

REVISION A' 10.7.17
 DIMENSIONS ADDED (1.50 PIERS)
 RAISED LEVEL +300MM
 COLOURS OF MATERIALS ADDED.
 REVISION B' 8.8.17
 FACIA SIGN REMOVED.

PROPOSED ALTERATION TO FRONTAGE NO 46

REP designs
 2 Lulworth Court
 13 Cannon Hill
 London N14 7DJ

Contract
 46 Birchington Road
 London NW6 4LJ
 Client
 Neritan


Drawing No 15/GL/02A/B
 Proposed Alterations to Frontage
 Scale 1:100
 Date June 2017
 Drawn by EP





AS BUILT ELEVATION OF NO 46.

SIDE ELEVATION

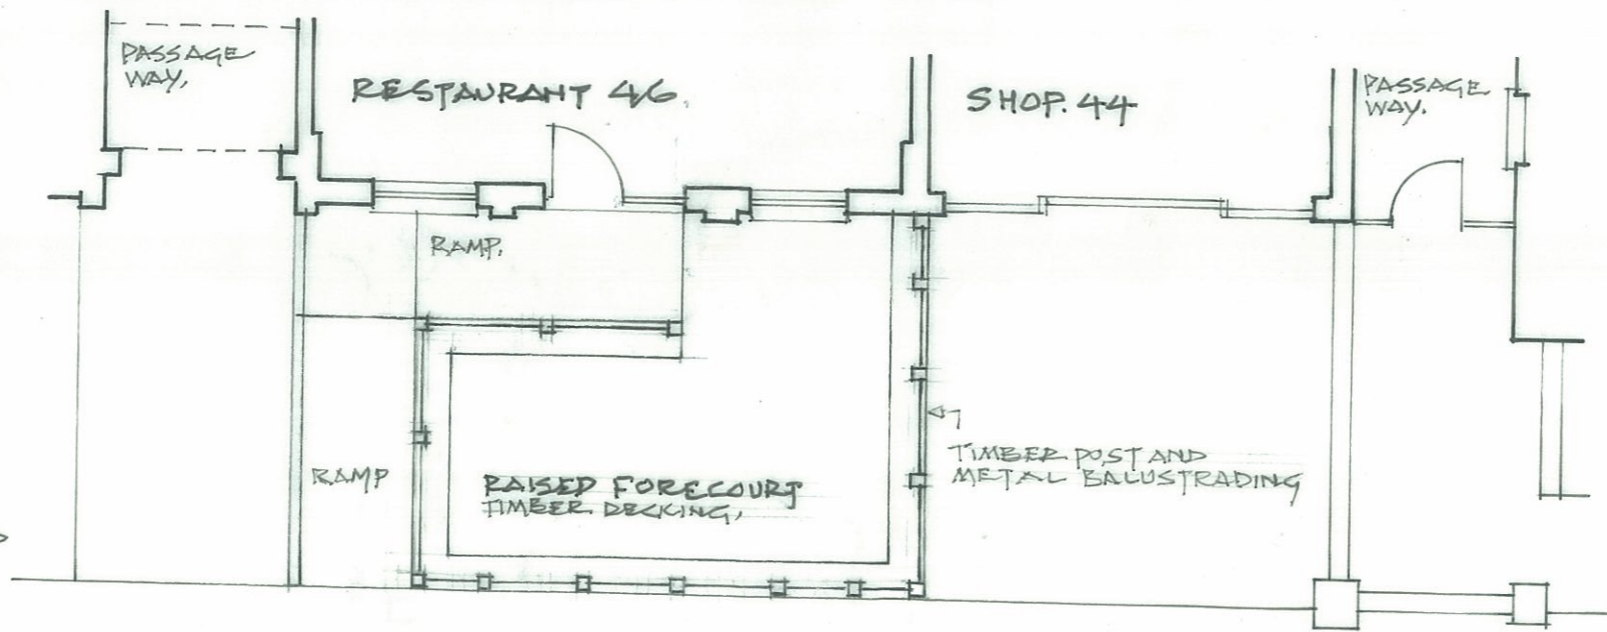

AS BUILT PLAN OF FRONTAGE NO 46

REVISION 'A' 10.7.17
 DIMENSIONS ADDED
 COLOUR OF MATERIALS ADDED
 SCALE BAR SHOWN
 REVISION 'B' 8.8.17
 FACIA SIGN REMOVED

NO 46, BIRCHINGTON ROAD
 WILBURN, LONDON NW6 4LJ

REP designs
 2 Lulworth Court
 13 Cannon Hill
 London N14 7DJ
 020 8882 3803

Contract
 46 Birchington Road
 Kilburn London NW64LJ
 Client
 Neritan

Drawing No 17/GL/01 A/B
 As Built Frontage
 Scale 1:100
 Date June 2017
 Drawn by EP