


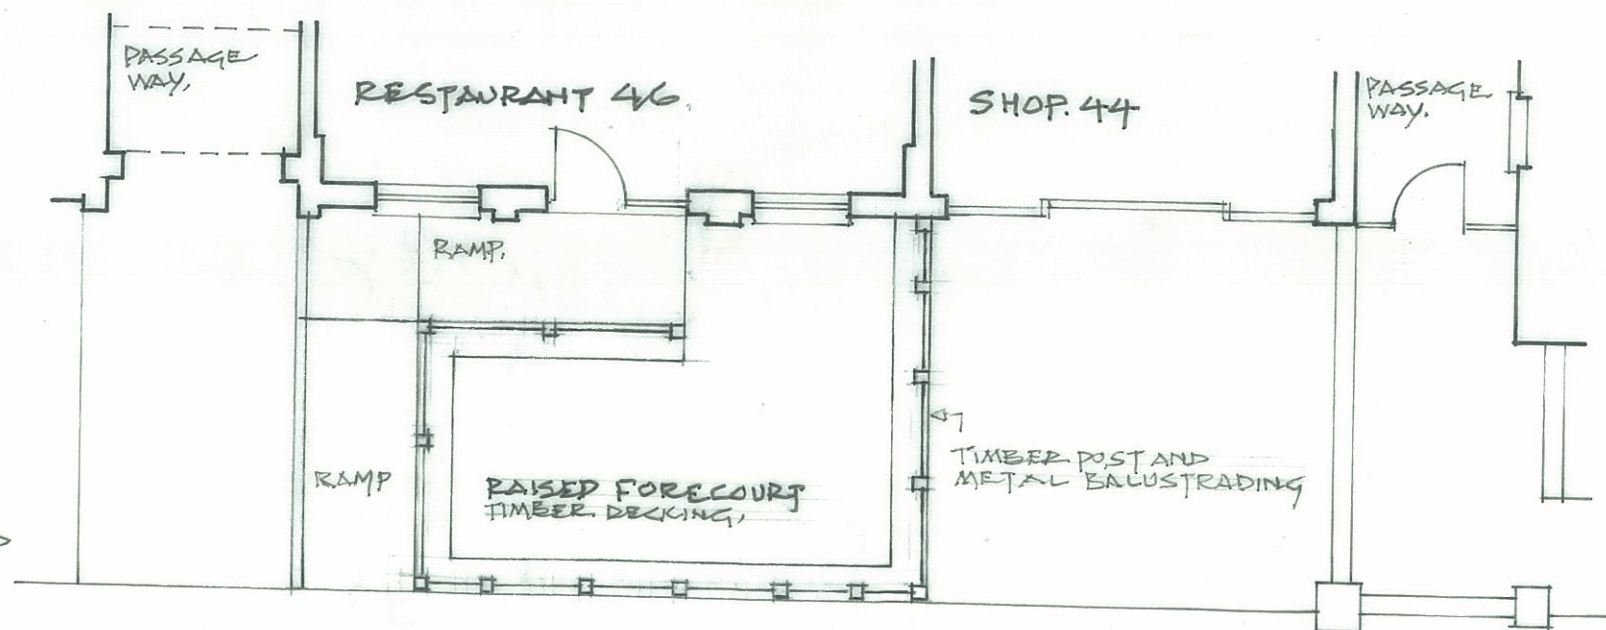

REVISION 'A' 10.7.17
 DIMENSIONS ADDED
 COLOUR OF MATERIALS ADDED
 SCALE BAR SHOWN
 REVISION 'B' 8.8.17
 FACIA SIGN REMOVED

NO 46, BIRCHINGTON ROAD
 KILBURN, LONDON NW6 4LJ

REP designs
 2 Lulworth Court
 13 Cannon Hill
 London N14 7DJ
 020 8882 3803

Contract
 46 Birchington Road
 Kilburn London NW6 4LJ
 Client
 Neritan

Drawing No 17/GL/01 A'B
 As Built Frontage
 Scale 1:100
 Date June 2017
 Drawn by EP