

Do not scale from drawings.  
 Errors to be reported immediately to the Architect.  
 To be read in conjunction with all relevant Architects', Services and Structural Engineers' drawings.  
 All dimensions to be checked on site.


— Red Line Boundary

Existing building fabric

Proposed building fabric

Envelope to consented scheme ref:2017/1611/P

NOTE: Drawings based on outline survey from different sources

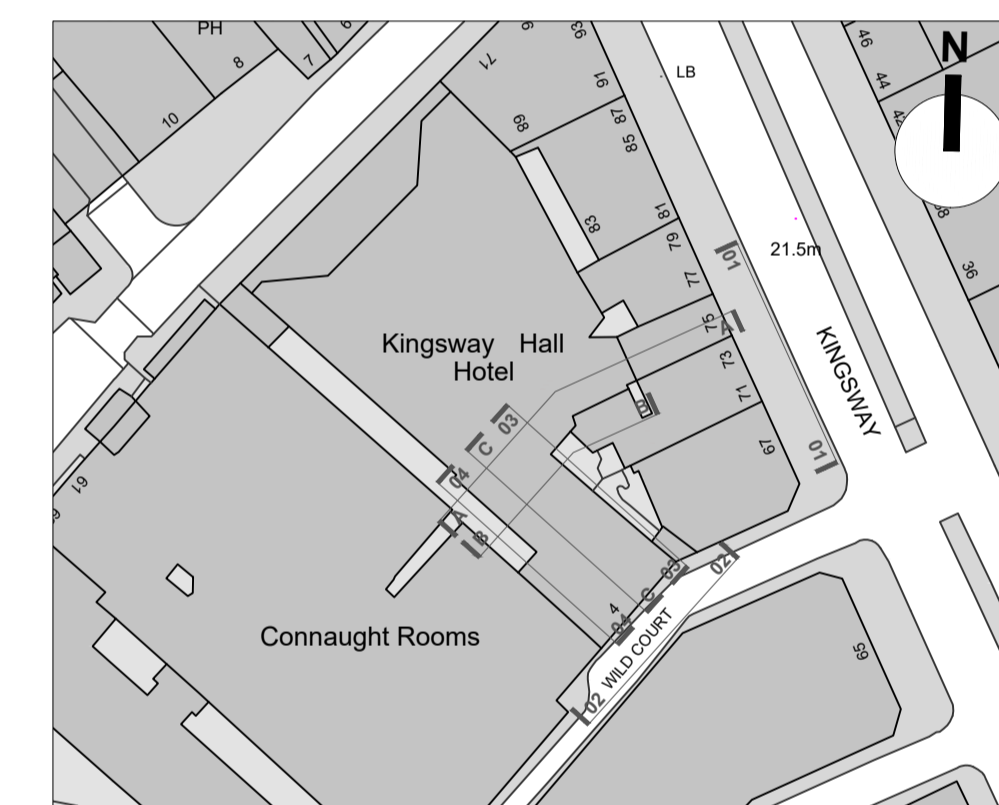

Rev.	Date	Description	DB	CB
P2	08.12.17	MMA Application	PA	RP
P1	10.03.17	Planning Application Submission	LF	PR

**TT Architects**

2 Eustace House  
 Old Paradise Street  
 London, SE11 6AN


Project  
 Z-WILD COURT  
 4 Wild Court & 75 Kingsway  
 London  
 WC2B 4AU

Client  
 Z Hotels


Drawing Name	Date	Issue
General Sections /Proposed Sections CC' & BB'	13.11.2017	Planning
Scale	1:100 @ A1	Drawn/Checked PA/RP
Drawing No. & Revision	005-GS01-P2	



RF 51.82  
 07 47.51  
 06 44.22  
 05 41.26  
 04 38.01  
 03 34.73  
 02 31.50  
 01 27.56  
 MEZ 25.11  
 GF 22.54  
 LG 18.75

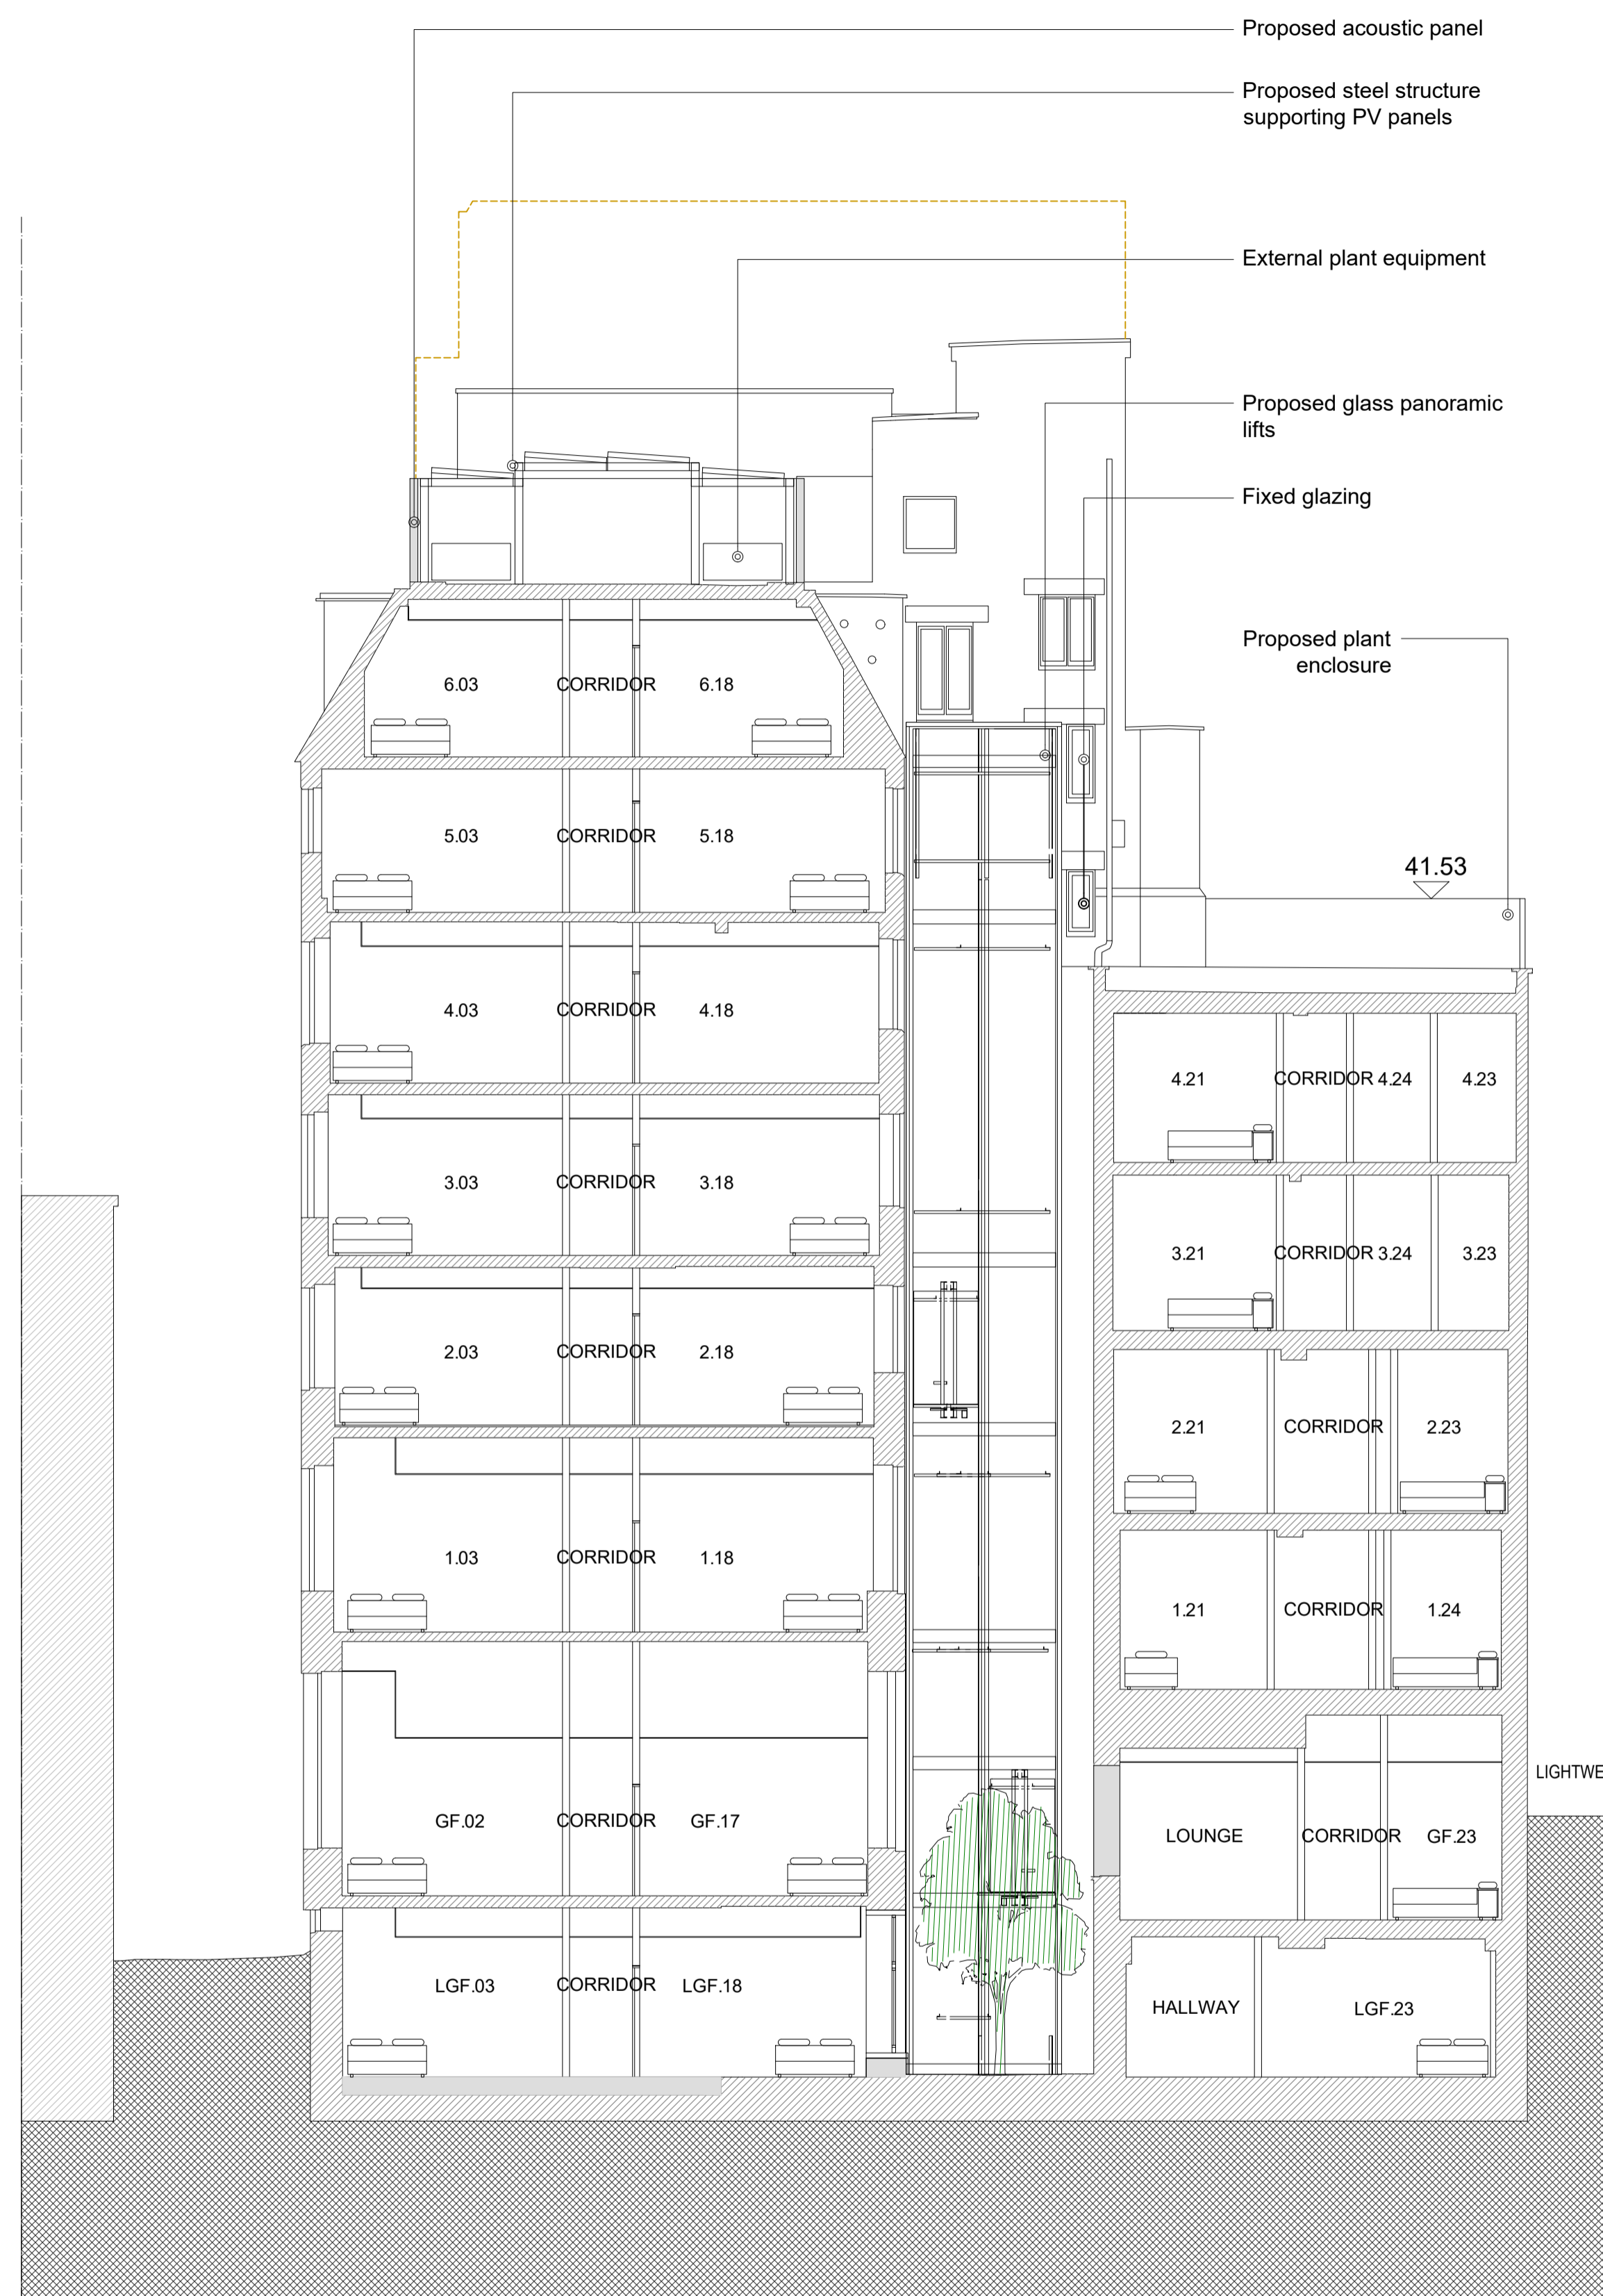

RF 51.82  
 07 47.51  
 06 44.22  
 05 41.26  
 04 38.01  
 03 34.73  
 02 31.50  
 01 27.56  
 MEZ 25.11  
 GF 22.54  
 LG 18.75

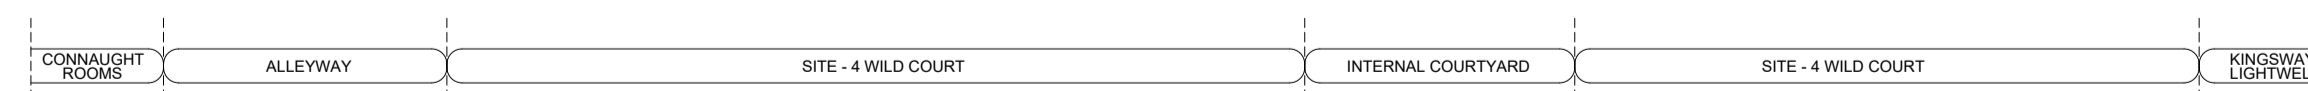

**01** Proposed Section CC' ( Kingsway Elevation)  
 Scale 1/100

**02** Proposed Section BB' ( Wild Court Elevation)  
 Scale 1/100

