




01 Proposed Elevation 03 (Kingsway Elevation)
Scale 1/100

P2

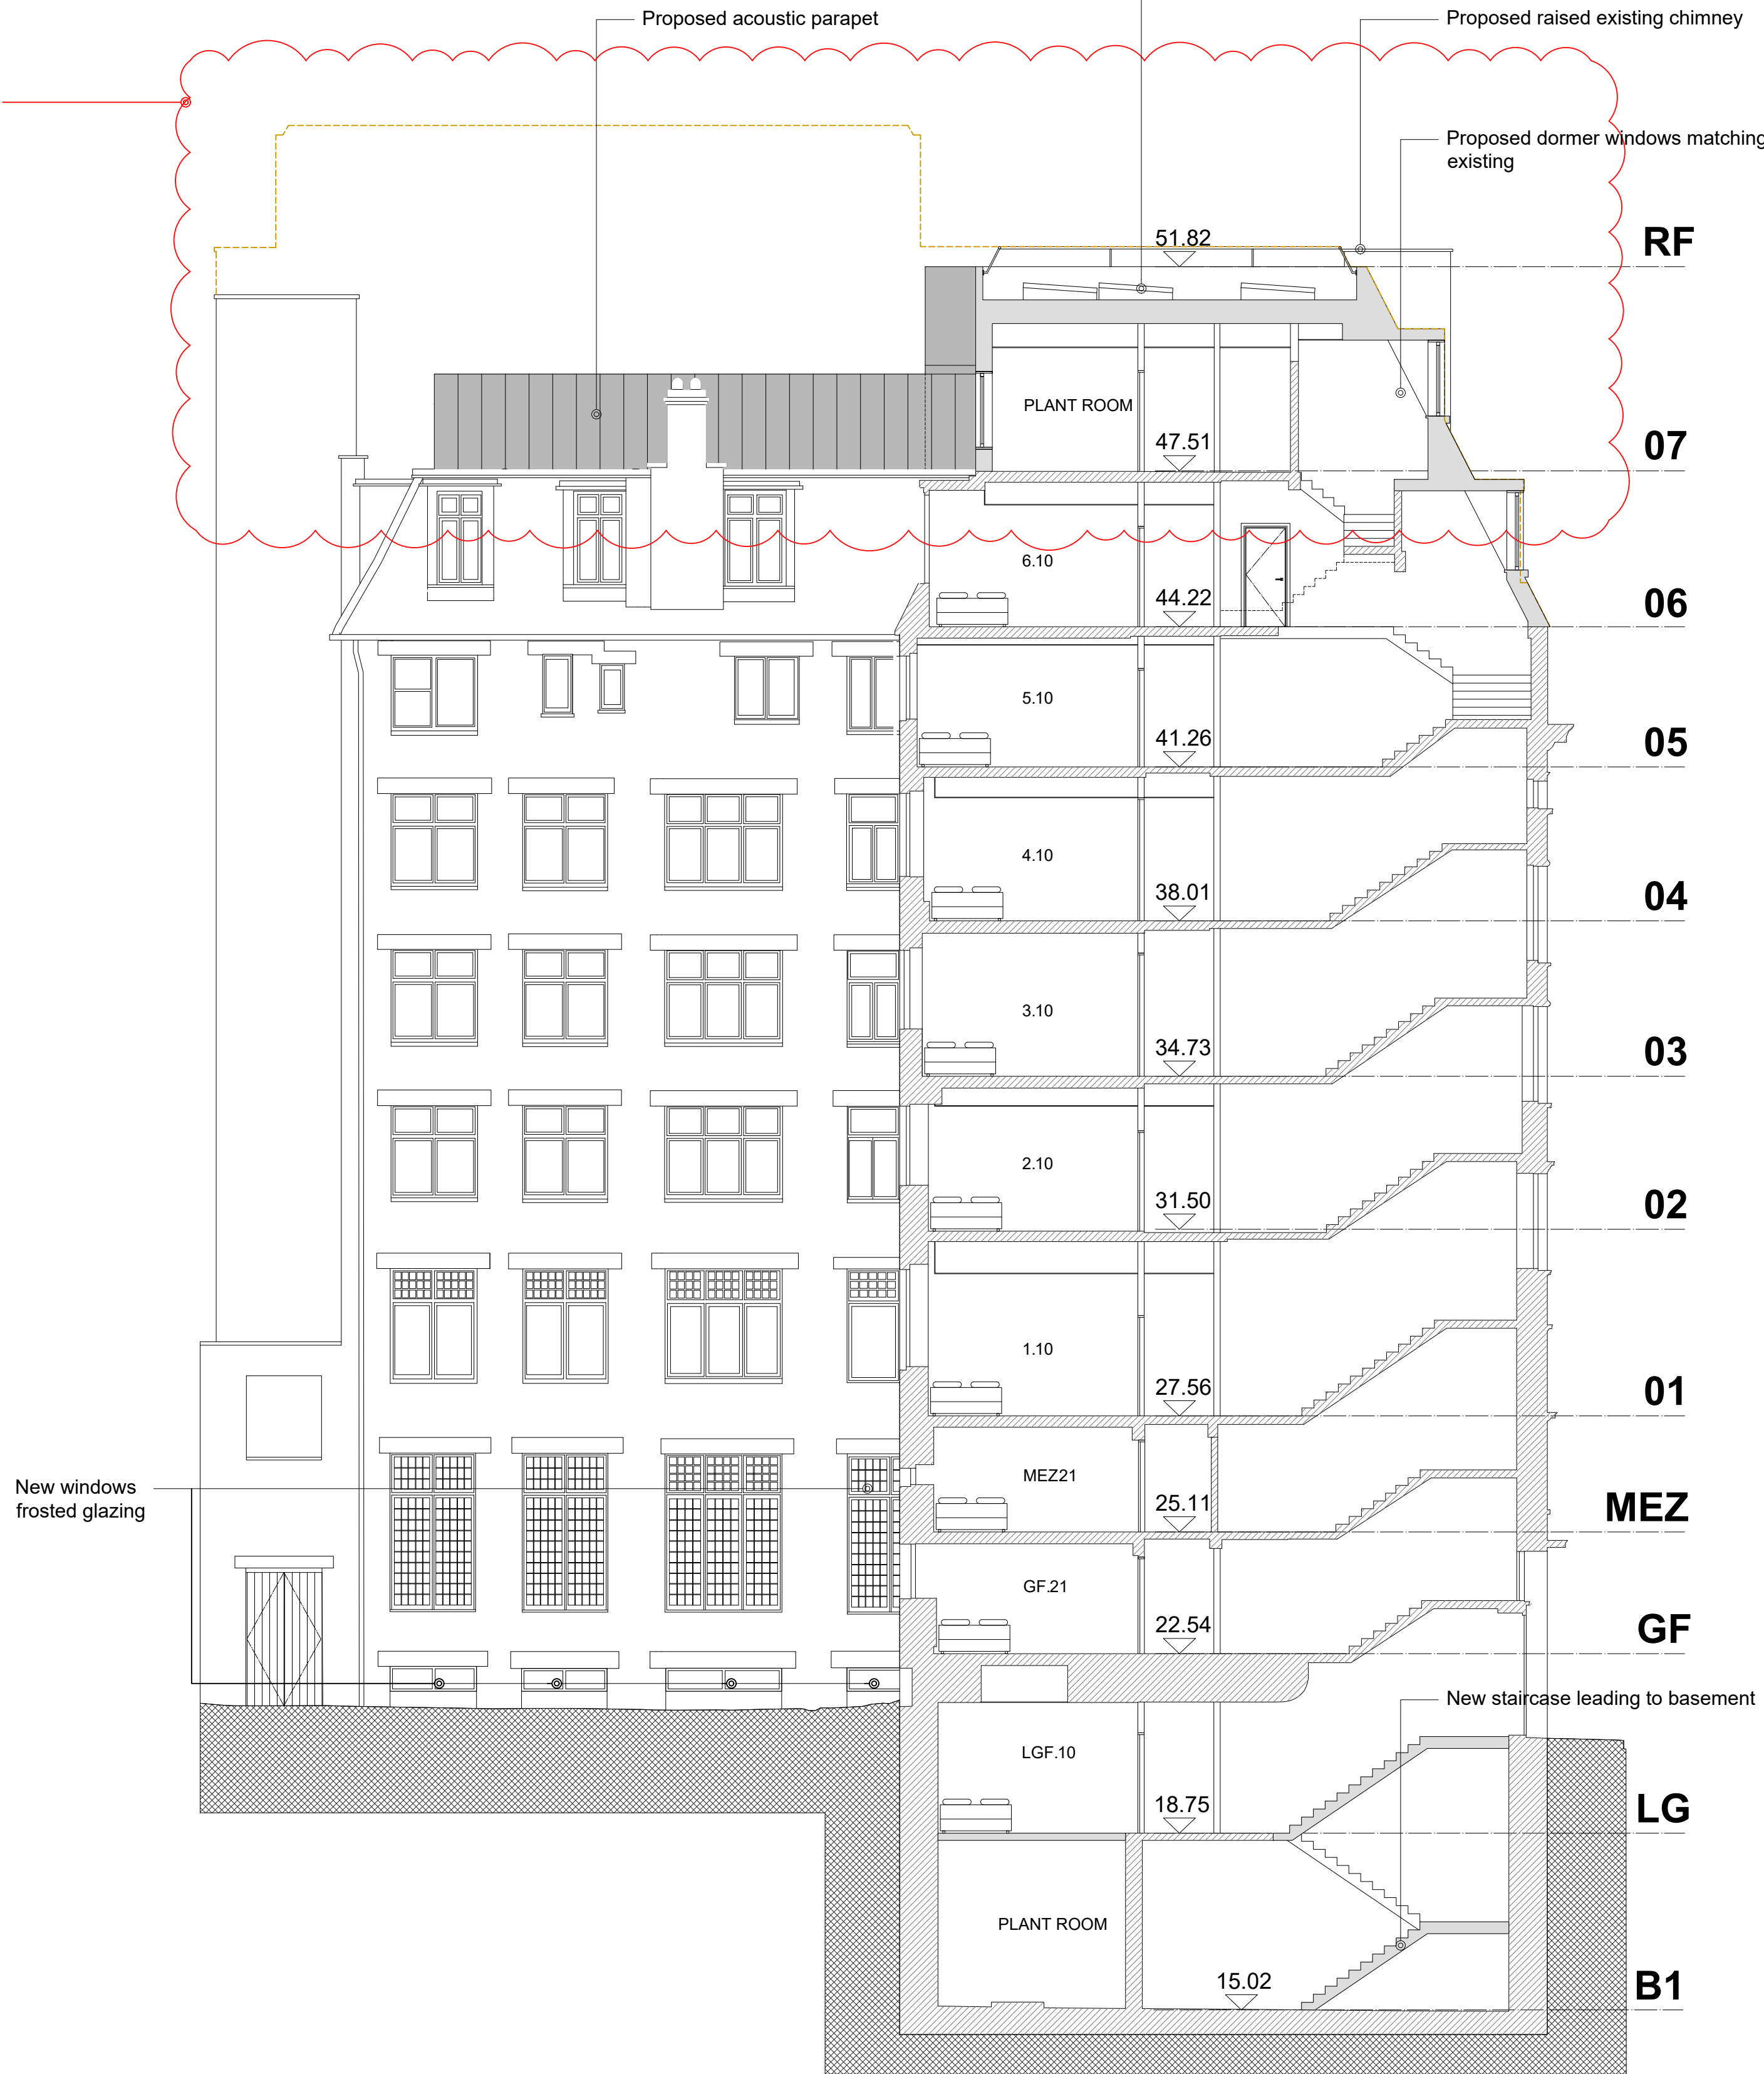


02 Proposed Elevation 04 (Wild Court Elevation)
Scale 1/100

GENERAL NOTES

Do not scale from drawings.
Errors to be reported immediately to the Architect.
To be read in conjunction with all relevant Architects', Services and Structural Engineers' drawings.
All dimensions to be checked on site.

- Red Line Boundary
 - Existing building fabric
 - Proposed building fabric
 - Envelope to consented scheme ref:2017/1611/P
- NOTE: Drawings based on outline survey from different sources

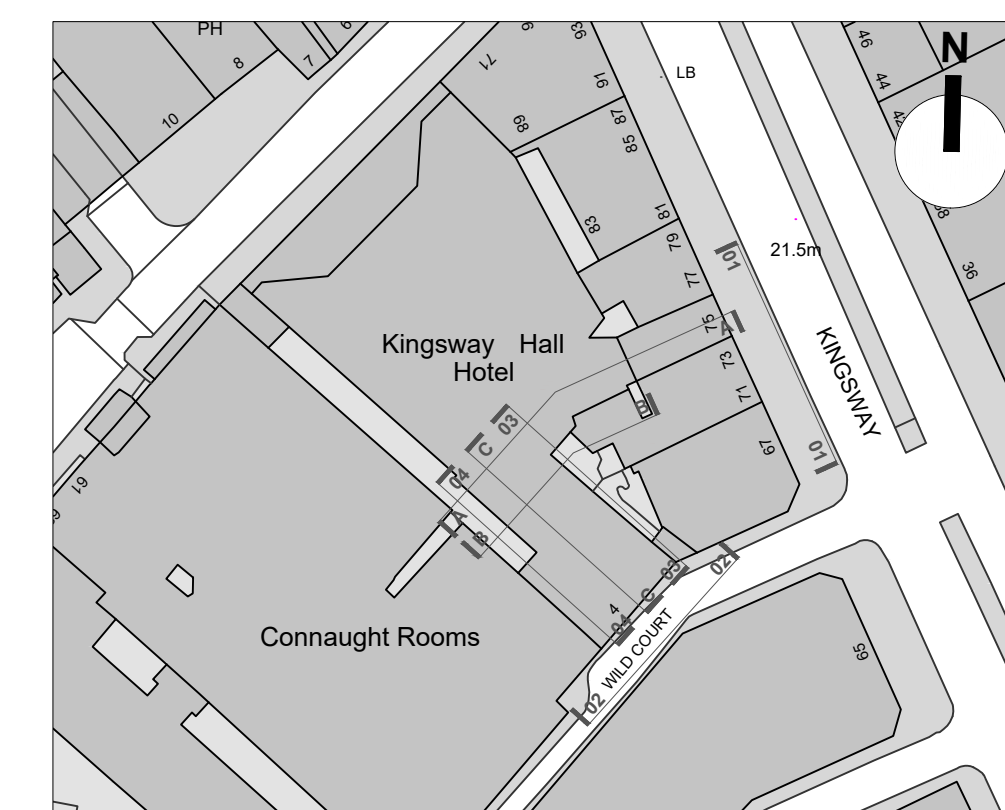

Rev.	Date	Description	DB	CB
P2	08.12.17	MMA Application	PA	RP
P1	10.03.17	Planning Application Submission	LF	PR

TT Architects

2 Eustace House
Old Paradise Street
London, SE11 6AN

Project
Z-WILD COURT
4 Wild Court & 75 Kingsway
London
WC2B 4AU

Client
Z Hotels

Drawing Name
General Elevations /Proposed Elevations 03 & 04

Date
13.11.2017
Issue
Planning

Scale
1:100 @ A1
Drawn/Checked
PA/RP

Drawing No. & Revision
005-GE02-P2

