



NOTE

THIS DRAWING IS TO BE READ IN CONJUNCTION WITH ALL OTHER RELEVANT DRAWINGS AND SPECIFICATIONS
 THIS DRAWING HAS BEEN PREPARED FOR IDENTIFICATION PURPOSES ONLY. VERIFICATION OF DRAWN INFORMATION TO BE CARRIED OUT BY CONTRACTOR PRIOR TO OTHER USE.

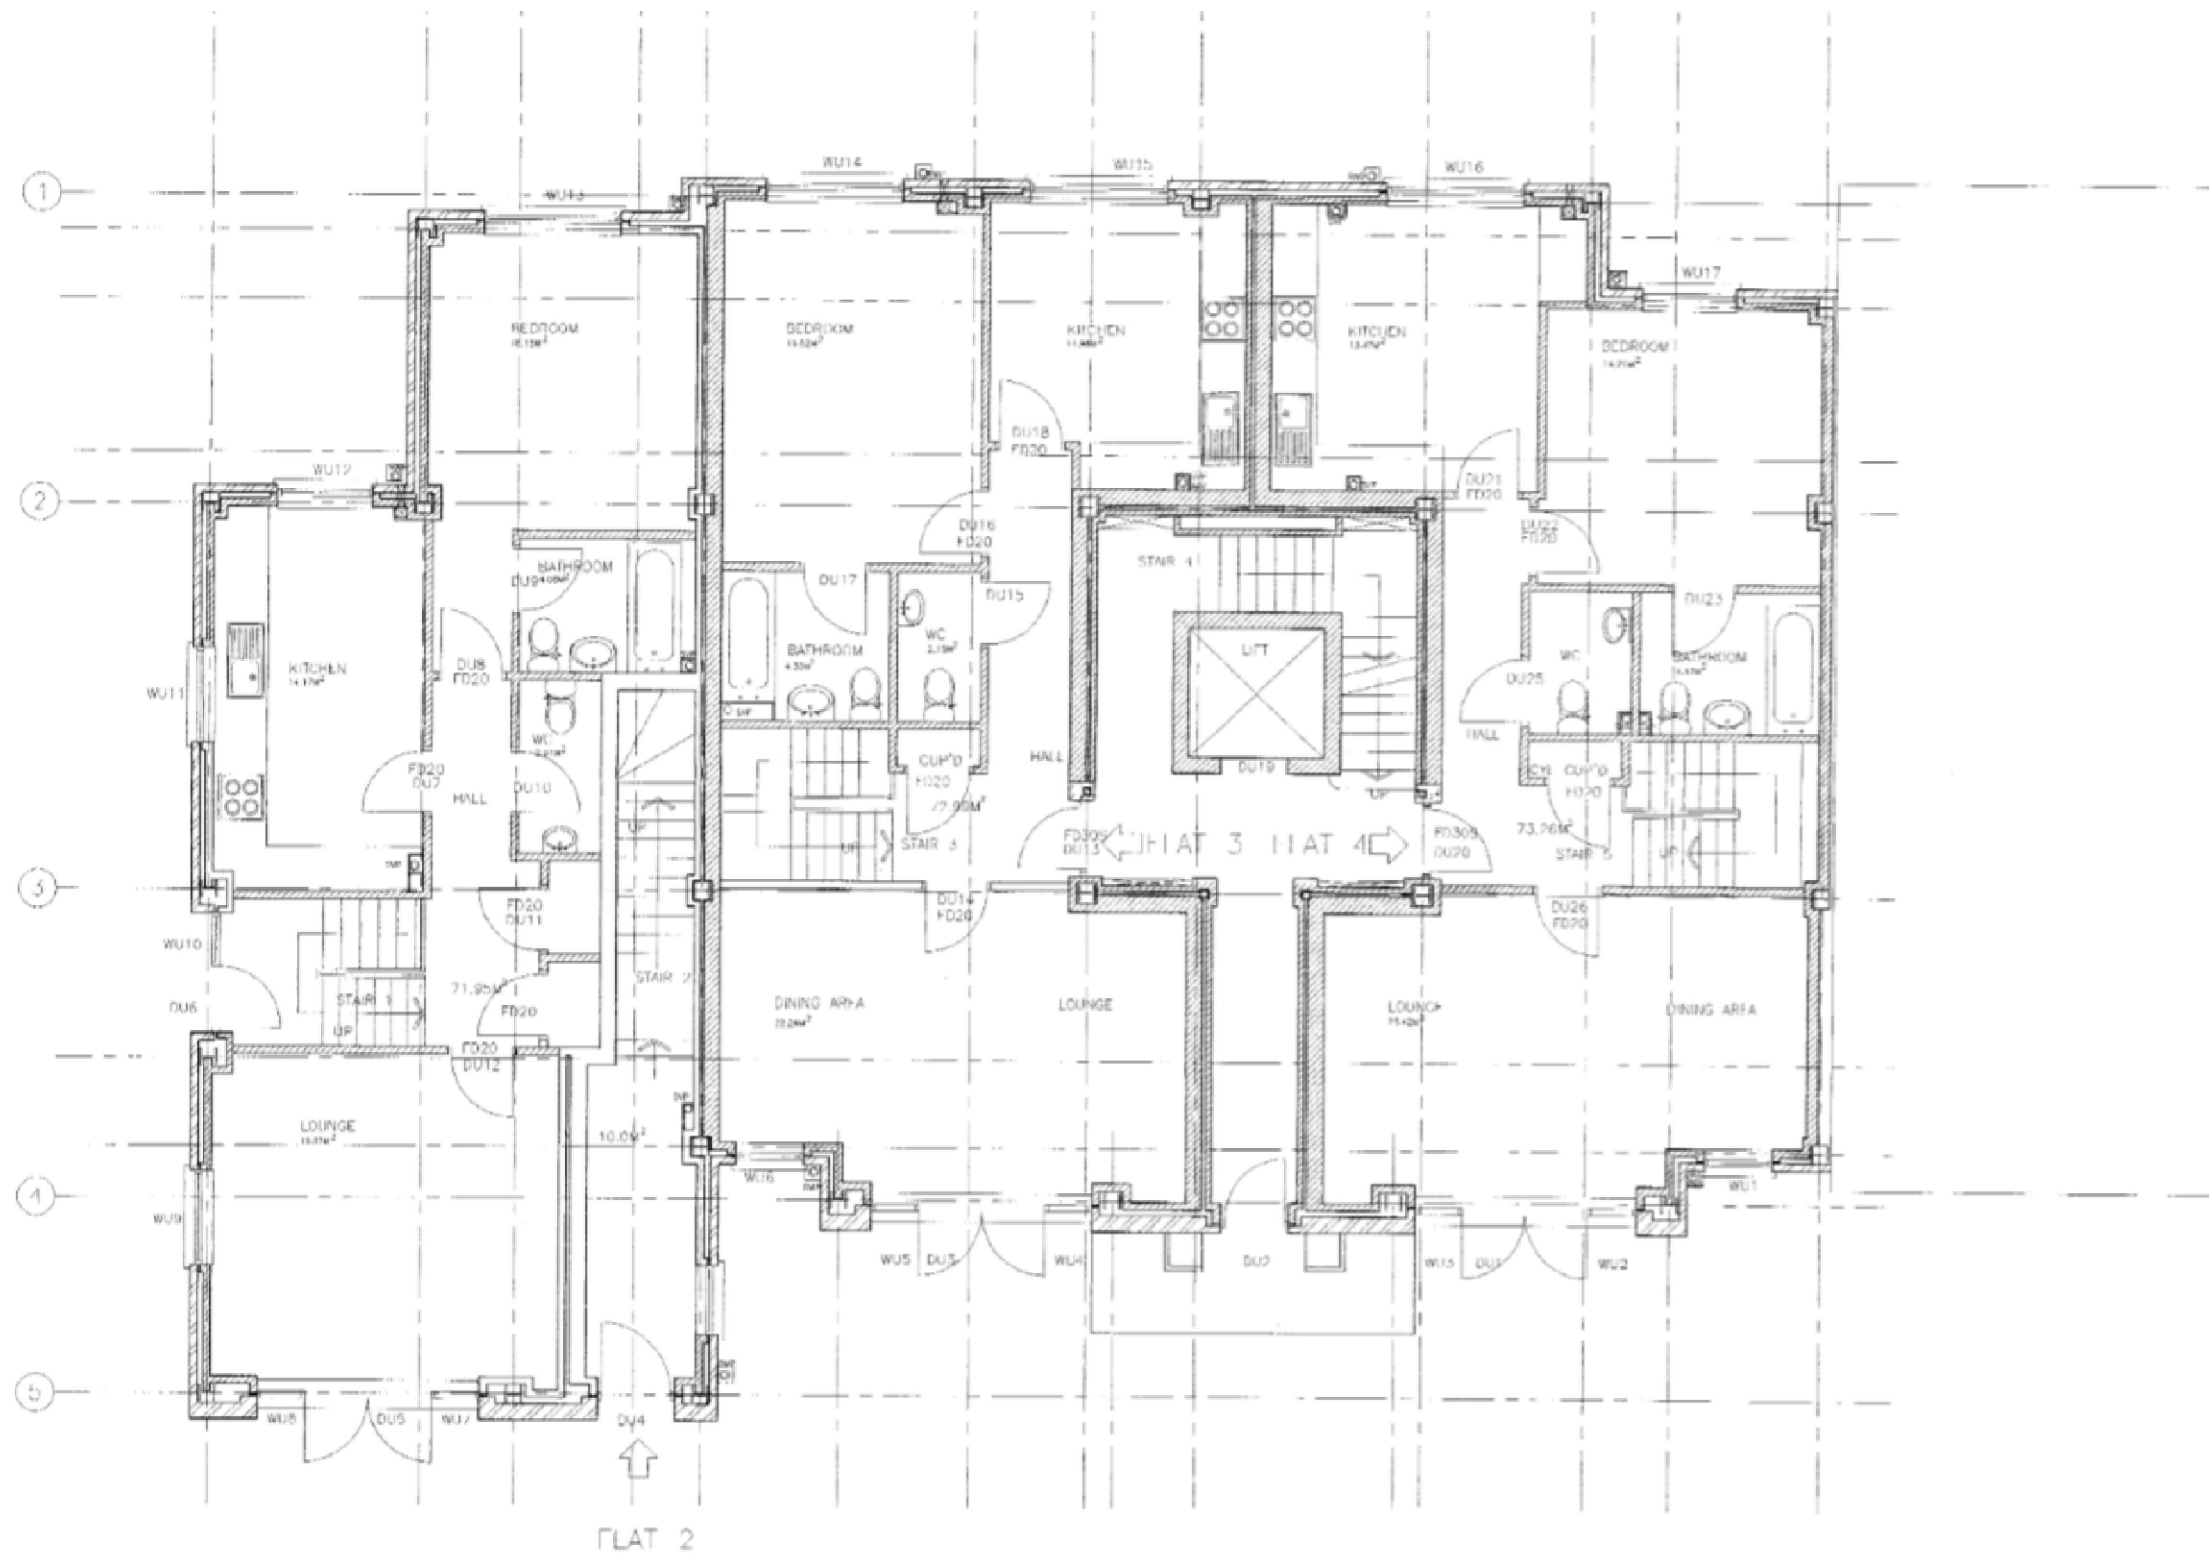

GROUND FLOOR PLAN

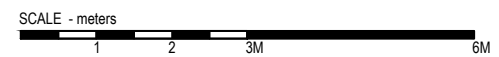

rev

STEVEN ADAMS RIBA ARCHITECTS

28b ENGLANDS LANE
 LONDON NW3 4UE
 Tel 020 7722 7664
 Fax 020 7722 7652

project	no		
HEATH CUT LODGE	720		
LONDON NW3			
drawing	no		
RECORD DRAWING	RD 01		
EXISTING GROUND FLOOR PLAN			
scale	date	drawn	checked
1:100@A3	23.11.17	RE	SAA

Extract from archive drawings