


KEY - DEMOLITION


DEMOLITION

Broken red line denotes furniture, areas of partition, glazing or door etc to be removed.

COMPLETE BARE SHELL STRIP OUT TO INCLUDE ALL RETAIL FIXTURES AND FITTINGS, PLASTERBOARD AND SUSPENDED CEILINGS, DOORS & FRAMES AS INDICATED, EXISTING CIRCULATION STAIRCASE, ESCALATORS, RETAIL UNIT ENTRANCE DOORS LIMITED AREAS OF EXISTING SHOPFRONT.

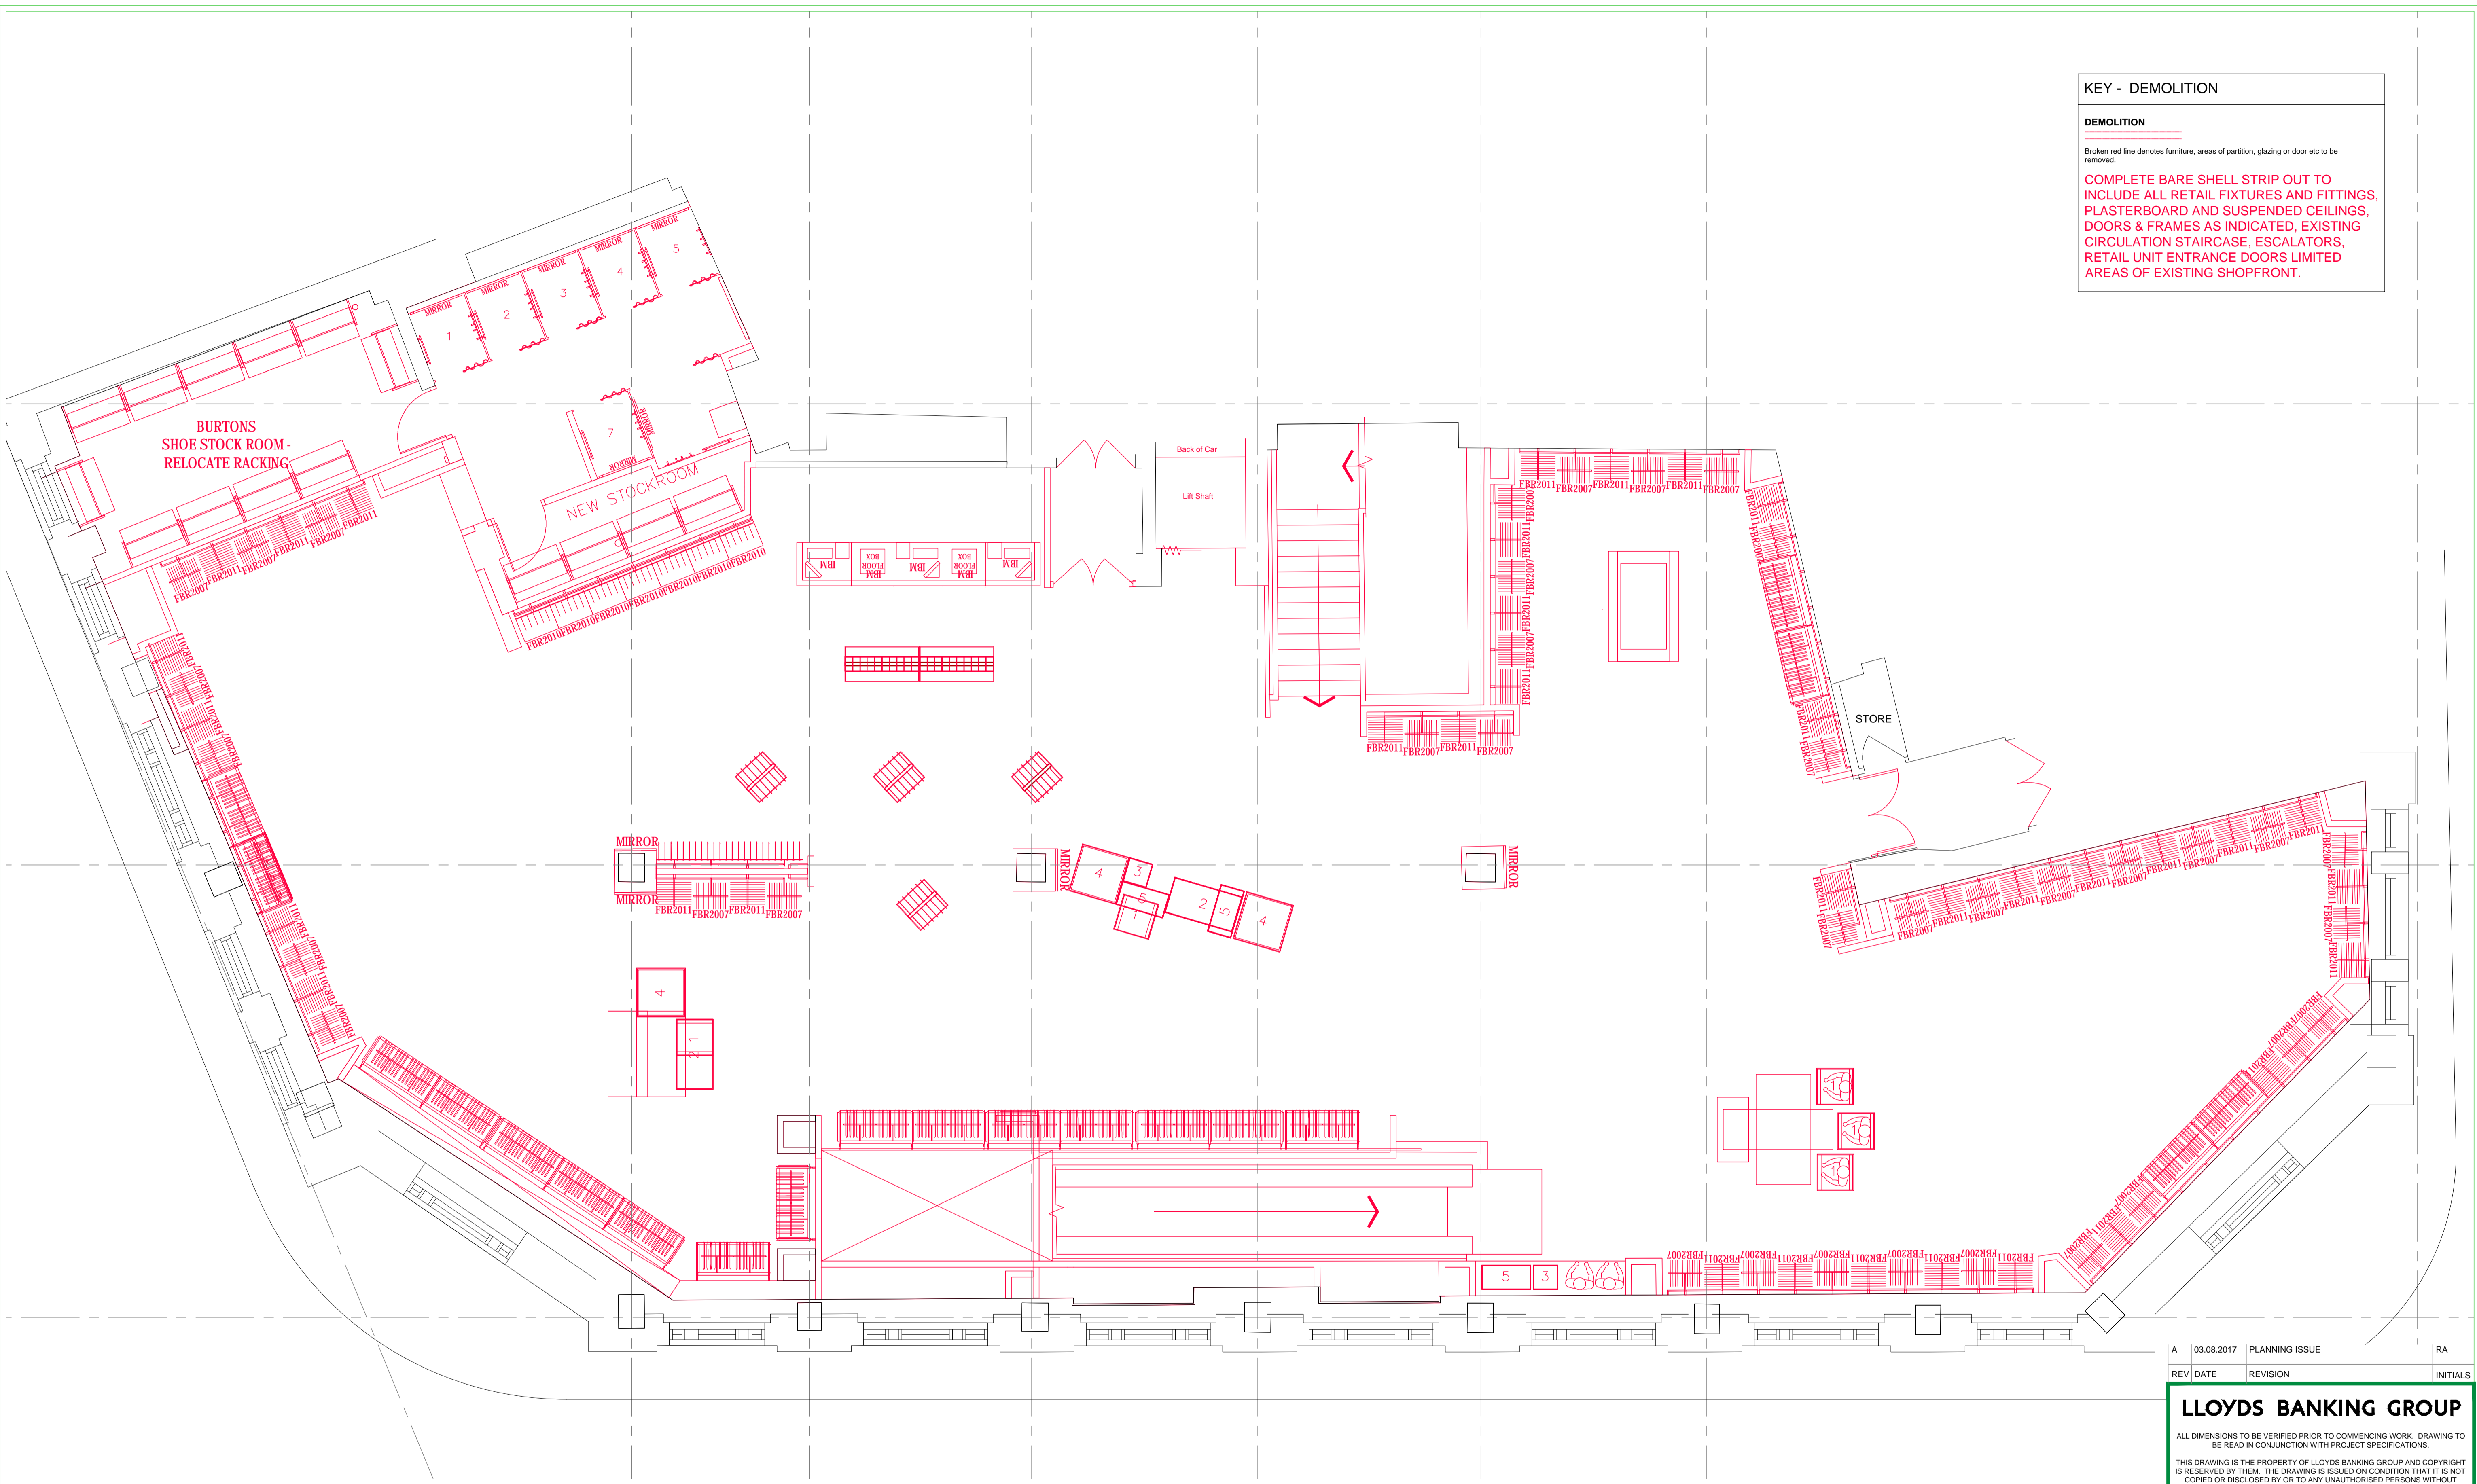

EXISTING FIRST FLOOR PLAN

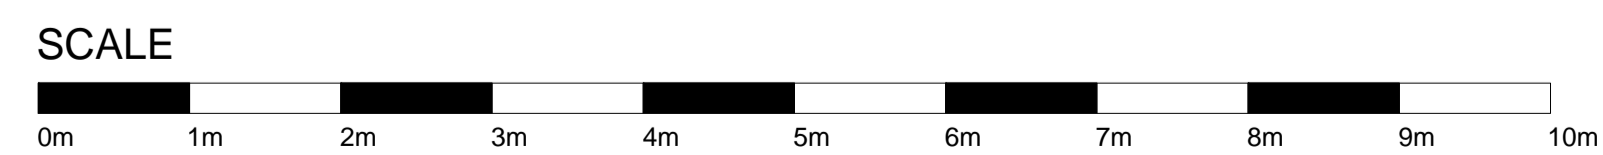

REV	DATE	REVISION	INITIALS
A	03.08.2017	PLANNING ISSUE	RA

LLOYDS BANKING GROUP

ALL DIMENSIONS TO BE VERIFIED PRIOR TO COMMENCING WORK. DRAWING TO BE READ IN CONJUNCTION WITH PROJECT SPECIFICATIONS.

THIS DRAWING IS THE PROPERTY OF LLOYDS BANKING GROUP AND COPYRIGHT IS RESERVED BY THEM. THE DRAWING IS ISSUED ON CONDITION THAT IT IS NOT COPIED OR DISCLOSED BY OR TO ANY UNAUTHORISED PERSONS WITHOUT PRIOR CONSENT IN WRITING TO LLOYDS BANKING GROUP - GROUP PROPERTY. ALL MODIFIED DRAWINGS SHOULD BE RETURNED TO LLOYDS BANKING GROUP.

GROUP PROPERTY

BRISTOL - PO Box 112, Canons House, Canons Way, BRISTOL, BS99 7LB
 EDINBURGH - Sighthill South, 12 Bankhead Crossway South, EDINBURGH, EH11 4EN
 HALIFAX - Trinity Road, HALIFAX, West Yorkshire, HX1 2RG

PROJECT ADDRESS	SCALE
Halifax	A1 - 1:50
118-132, New Oxford Street	A3 - 1:100
West End	DATE
LONDON, WC1A 1HL	30/08/2016
DRAWING DESCRIPTION	DRAWN BY
First Floor Plan	RA
Demolition and Removals	REVISION
PLANNING	A
DRAWING NUMBER	
50941725-AREX-01-0021 PL	