



AS-BUILT PHOTOGRAPHS OF PLANNING  
CHANGE OF USE APPROVAL 2017/3788/P

SCALE 1:100

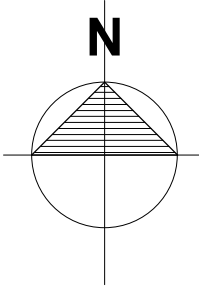


LOCATION PLAN 1:1250

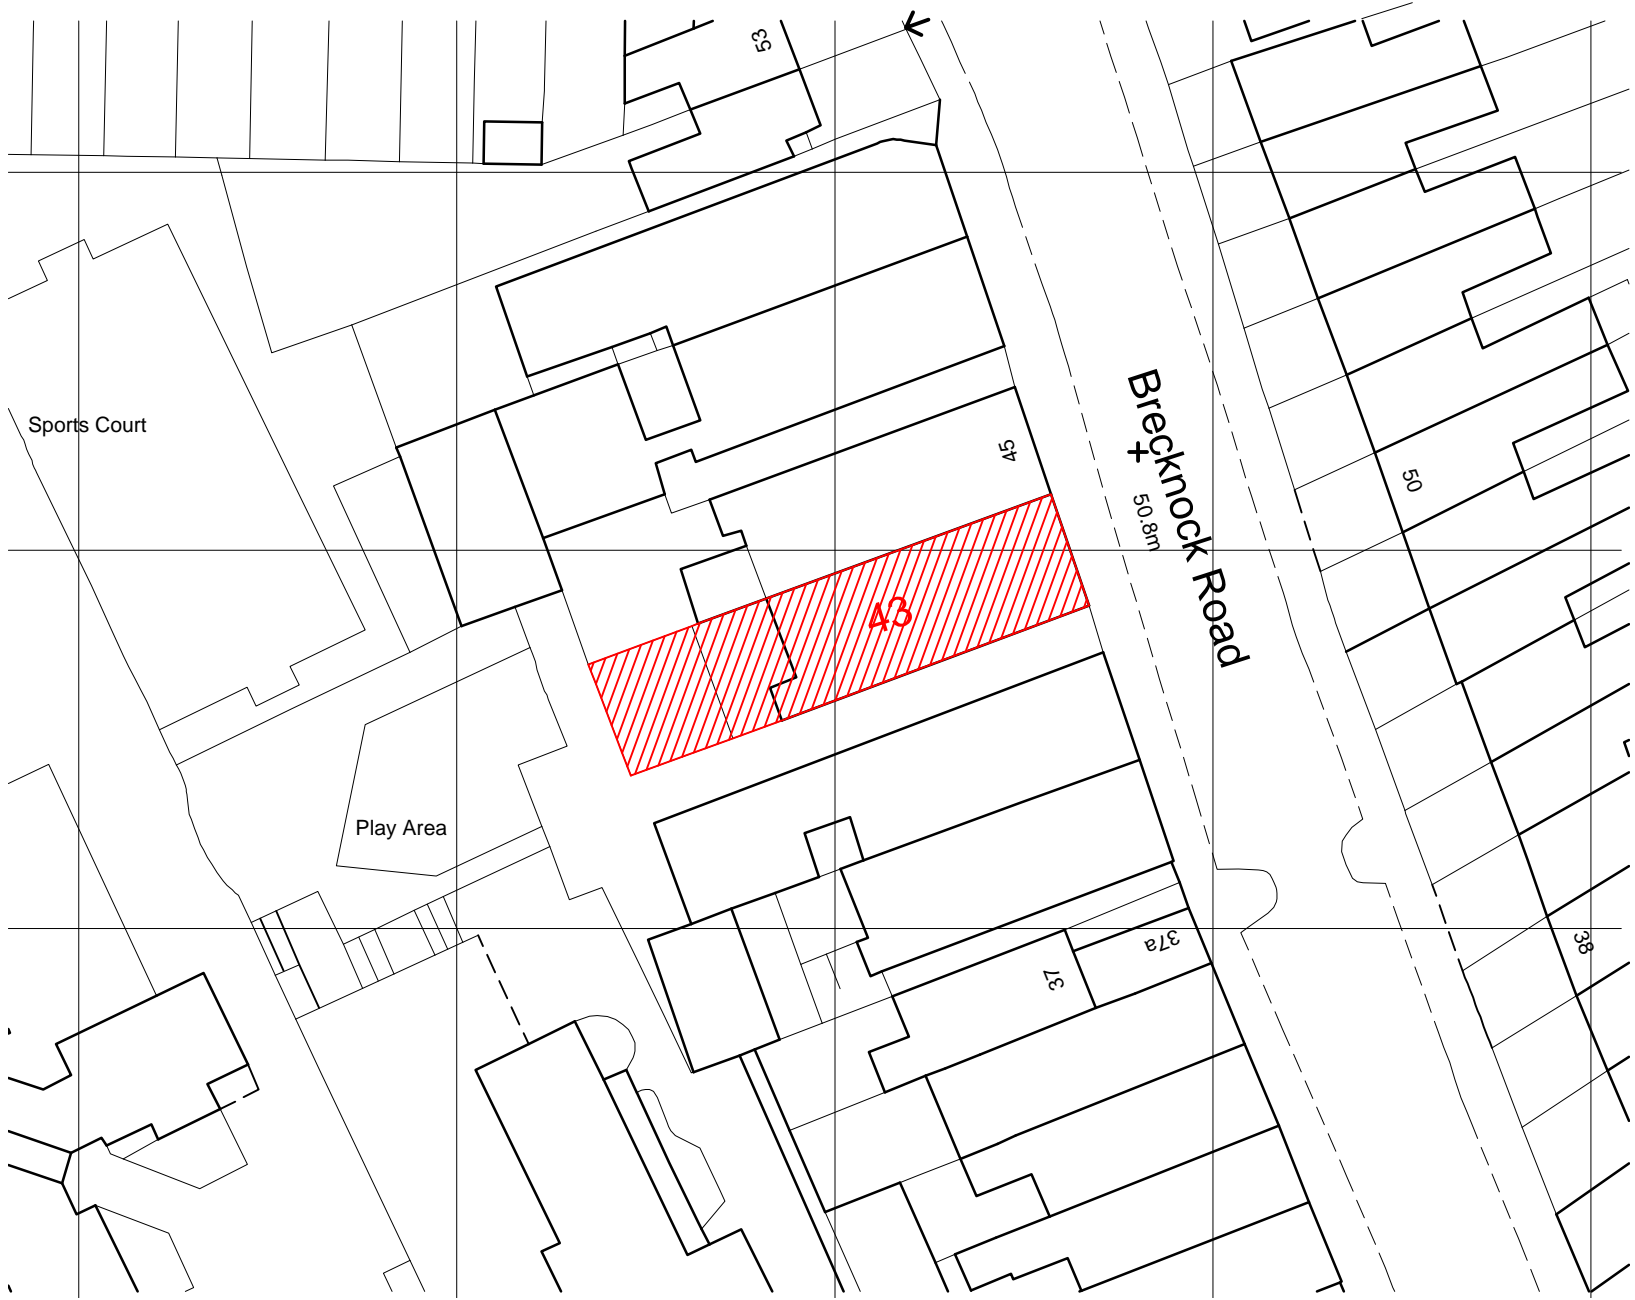


BLOCK PLAN 1:500


EXISTING UPPER FLOOR  
LEVELS SUBJECT TO  
PLANNING APPROVAL  
2017/3776/P

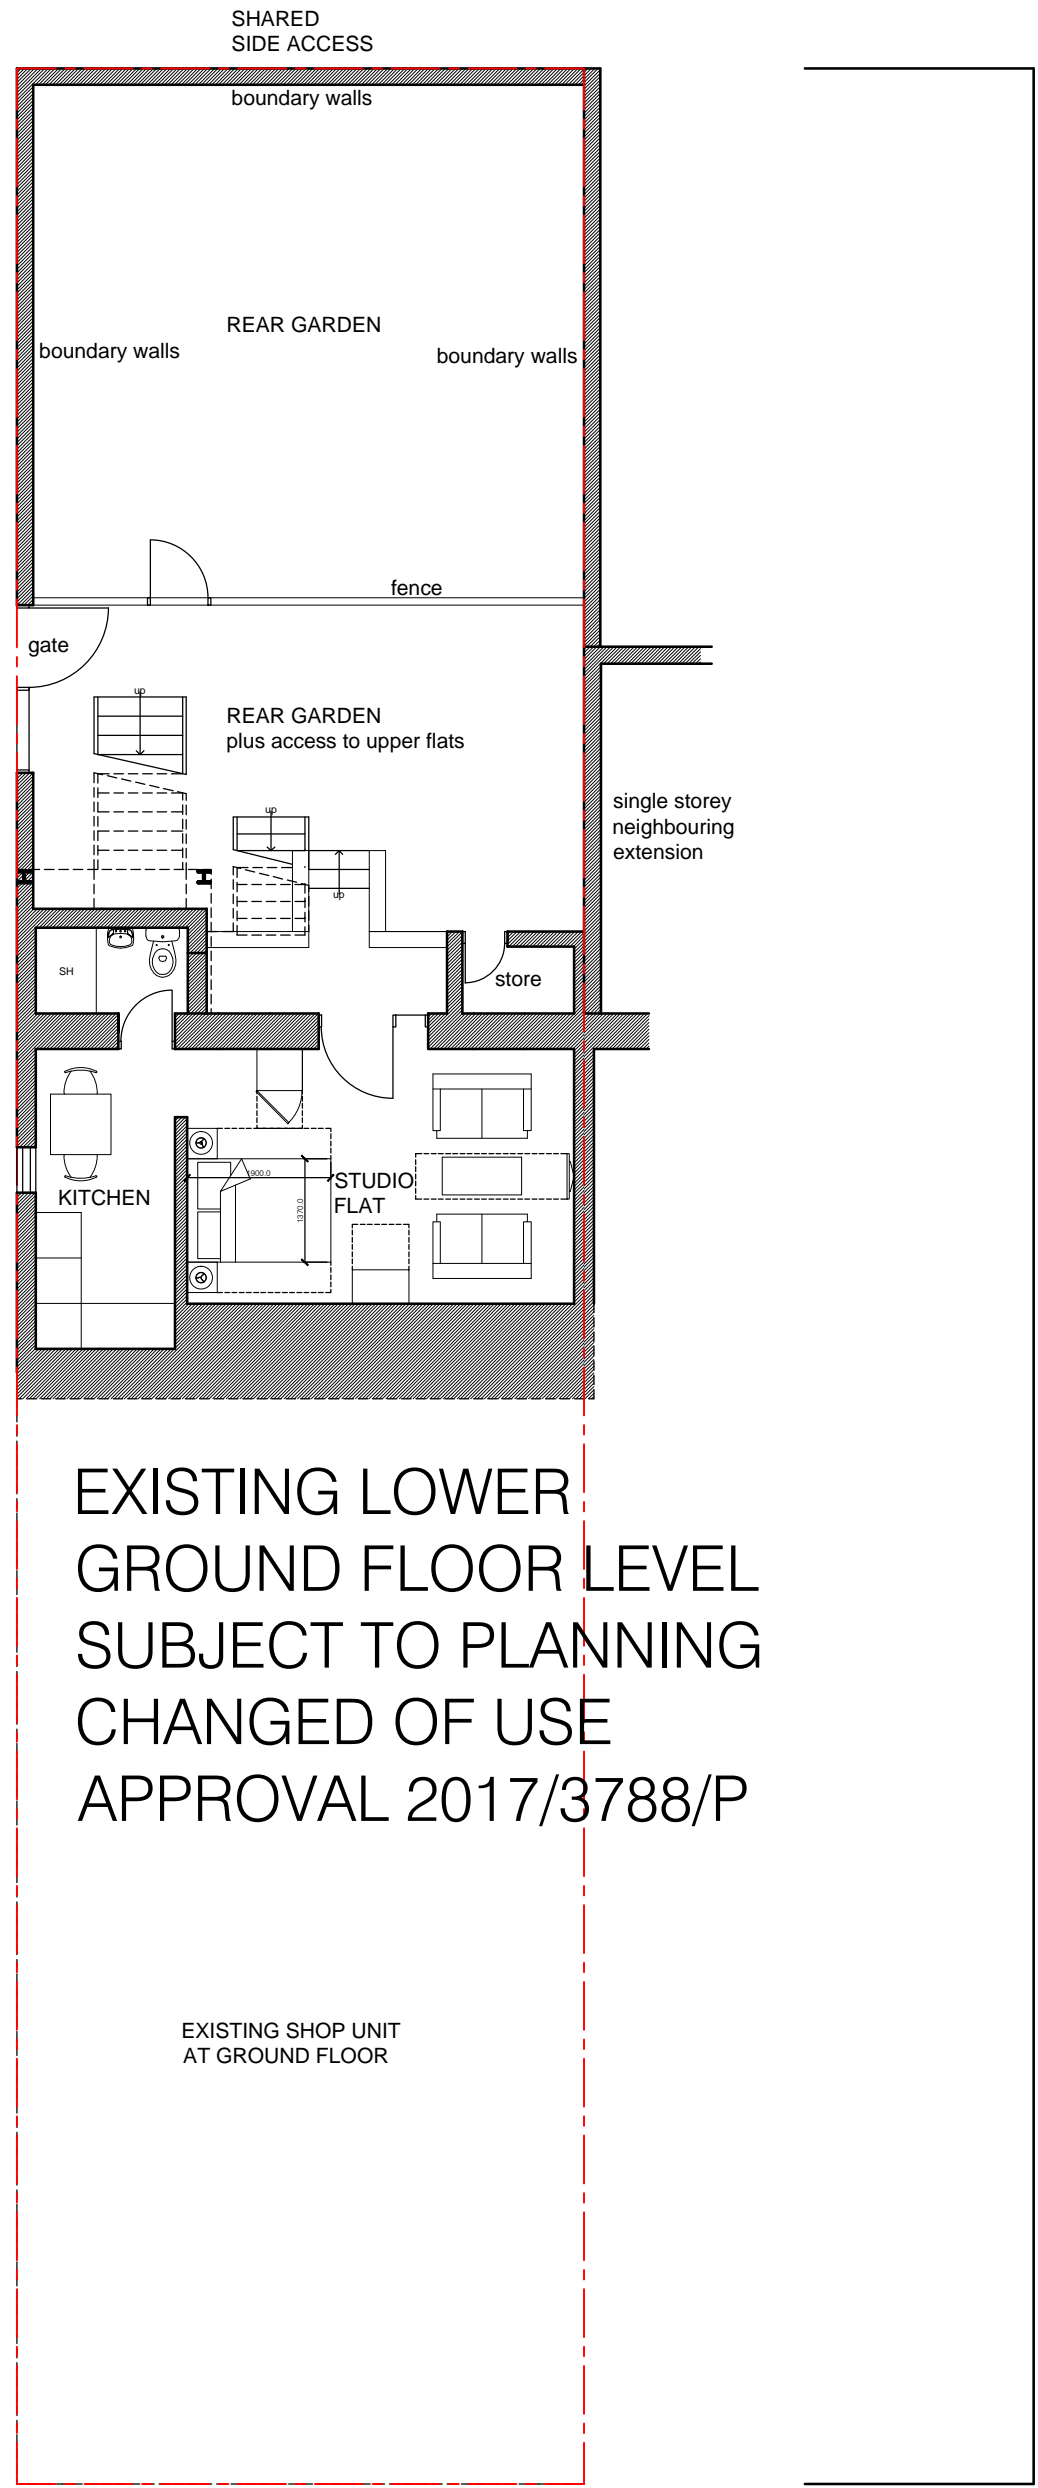


LOWER GROUND FLOOR PLAN 1:100

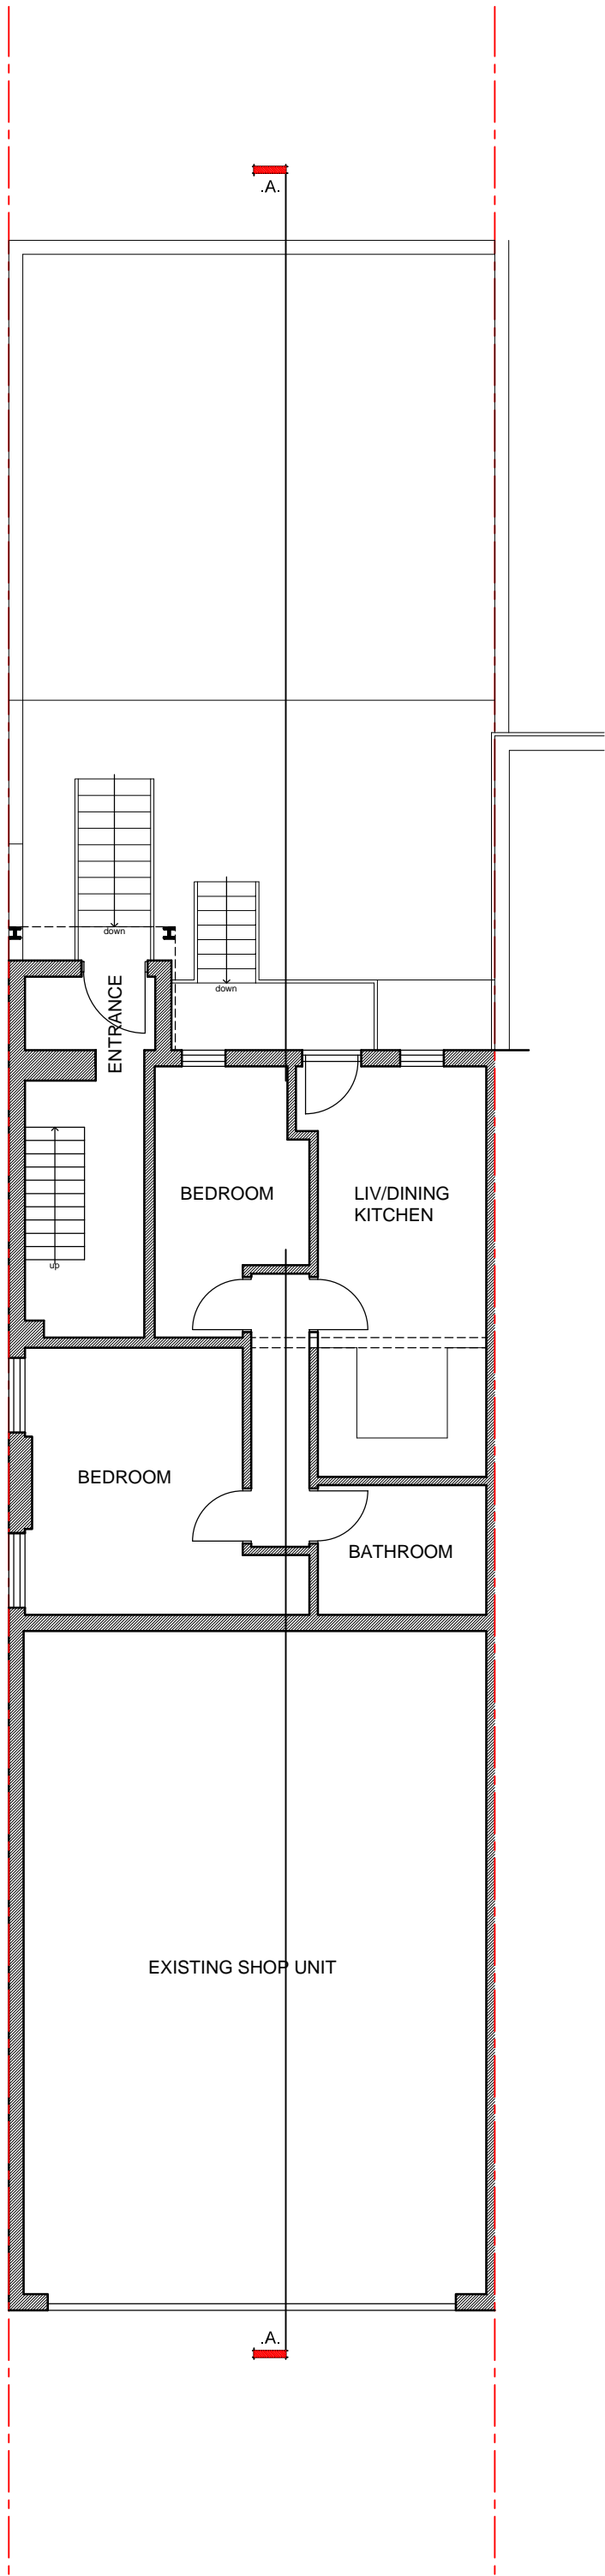

GROUND FLOOR PLAN 1:100

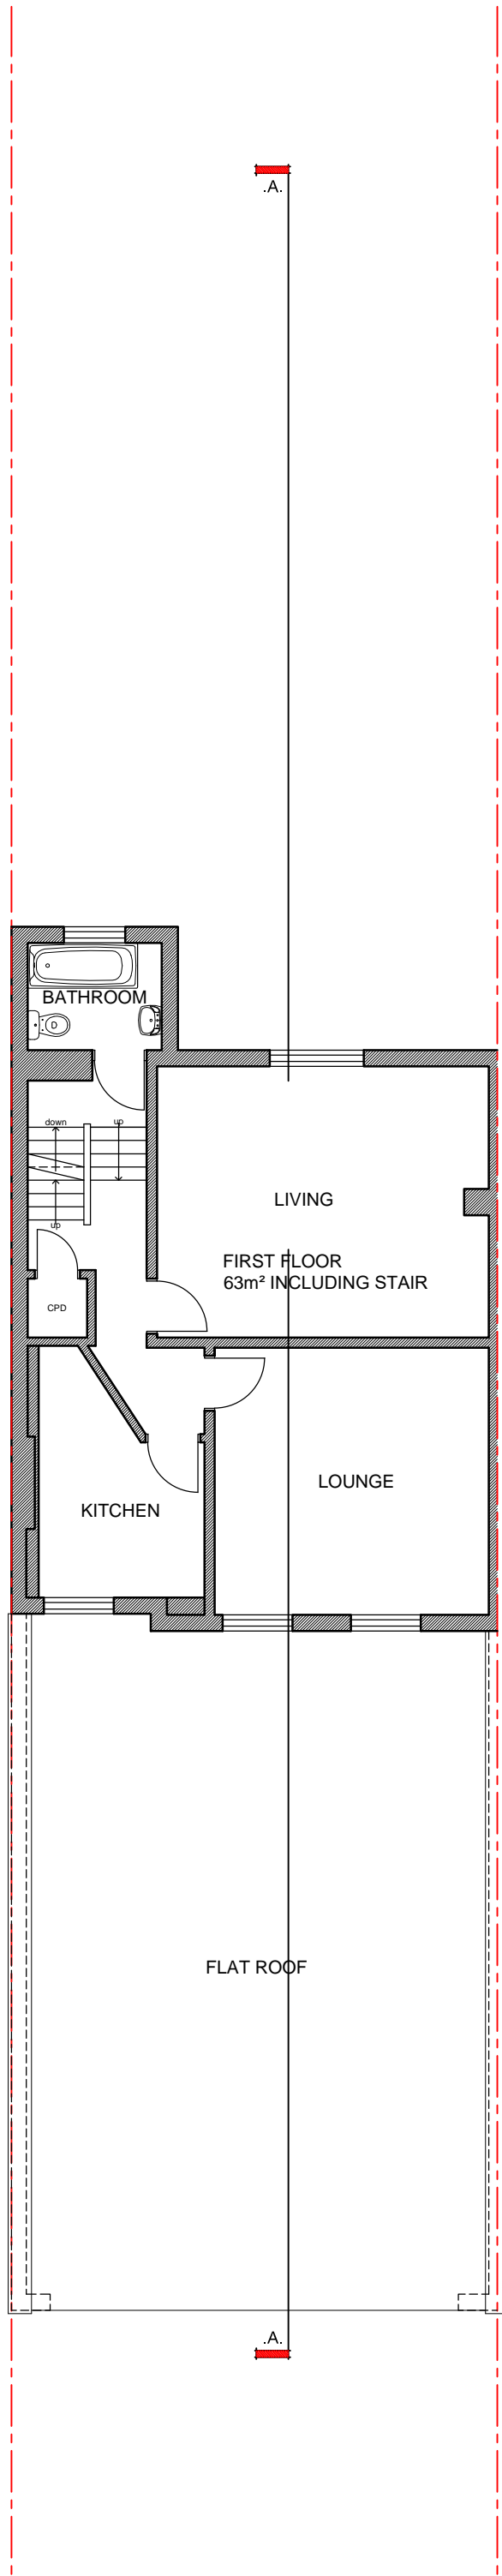

FIRST FLOOR PLAN 1:100

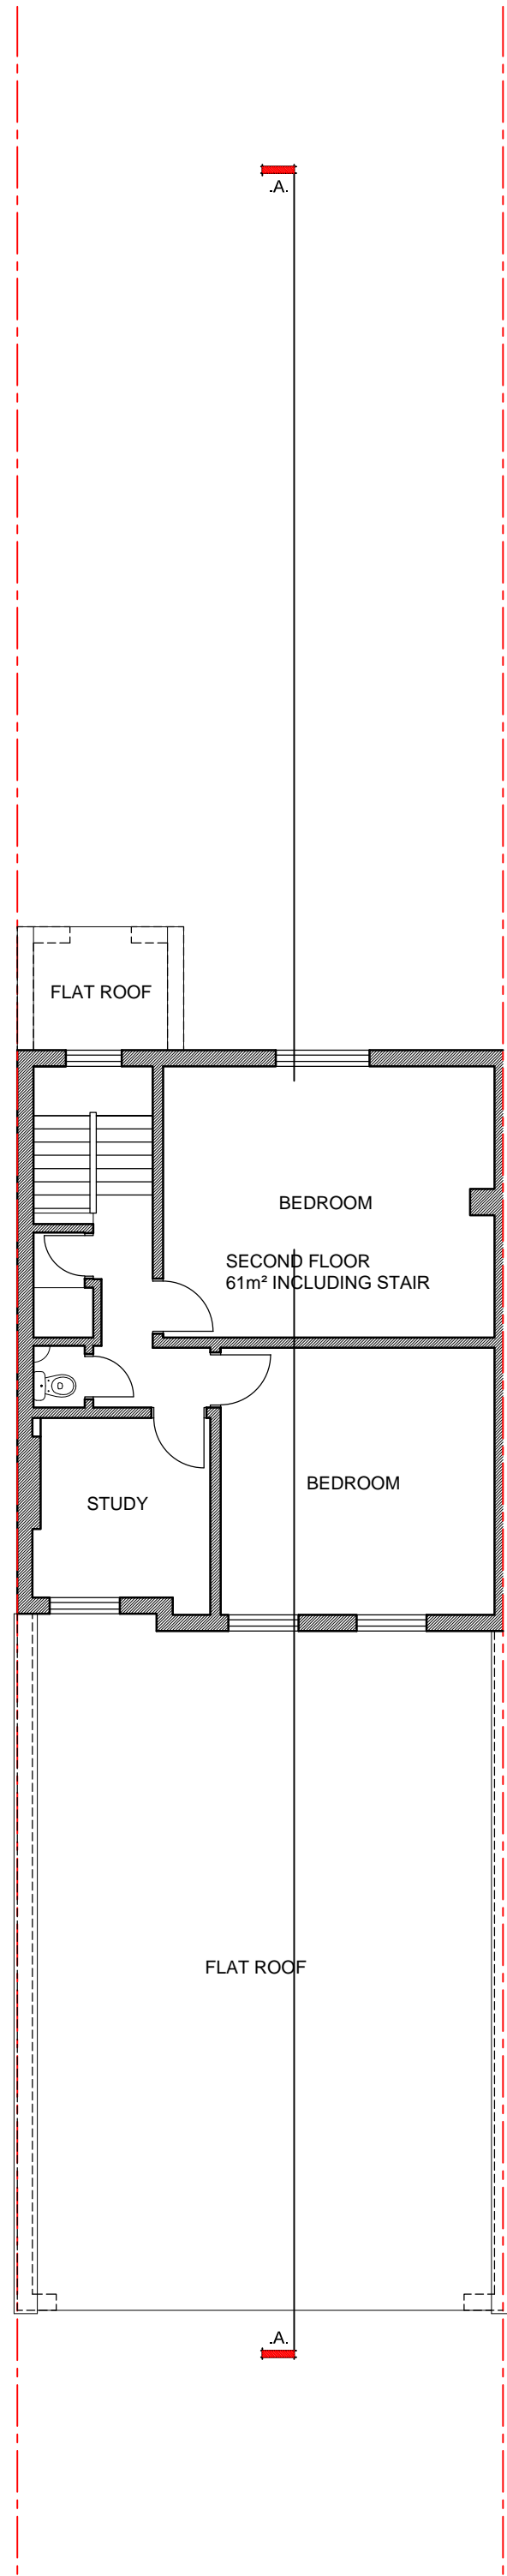

SECOND FLOOR PLAN 1:100

notes:  
Do not scale from this drawing  
All dimensions to be checked on site and any discrepancies reported to the Architect/Contract Administrator before proceeding with the works on site, or off-site fabrication

For Information		
revision	description	date
A	AS-BUILT PHOTOS ADDED	13.12.17
GENESIS ARCHITECTS LTD 7 St Margarets Road, Staines Abbotts Ware Hertfordshire SG12 8EP T: 01920 877998 F: 01920 877998 E: genesisarchitects@btconnect.com W: www.genesisarchitects.ltd.uk		
client	Brecknock Properties Ltd	
project	RESIDENTIAL DEVELOPMENT 43 BRECKNOCK ROAD LONDON N7 0BT	
title	LOCATION PLAN, BLOCK PLAN, FLOOR PLANS	
date	SEPT 17	scale AS SHOWN
drawn	IRMB	
drawing no	GAL 262 (PC) 030	
revision	A	