

DO NOT SCALE FROM THIS DRAWING  
THIS DRAWING IS COPYRIGHT

NOTES:

REVISIONS:

F - AS CONSTRUCTED

PROJECT:  
39A BELSIZE SQUARE  
LONDON NW3 4HL

DRAWING TITLE:  
GARDEN PLAN  
as CONSTRUCTED

Scale:  
1:100@A3

Dwg No:  
BS-PP2

Date:  
15.01.18





Rev:  
F

KASIA WHITFIELD  
*Design Consultant*

Tel: 020 75869624  
Mob: 07985 035333  
email: Kasia\_Whitfield@hotmail.com

# FRONT (SOUTH) ELEVATION

# SIDE (EAST) ELEVATION

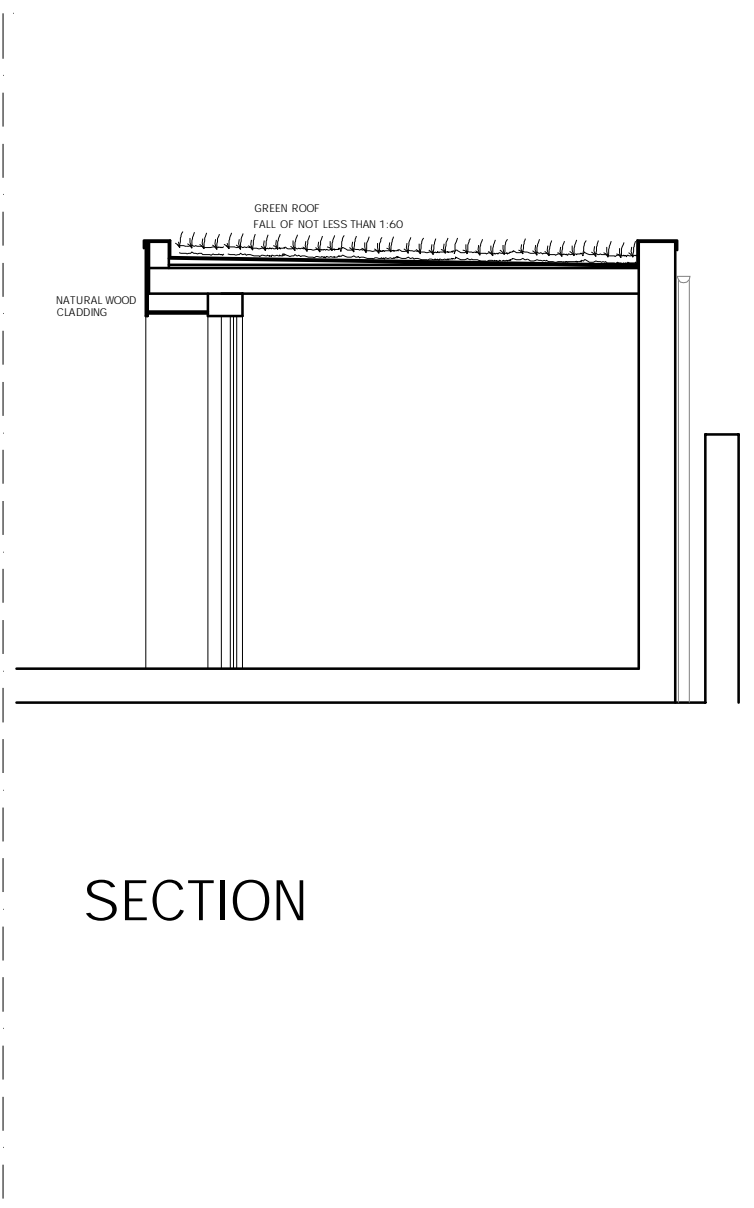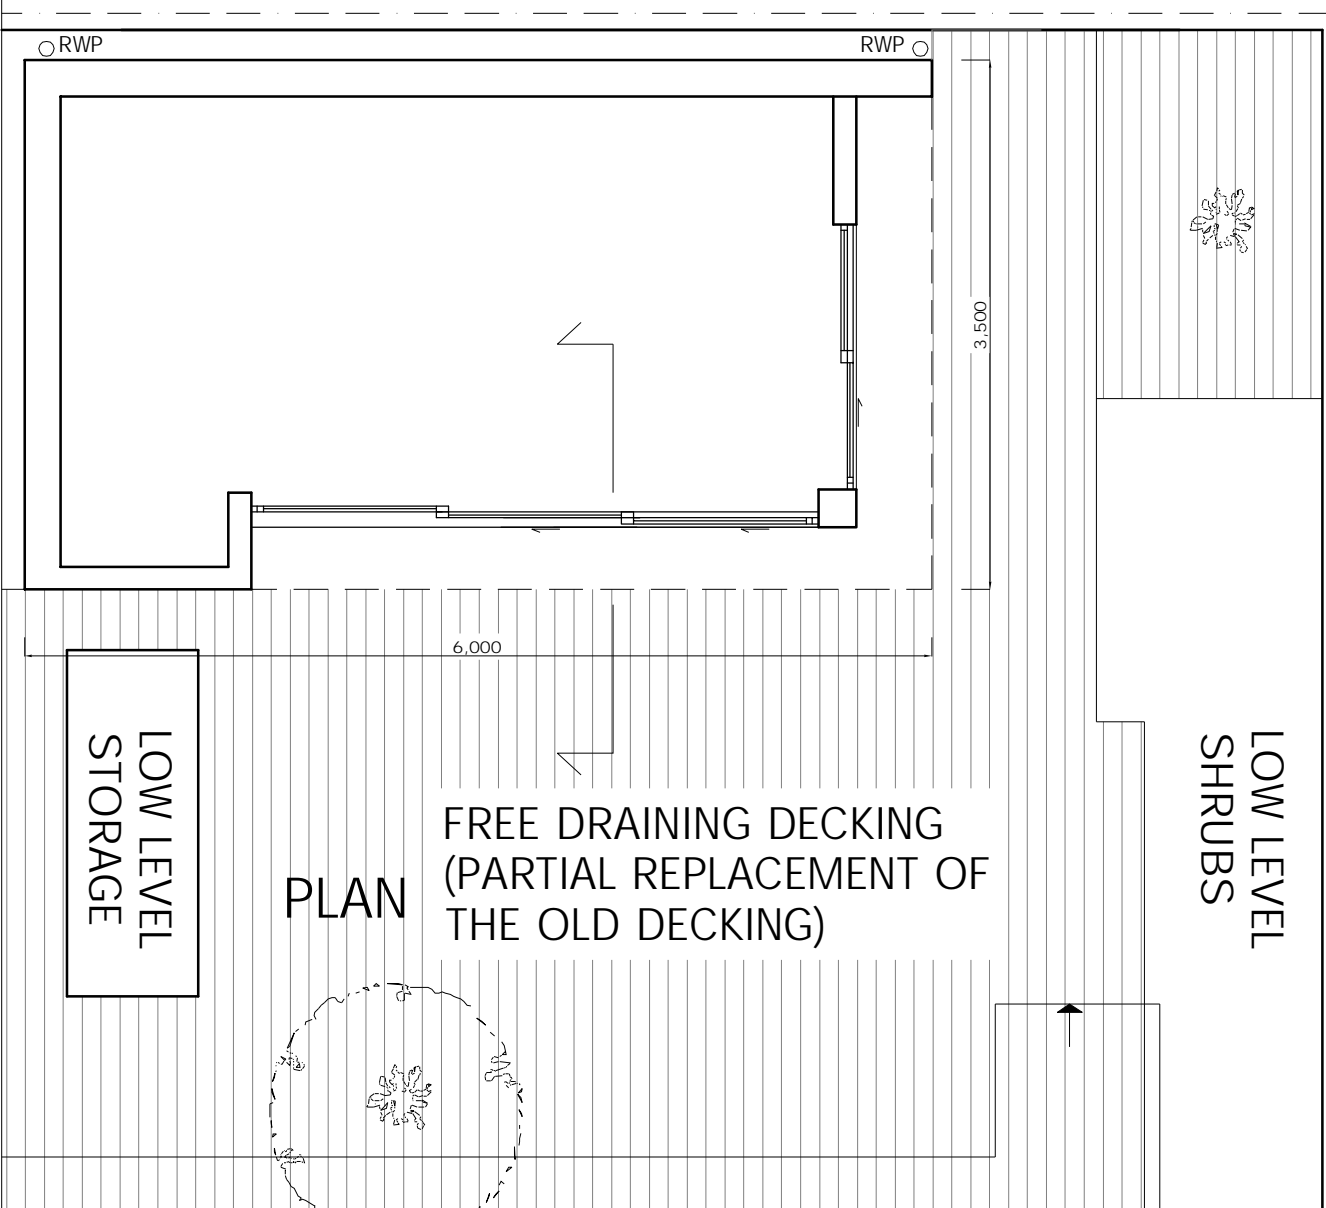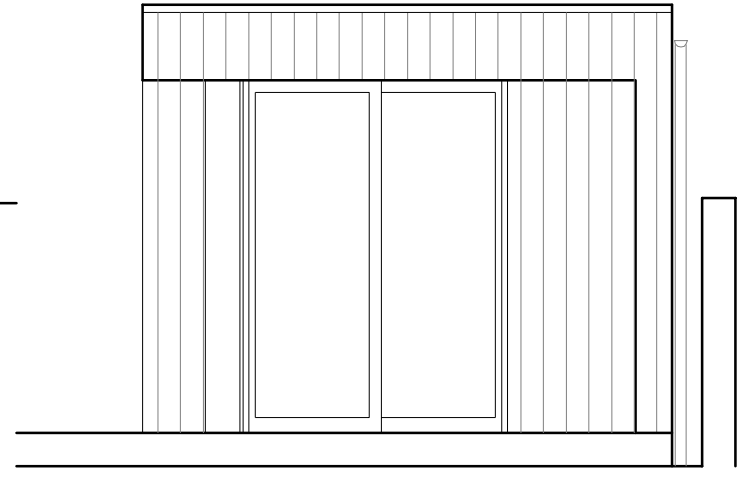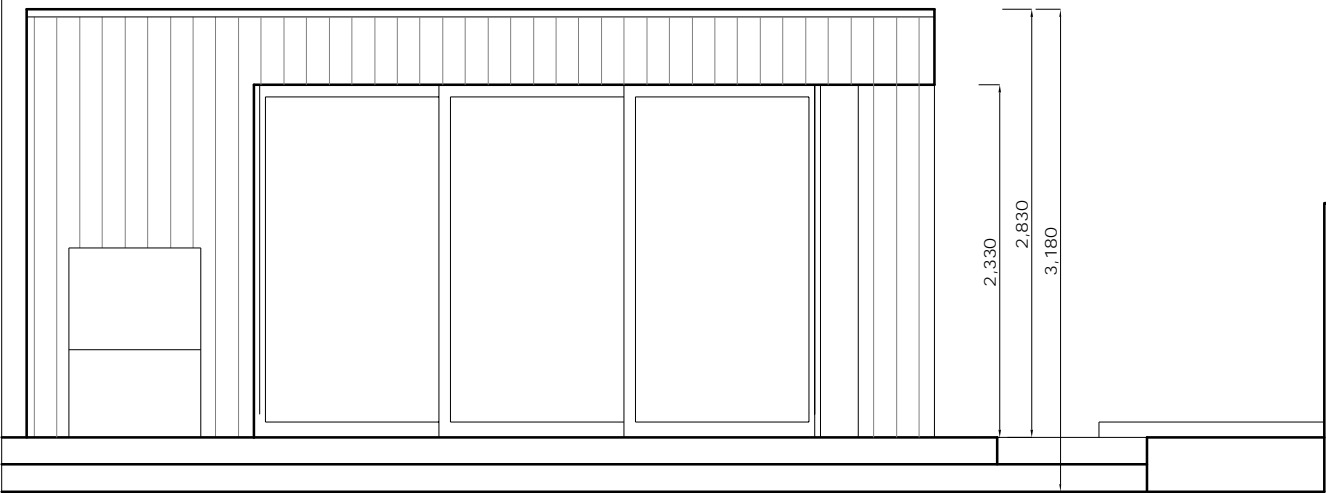

DO NOT SCALE FROM THIS DRAWING THIS DRAWING IS COPYRIGHT	REVISIONS:	PROJECT: 39A BELSIZE SQUARE LONDON NW3 4HL	Scale: 1:50@A3	Date: 15.01.18	KASIA WHITFIELD <i>Design Consultant</i> Tel: 020 75869624 Mob: 07985 035333 email: Kasia_Whitfield@hotmail.com
		DRAWING TITLE: RECREATION HOUSE PLAN, SECTION, ELEVATION as CONSTRUCTED	Dwg No: BS-PP3	Rev: F	
NOTES:					