


107 KINGS
CROSS ROAD

105 KINGS
CROSS ROAD

2 FREDERICK
STREET

Carpenters Arms @ 1:100

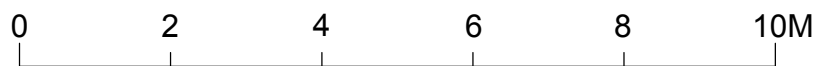


NOTES: The drawings and the design hereon is the copyright of Milan Babic Architects Ltd and must not be reproduced without their written consent.

Figured dimensions only to taken from this drawing. All dimensions to be checked on site and Milan Babic Architects Ltd informed immediately of any discrepancies.

All works to be carried out in accordance with Local Authority approval, Building Regulations and current British Standards

Indicates revisions made to this drawing.

REV	DATE	INITIALS	DESCRIPTION

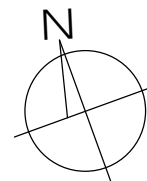

Milan Babic
Architects Ltd

Architects + Urban Designer
Bickel's Yard
151B Bermondsey Street
London SE1 3UW
TEL: (0)203 117 0120
FAX: (0)203 117 0122
E-mail:
milan@mb-architects.co.uk

PROJECT: PROPOSED RESIDENTIAL DEVELOPMENT
Carpenters Arms, 105 Kings Cross Rd
LONDON - WC1X 9LR

CLIENT: **MENDOZA LTD**

DWG TITLE: **Existing Rear Elevation (as built 2017)**

DWG NO: **AB 834 / 207**

DATE: 01.12.2017

SCALE: 1:100 @ A3

DRAWN BY: