


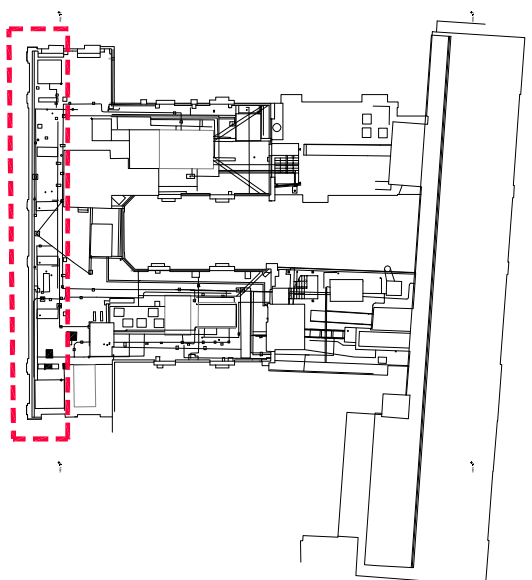


Key Plan

South Elevation


Demolition Key

----- Dashed red line denotes demolition

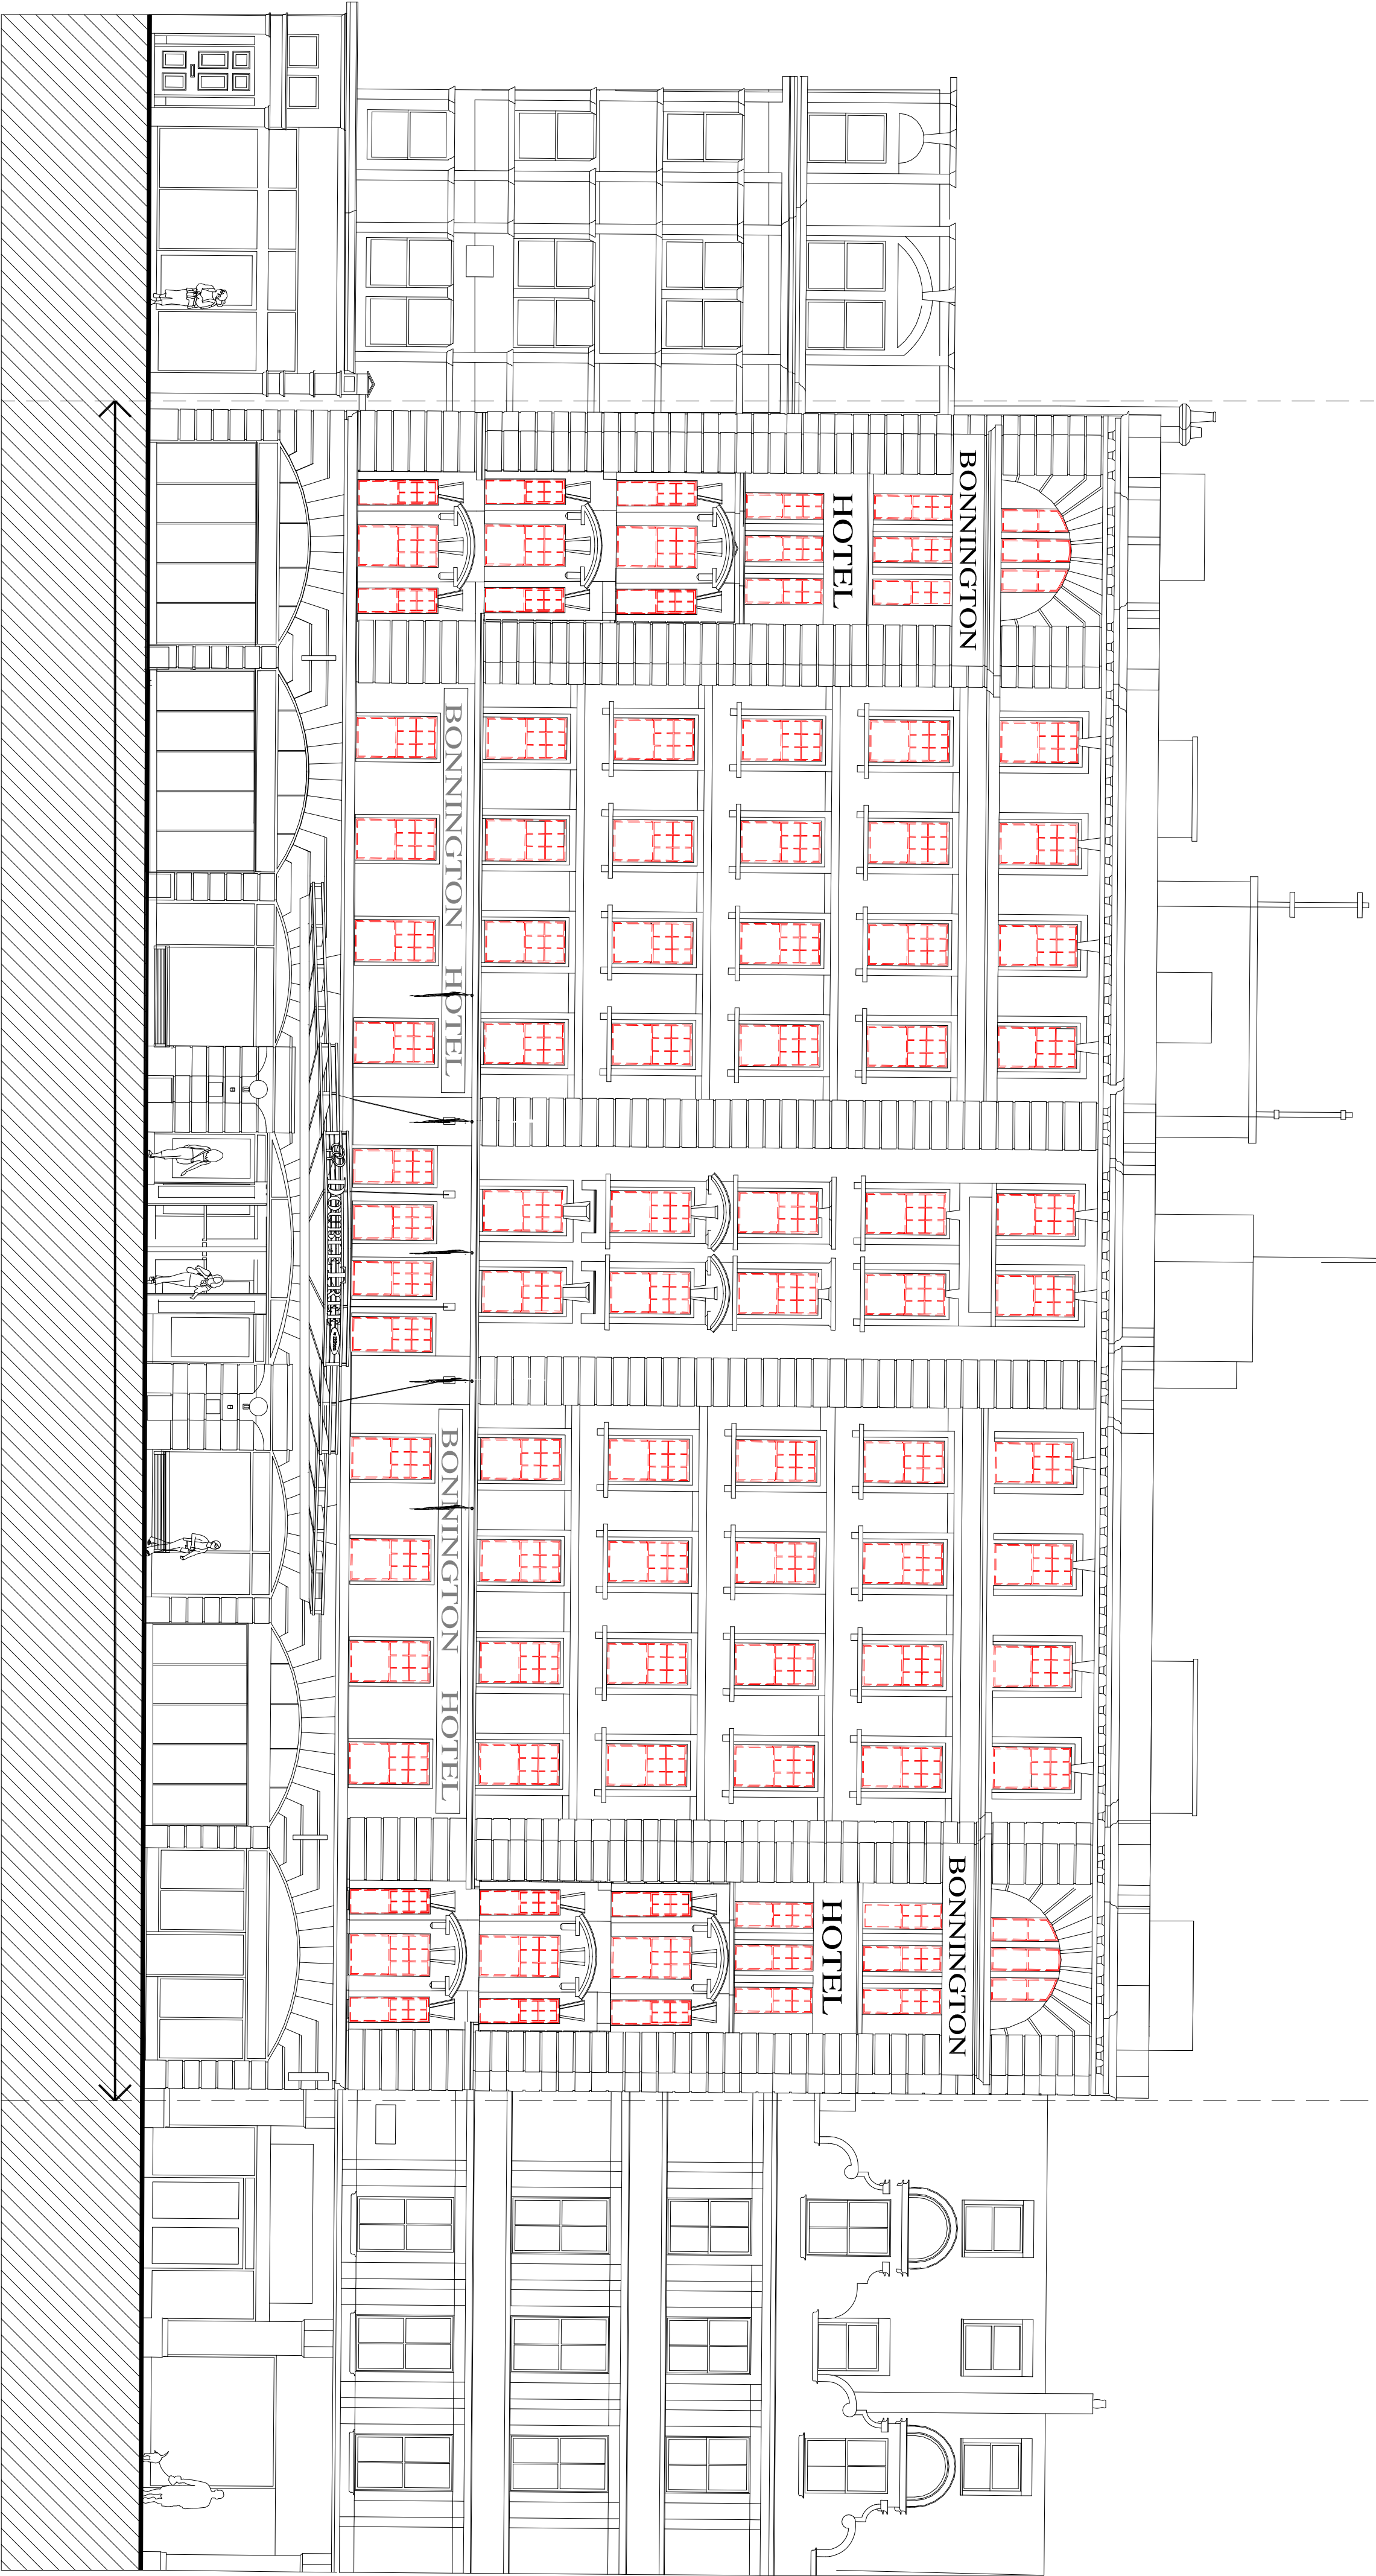

APPLICATION SITE

South Elevation - 1:100

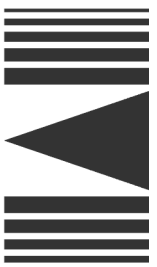

MORRISON DESIGN
CHARTERED ARCHITECTS

St Almunds House, 103 Belper Road, Derby DE1 3ES

T: 01332 263356 F: 01332 291441 E: architect@morrisondesign.co.uk

Job Title

Doubletree by Hilton, London West End

For Crimson Hotels

Drawing Title

South Elevation Demolition

File Ref:

Project drawings:

Scale: 1:100@A1 Drawn: TSJ Date: 19/12/17

Job No. Drawing No. Revision

38298 062

PLANNING SUBMISSION