


Area bubbled
is subject area of
application
Area consented
as 'storage'
under 2010/5763/L
is now used as a
shower.

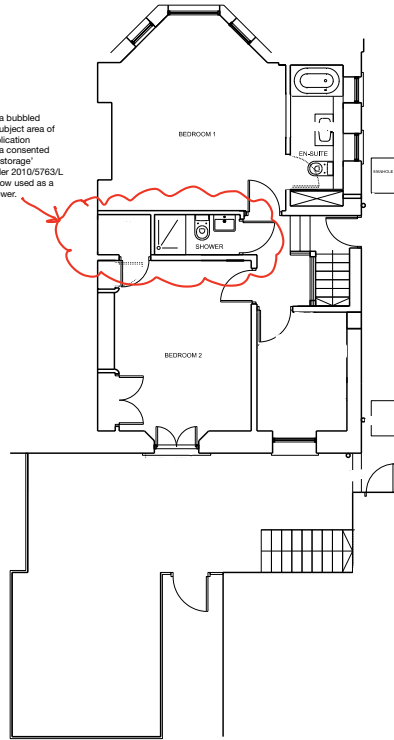

BASEMENT 1:50

Date	Rev	Revisions	Key Plan	Notes	Designer
					HOME EXTENSION STUDIO
					Project 6 OAK COURT
					Drawing title AS BUILT PLAN
					Client E ALVARES
					Scale at A1 1:50
					Scale at A3 1:100
					Drawn
					Date
					Job no.
					Drawing no. Rev
					SK007

Layout subject to further design development of structural and services coordination & full survey.
Suggested methods of construction are to aid in pricing only and any construction methods and techniques are to be built to the contractors own design and to be compliant with the current building regulations.
This drawing is the property of Home Extension Studio
No disclosure or copy of it may be made without the written permission of Home Extension Studio