


GENERAL NOTES:
 1. DO NOT SCALE FROM THIS DRAWING. DIMENSIONS GOVERN.
 2. ALL DIMENSIONS ARE IN MILLIMETRES UNLESS NOTED OTHERWISE.
 3. ALL DIMENSIONS SHALL BE VERIFIED ON SITE BEFORE PROCEEDING WITH THE WORK.
 4. PLINCKE SHALL BE NOTIFIED IN WRITING OF ANY PROBLEMS.
 5. PLINCKE ACCEPTS NO LIABILITY FOR ANY EXPENSE LOSS OR DAMAGE OF WHATSOEVER NATURE AND HOWSOEVER ARISING FROM ANY VARIATION MADE TO THE DRAWING OR IN THE EXECUTION OF THE WORK TO WHICH IT RELATES WHICH HAS NOT BEEN REFERRED TO THEM AND THEIR APPROVAL OBTAINED.

A1 Original Sheet Size
 0mm 50mm

KEY PLAN

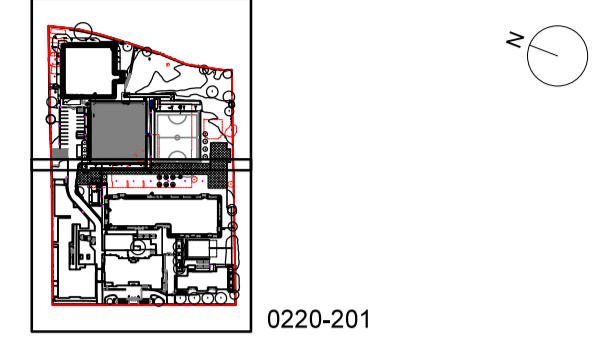

CDM:
 IN ADDITION TO THE HAZARDS / RISKS NORMALLY ASSOCIATED WITH THE TYPES OF WORK DETAILED ON THIS DRAWING, NOTE THE FOLLOWING:

ITEM NO.	RISK REGISTER DETAILS

KEY:

HARDWORKS	SITE FURNITURE, FITTINGS & EQUIPMENT
[Symbol] SITE BOUNDARY	[Symbol] CYCLE STAND
[Symbol] EXISTING REMOVED SCHOOL BUILDING AND TREES	[Symbol] CYCLE SHELTER
[Symbol] EXISTING TREE RPA REFER TO ARBORISTS DWGS	[Symbol] TREE GRILLE
[Symbol] HAND DIG ZONE TO EXISTING RPA REFER TO ARBORICULTURIST REPORT & METHOD STATEMENT FOR DETAILS	[Symbol] HANDRAILS (TO ALL STAIRS)
[Symbol] DRAINAGE CHANNEL TO ENGINEERS DETAILS	[Symbol] DOOR BARRIERS
[Symbol] DRAINAGE GULLY TO ENGINEERS DETAILS	[Symbol] EXTERNAL TAP POINT TO ENGINEERS DETAILS
[Symbol] LAND FILTER DRAIN TO ENGINEERS DETAILS	[Symbol] CYCLE SPLITTER
[Symbol] EXISTING WALL FEATURE / EDGE RETAINED	[Symbol] BOLLARD -FIXED
[Symbol] PCC UPSTAND BN KERB	[Symbol] BOLLARD -REMOVABLE
[Symbol] PCC FLUSH KERB	[Symbol] SITE FENCING
[Symbol] PCC PIN KERB	[Symbol] 3.0M HT SPORTS WELDMESH FENCE
[Symbol] TIMBER EDGING BOARD	[Symbol] 2.4M HT WELDMESH FENCE
[Symbol] VEHICULAR ASPHALT TO ENGINEERS DETAILS	[Symbol] 2.2M HT TIMBER HIT & MISS FENCE
[Symbol] PEDESTRIAN ASPHALT TO ENGINEERS DETAILS	[Symbol] 1.8M HT TIMBER PALLISADE FENCE
[Symbol] PERMEABLE ASPHALT	[Symbol] 1.1M HT BALUSTRADE
[Symbol] ARTIFICIAL GRASS	[Symbol] TEMPORARY TIMBER POST & 3 WIRE TO HEDGES
[Symbol] COLOURBY TACTILE PAVING - BUFF COLOUR	[Symbol] 2.2M HT SPORTS WELDMESH FENCE
[Symbol] THERMOPLASTIC LINE MARKINGS (PARKING BAYS) AND ROAD MARKINGS	[Symbol] EXTERNAL LIGHTING COLUMN - DETAILS TO M&E ENGINEER
[Symbol] SPORTS LINE MARKINGS	
[Symbol] DETERRENT PAVING	
[Symbol] IN SITU CONCRETE PAVING	
[Symbol] IN SITU CONCRETE STEPS (ALL STEPS ILLUSTRATED)	
[Symbol] CONCRETE RETAINING WALL - HEIGHT VARIES	
[Symbol] EMERGENCY VEHICLE ACCESSIBLE AREA	
[Symbol] VEHICULAR GRADE ASPHALT	

GATE SCHEDULE

NO.	HT	TYPE	CO.	FENCE NO.
G1	3000 SL	2105 FE1	2 no	
G2	3000 SL	1760 FE1	1 no	
G3	2400 DL	3705 FE2	1 no	
G4	2400 DL	2225 FE2	3 no	
G5	2200 DL	1500 FE3	1 no	
G6	1600 SL	1600 FE4	2 no	

NOTES:
 TO BE READ IN CONJUNCTION WITH 0220-FLASH-001 OUTLINE SPECIFICATION



00	AS BUILT	22.01.18	YB	CK
C06	Bin store area	27.10.17	CK	CJ
C05	Gate schedule amended. Lump columns added	25.10.17	CK	CJ
C04	Various minor amendments as clouded	16.10.17	CK	CJ
C03	E01 changed to E02 as clouded	30.03.16	CK	CJ
C02	Gate(G6) location and door location adjusted	14.03.16	CK	CJ
C01	Team comments incorporated	03.02.16	MT	CJ
C00	CONSTRUCTION ISSUE	14.12.15	AS	CJ
P01	Minor Amendments	21.05.15	PA	CJ
REV	REVISION	DATE	DWN	APPD

plincke.
 landscape urbanism design
 London +44 (0)207 739 3330
 Manchester +44 (0)161 237 9223
 www.plincke.com

Project:
 HAMPSTEAD SECONDARY SCHOOL
 WESTBERE ROAD

Drawing:
 HARDWORKS PLAN 01

Date: 01.05.15
Scale: 1:200

Status: AS BUILT
Drn: PA
App'd: CJ

Drawing No: 0220-201
Rev: 00