


GENERAL NOTES:  
 1. DO NOT SCALE FROM THIS DRAWING. DIMENSIONS GOVERN.  
 2. ALL DIMENSIONS ARE IN MILLIMETRES UNLESS NOTED OTHERWISE.  
 3. ALL DIMENSIONS SHALL BE VERIFIED ON SITE BEFORE PROCEEDING WITH THE WORK.  
 4. PLINCKE SHALL BE NOTIFIED IN WRITING OF ANY DISCREPANCIES.  
 5. PLINCKE ACCEPTS NO LIABILITY FOR ANY EXPENSE LOSS OR DAMAGE OF WHATSOEVER NATURE AND HOWSOEVER ARISING FROM ANY VARIATION MADE TO THIS DRAWING OR IN THE EXECUTION OF THE WORK TO WHICH IT RELATES WHICH HAS NOT BEEN REFERRED TO THEM AND PRIOR APPROVAL OBTAINED.

**A1** Original Sheet Size  
 0mm 50mm

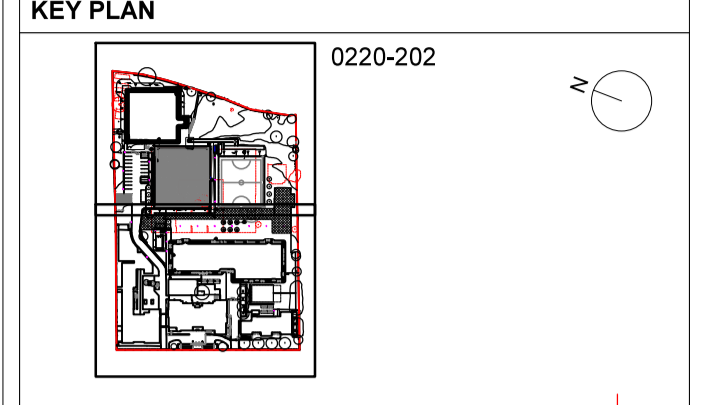

**CDM:**  
 IN ADDITION TO THE HAZARDS / RISKS NORMALLY ASSOCIATED WITH THE TYPES OF WORK DETAILED ON THIS DRAWING, NOTE THE FOLLOWING:

ITEM NO.	RISK REGISTER DETAILS

**KEY:**

SITE BOUNDARY	SITE FURNITURE, FITTINGS & EQUIPMENT
EXISTING REMOVED SCHOOL BUILDING AND TREES	CYCLE STAND
EXISTING TREE RPA - REFER TO ARBORISTS DWGS	CYCLE SHELTER
HAND DIG ZONE TO EXISTING RPA - REFER TO ARBORICULTURIST REPORT & METHOD STATEMENT FOR DETAILS	TREE GRILLE
DRAINAGE CHANNEL - TO ENGINEERS DETAILS	HANDRAILS (TO ALL STAIRS)
DRAINAGE GULLY - TO ENGINEERS DETAILS	DOOR BARRIERS
LAND FILTER DRAIN - TO ENGINEERS DETAILS	EXTERNAL TAP POINT - TO ENGINEERS DETAILS
EXISTING WALL FEATURE / EDGE RETAINED	CYCLE SPLITTER
PCC UPSTAND BN KERB	BOLLARD - FIXED
PCC FLUSH KERB	BOLLARD - REMOVABLE
PCC PIN KERB	SITE FENCING
TIMBER EDGING BOARD	3.0M HT SPORTS WELDMESH FENCE
VEHICULAR ASPHALT - TO ENGINEERS DETAILS	2.4M HT WELDMESH FENCE
PEDESTRIAN ASPHALT - TO ENGINEERS DETAILS	2.2M HT TIMBER HIT & MISS FENCE
PERMEABLE ASPHALT	1.8M HT TIMBER PALISADE FENCE
ARTIFICIAL GRASS	1.1M HT BALUSTRADE
COLOURBY TACTILE PAVING - BUFF COLOUR	TEMPORARY TIMBER POST & 3 WIRE TO HEDGES
THERMOPLASTIC LINE MARKINGS (PARKING BAYS) AND ROAD MARKINGS	2.2M HT SPORTS WELDMESH FENCE
SPORTS LINE MARKINGS	EXTERNAL LIGHTING COLUMN - DETAILS TO M&E ENGINEER
DETERRANT PAVING	GATE SCHEDULE
IN SITU CONCRETE PAVING	NO. HT. TYPE CO. FENCE NO.
IN SITU CONCRETE STEPS (ALL STEPS ILLUSTRATED)	G1 3000 SL 2100 FE1 2 no
CONCRETE RETAINING WALL - HEIGHT VARIES	G2 3000 SL 1700 FE1 1 no
EMERGENCY VEHICLE ACCESSIBLE AREA - VEHICULAR GRADE ASPHALT	G3 2400 DL 3705 FE1 1 no
	G4 2400 DL 2225 FE2 3 no
	G5 2200 DL 1500 FE3 1 no
	G6 1600 SL 1600 FE4 2 no

**NOTES:**  
 TO BE READ IN CONJUNCTION WITH 0220-FASH-01 OUTLINE SPECIFICATION



NO.	HT.	TYPE	CO.	FENCE	NO.
G1	3000	SL	2100	FE1	2 no
G2	3000	SL	1700	FE1	1 no
G3	2400	DL	3705	FE1	1 no
G4	2400	DL	2225	FE2	3 no
G5	2200	DL	1500	FE3	1 no
G6	1600	SL	1600	FE4	2 no

**plincke.**  
 landscape urbanism design  
 London +44 (0)207 739 3330  
 Manchester +44 (0)161 237 9223  
 www.plincke.com

**Project:**  
 HAMPSTEAD SECONDARY SCHOOL  
 WESTBERE ROAD

**Drawing:**  
 HARDWORKS PLAN 02

**Date:** 01.05.15  
**Scale:** 1:200

**Status:** AS BUILT  
**PA:** PA  
**App'd:** App'd

**Drawing No:** 0220-202  
**Rev:** 00