



AS-BUILT AS AT JANUARY 2018

Centre line of Party Wall

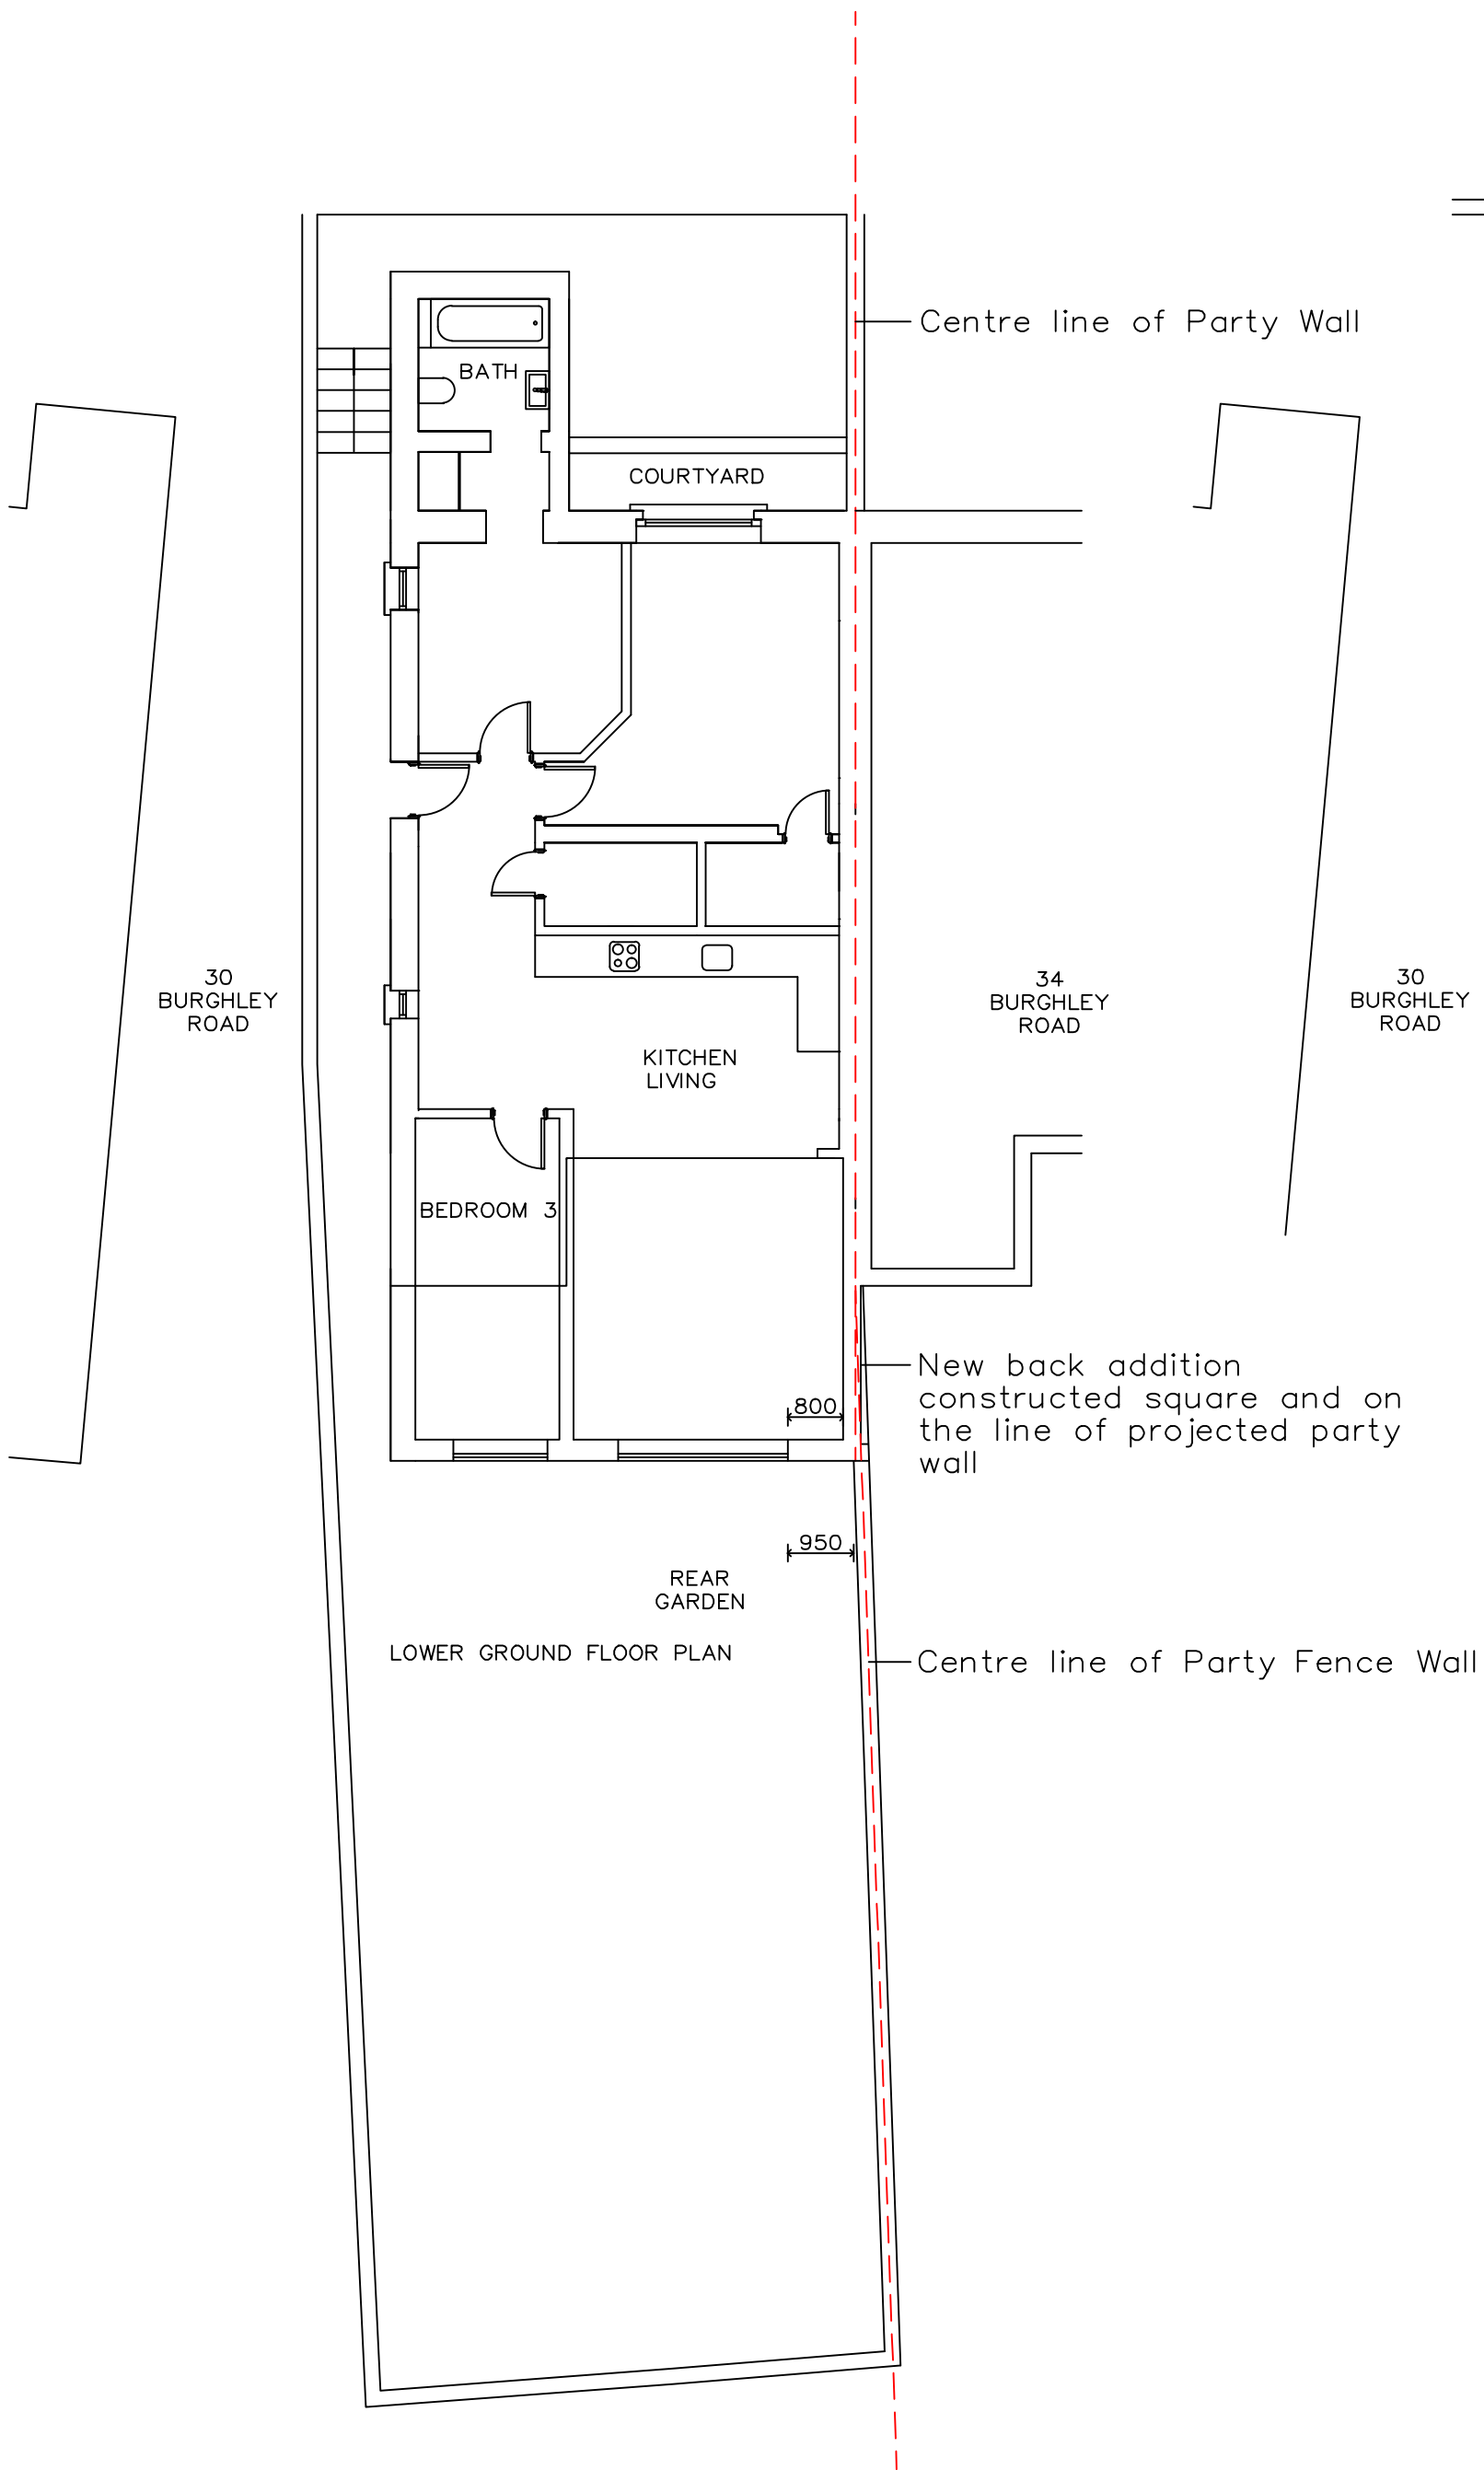

LOWER GROUND FLOOR PLAN

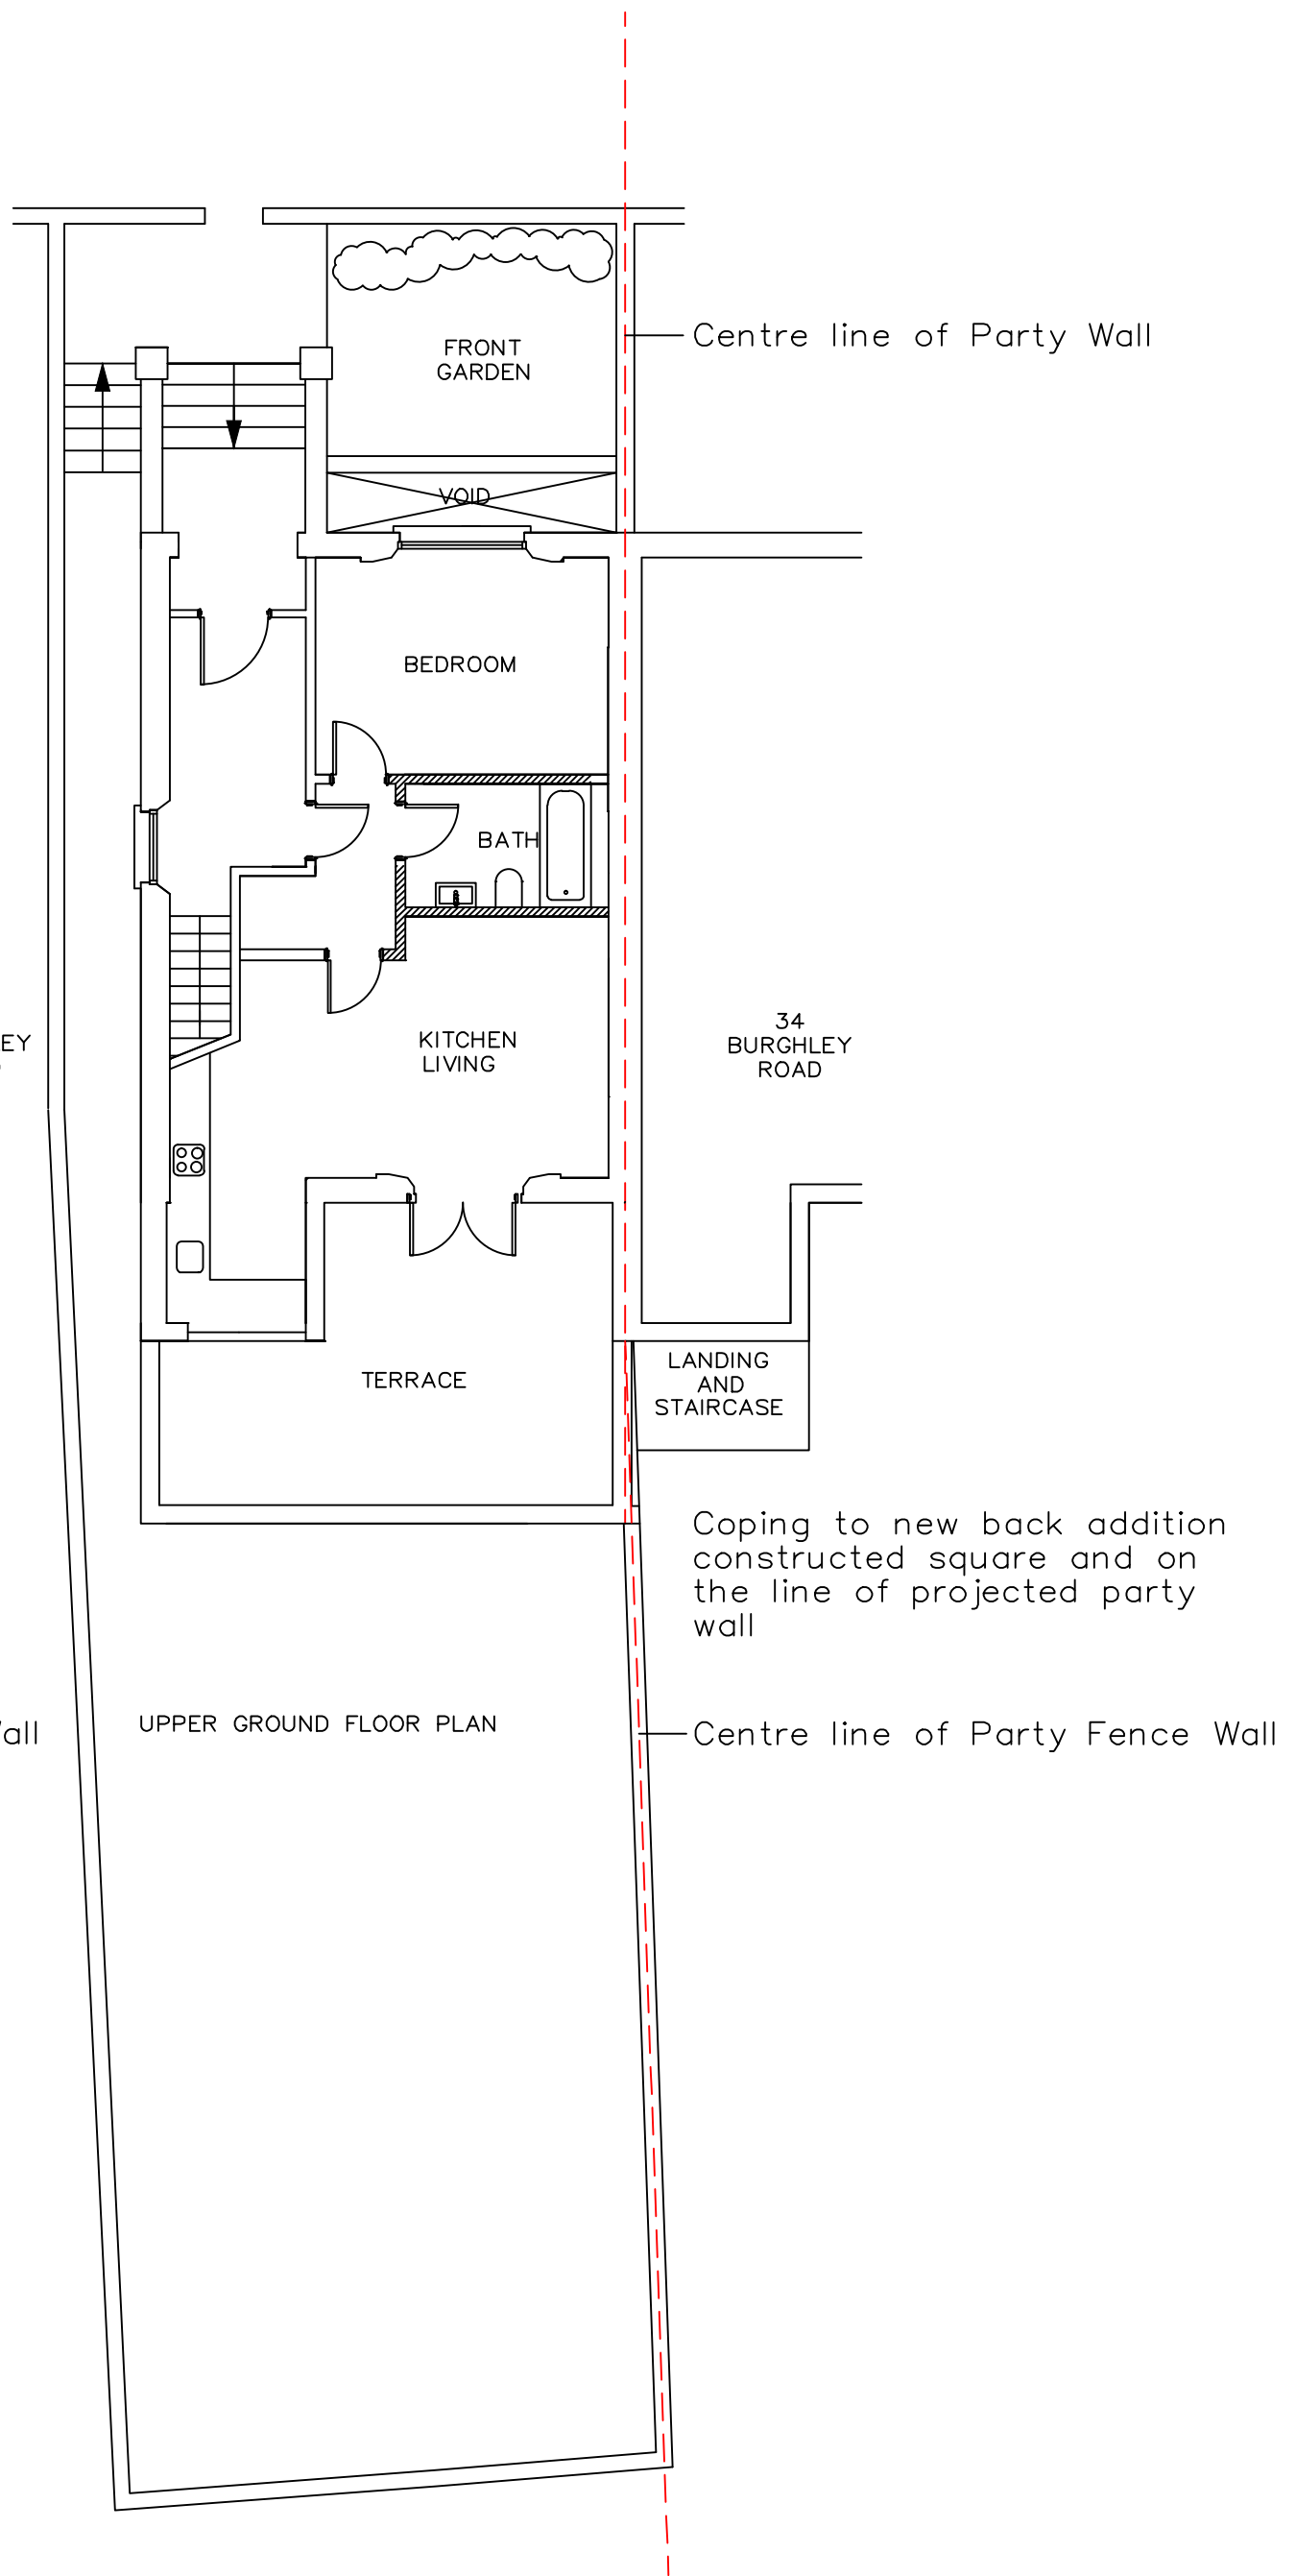

UPPER GROUND FLOOR PLAN