



**Notes:**  
 This drawing is protected by copyright. No part of this document may be reproduced, altered, or transmitted in any form or by any means without permission.  
 Do not scale off these drawings for construction purposes. If any discrepancies are found, please contact Proctor Watts Cole Rutter.

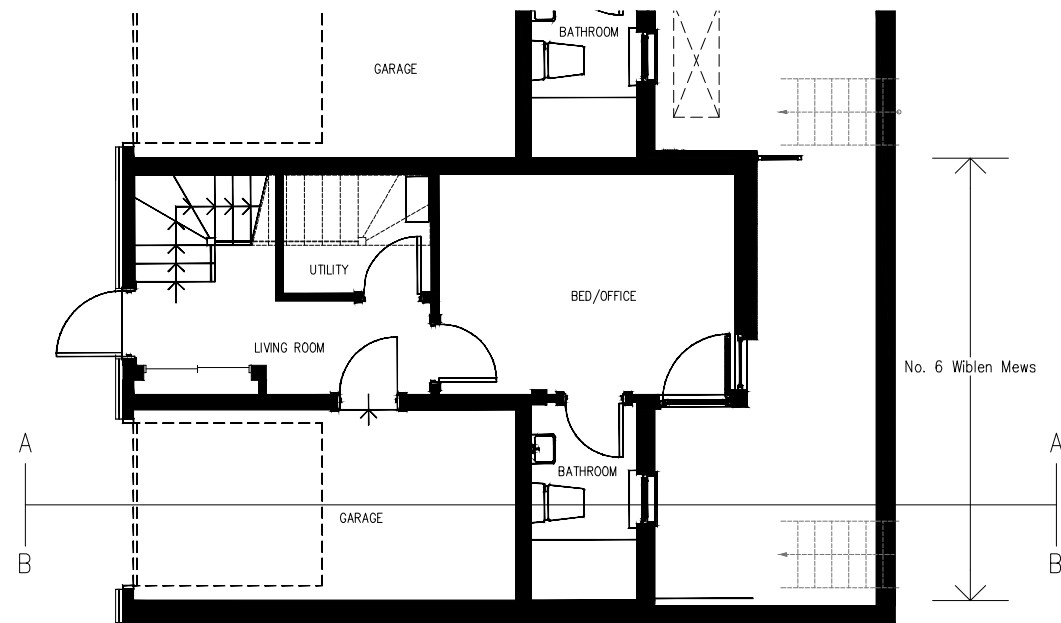

**Lower Ground Floor Plan**  
 Scale 1:100




**Ground Floor Plan**  
 Scale 1:100

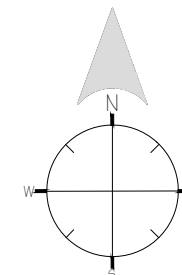


Rev.	Description:	By	Date
-	-	-	-
Client: Four Quarters Construction		Drawn By:	JP
Title: As Built Lower and Ground Floor Plans		Checked By:	-
Project: 6 Wiblin Mews, College Lane, Kentish Town, London		Scale:	1:100@A3
		Date:	02 Feb 2018
Job No:	Dwg No:	Revision:	
4672(18)	S01	-	

**Proctor Watts Cole Rutter**  
 Chartered Architects & Town Planners  
 Grosvenor House, Bleke Street, Shaftesbury, Dorset, SP7 8AW.  
 Phone: 01747 851881 Fax: 01747 851081  
 mail@pwcr.co.uk www.pwcr.co.uk



**Notes:**  
 This drawing is protected by copyright. No part of this document may be reproduced, altered, or transmitted in any form or by any means without permission.  
 Do not scale off these drawings for construction purposes. If any discrepancies are found, please contact Proctor Watts Cole Rutter.

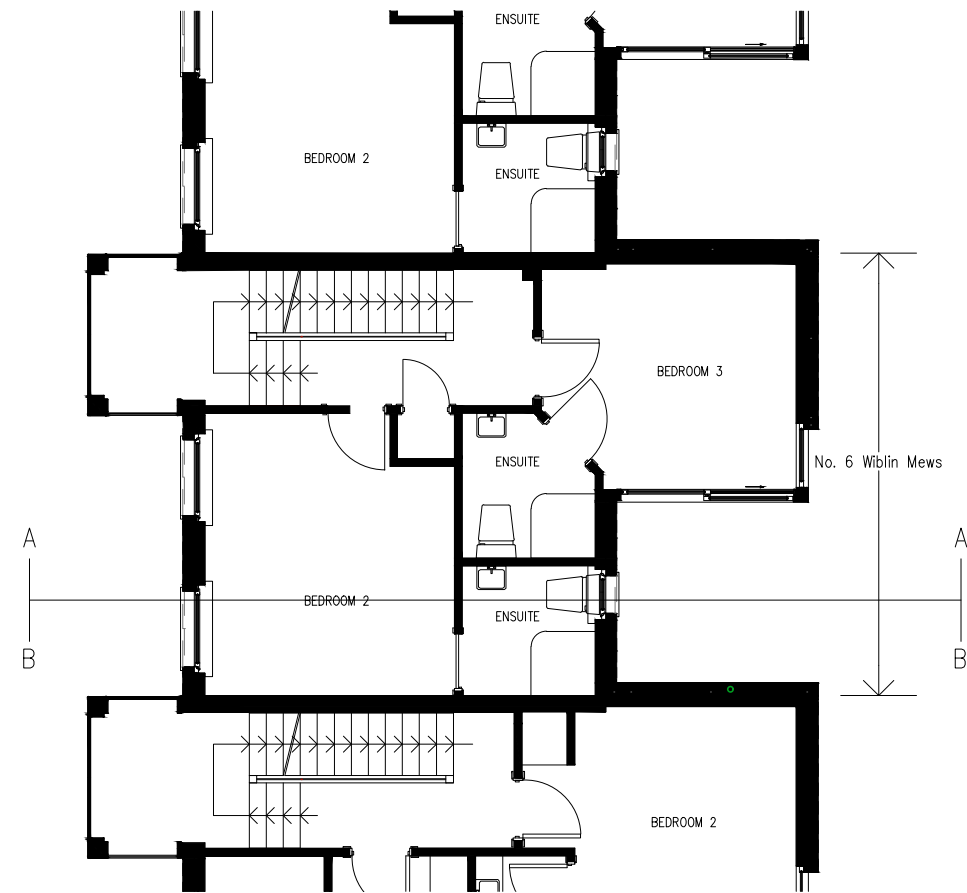

**First Floor Plan**  
 Scale 1:100

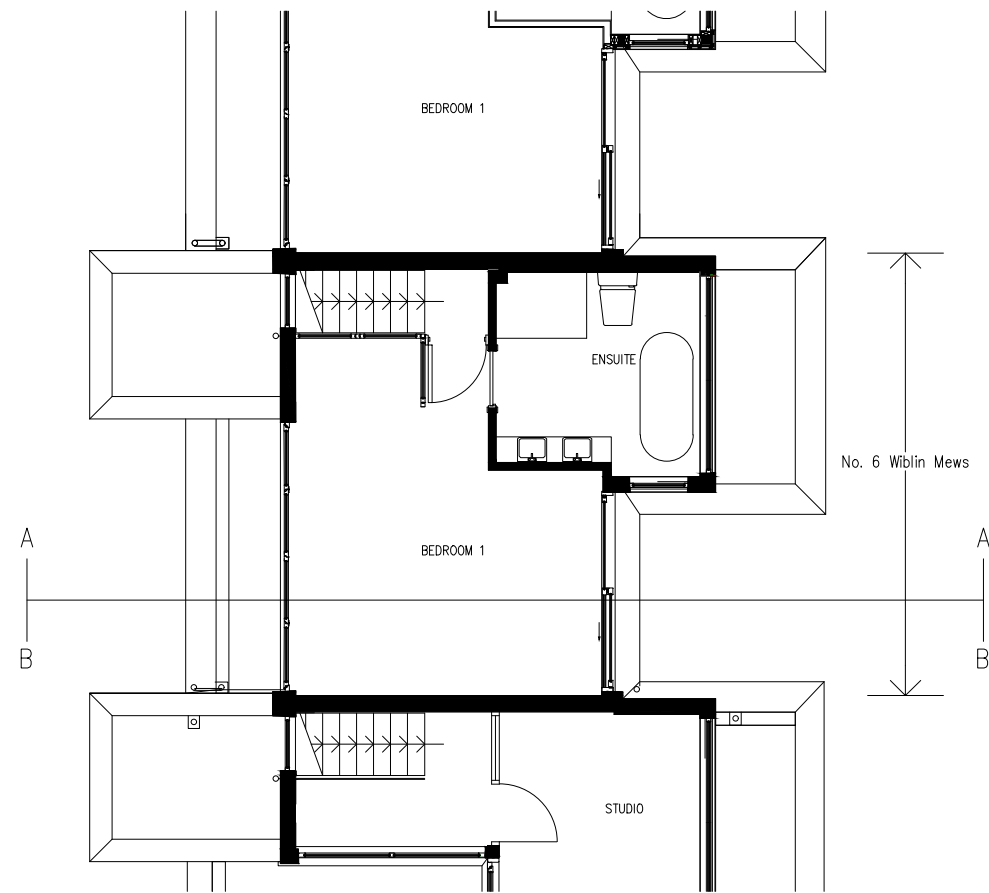


**Second Floor Plan**  
 Scale 1:100

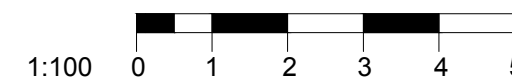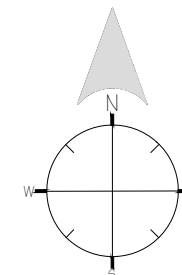


Rev.	Description:	By	Date
-	-	-	-
Client: Four Quarters Construction		Drawn By:	JP
Title: As Built Lower and Ground Floor Plans		Checked By:	-
Project: 6 Wiblin Mews, College Lane, Kentish Town, London		Scale: 1:100@A3	Date: 02 Feb 2018
Job No: 4672(18)	Dwg No: S02	Revision:	-

**Notes:**  
 This drawing is protected by copyright. No part of this document may be reproduced, altered, or transmitted in any form or by any means without permission.  
 Do not scale off these drawings for construction purposes. If any discrepancies are found, please contact Proctor Watts Cole Rutter.

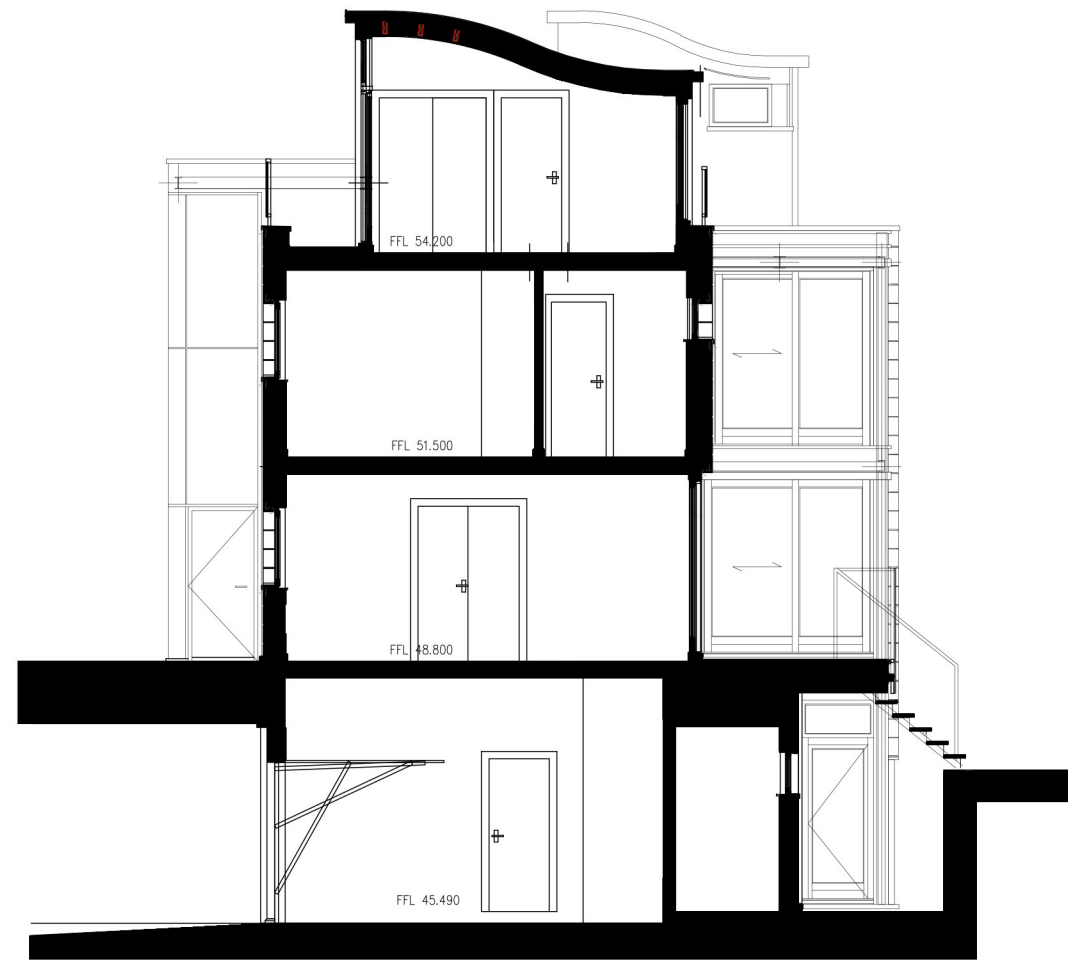

**Section A-A**  
 Scale 1:100

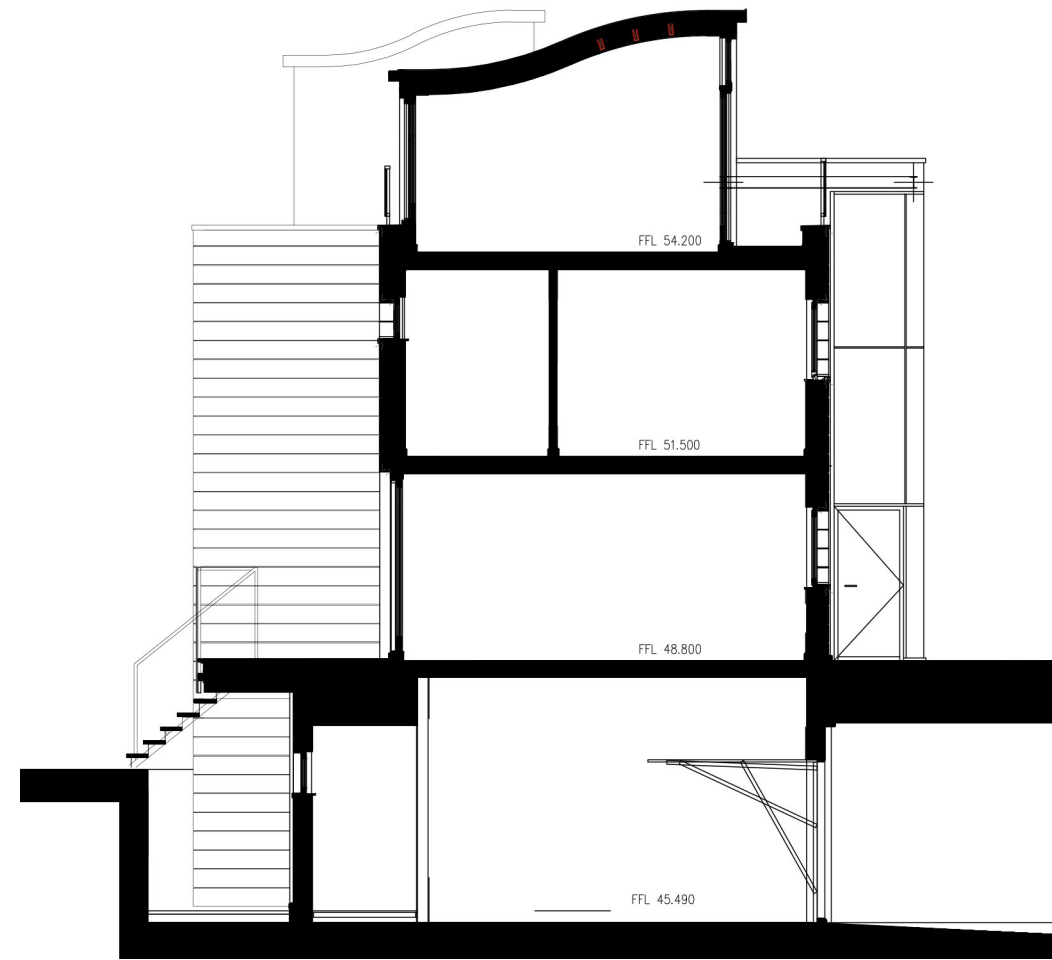

**Section B-B**  
 Scale 1:100



Rev.	Description:	By	Date
-	-	-	-
Client: Four Quarters Construction		Drawn By:	JP
Title: As Built Section		Checked By:	-
Project: 6 Wiblin Mews, College Lane, Kentish Town, London		Scale:	1:100@A3
		Date:	02 Feb 2018
Job No:	Dwg No:	Revision:	
4672(18)	S03	-	

**Proctor Watts Cole Rutter**  
 Chartered Architects & Town Planners  
 Grosvenor House, Bleke Street, Shaftesbury, Dorset, SP7 8AW.  
 Phone: 01747 851881 Fax: 01747 851081  
 mail@pwcr.co.uk www.pwcr.co.uk

**Notes:**  
 This drawing is protected by copyright. No part of this document may be reproduced, altered, or transmitted in any form or by any means without permission.  
 Do not scale off these drawings for construction purposes. If any discrepancies are found, please contact Proctor Watts Cole Rutter.



**South East Elevation**  
 Scale 1:100

Rev.	Description:	By	Date
-	-	-	-
Client: Four Quarters Construction		Drawn By: JP	
Title: As Built Elevation		Checked By: -	
Project: 6 Wiblin Mews, College Lane, Kentish Town, London		Scale: 1:100@A3	Date: 02 Feb 2018
Job No: 4672(18)	Dwg No: S04	Revision: -	

