



RT 01

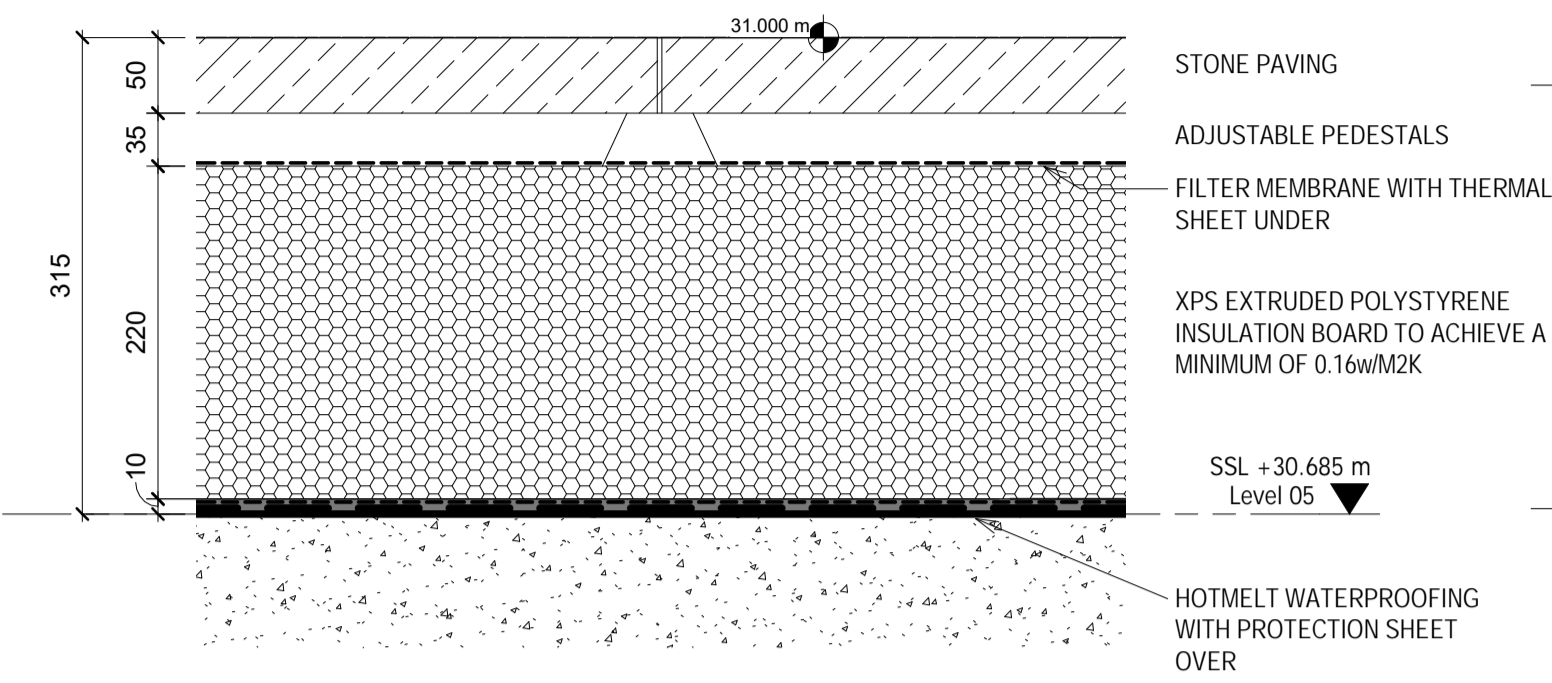

1 RT01 - Level 05 Roof terrace
1:5


RT 08

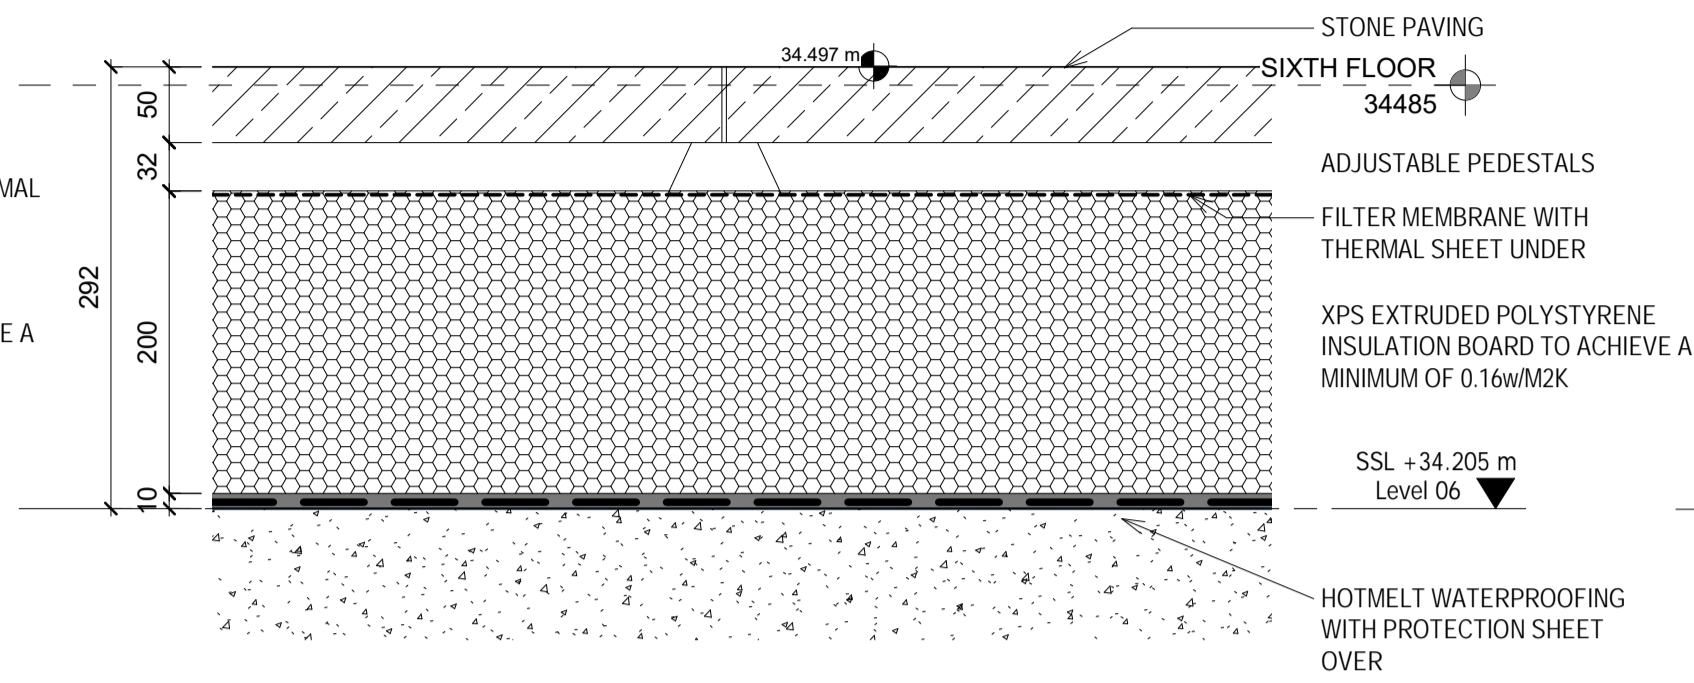

8 RT08 - Level 06 reduced build up for DDA
1:5

RT 09


DETAIL SOLUTION TBC,
PENDING CONFIRMATION OF
VIP BUILD UP THICKNESS

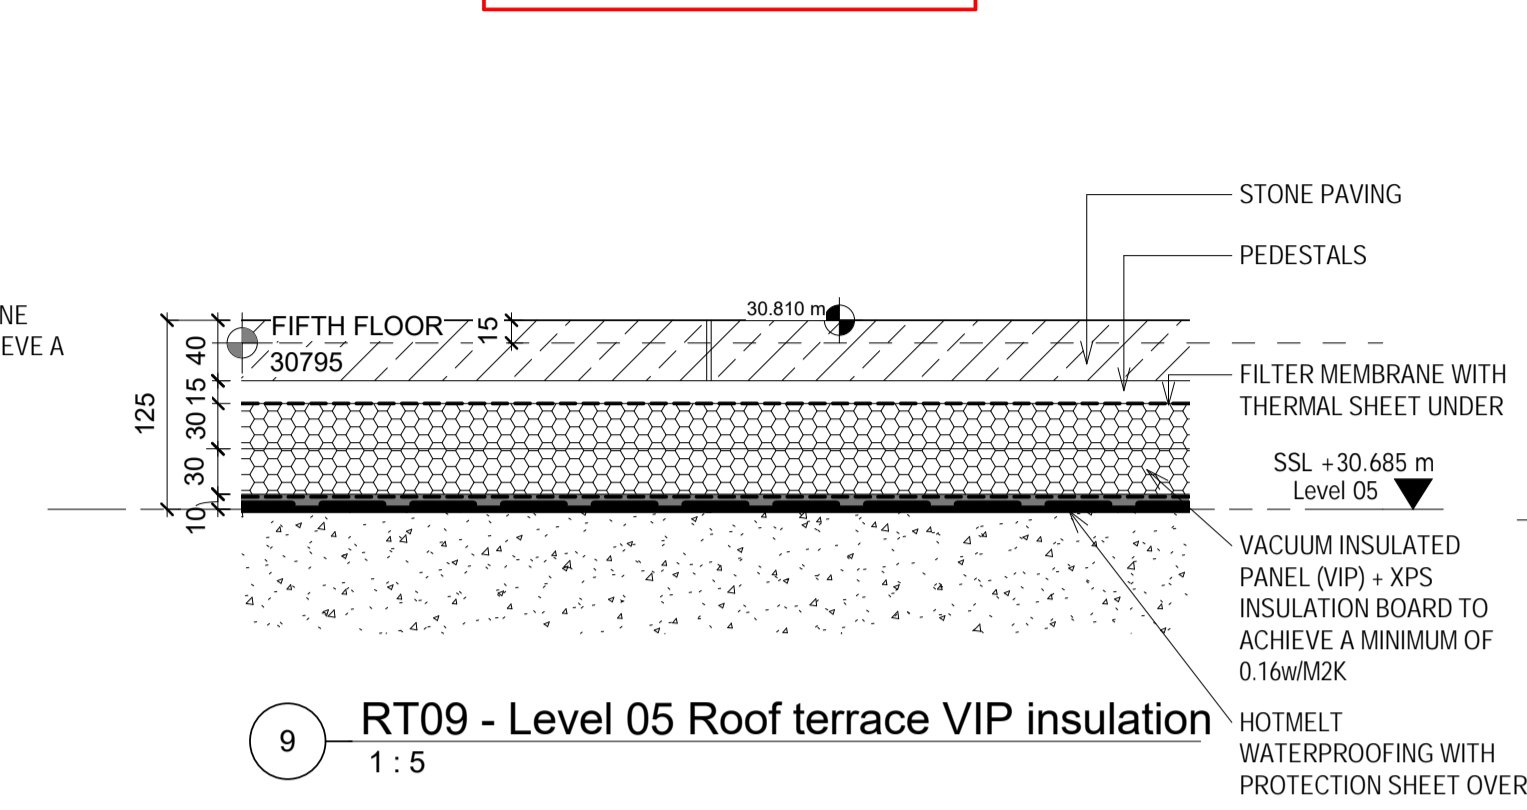

9 RT09 - Level 05 Roof terrace VIP insulation
1:5


RT 13

DETAIL SOLUTION TBC,
PENDING CONFIRMATION OF
VIP BUILD UP THICKNESS

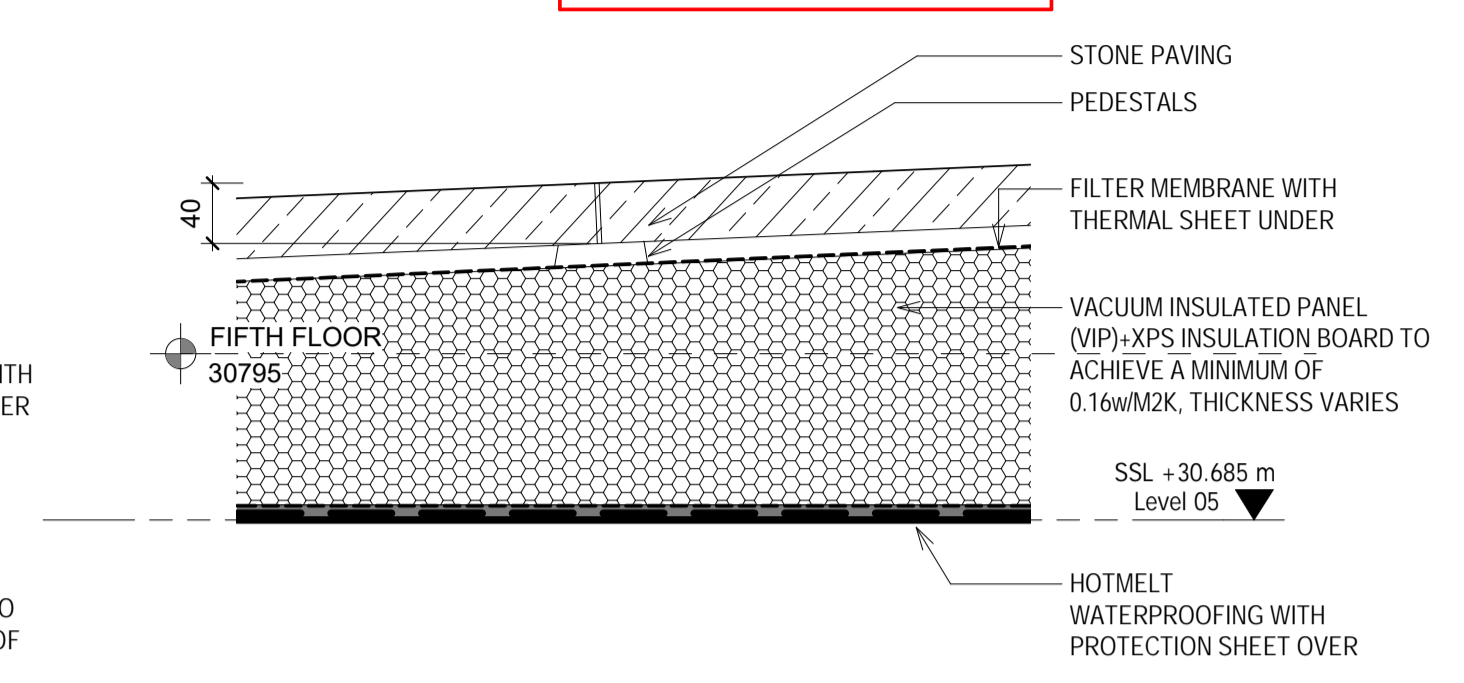


10 RT13 - L5 RAMP
1:5

RT 02

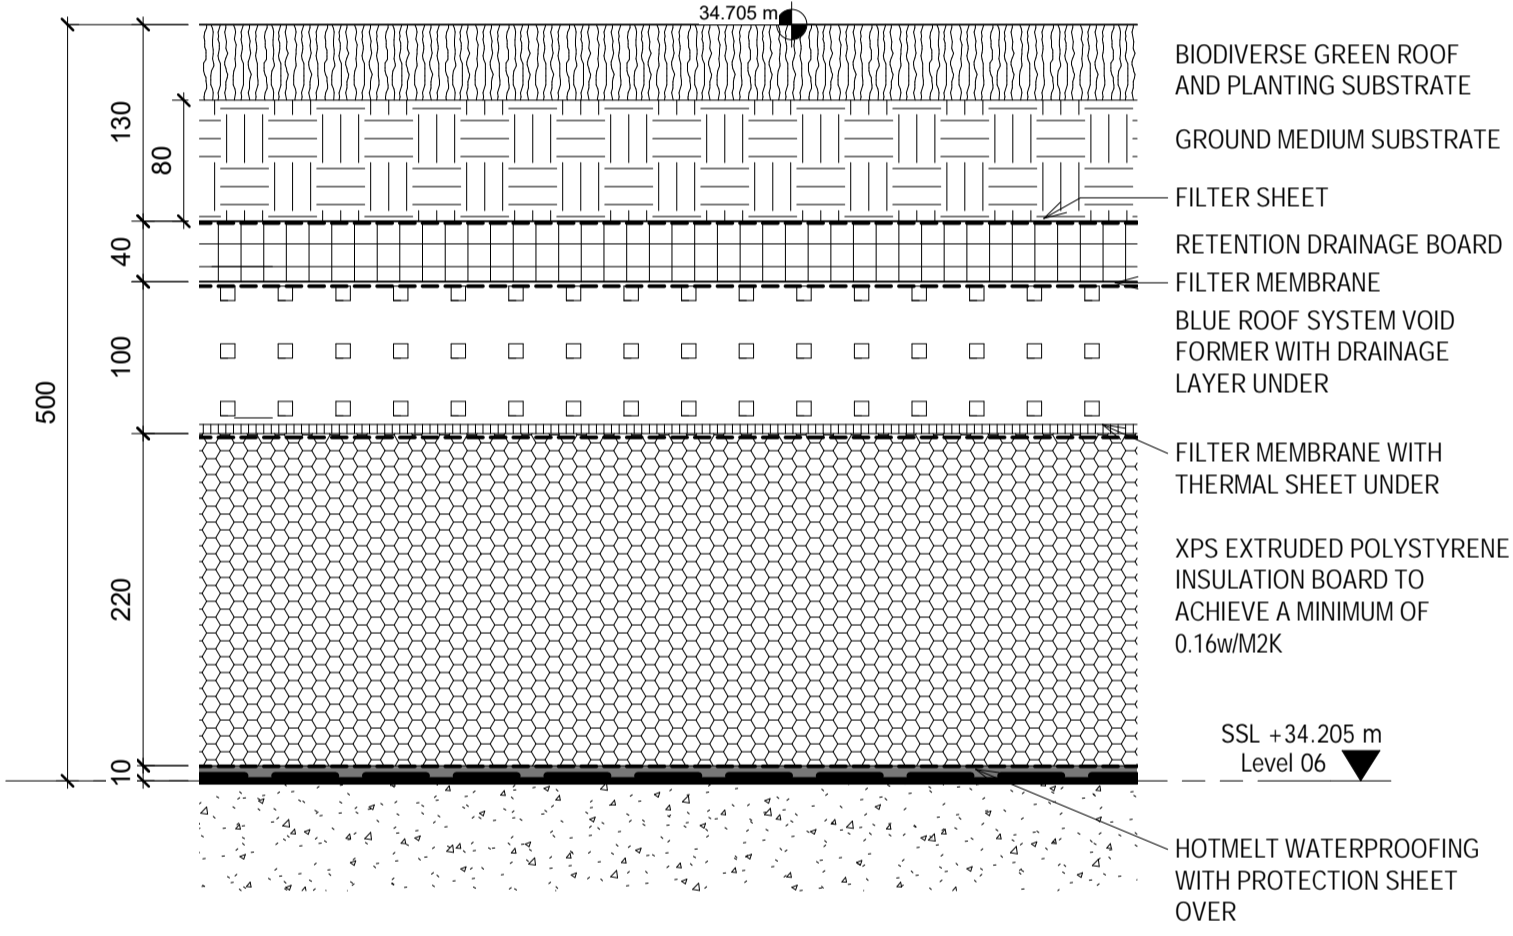


2 RT02 - Level 06 Green roof
1:5

RT 03

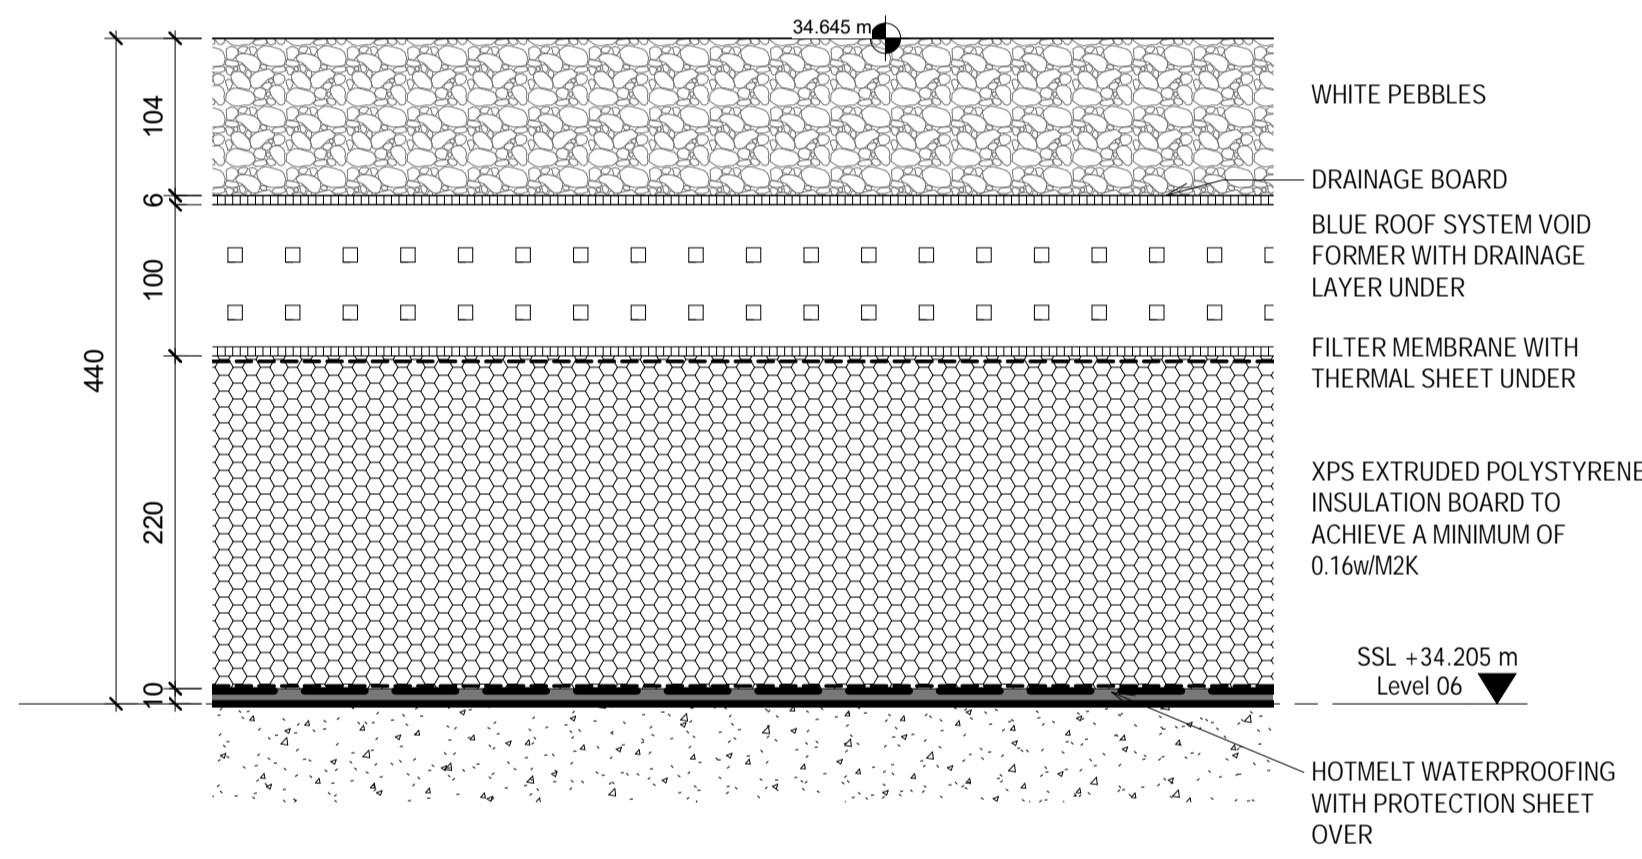

3 RT03 - Level 06 Blue roof with pebbles finish
1:5

RT 04

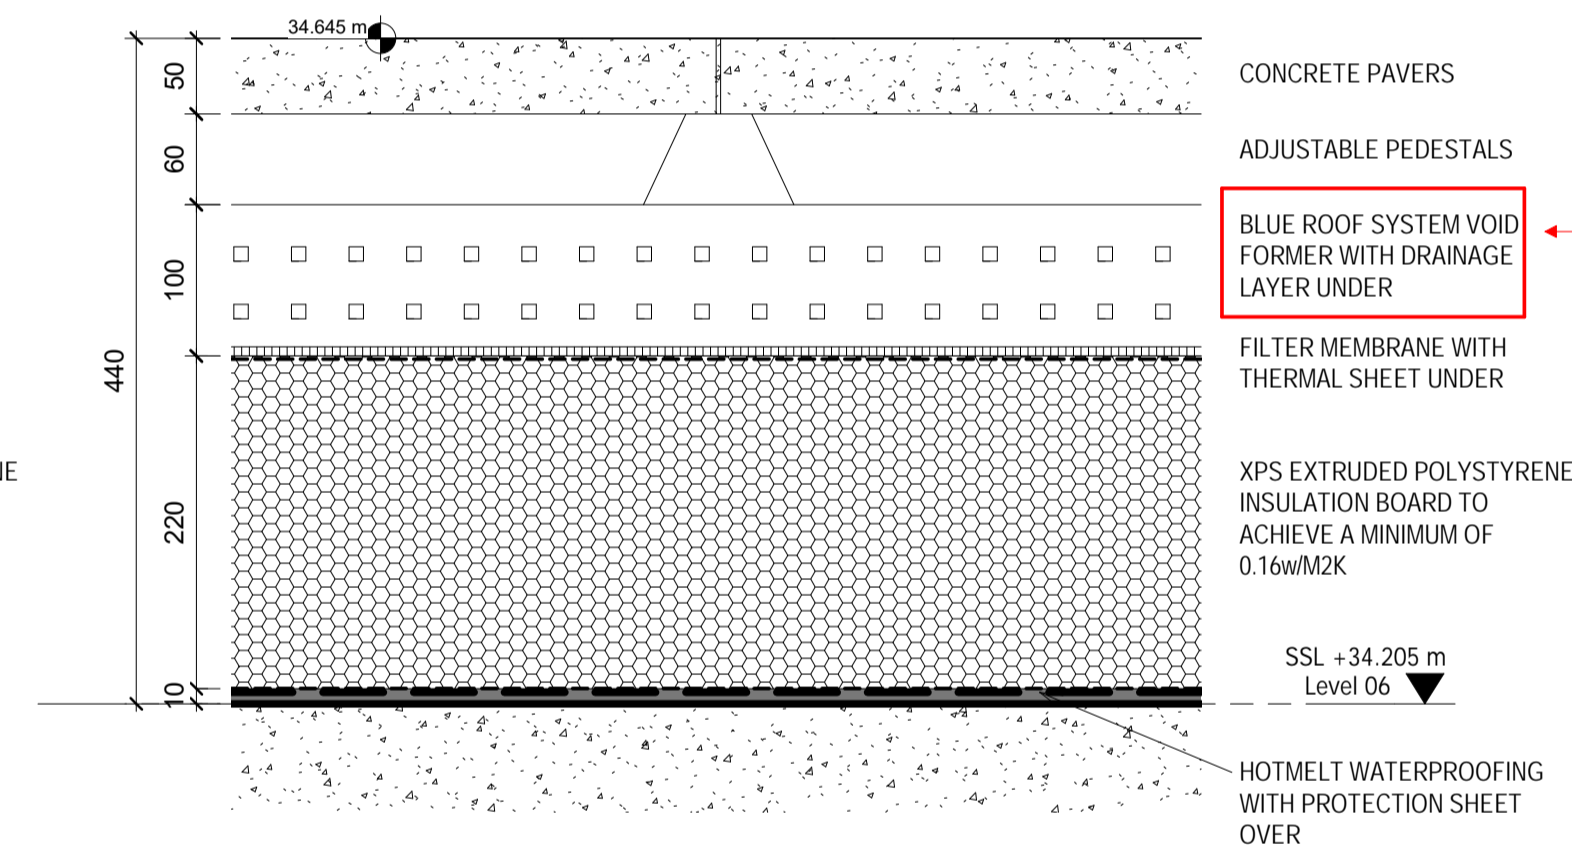


4 RT04 - Level 06/07 Blue roof with concrete pavers
1:5

BLUE ROOF SYSTEM ON
ROOF PLANT ROOMS
TBC

RT 05


DETAIL TBC AS STRUCTURE UNDER IS TO
BE CONFIRMED

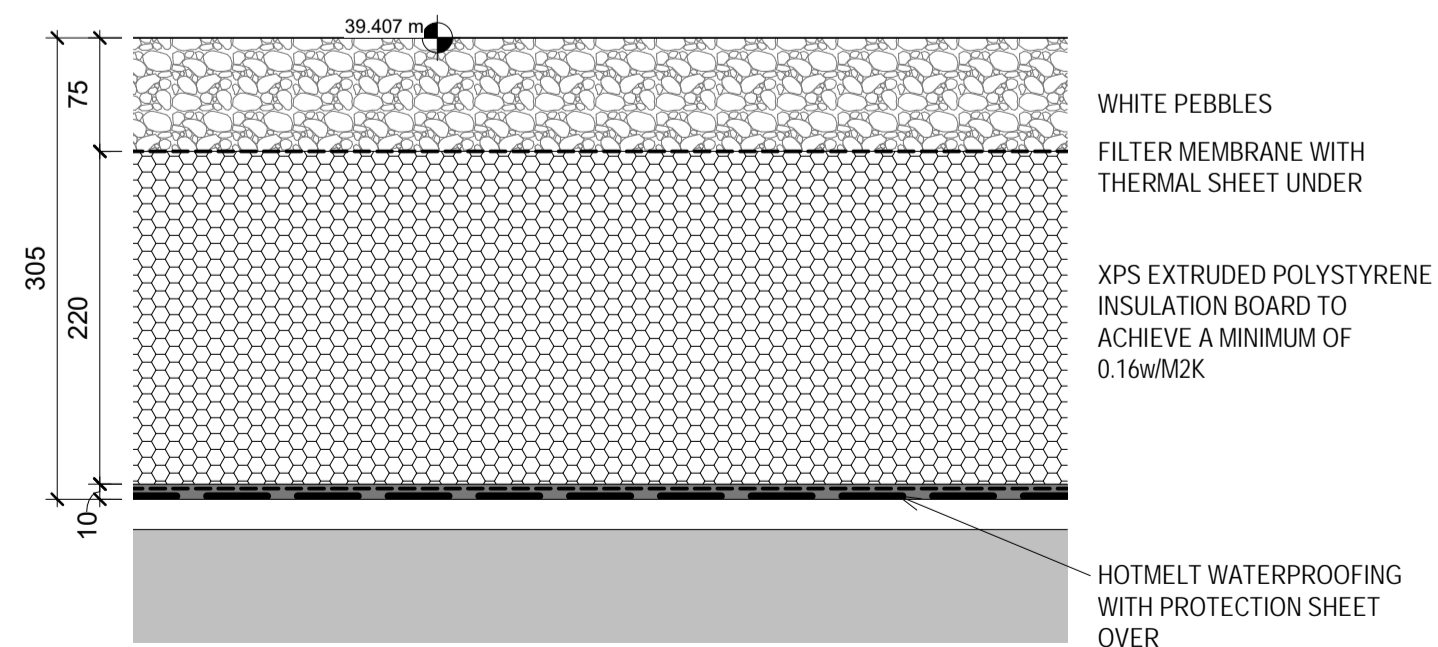

5 RT05 - Level 07 Lift overruns
1:5


RT 06

INSULATION THICKNESS TO
BE CONFIRMED WHEN
EXISTING EDGE UPSTANDS
HEIGHTS, EXISTING FINISH
LEVEL IS CONFIRMED

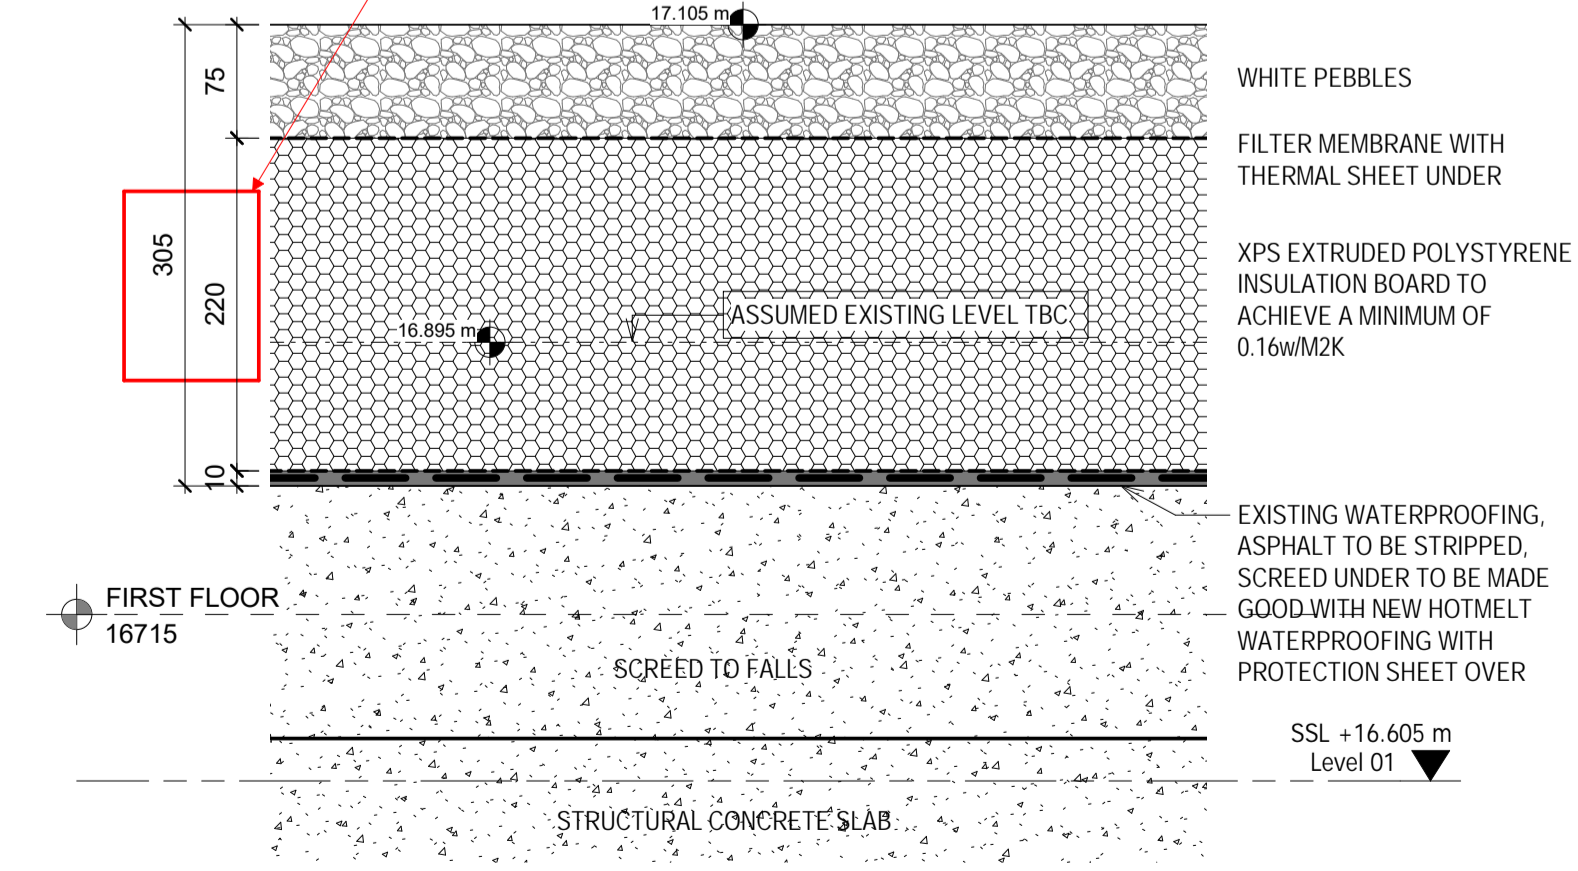

7 RT06 - Level 01 Existing roof
1:5

RT 07

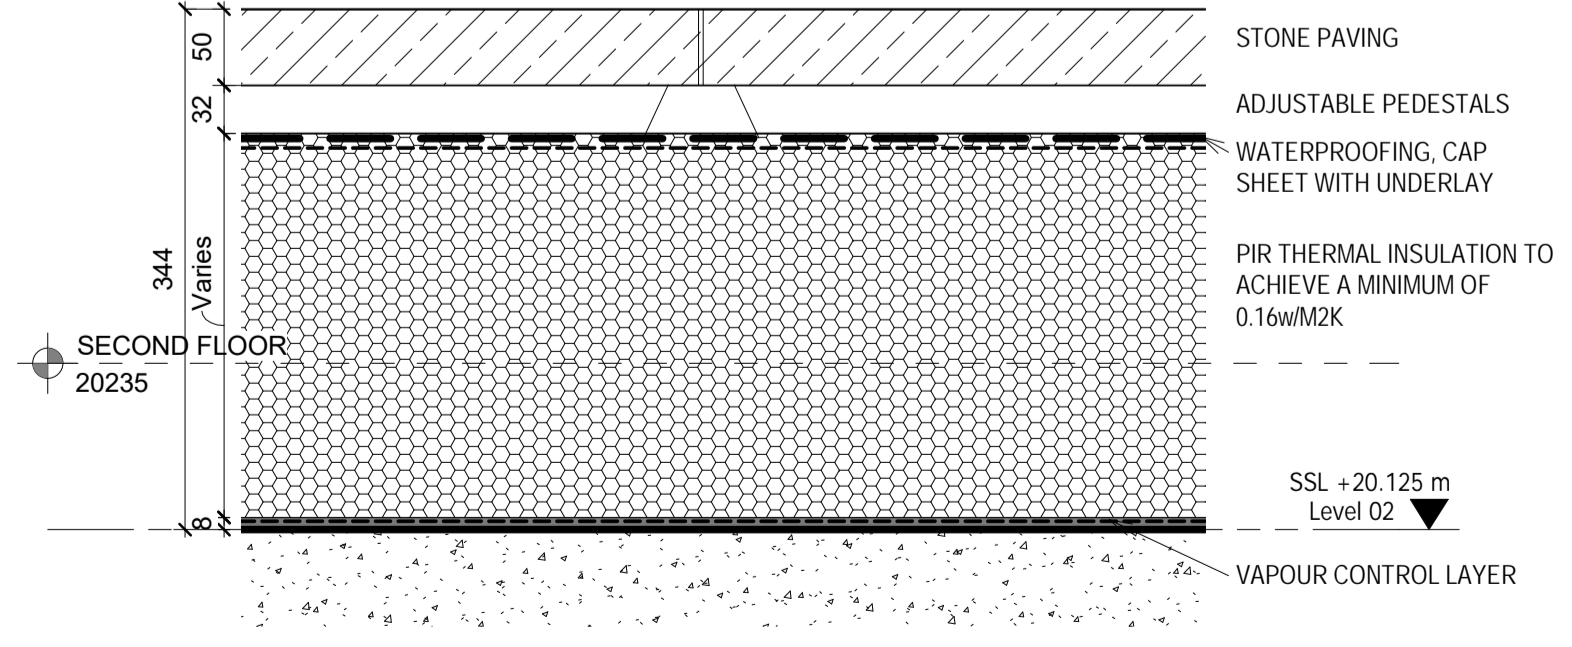

6 RT07 - Level 02 Warm roof pavillion
1:5

DO NOT SCALE ANY DIMENSIONS OFF THIS DRAWING. ANY DISCREPANCIES BETWEEN THIS DRAWING AND OTHER INFORMATION ARE TO BE REFERRED TO MCM ARCHITECTURE LIMITED. WHERE THE DRAWING RELATES TO AN EXISTING BUILDING OR COMPLETED CONSTRUCTION THE CONTRACTOR IS RESPONSIBLE FOR CHECKING THAT THERE IS NO CONFLICT BETWEEN ACTUAL BUILDING DIMENSIONS AND DRAWING DIMENSIONS. IN THE EVENT OF DISCREPANCIES BETWEEN THIS DRAWING AND SUBCONTRACTORS APPROVED WORKING DRAWINGS FOR RELEVANT BUILDING COMPONENTS, THE SUBCONTRACTORS DRAWING SHALL TAKE PRECEDENCE. ANY CONFLICTS ARISING OUT OF INFORMATION AS NOTED ABOVE MUST BE REPORTED IMMEDIATELY TO MCM ARCHITECTURE LIMITED. THIS DRAWING IS THE COPYRIGHT OF MCM ARCHITECTURE LIMITED. ALL DIMENSIONS ARE IN MILLIMETRES UNLESS OTHERWISE STATED.

CDM REGULATION			
HAZARDS	DATE ADDED	DATE MITIGATED	RISK ASSESSMENT DATE

P1 31.01.18 FIRST STAGE 4 ISSUE LS
REV DATE PURPOSE OF ISSUE

CLIENT AA & DB
PROJECT 17 CHARTERHOUSE ST.
DRAWING ROOF TYPICAL BUILD UPS DETAILS

SCALE 1:100 @A1
1:200 @A3
DRAWN LS
CHECKED SP

STATUS PRELIMINARY
TENDER
CONSTRUCTION
AS BUILT

DRAWING NO. P17-082 A-41-DET-50 P1
MCM Architecture Limited
71 Hopton Street London SE1 9LR
T 020 7902 0900
www.mcm-uk.com