



Flat Type B1 Kitchen Plan

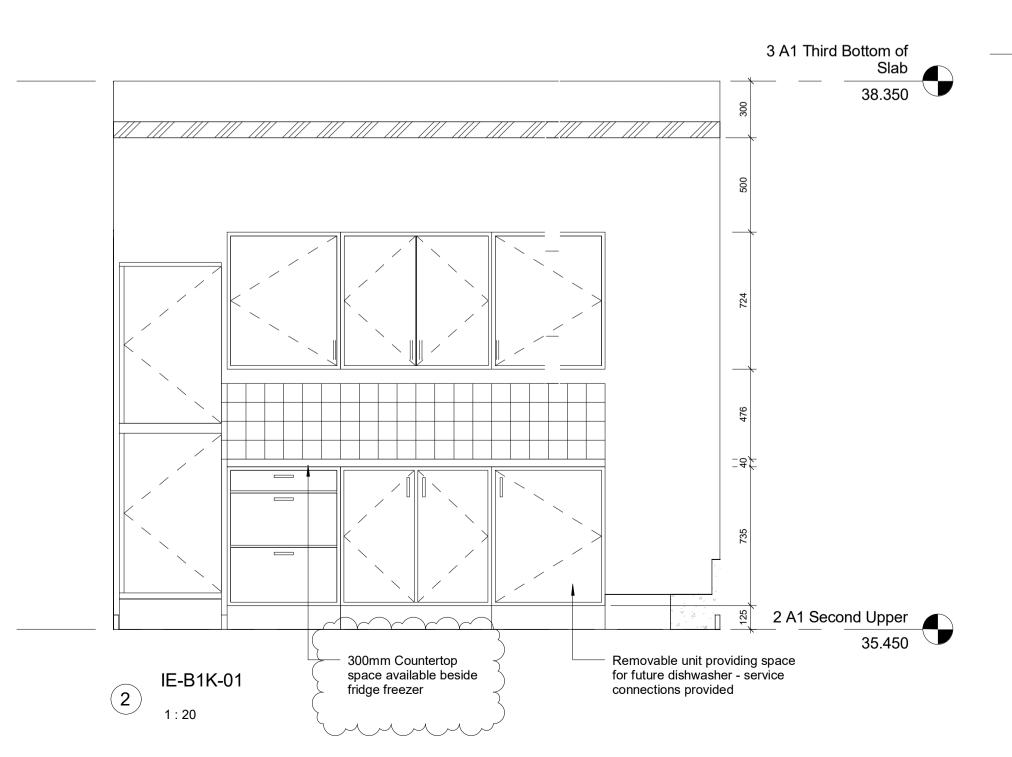

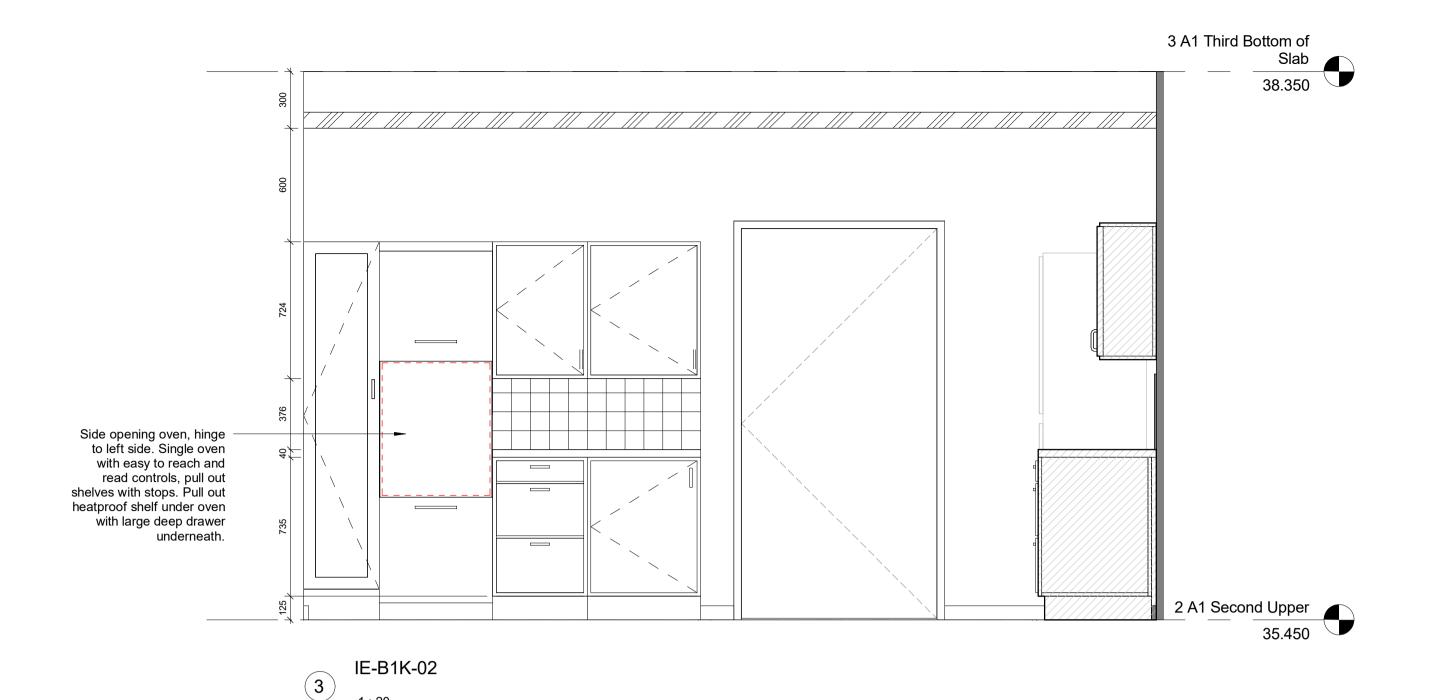

Slab 38.350 Cooker hood shown indicatively only.
 Contractor to confirm with M&E subcontractor specific cooker hood installment height to determine the top of tiles in this area Shallow sink Tiling (M40/140D) 100x100mm Domus
Colori Lucido
Colour: DMSL 22
Tiling extends to skirting behind cooker.
Tiles to extend to external wall and skirting where socket run pass edge of counter. This situation is to be discussed with Site Manager prior to installation of tiles. 2 A1 Second Upper 35.450

IE-B1K-	03						
1 : 20	Casework Schedule IE-B1K						
	Description	Mark	Width	Height	Depth		
		I		1	I		
	40mm Worktop	IE-B1K-WT01		900.0	625.0		
	40mm Worktop	IE-B1K-WT02		900.0	625.0		
	40mm Worktop	IE-B1K-WT03		900.0	625.0		
	3		_				
	400mm Larder unit	IE-B1K-LA01	400.0	2000.0	600.0		
	1						
	500mm Base unit 3 drawers	IE-B1K-BU04	500.0	860.0	600.0		
	1						
	500mm Wall unit	IE-B1K-WU04	500.0	724.0	300.0		
	1	,		1			
	600mm Base unit	IE-B1K-BU03	600.0	860.0	600.0		
	600mm Base unit	IE-B1K-BU05	600.0	860.0	600.0		
	2						
	600mm Base unit 3 drawers	IE-B1K-BU01	600.0	860.0	600.0		
	1			1			
	600mm Tall oven unit	IE-B1K-TO01	600.0	2000.0	600.0		
	1			1	I.		
	600mm Wall unit	IE-B1K-WU01	600.0	724.0	300.0		
	600mm Wall unit	IE-B1K-WU03	600.0	724.0	300.0		
	600mm Wall unit	IE-B1K-WU05	600.0	724.0	300.0		
	3	<u> </u>		1	I		
	800mm Base unit, double doors	IE-B1K-BU02	800.0	860.0	600.0		
	1		-1	1			
	800mm Wall unit double doors	IE-B1K-WU02	800.0	724.0	300.0		

Grand total: 15

4

Kitchen Equipment Schedule IE-B1K							
Description	Mark	Comments					
Extractor Fan	IE-B1K-EX01	Client supplies					
1							
Fridge Freezer	IE-B1K-FF01	Tenant supplies					
1							
Electric Hob	IE-B1K-H01	Client supplies					
1							
Oven	IE-B1K-OV01	Client supplies					
1							
Sink	IE-B1K-SK01	Shallow sink					
	<del></del>	<del>'</del>					

3 A1 Third Bottom of

Grand total: 5

Note: Refer to Architype NBS for specification of all Contractor supplied items

Please refer to kitchen subcontractors kitchen drawings for set-out.

NOTE - Kitchen type occurs 2no. times in Block A

This drawing is © Architype Ltd.

Check this drawing is the latest revision.

Do not scale from this drawing.

Do not use the information on this drawing without checking all dimensions on

**Do not** use any areas indicated for either valuation, puchase, sale or any other form of legally binding contract. Do not reproduce any part of this drawing withour prior written consent.


Report any discrepancies on this document to Architype.

Read this drawing in conjunction with the associated models, specifications and related consultant's documents.

Requirements, Thermal Performance, Airtightness and any other specified performance requirements are met. Subject to Architype "Acceptance".

All materials to be certified to comply with BS 14001/or BES6001 or be able to provide a Chain of Custody certificate in order to comply Code for Sustainable Homes. All timber species and sources used in this development are not to be listed on the CITES appendices for endangered or threatened species

Rev	Date	Description	Drawn	Checked
1	02.09.15	Preliminary Issue	IC	CD
2	19.10.15	Issued for Building Control	CD	EB
3	18.04.16	Issued for Construction. Kitchen layouts updated following M&E and kitchen supplier coordination.	AP	EB
4	08.06.16	Adjustments to tiling as per Hawkins\Brown comments	IC	EB
5	28.07.16	Tiling size and specification updated. Unit schedule updated		EB
6	06.12.16	Updates as response to Occupational Therapist comments	IC	RW
7	09.06.17	Update to kitchen drawings to reflect kitchen subcontractor set-out. Tiling layout adapted to suit.		RW
8	31.01.18	LAST ISSUE FOR CONSTRUCTION	IC	RW
9	28.02.18	Amendments for planning	CR	AMF

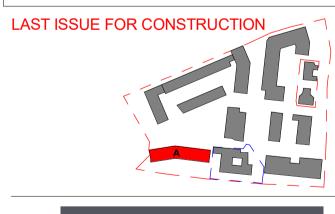



AR		YPE
LONDON: 020 7403 2889	WWW.ARCHITYPE.CO.UK	HEREFORD: 01981 542 11

Hill Partnership Ltd for Camden Council

Agar Grove Block A Flat Type B1 Kitchen

Type Role Phase Block Unit Unique ID - ART - DR - A - 1a A 00 - DD-665

Code Suitability Description A Issued for Construction

Code Revision Description

Z9 Revision description as above Scale: As indicated @ A1 02 Sep 15

8090 Model Ref: AG-RAC2015-A-A