


STANWAY LITTLE ASSOCIATES
 CHARTERED TOWN PLANNERS CHARTERED ARCHITECTS
 The Studios 72 Ruskin Walk London SE24 9LZ
 Tel 0207 733 1106 Email peterstanway@peterstanway.com


Project 32 Burghley Road London NW5 1UE

Dwg. Title As built as at January 2018 Job No. 1975
 Scale 1:100 @ A2 Date January 2018 Dwg. No. AB 1

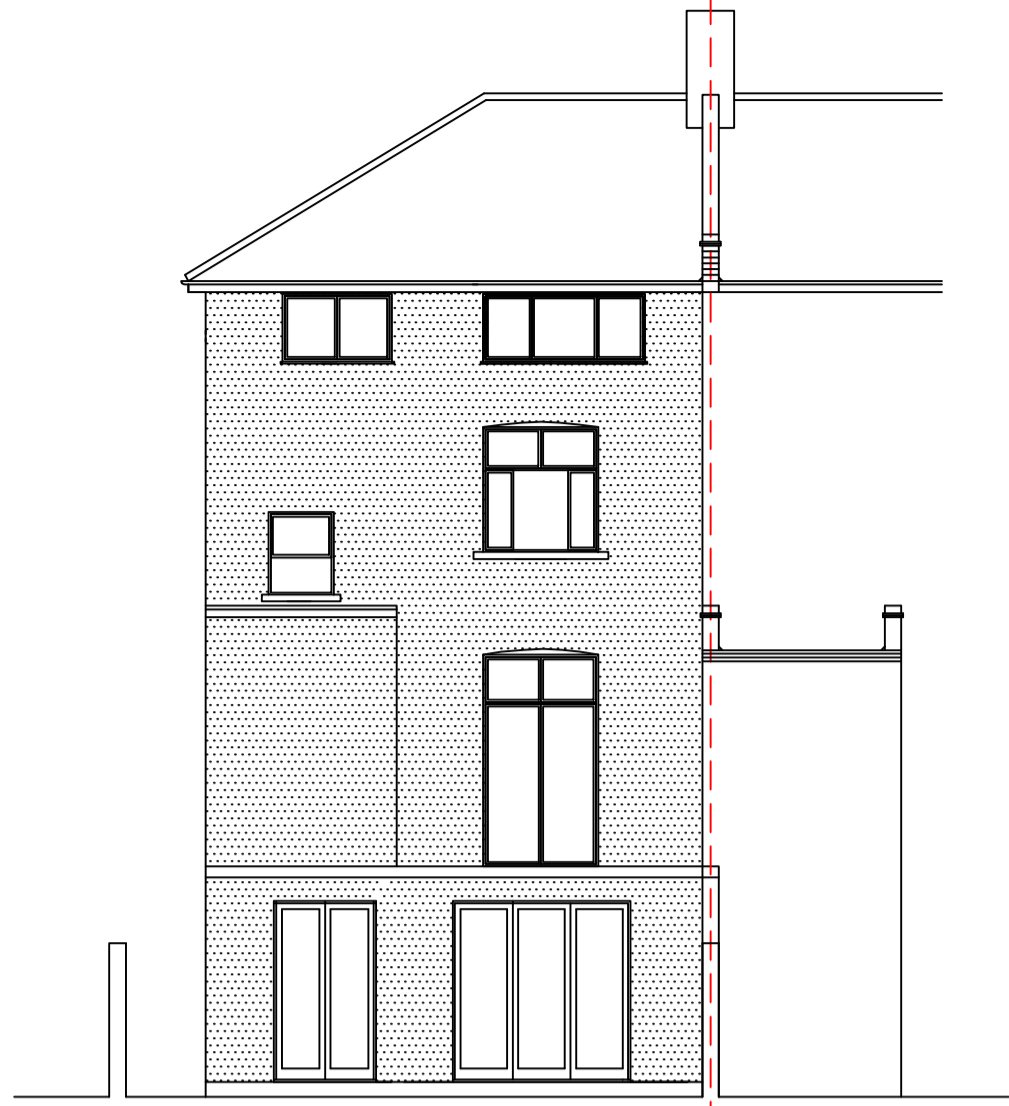


AS-BUILT AS AT JANUARY 2018

— Centre line of Party Wall

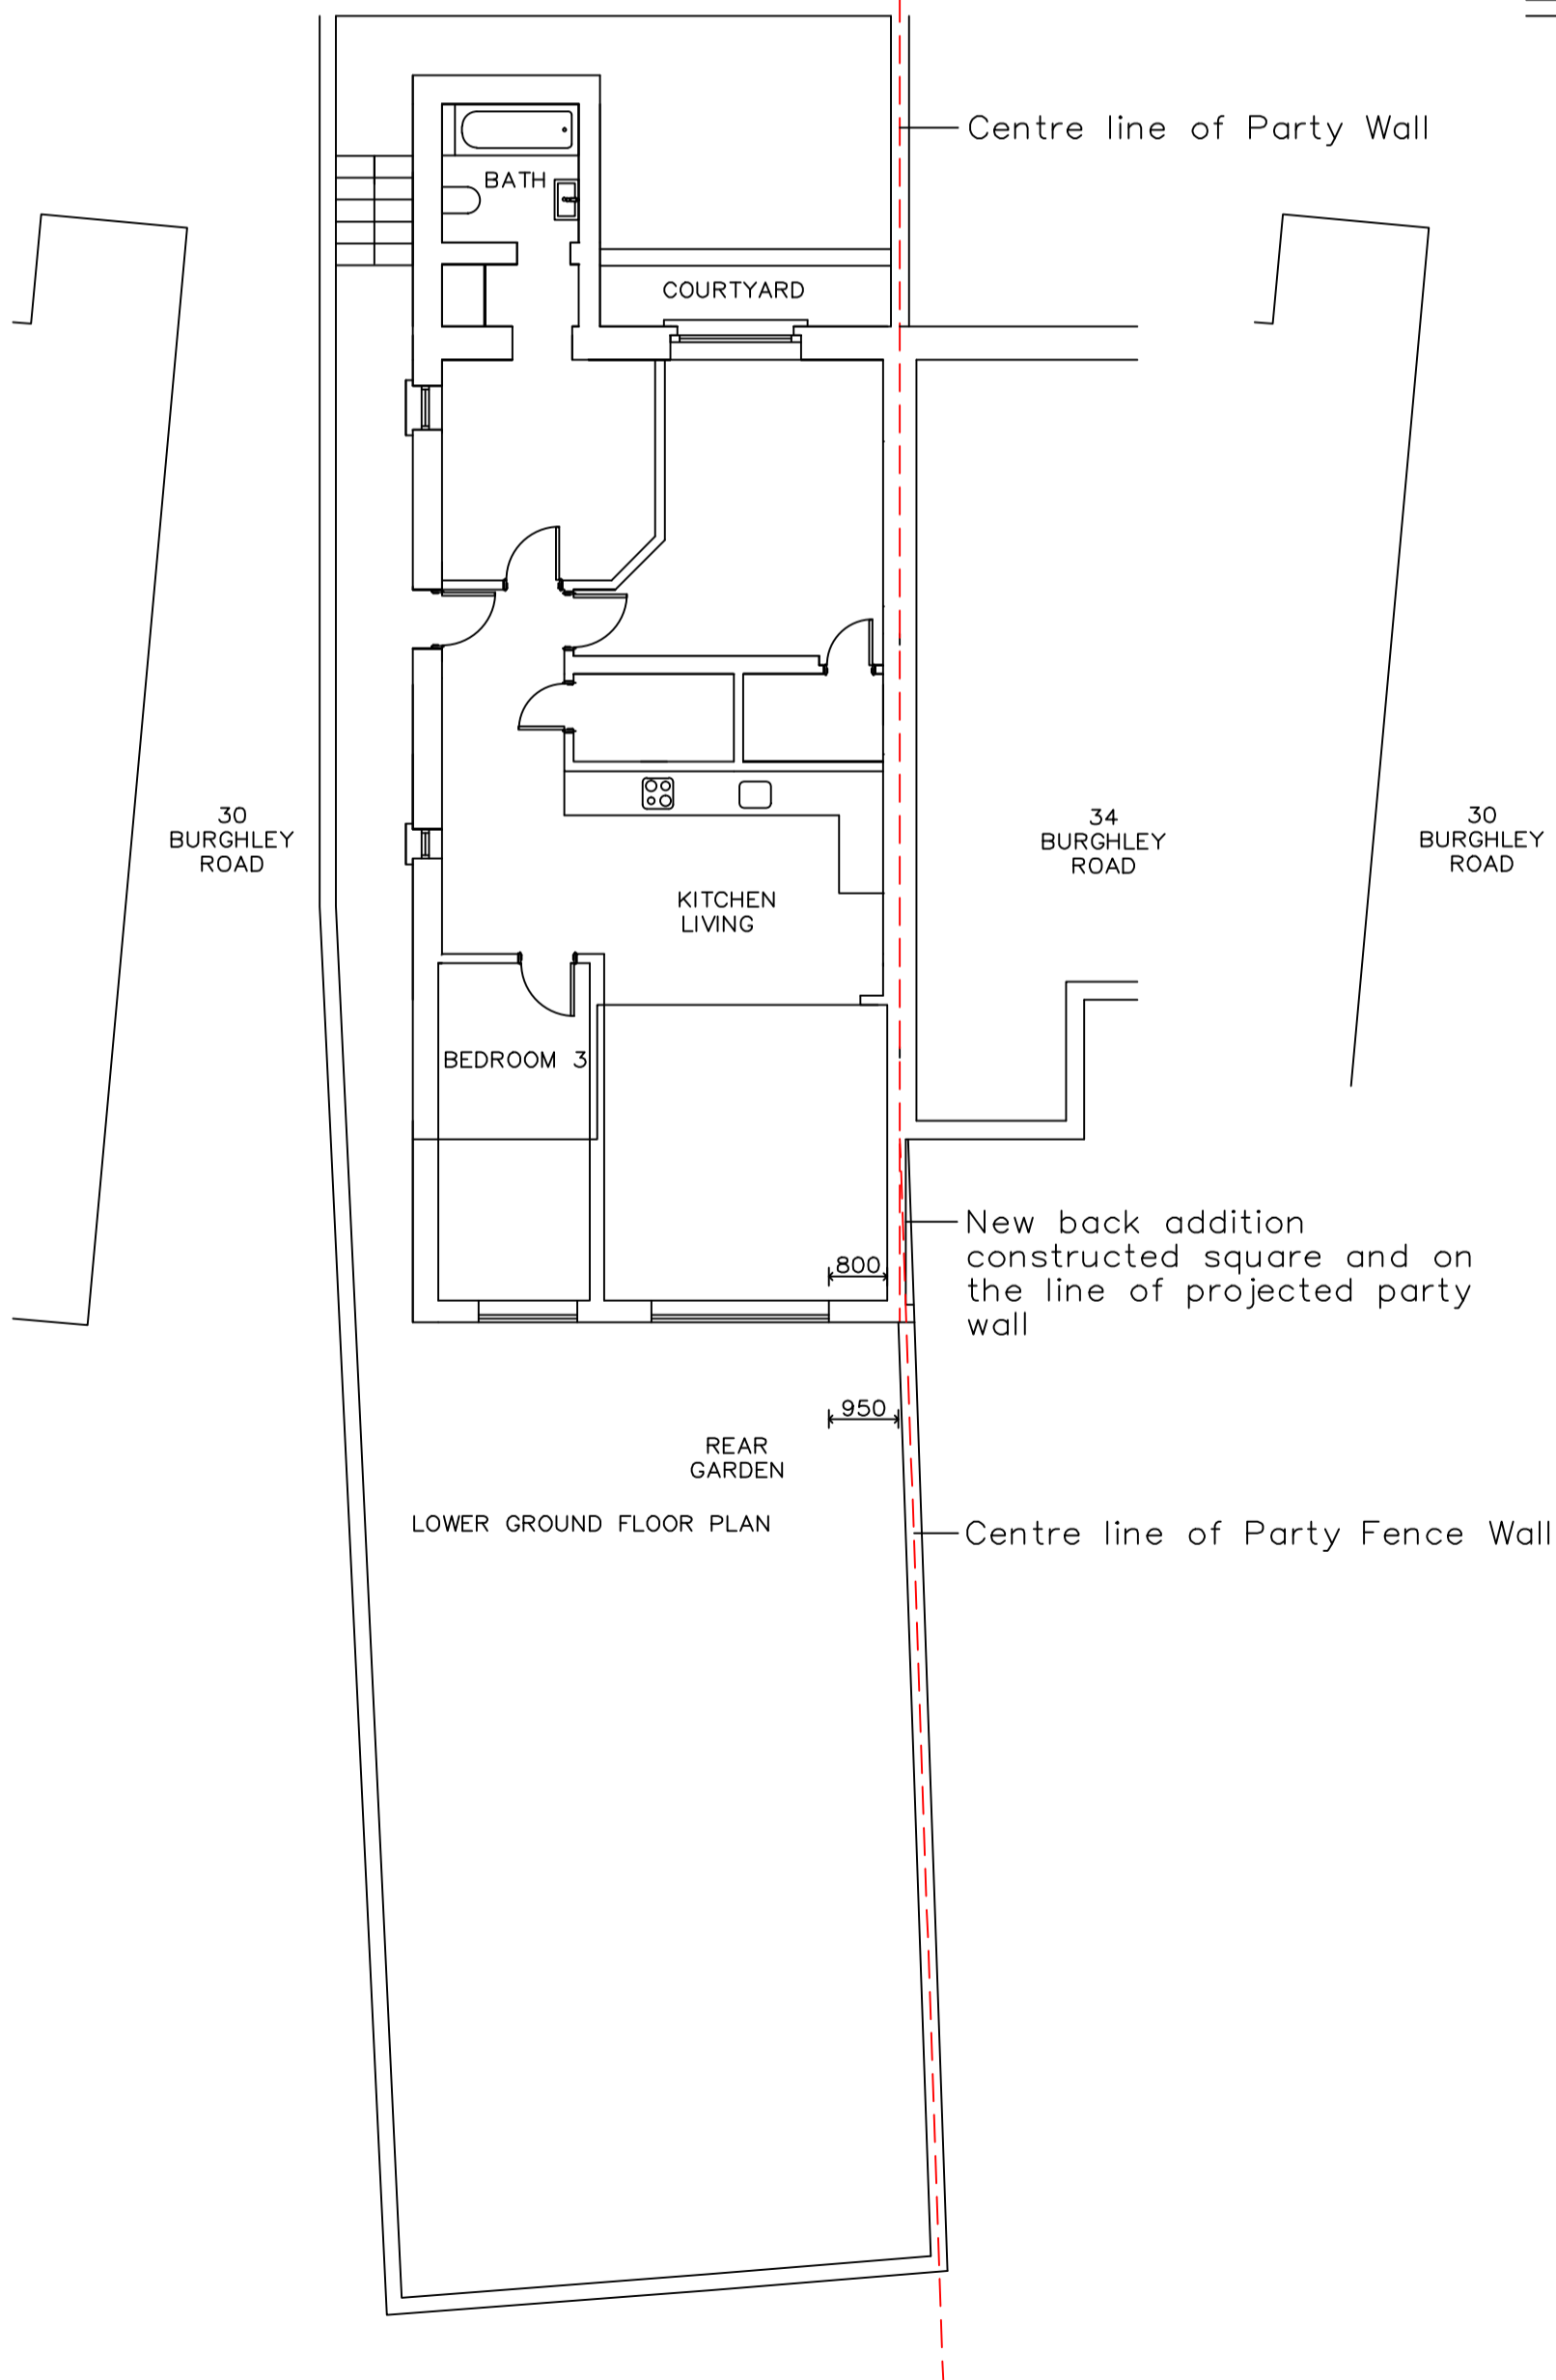

LOWER GROUND FLOOR PLAN

— Centre line of Party Fence Wall

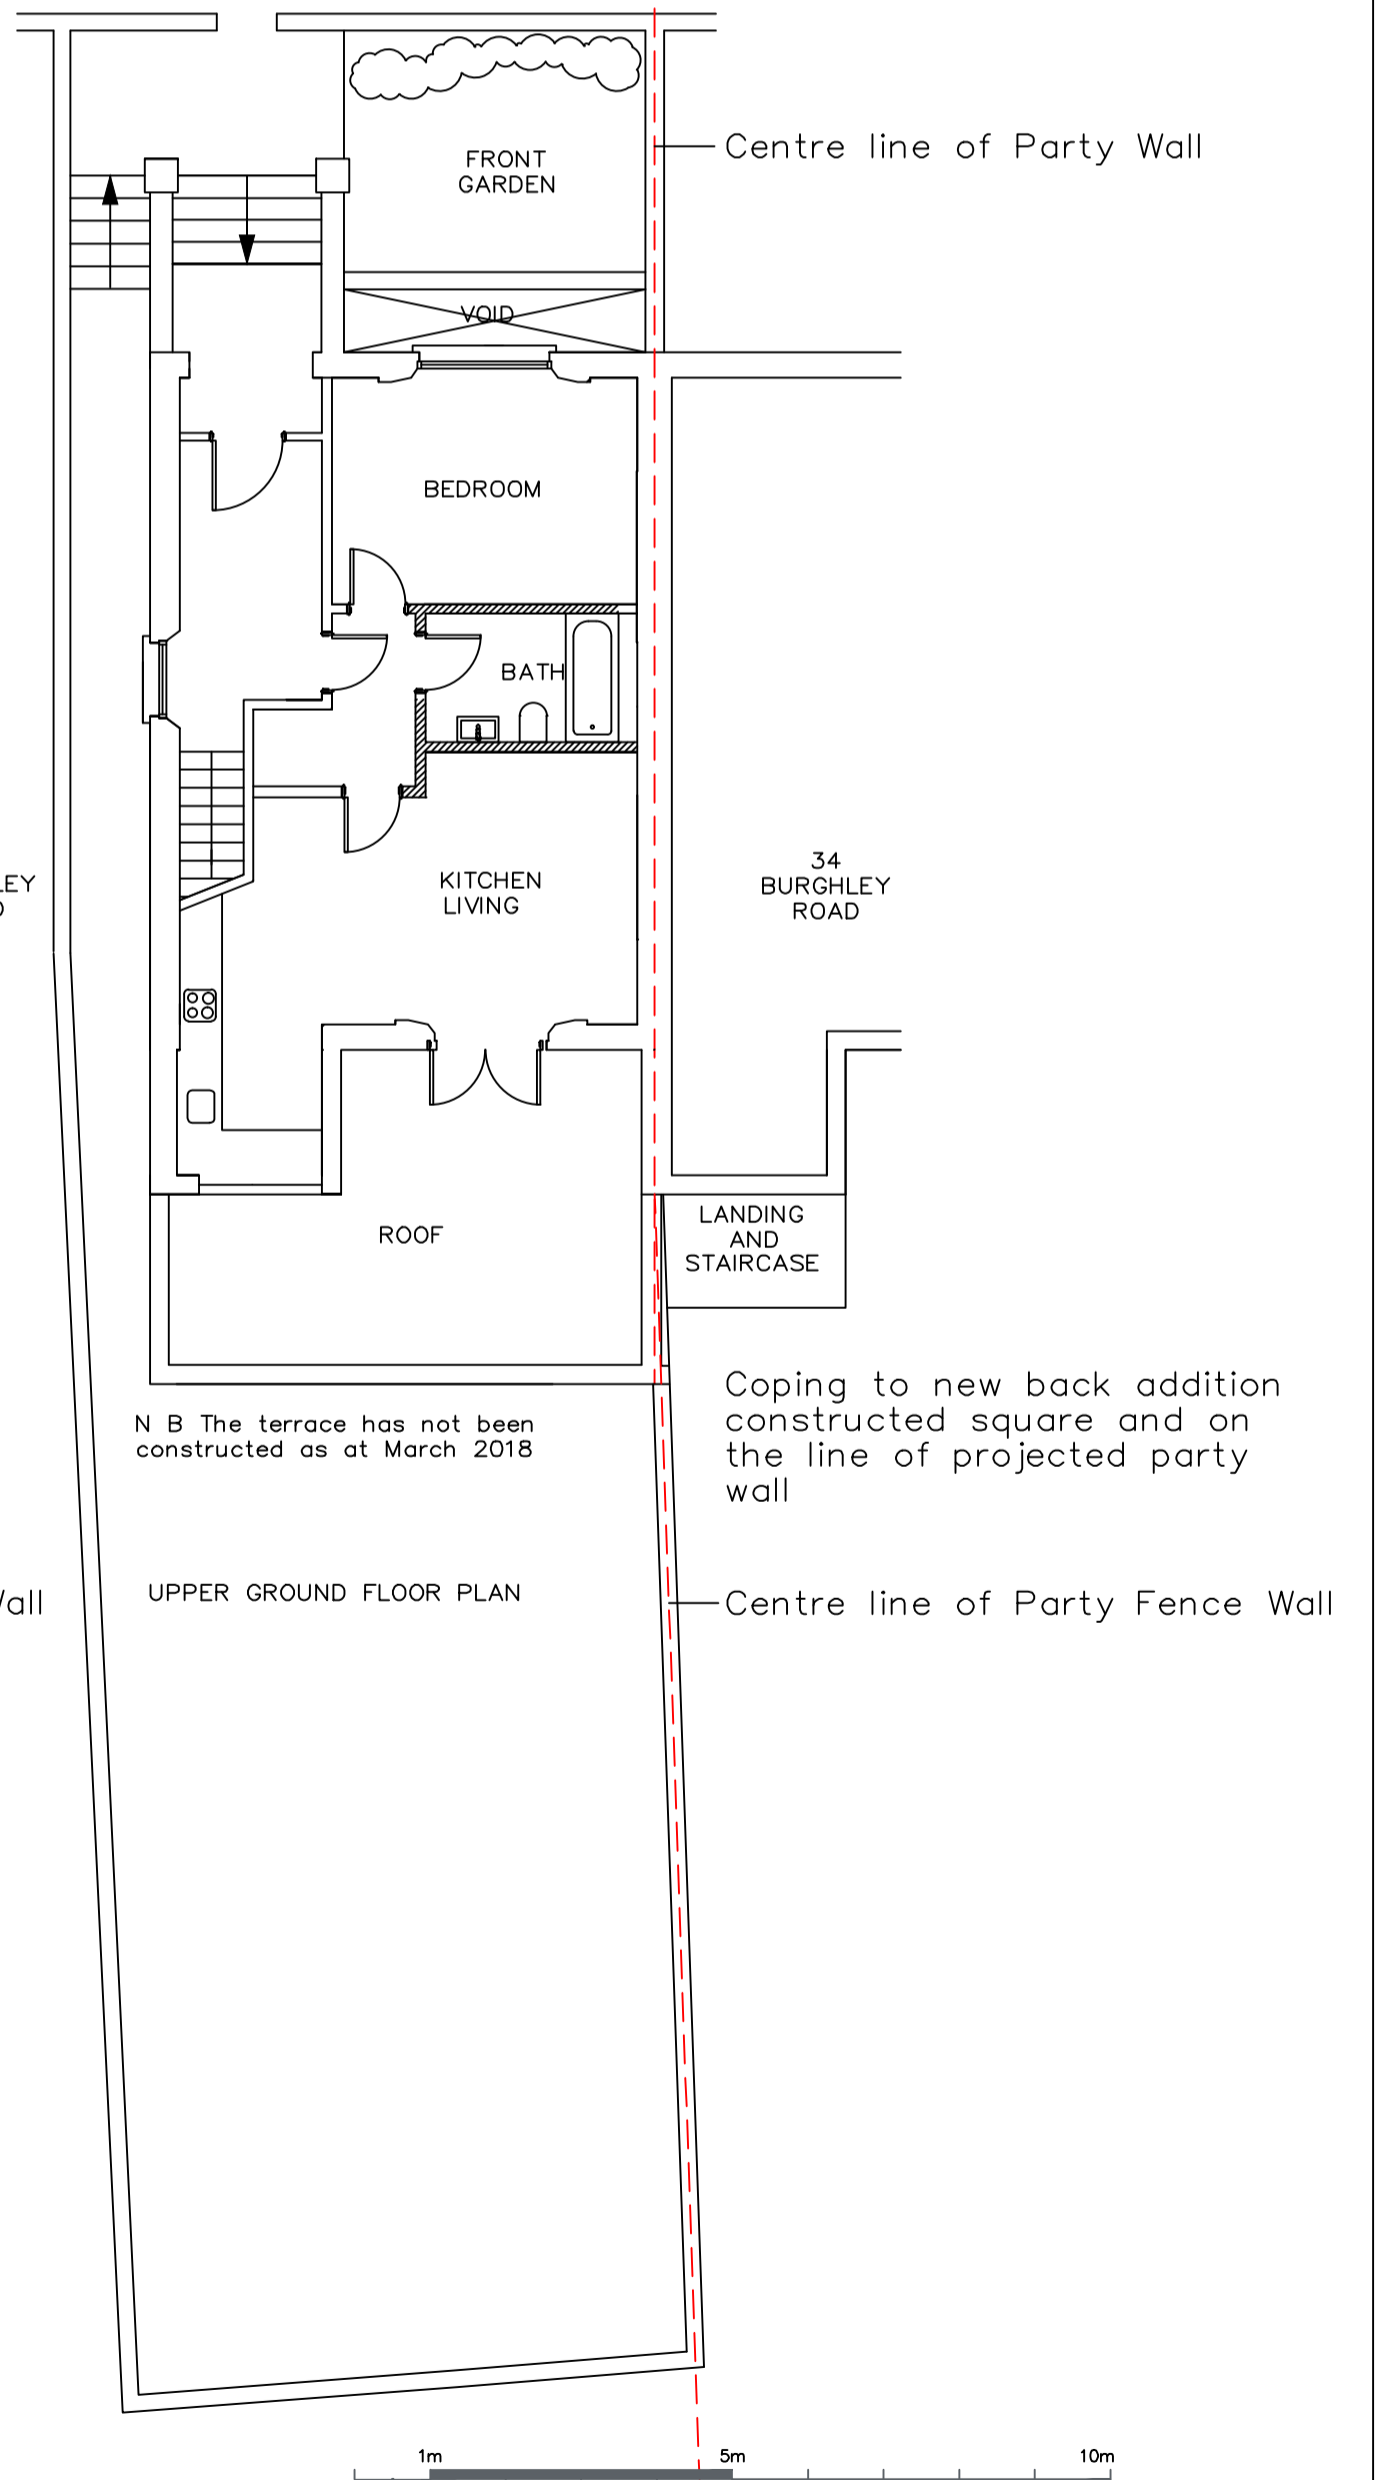

UPPER GROUND FLOOR PLAN

— Centre line of Party Fence Wall

