



Rev.D 23.02.18: No amendments further to those listed under Rev.C  
 Rev.C 13.02.18: Garden doors amended; minor internal layout amendments

<b>EDRM +</b> <b>DSDHA</b> <a href="http://www.edrm.co.uk">www.edrm.co.uk</a> <a href="http://www.dsdha.co.uk">www.dsdha.co.uk</a>	Title	Ground Floor Plan Proposed		Drawing no.	16.12.201_PL	Rev	D
	Project	Bickersteth House 31 Grove Place, NW3 1JS		Date	12.16	Scale	1:50 @ A3


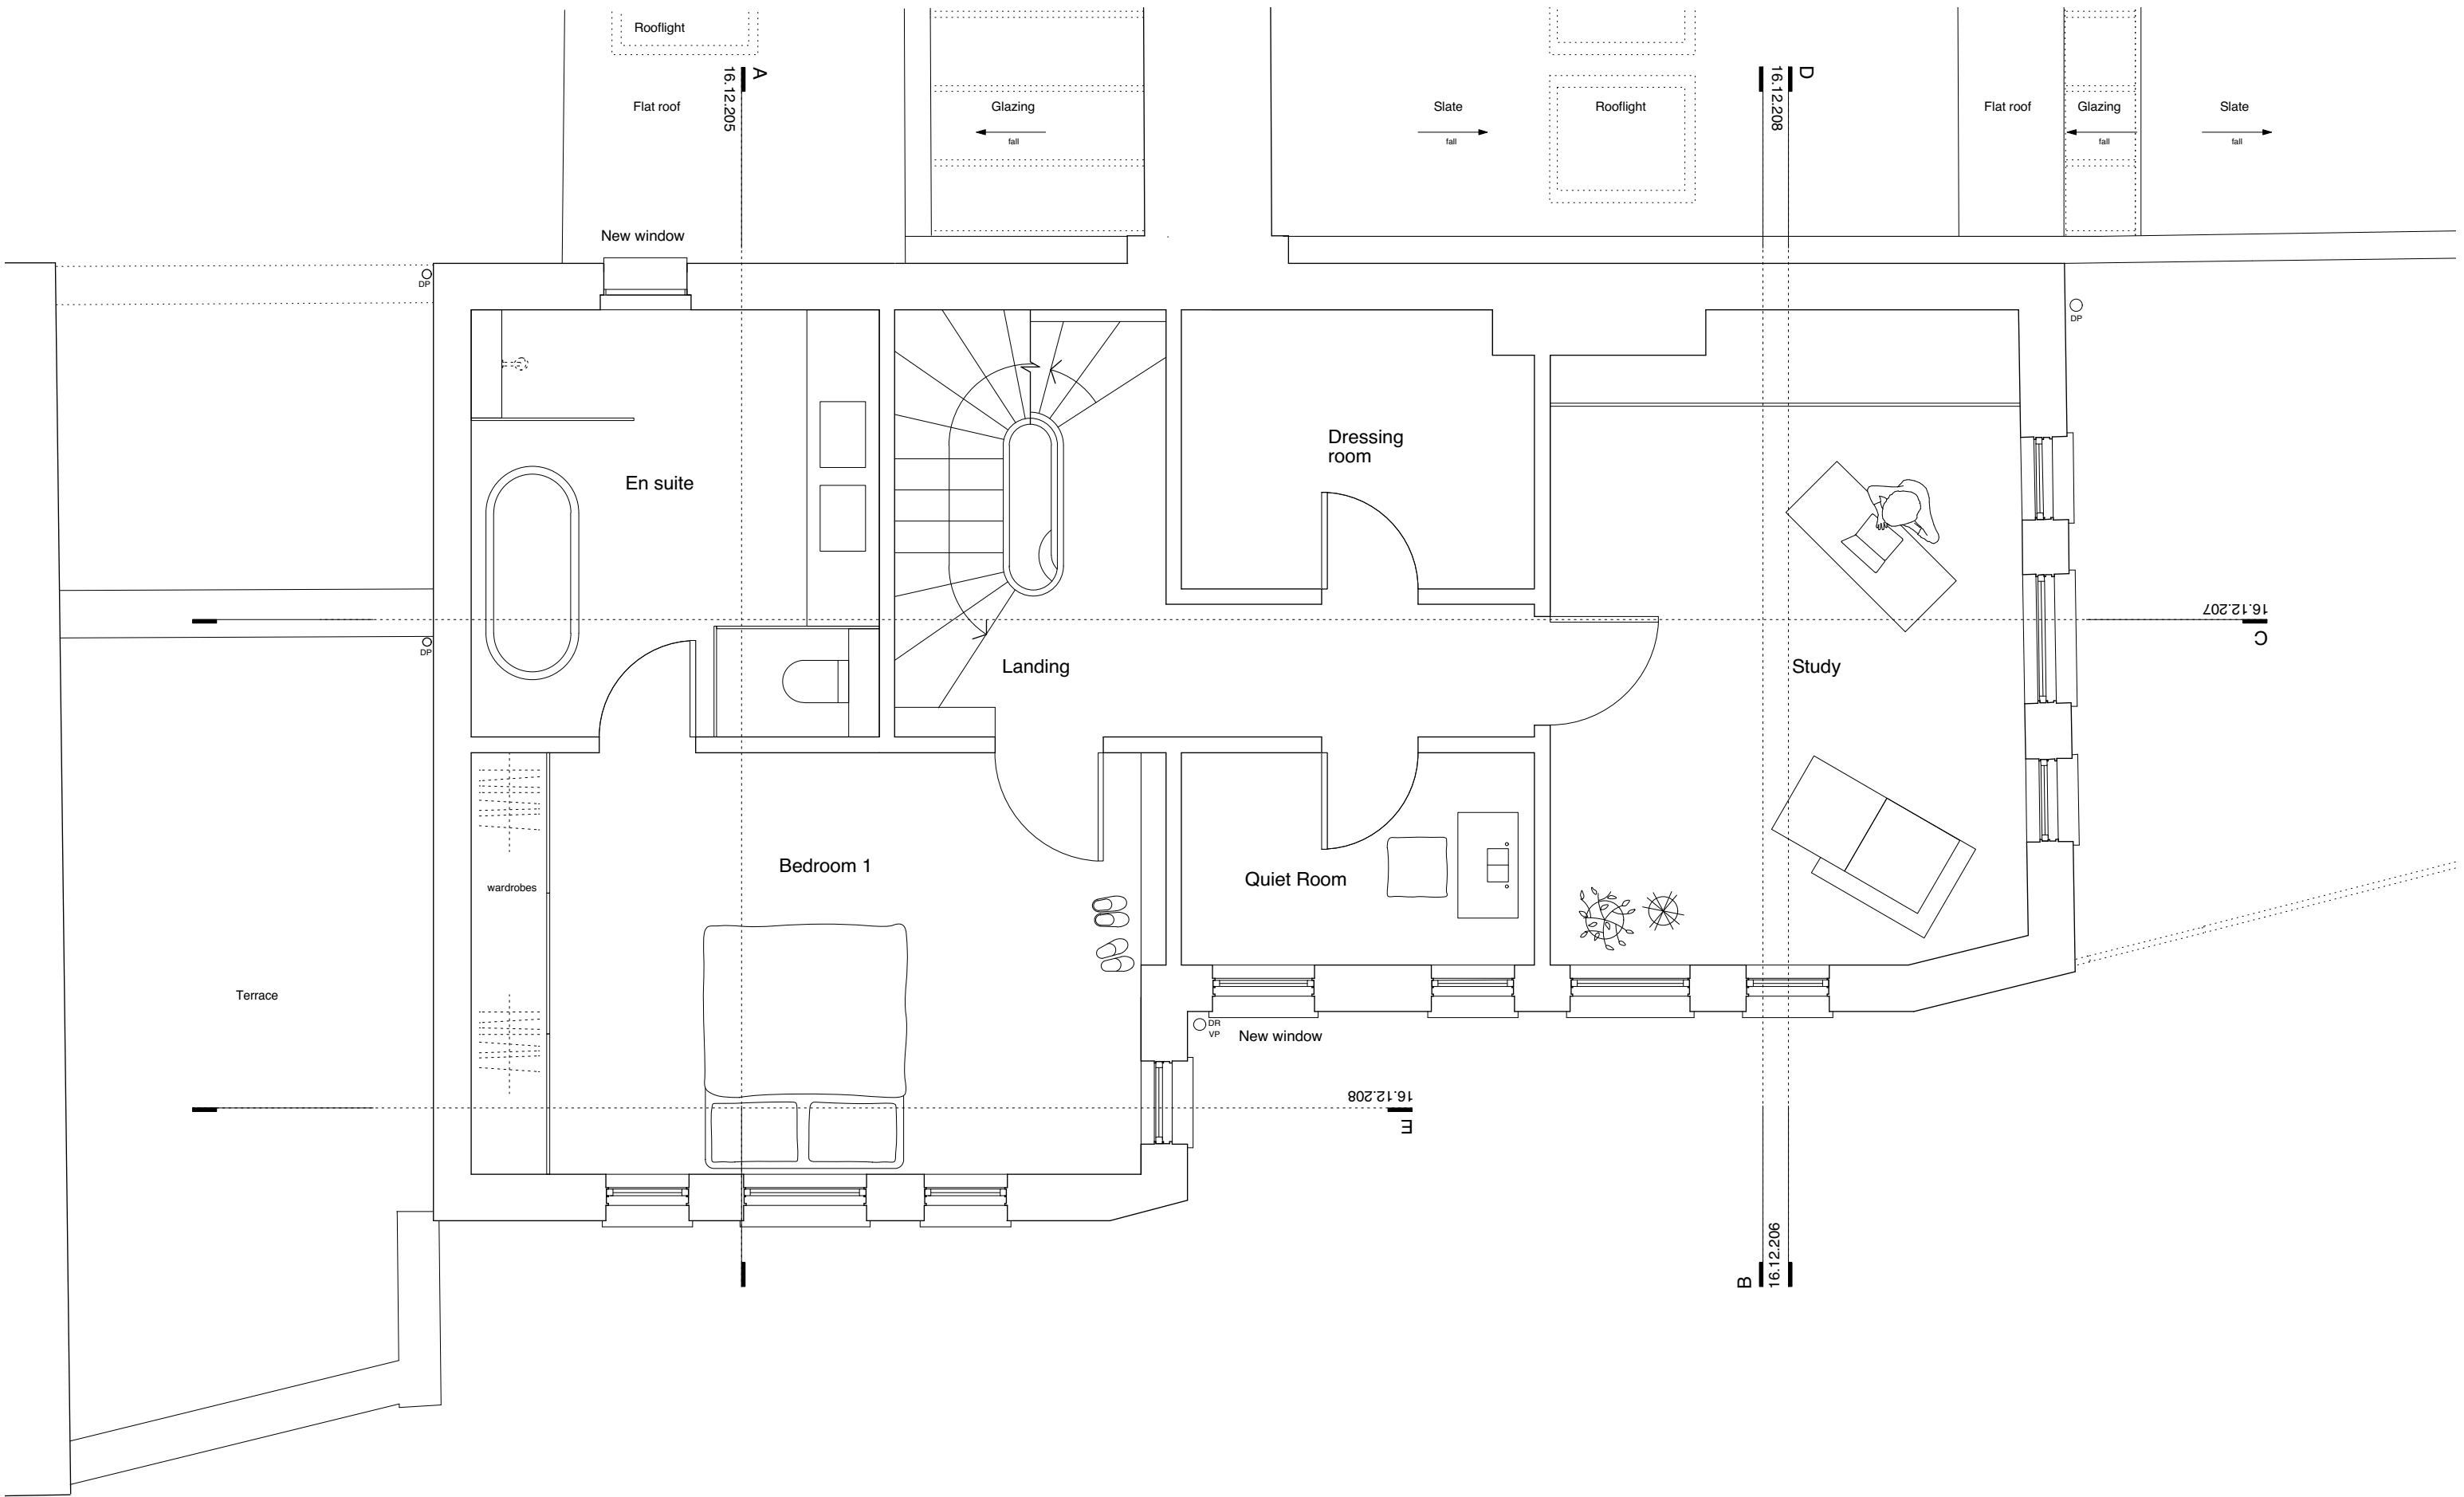


Rev.D 23.02.18: No amendments further to those listed under Rev.C  
 Rev.C 13.02.18: Minor internal layout amendments




<b>EDRM +</b> <b>DSDHA</b>  <a href="http://www.edrm.co.uk">www.edrm.co.uk</a> <a href="http://www.dsdha.co.uk">www.dsdha.co.uk</a>	Title	First Floor Plan Proposed		Drawing no.	16.12.202_PL	Rev	D
	Project	Bickersteth House 31 Grove Place, NW3 1JS		Date	12.16	Scale	1:50 @ A3

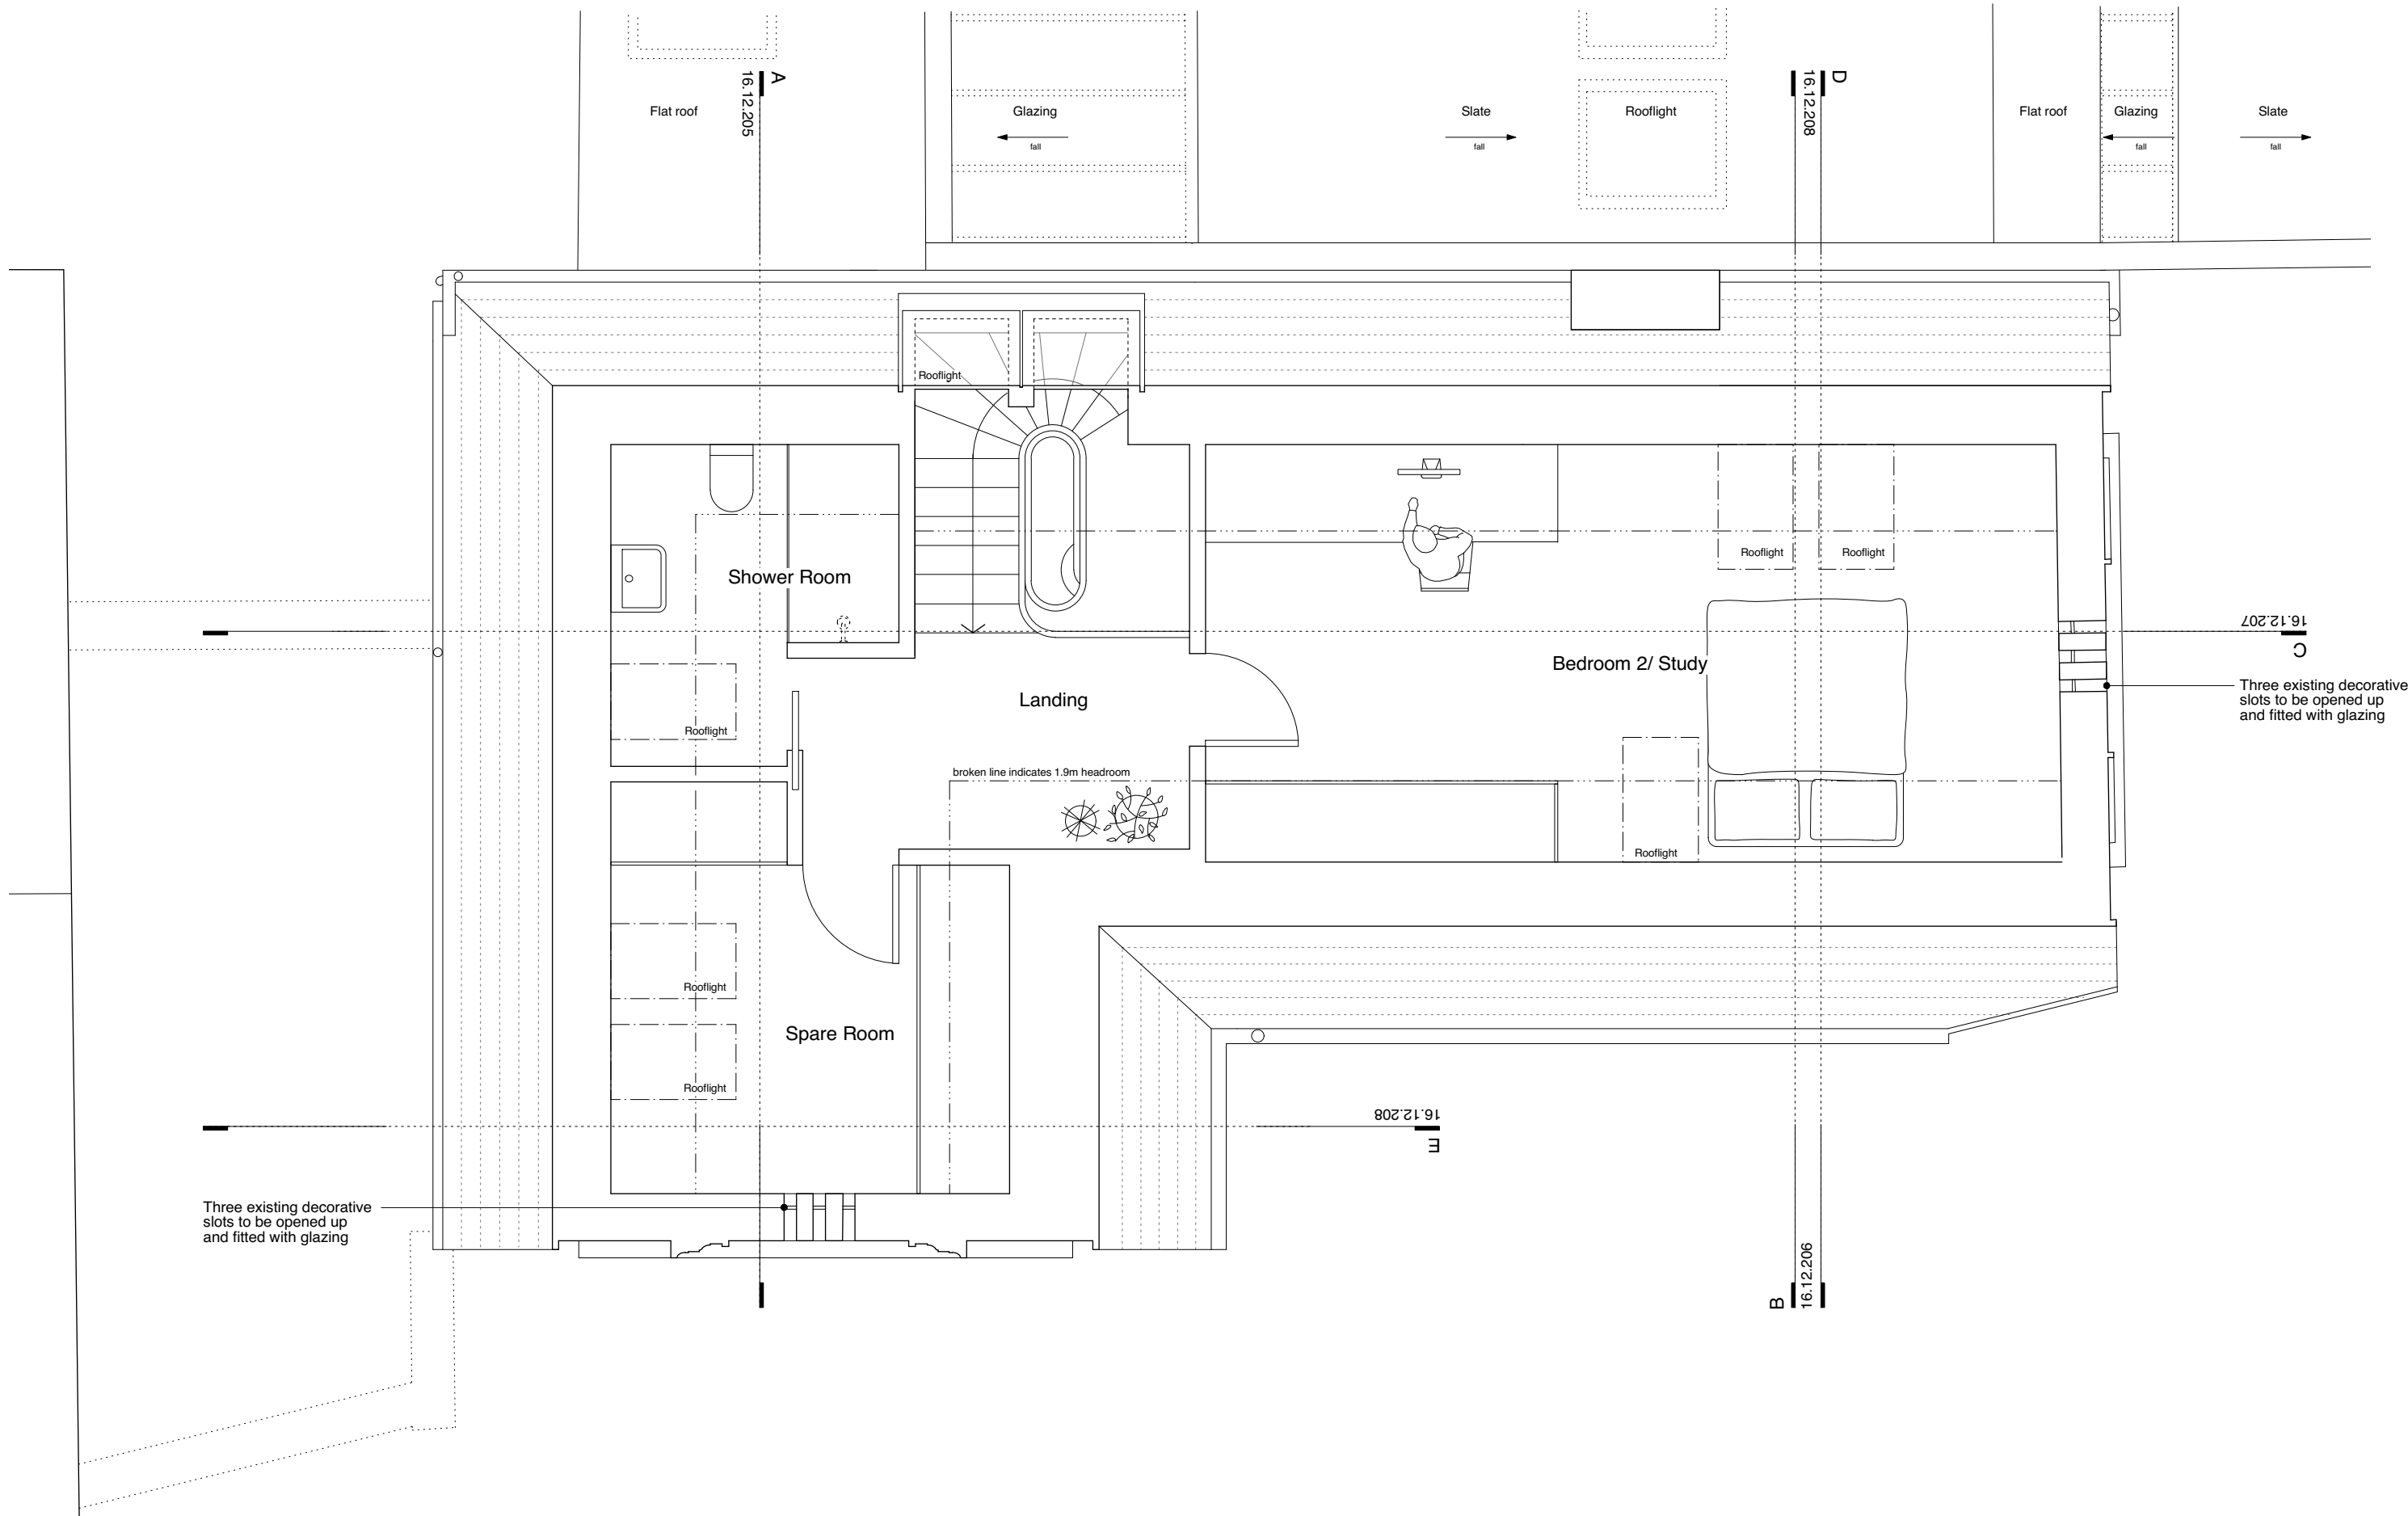

Rev.D 23.02.18: Minor adjustments to rooflight sizes to suit supplier's details  
 Rev.C 27.09.17: Rooflight to front elevation repositioned to suit amended internal layout; Rooflight positions and broken line to denote 1.9m headroom amended to suit raised roof.  
 Rev.A 28.03.17: Rooflights amended.

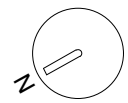
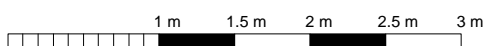


<b>EDRM +</b> <b>DSDHA</b>  <a href="http://www.edrm.co.uk">www.edrm.co.uk</a> <a href="http://www.dsdha.co.uk">www.dsdha.co.uk</a>	Title	Second Floor Plan Proposed		Drawing no.	16.12.203_PL	Rev	D
	Project	Bickersteth House 31 Grove Place, NW3 1JS		Date	12.16	Scale	1:50 @ A3

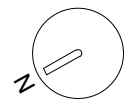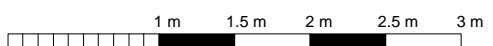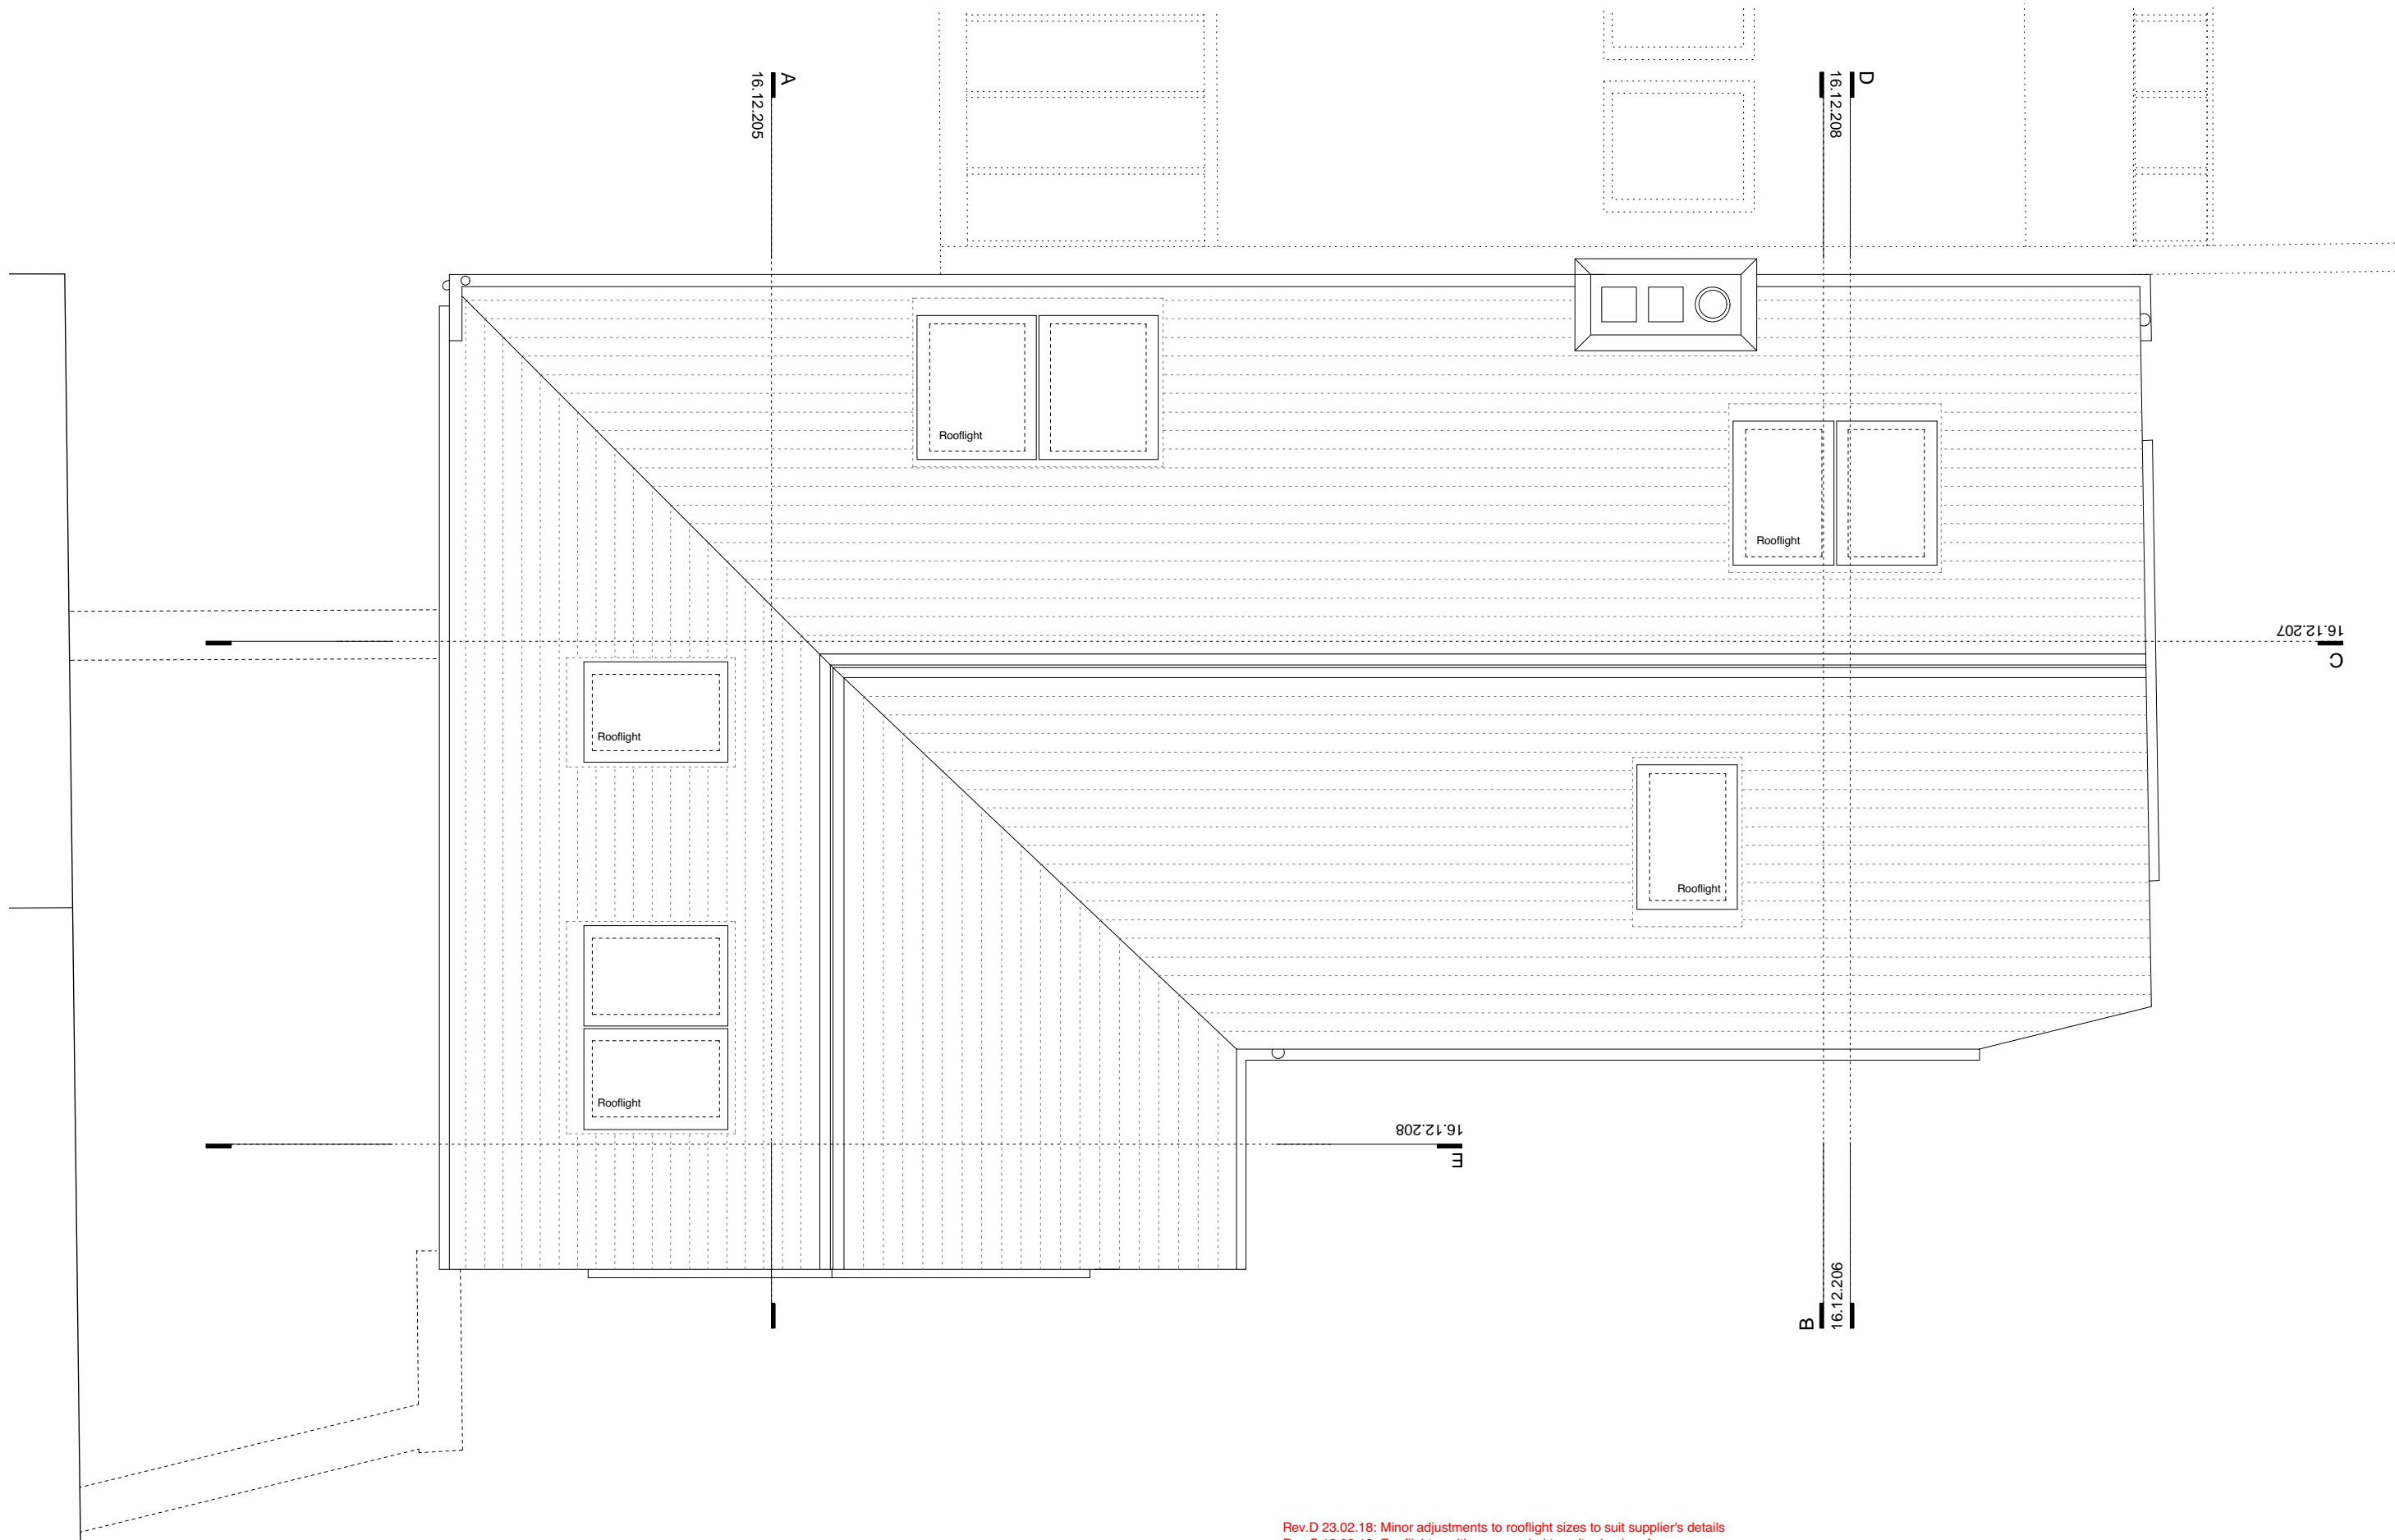

Rev.D 23.02.18: Minor adjustments to rooflight sizes to suit supplier's details  
 Rev.C 13.02.18: Rooflight positions amended to suit raised roof.  
 Rev.B 28.03.17: Rooflights amended.  
 Rev.A 22.03.17: Rooflights amended.

<b>EDRM +</b> <b>DSDHA</b>  <a href="http://www.edrm.co.uk">www.edrm.co.uk</a> <a href="http://www.dsdha.co.uk">www.dsdha.co.uk</a>	Title	Roof Plan Proposed		Drawing no.	16.12.204_PL	Rev	D
	Project	Bickersteth House 31 Grove Place, NW3 1JS		Date	12.16	Scale	1:50 @ A3

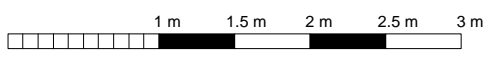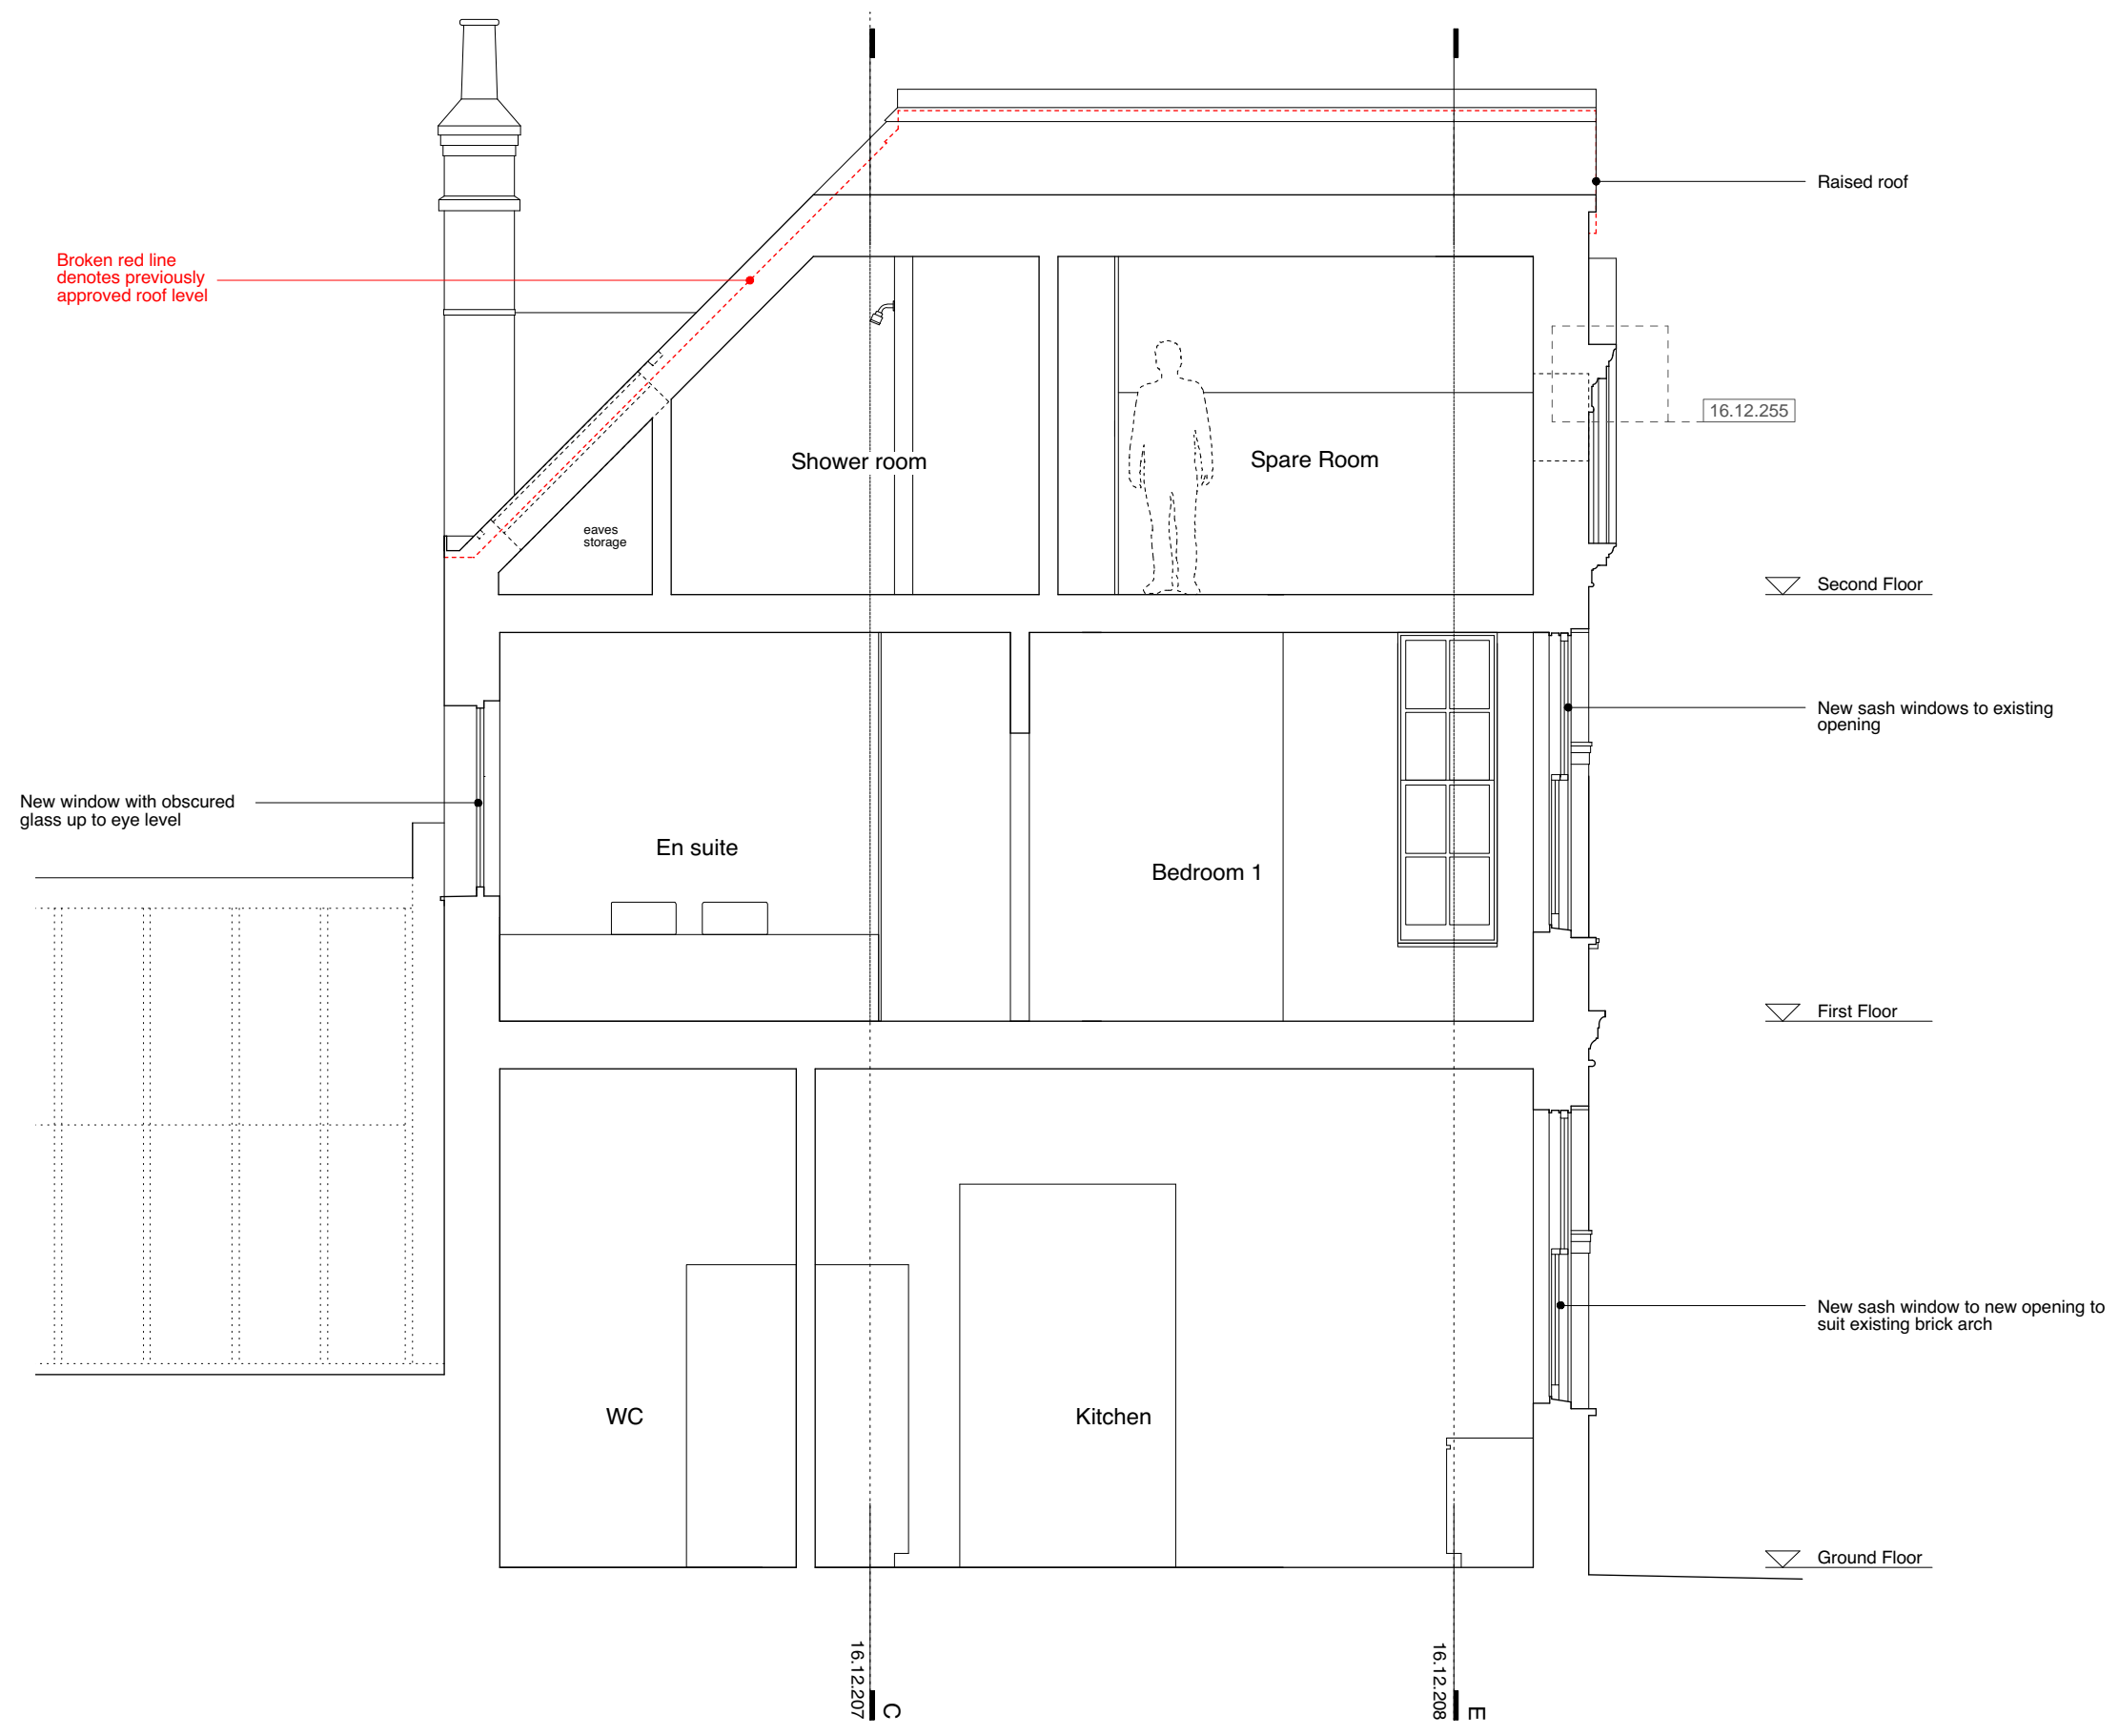


Rev.D 23.02.18: Minor adjustments to rooflight sizes to suit supplier's details  
 Rev.C 13.02.18: Roof level raised by 2 brick courses (c.150mm); intermediate glazing bars added to sash windows.  
 Rev.A 28.03.17: Rooflights amended.

<b>EDRM +</b> <b>DSDHA</b>  <a href="http://www.edrm.co.uk">www.edrm.co.uk</a> <a href="http://www.dsdha.co.uk">www.dsdha.co.uk</a>	Title	Section AA Proposed		Drawing no.	16.12.205_PL	Rev	D
	Project	Bickersteth House 31 Grove Place, NW3 1JS		Date	11.16	Scale	1:50 @ A3



Rev.D 23.02.18: Minor adjustments to rooflight sizes to suit supplier's details  
 Rev.C 13.02.18: Roof level raised by 2 brick courses (c.150mm); intermediate glazing bars added to sash windows; door canopy added  
 Rev.A 28.03.17: Rooflights amended.

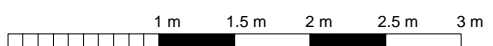

<b>EDRM +</b> <b>DSDHA</b> <a href="http://www.edrm.co.uk">www.edrm.co.uk</a> <a href="http://www.dsdha.co.uk">www.dsdha.co.uk</a>	Title	Section BB Proposed		Drawing no.	16.12.206_PL	Rev	D
	Project	Bickersteth House 31 Grove Place, NW3 1JS		Date	11.16	Scale	1:50 @ A3



Broken red line denotes previously approved roof level

Raised roof


Second Floor

First Floor

Ground Floor




New timber sash windows to existing opening

Glazed door to existing opening

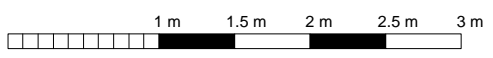

Rev.D 23.02.18: Minor adjustments to rooflight sizes to suit supplier's details  
 Rev.C 13.02.18: Roof level raised by 2 brick courses (c.150mm); intermediate glazing bars added to sash windows.  
 Rev.A 28.03.17: Rooflights amended.

<b>EDRM +</b> <b>DSDHA</b> <a href="http://www.edrm.co.uk">www.edrm.co.uk</a> <a href="http://www.dsdha.co.uk">www.dsdha.co.uk</a>	Title	Section CC Proposed		Drawing no.	16.12.207_PL	Rev	D
	Project	Bickersteth House 31 Grove Place, NW3 1JS		Date	11.16	Scale	1:50 @ A3

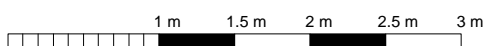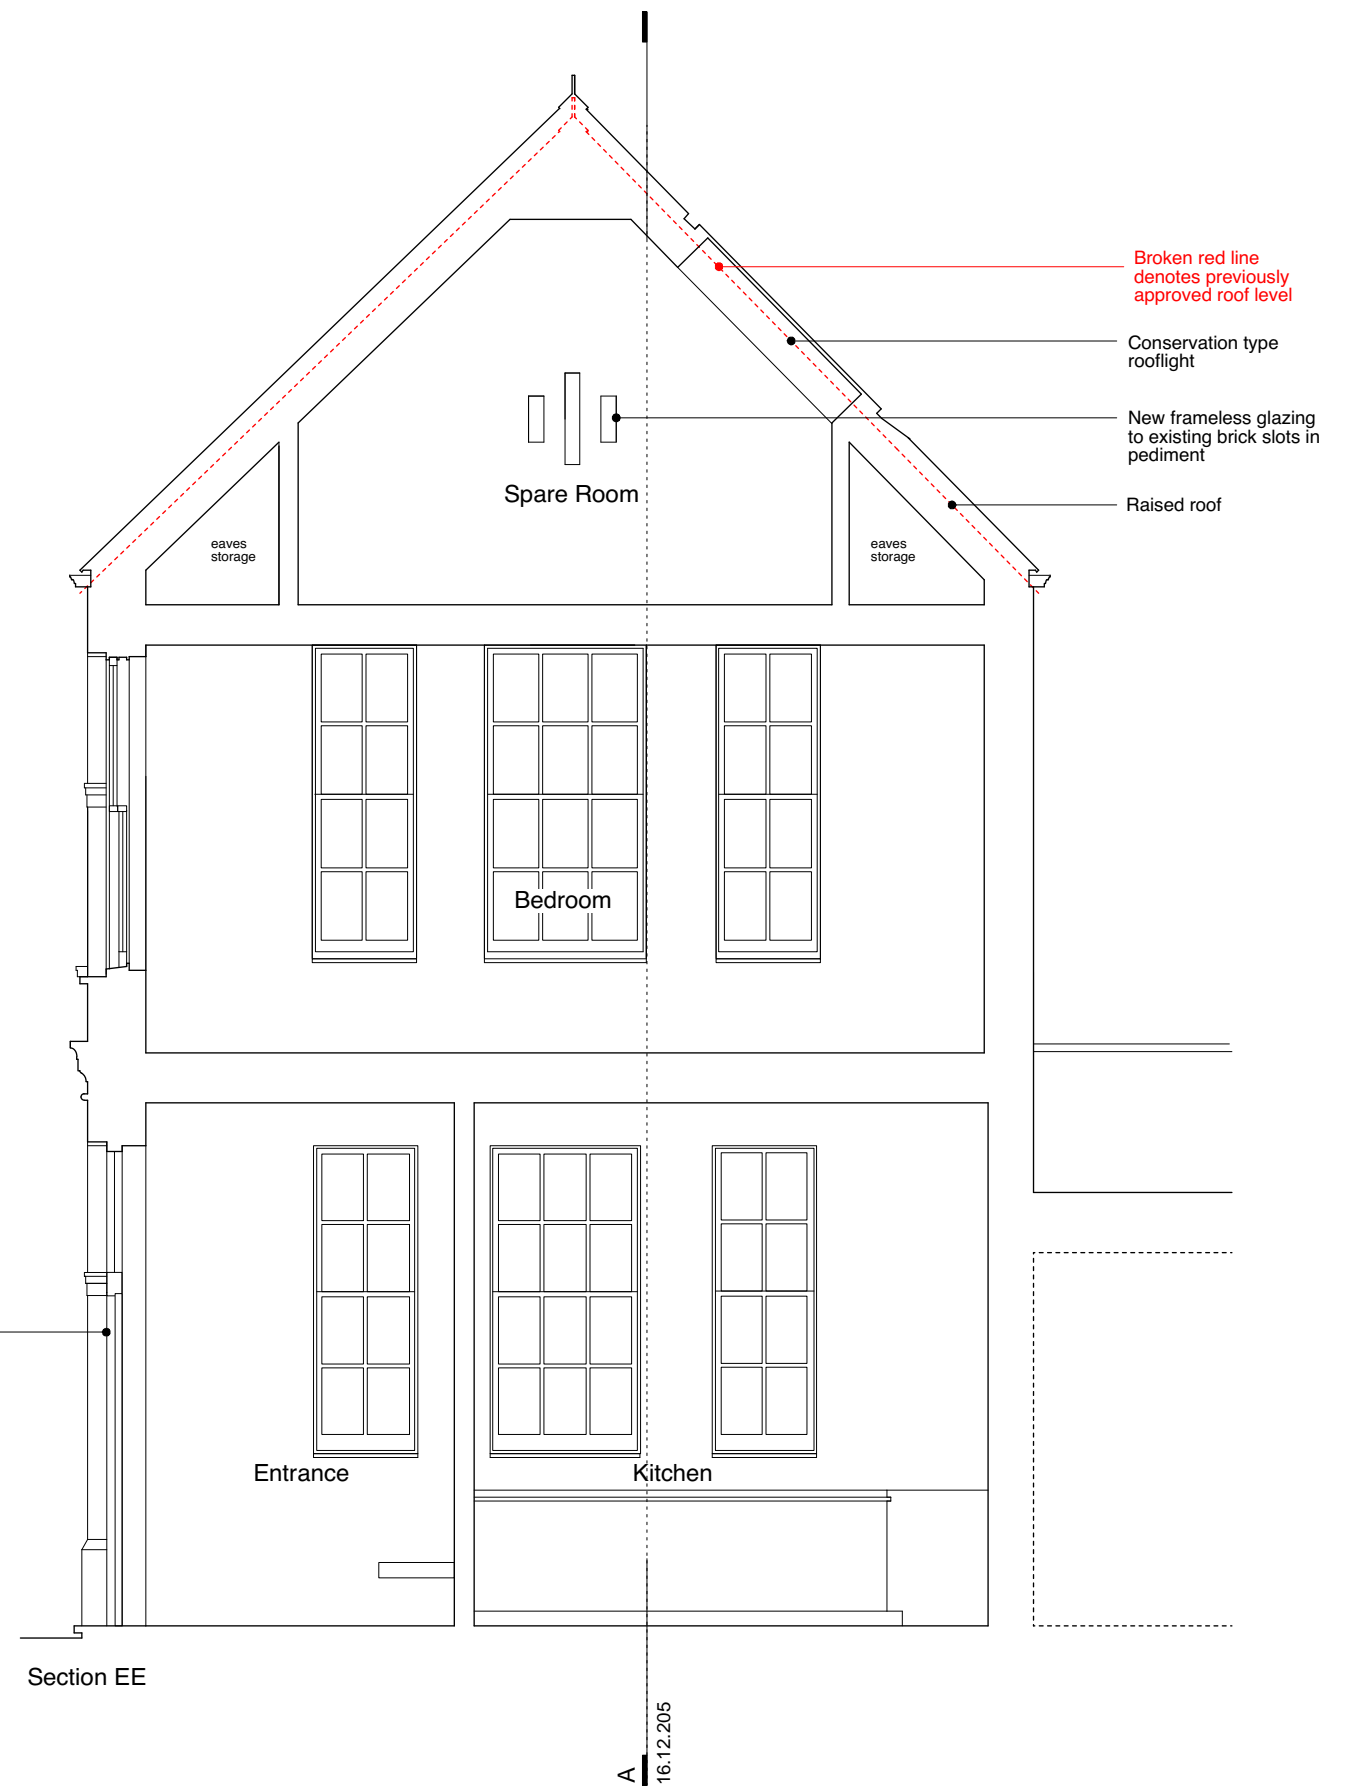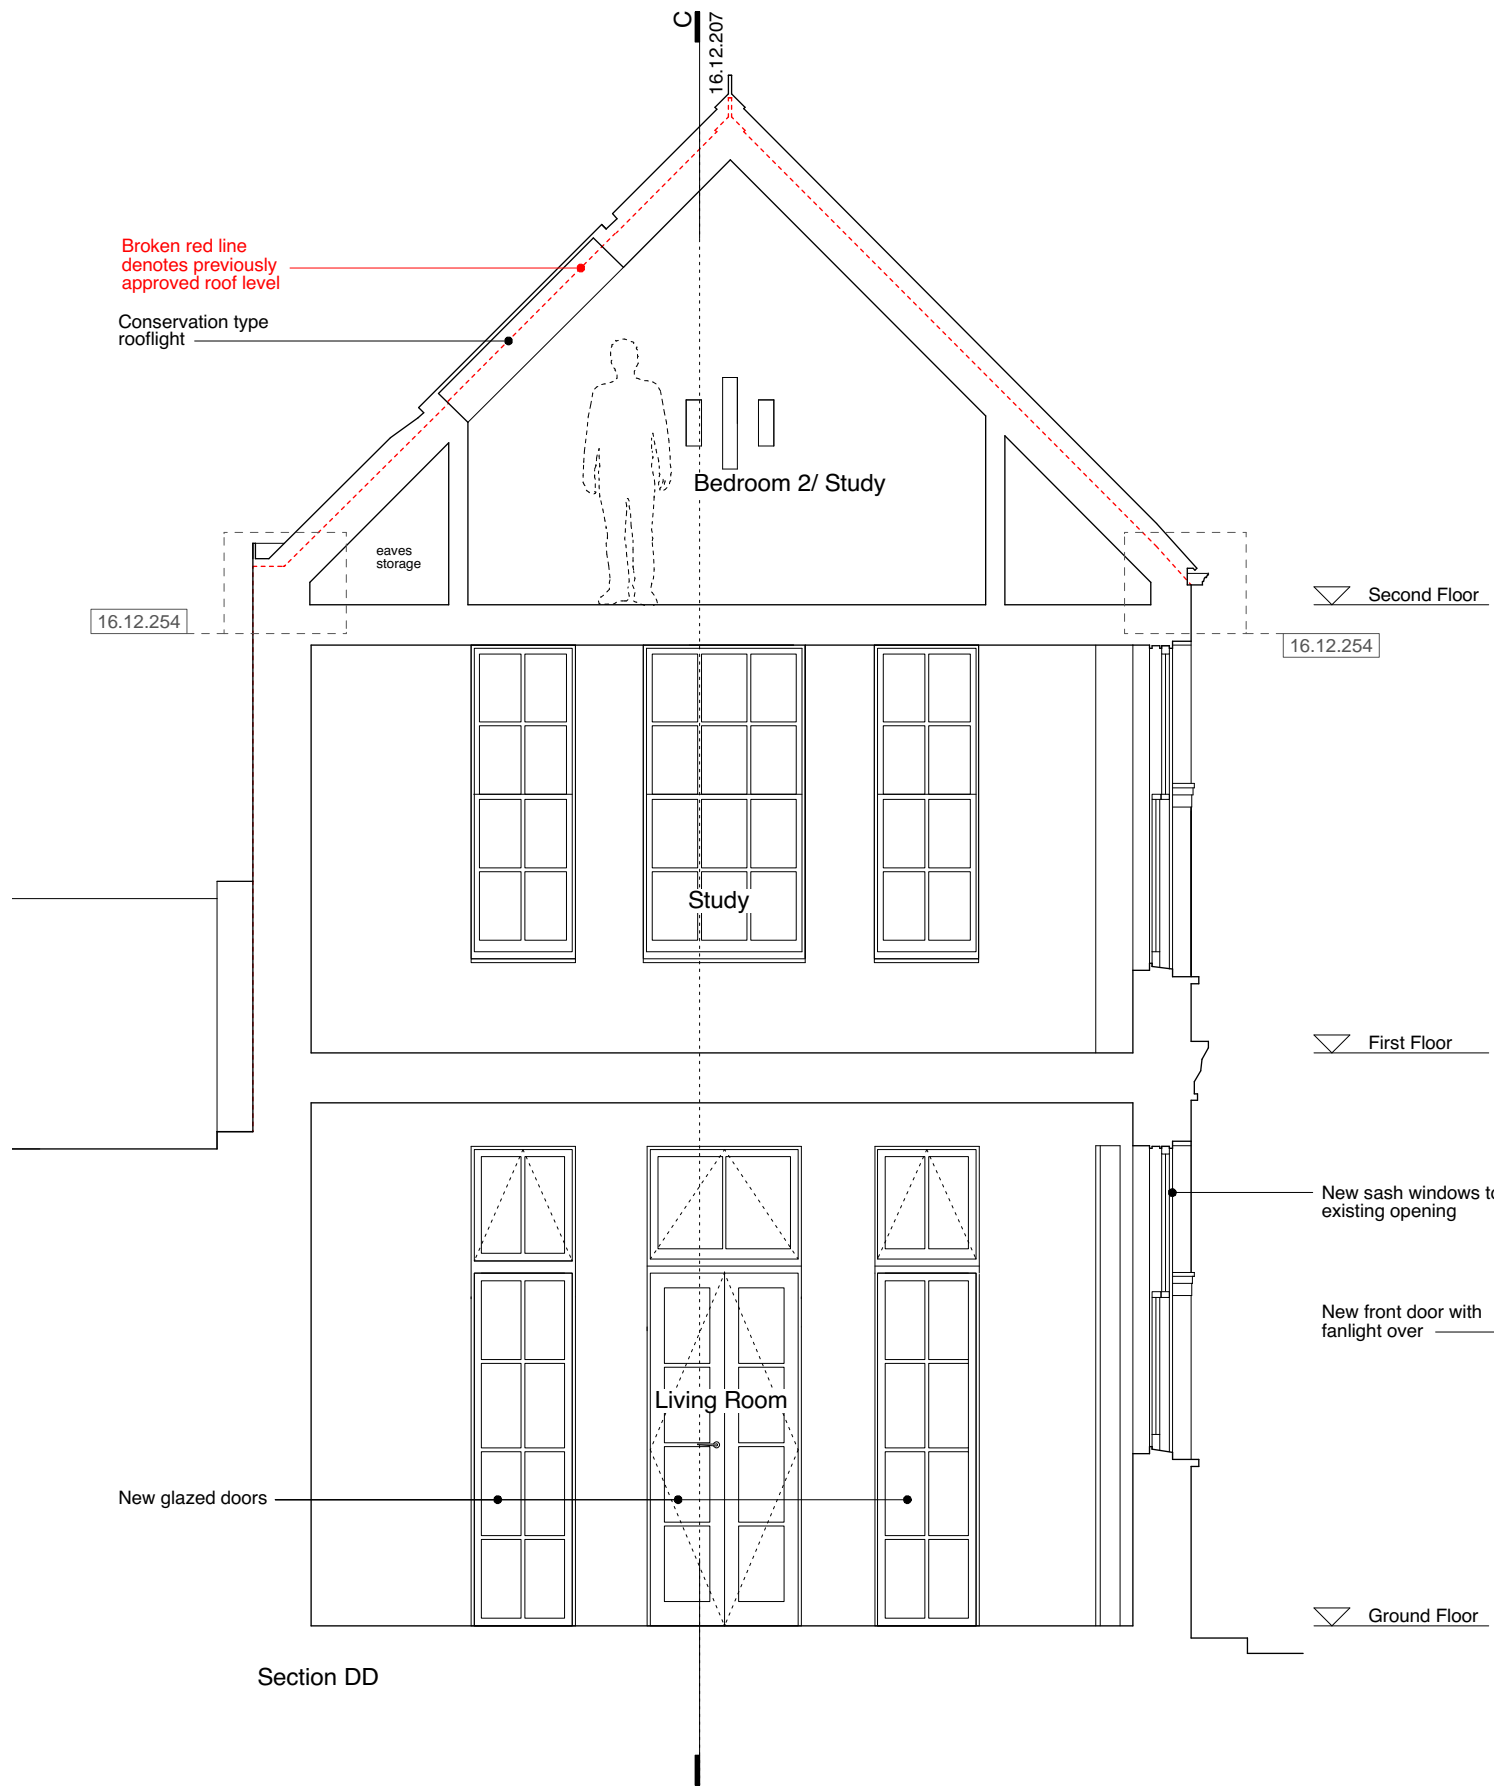


Rev.D 23.02.18: Minor adjustments to rooflight sizes to suit supplier's details  
 Rev.C 13.02.18: Roof level raised by 2 brick courses (c.150mm); intermediate glazing bars added to sash windows.  
 Rev.A 28.03.17: Rooflights amended.

<b>EDRM +</b> <b>DSDHA</b>  <a href="http://www.edrm.co.uk">www.edrm.co.uk</a> <a href="http://www.dsdha.co.uk">www.dsdha.co.uk</a>	Title	Section DD and EE Proposed		Drawing no.	16.12.208_PL	Rev	D
	Project	Bickersteth House 31 Grove Place, NW3 1JS		Date	11.16	Scale	1:50 @ A3






Rev.D 23.02.18: Minor adjustments to rooflight sizes to suit supplier's details  
 Rev.C 13.02.18: Roof level raised by 2 brick courses (c.150mm); intermediate glazing bars added to sash windows; Rooflight repositioned  
 Rev.B 28.03.17: Rooflights amended, roof finish note added.

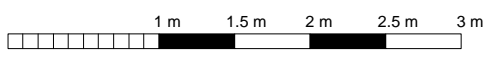


<b>EDRM +</b> <b>DSDHA</b>  <a href="http://www.edrm.co.uk">www.edrm.co.uk</a> <a href="http://www.dsdha.co.uk">www.dsdha.co.uk</a>	Title	North West Elevation Proposed Facing Grove Place	Drawing no.	16.12.209_PL	Rev	D
	Project	Bickersteth House 31 Grove Place, NW3 1JS	Date	12.16	Scale	1:50 @ A3




Rev.D 23.02.18: No amendments further to those listed under Rev.C  
 Rev.C 13.02.18: Roof level raised by 2 brick courses (c.150mm); intermediate glazing bars added to the sash windows, fixed lights and doors.  
 Rev.A 22.03.17: Roof finish note added.

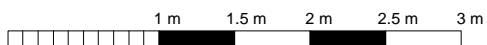


<b>EDRM +</b> <b>DSDHA</b>  <a href="http://www.edrm.co.uk">www.edrm.co.uk</a> <a href="http://www.dsdha.co.uk">www.dsdha.co.uk</a>	Title	South West Elevation Proposed Facing Garden	Drawing no.	16.12.210_PL	Rev	D
	Project	Bickersteth House 31 Grove Place, NW3 1JS	Date	12.16	Scale	1:50 @ A3

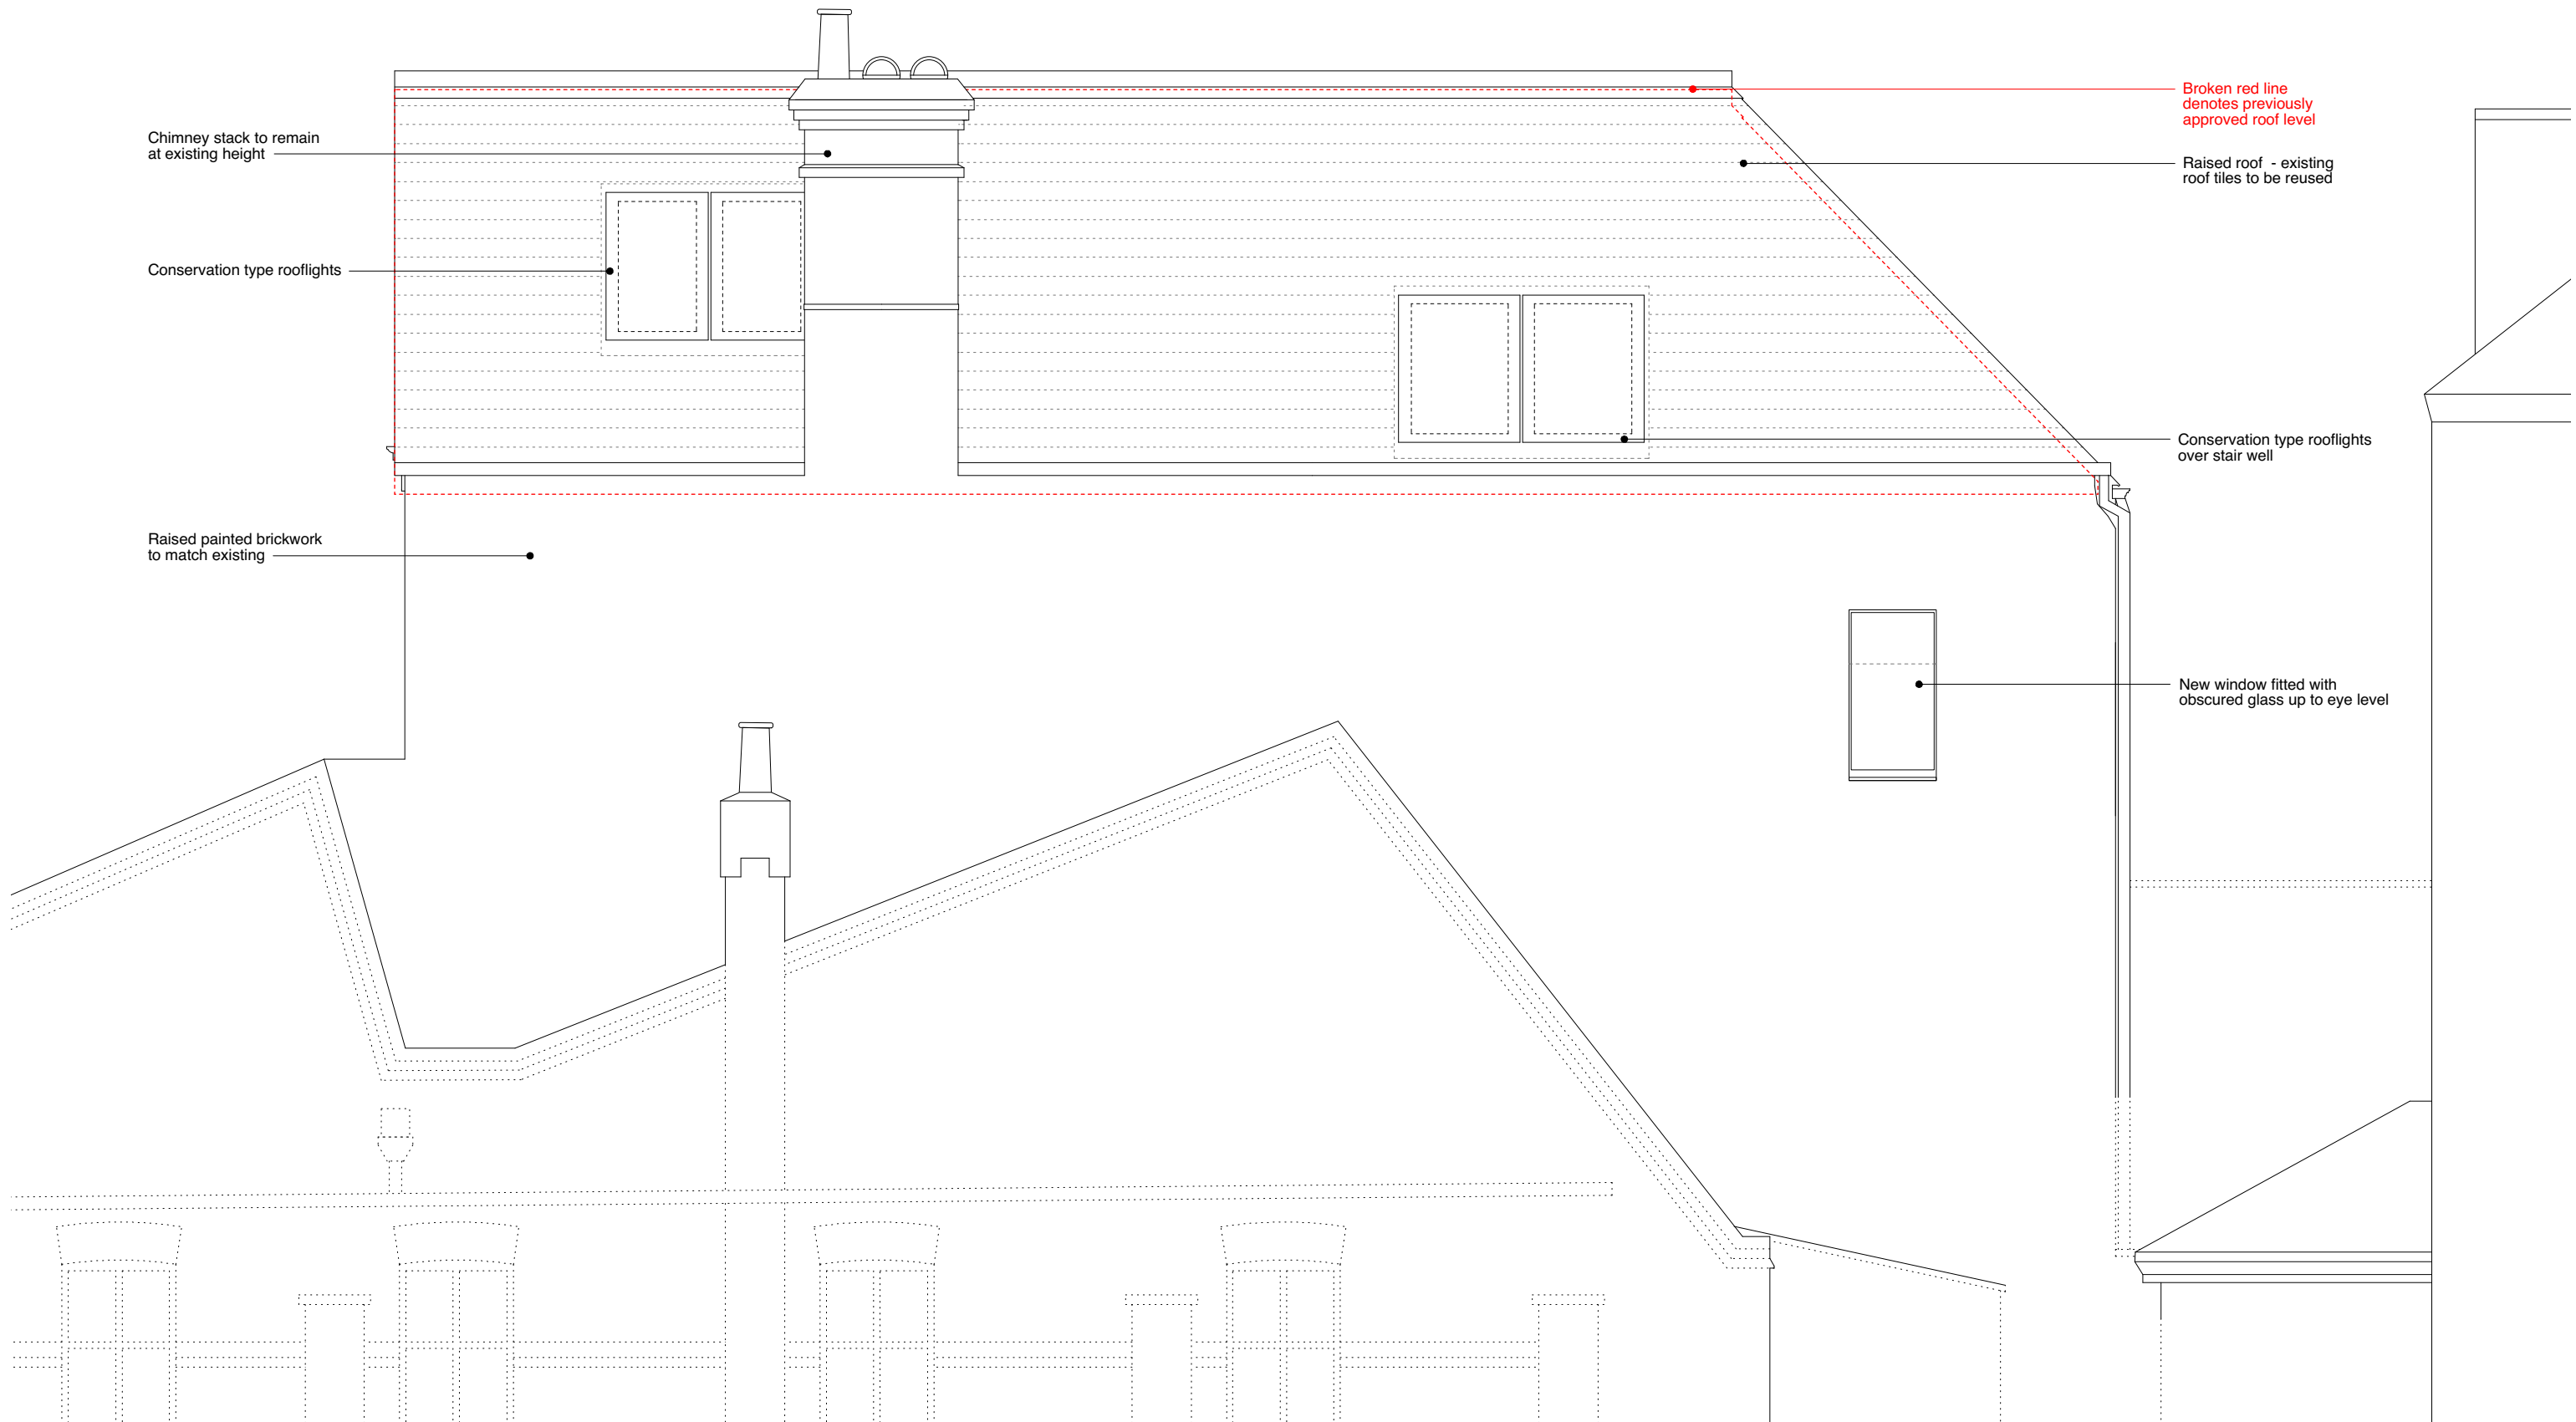


Rev.D 23.02.18: Minor adjustments to rooflight sizes to suit supplier's details  
 Rev.C 13.02.18: Roof level raised by 2 brick courses (c.150mm).  
 Rev.B 28.03.17: Rooflights amended, roof finish note added.  
 Rev.A 22.03.17: Rooflights amended.

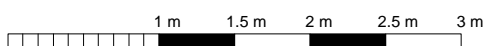

<b>EDRM +</b> <b>DSDHA</b>  <a href="http://www.edrm.co.uk">www.edrm.co.uk</a> <a href="http://www.dsdha.co.uk">www.dsdha.co.uk</a>	Title	South East Elevation Proposed Facing Well Road	Drawing no.	16.12.211_PL	Rev	D
	Project	Bickersteth House 31 Grove Place, NW3 1JS	Date	11.16	Scale	1:50 @ A3

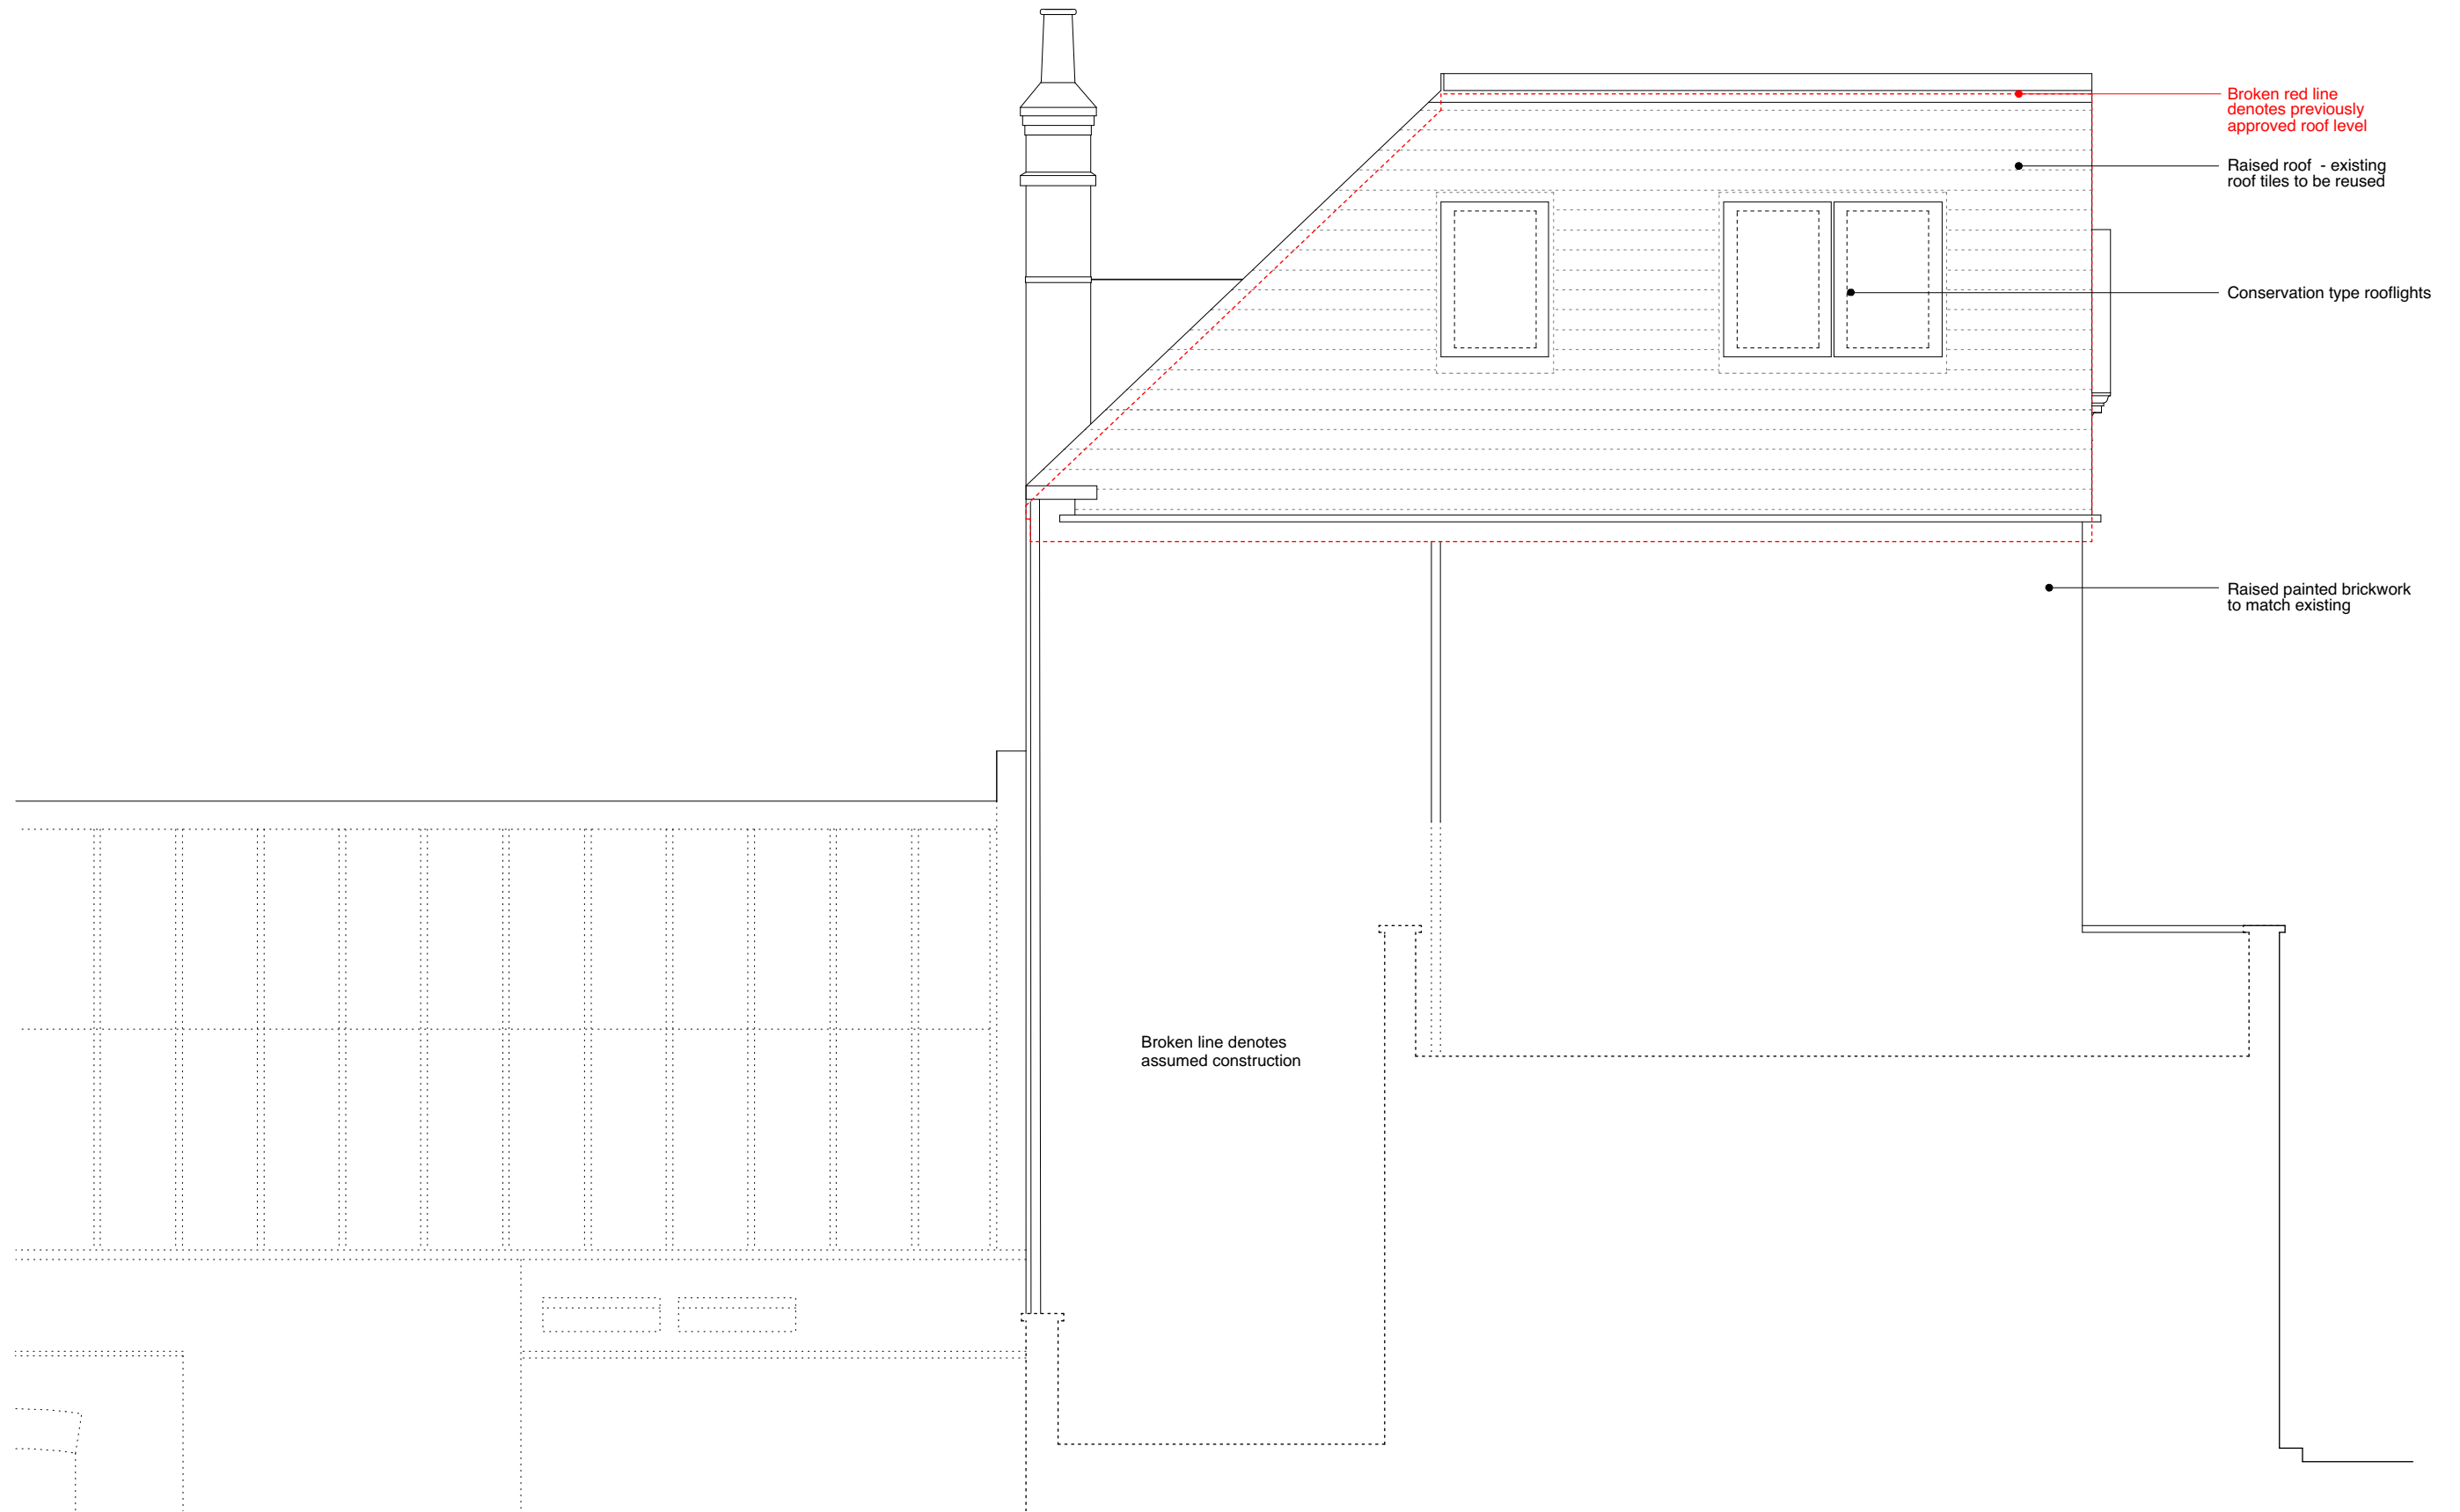

Rev.D 23.02.18: Minor adjustments to rooflight sizes to suit supplier's details  
 Rev.C 13.02.18: Roof level raised by 2 brick courses (c.150mm).  
 Rev.B 28.03.17: Roof finish note added.  
 Rev.A 22.03.17: Rooflights amended.

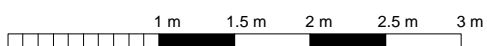


<b>EDRM +</b> <b>DSDHA</b>  <a href="http://www.edrm.co.uk">www.edrm.co.uk</a> <a href="http://www.dsdha.co.uk">www.dsdha.co.uk</a>	Title	North East Elevation Proposed Facing Number 30 Grove Place	Drawing no.	16.12.212_PL	Rev	D
	Project	Bickersteth House 31 Grove Place, NW3 1JS	Date	12.16	Scale	1:50 @ A3



Broken red line denotes previously approved roof level

Number 30

Number 31

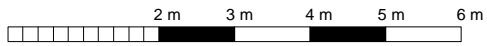

Rev.D 23.02.18: Minor adjustments to rooflight sizes to suit supplier's details  
 Rev.C 13.02.18: Roof level raised by 2 brick courses (c.150mm); intermediate glazing bars added to sash windows; Rooflight repositioned.  
 Rev.A 28.03.17: Rooflights amended.

<b>EDRM +</b> <b>DSDHA</b>  <a href="http://www.edrm.co.uk">www.edrm.co.uk</a> <a href="http://www.dsdha.co.uk">www.dsdha.co.uk</a>	Title	NW Elevation Proposed Facing Grove Place	Drawing no.	16.12.213_PL	Rev	D
	Project	Bickersteth House 31 Grove Place, NW3 1JS	Date	12.16	Scale	1:100 @ A3