



ORIGINAL SOUTH WEST (SIDE) ELEVATION

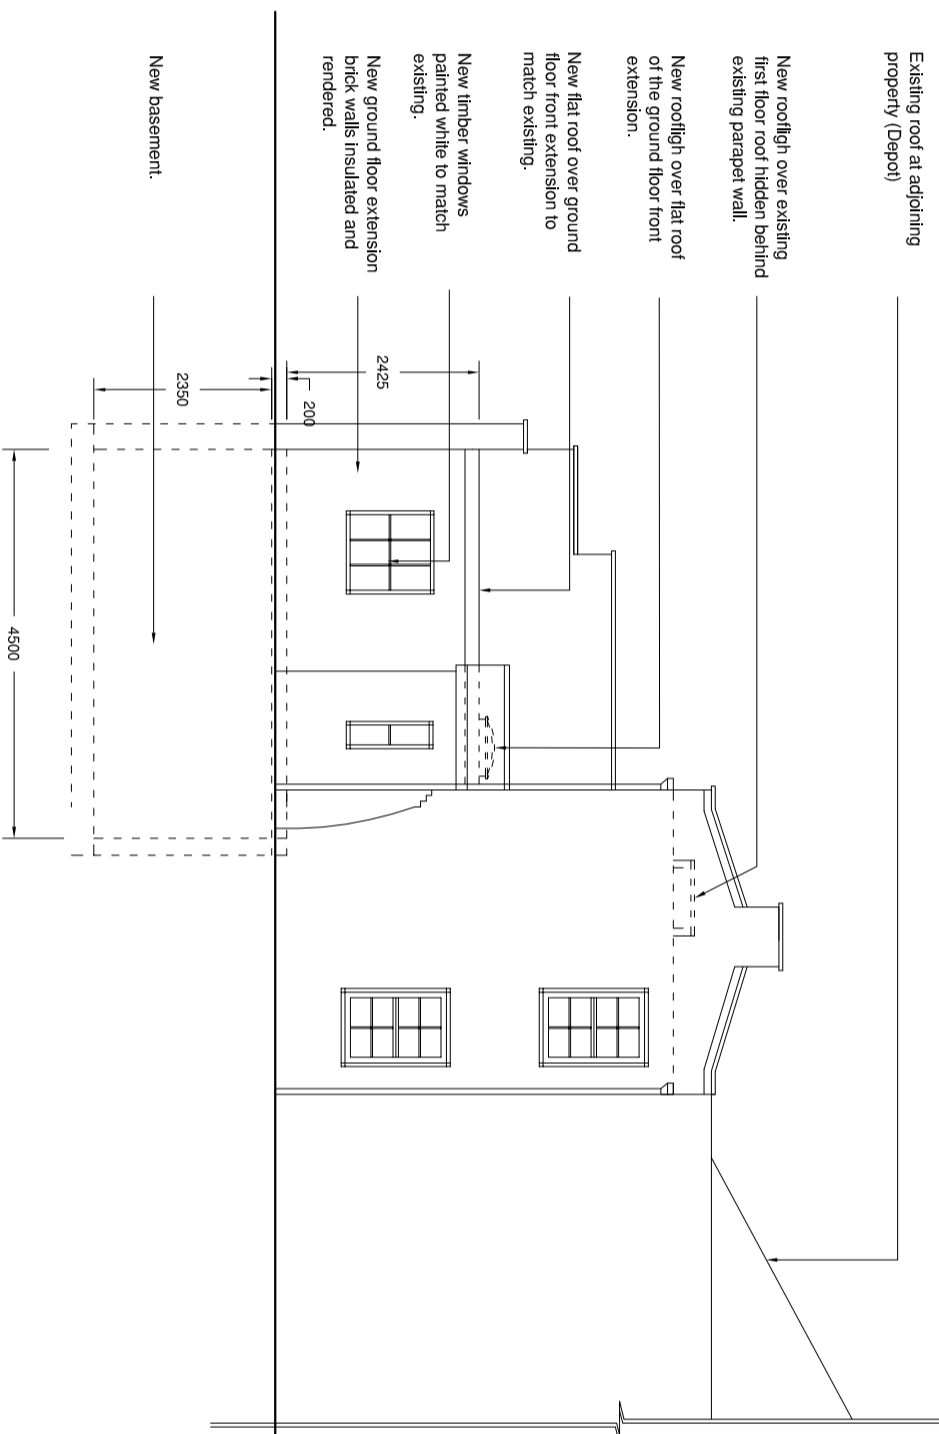

AS BUILT SOUTH WEST (SIDE) ELEVATION

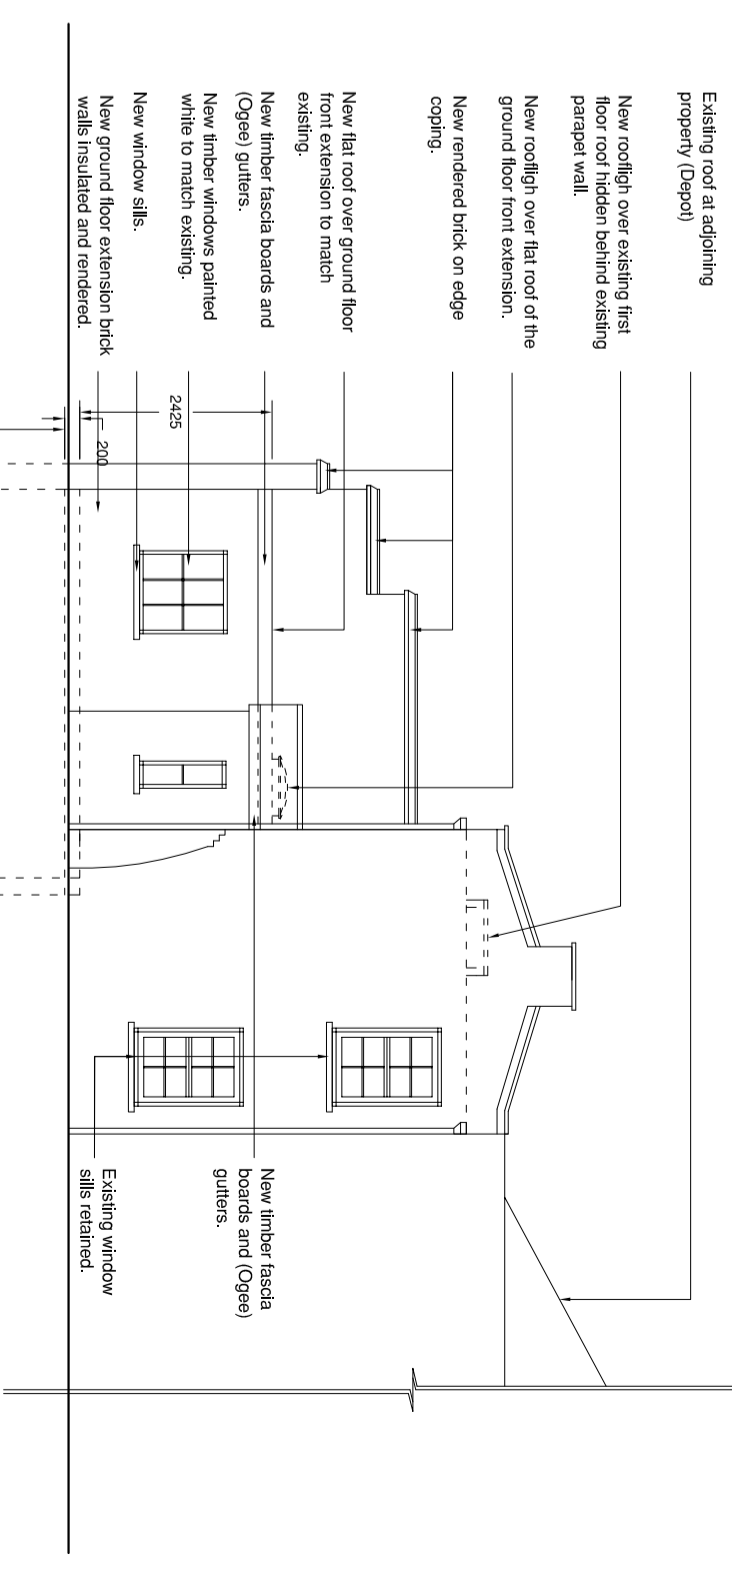

PROPOSED SOUTH WEST (SIDE) ELEVATION

Revision
a (00 / 00 / 2018).

Notes

N. Abdelsaid
101 Oakkington Ave.
London HA9 8HY
Tel / Fax: 020 8904 4786
Mob: 07958 659982
E-mail: nastriagib@yahoo.co.uk

Mr Remzi Hassani
20 Fortess Grove
London NW5 2HD
Original, As Built & Proposed South West (Side)
Elevations



March 2018
Scale: 1 : 100 @ A2
Dwg : 528.P1.07c