



ORIGINAL SECTION A - A

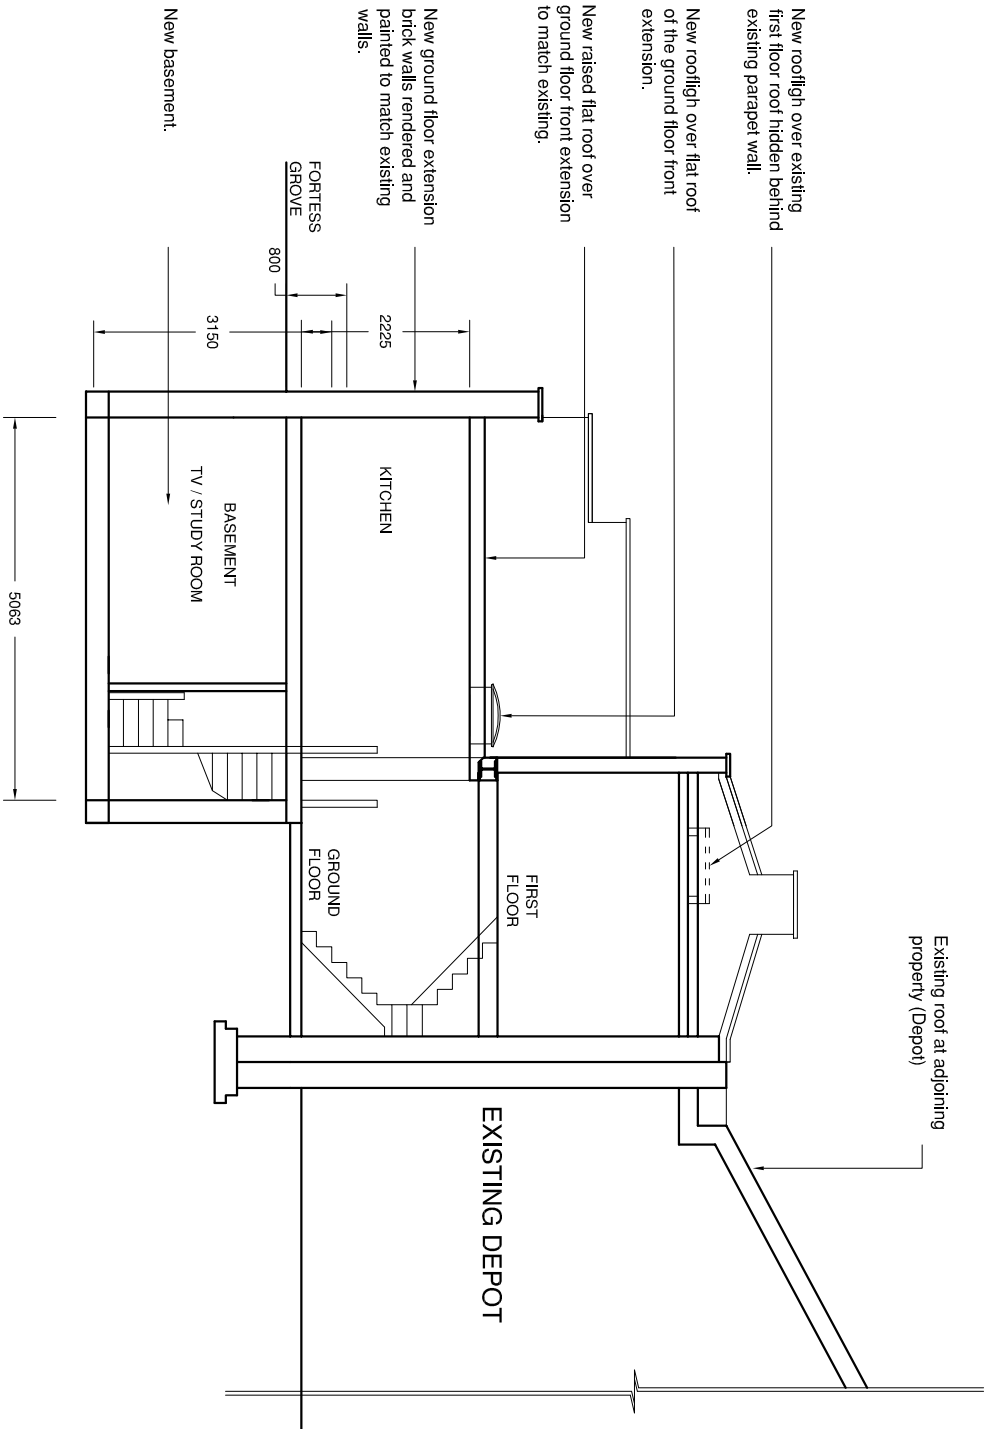

AS BUILT SECTION A - A

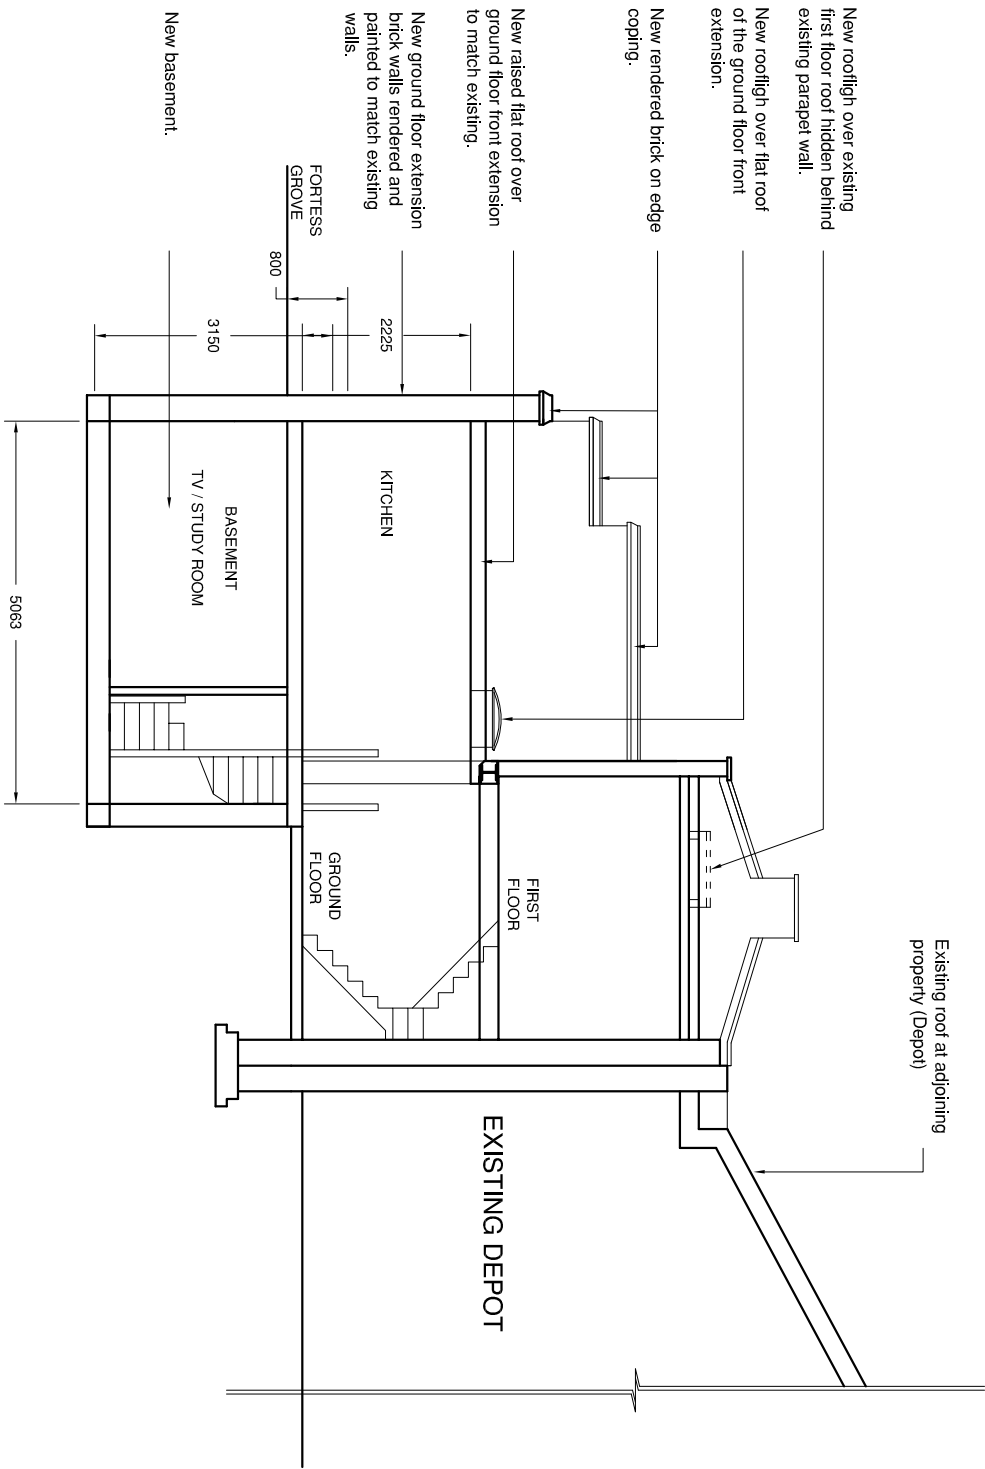


PROPOSED SECTION A - A

Revision
a (00 / 00 / 2018).

Notes

N. Abdelsaid
101 Oakington Ave.
London HA9 8HY
Tel / Fax: 020 8904 4786
Mob: 07958 659982
E-mail: nastnagib@yahoo.co.uk

Mr Remzi Hassani
20 Fortress Grove
London NW5 2HD
Original, As Built & Proposed Sections A - A

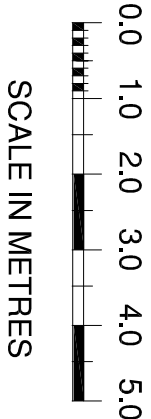

March 2018
Scale: 1 : 100 @ A2
Dwg : 528.PLT.09b