



ORIGINAL SECTION B - B

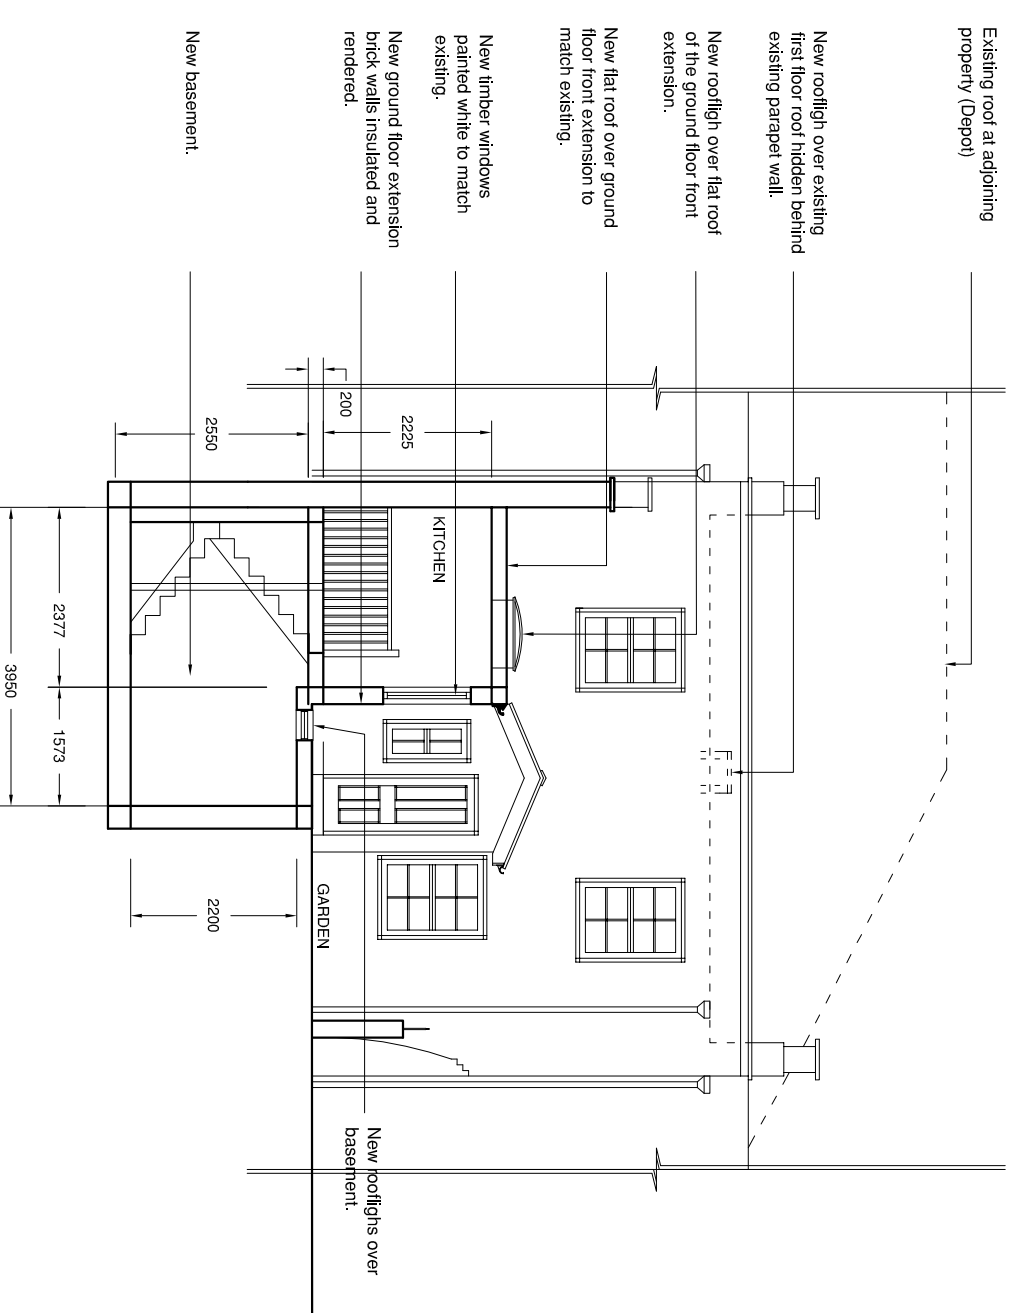

AS BUILT SECTION B - B

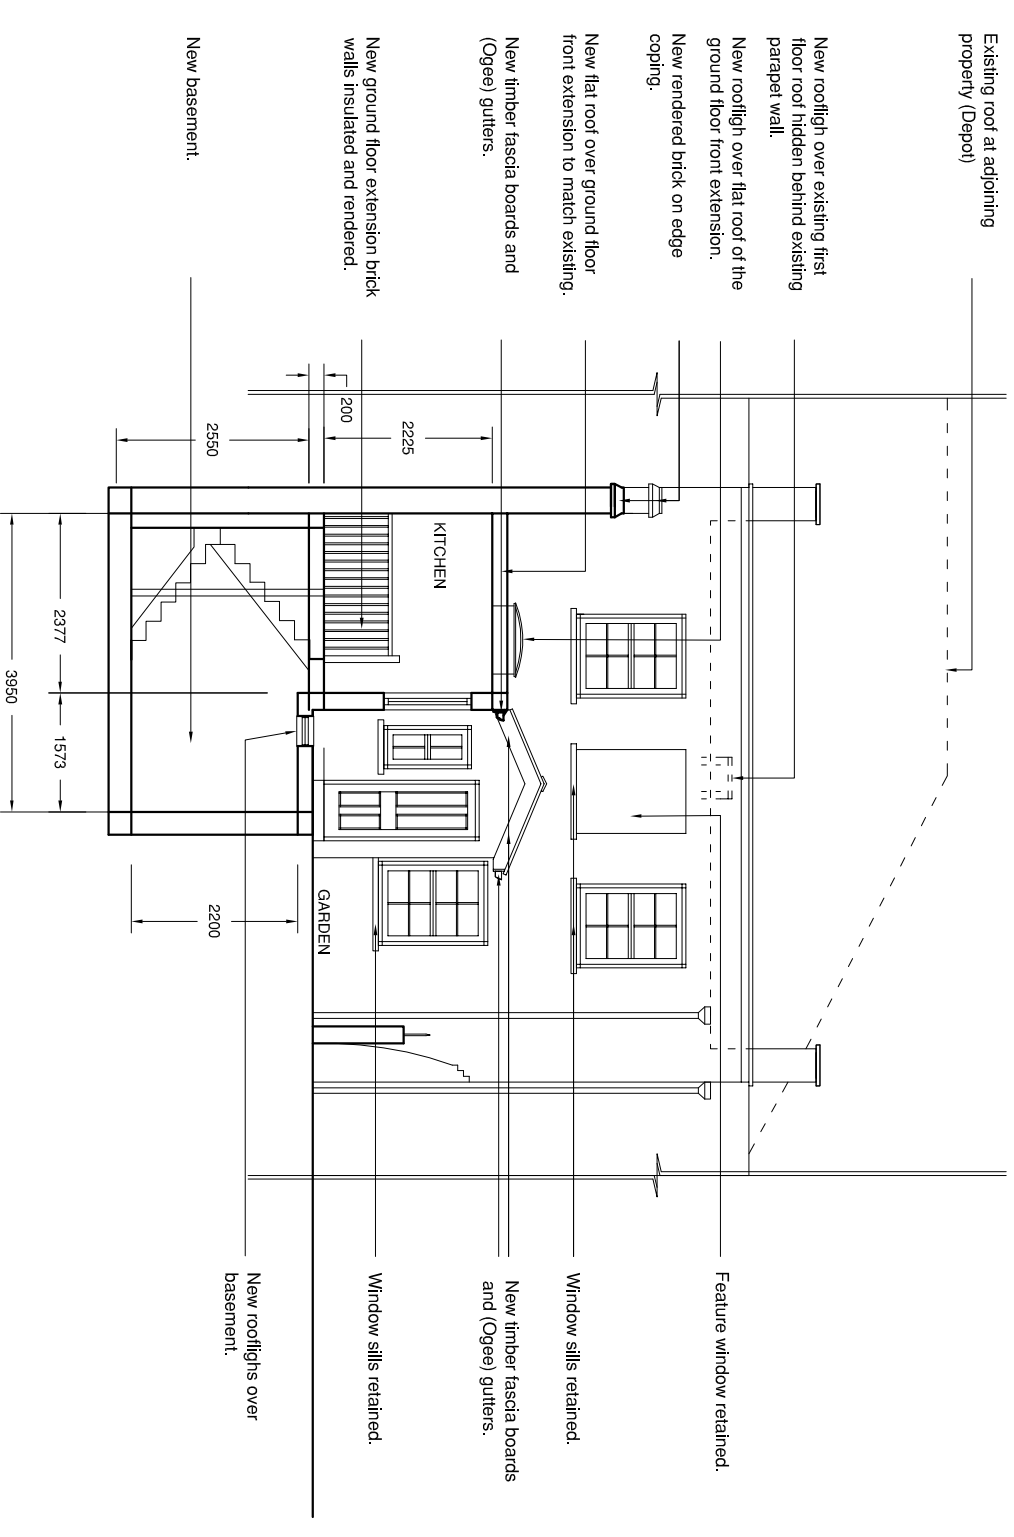

PROPOSED SECTION B - B

Existing roof at adjoining property (Depot)

Existing roof at adjoining property (Depot)

Existing roof at adjoining property (Depot)

New rooflight over existing first floor roof hidden behind existing parapet wall.

New rooflight over flat roof of the ground floor front extension.

New flat roof over ground floor front extension to match existing.

New timber windows painted white to match existing.

New ground floor extension brick walls insulated and rendered.

New Basement.

New rooflight over existing first floor roof hidden behind existing parapet wall.

New rooflight over flat roof of the ground floor front extension.

New rendered brick on edge coping.

New flat roof over ground floor front extension to match existing.

New timber fascia boards and (Ogee) gutters.

New Basement.

Feature window retained.

Window sills retained.

New timber fascia boards and (Ogee) gutters.

Window sills retained.

New rooflights over basement.