



ORIGINAL GROUND FLOOR PLAN

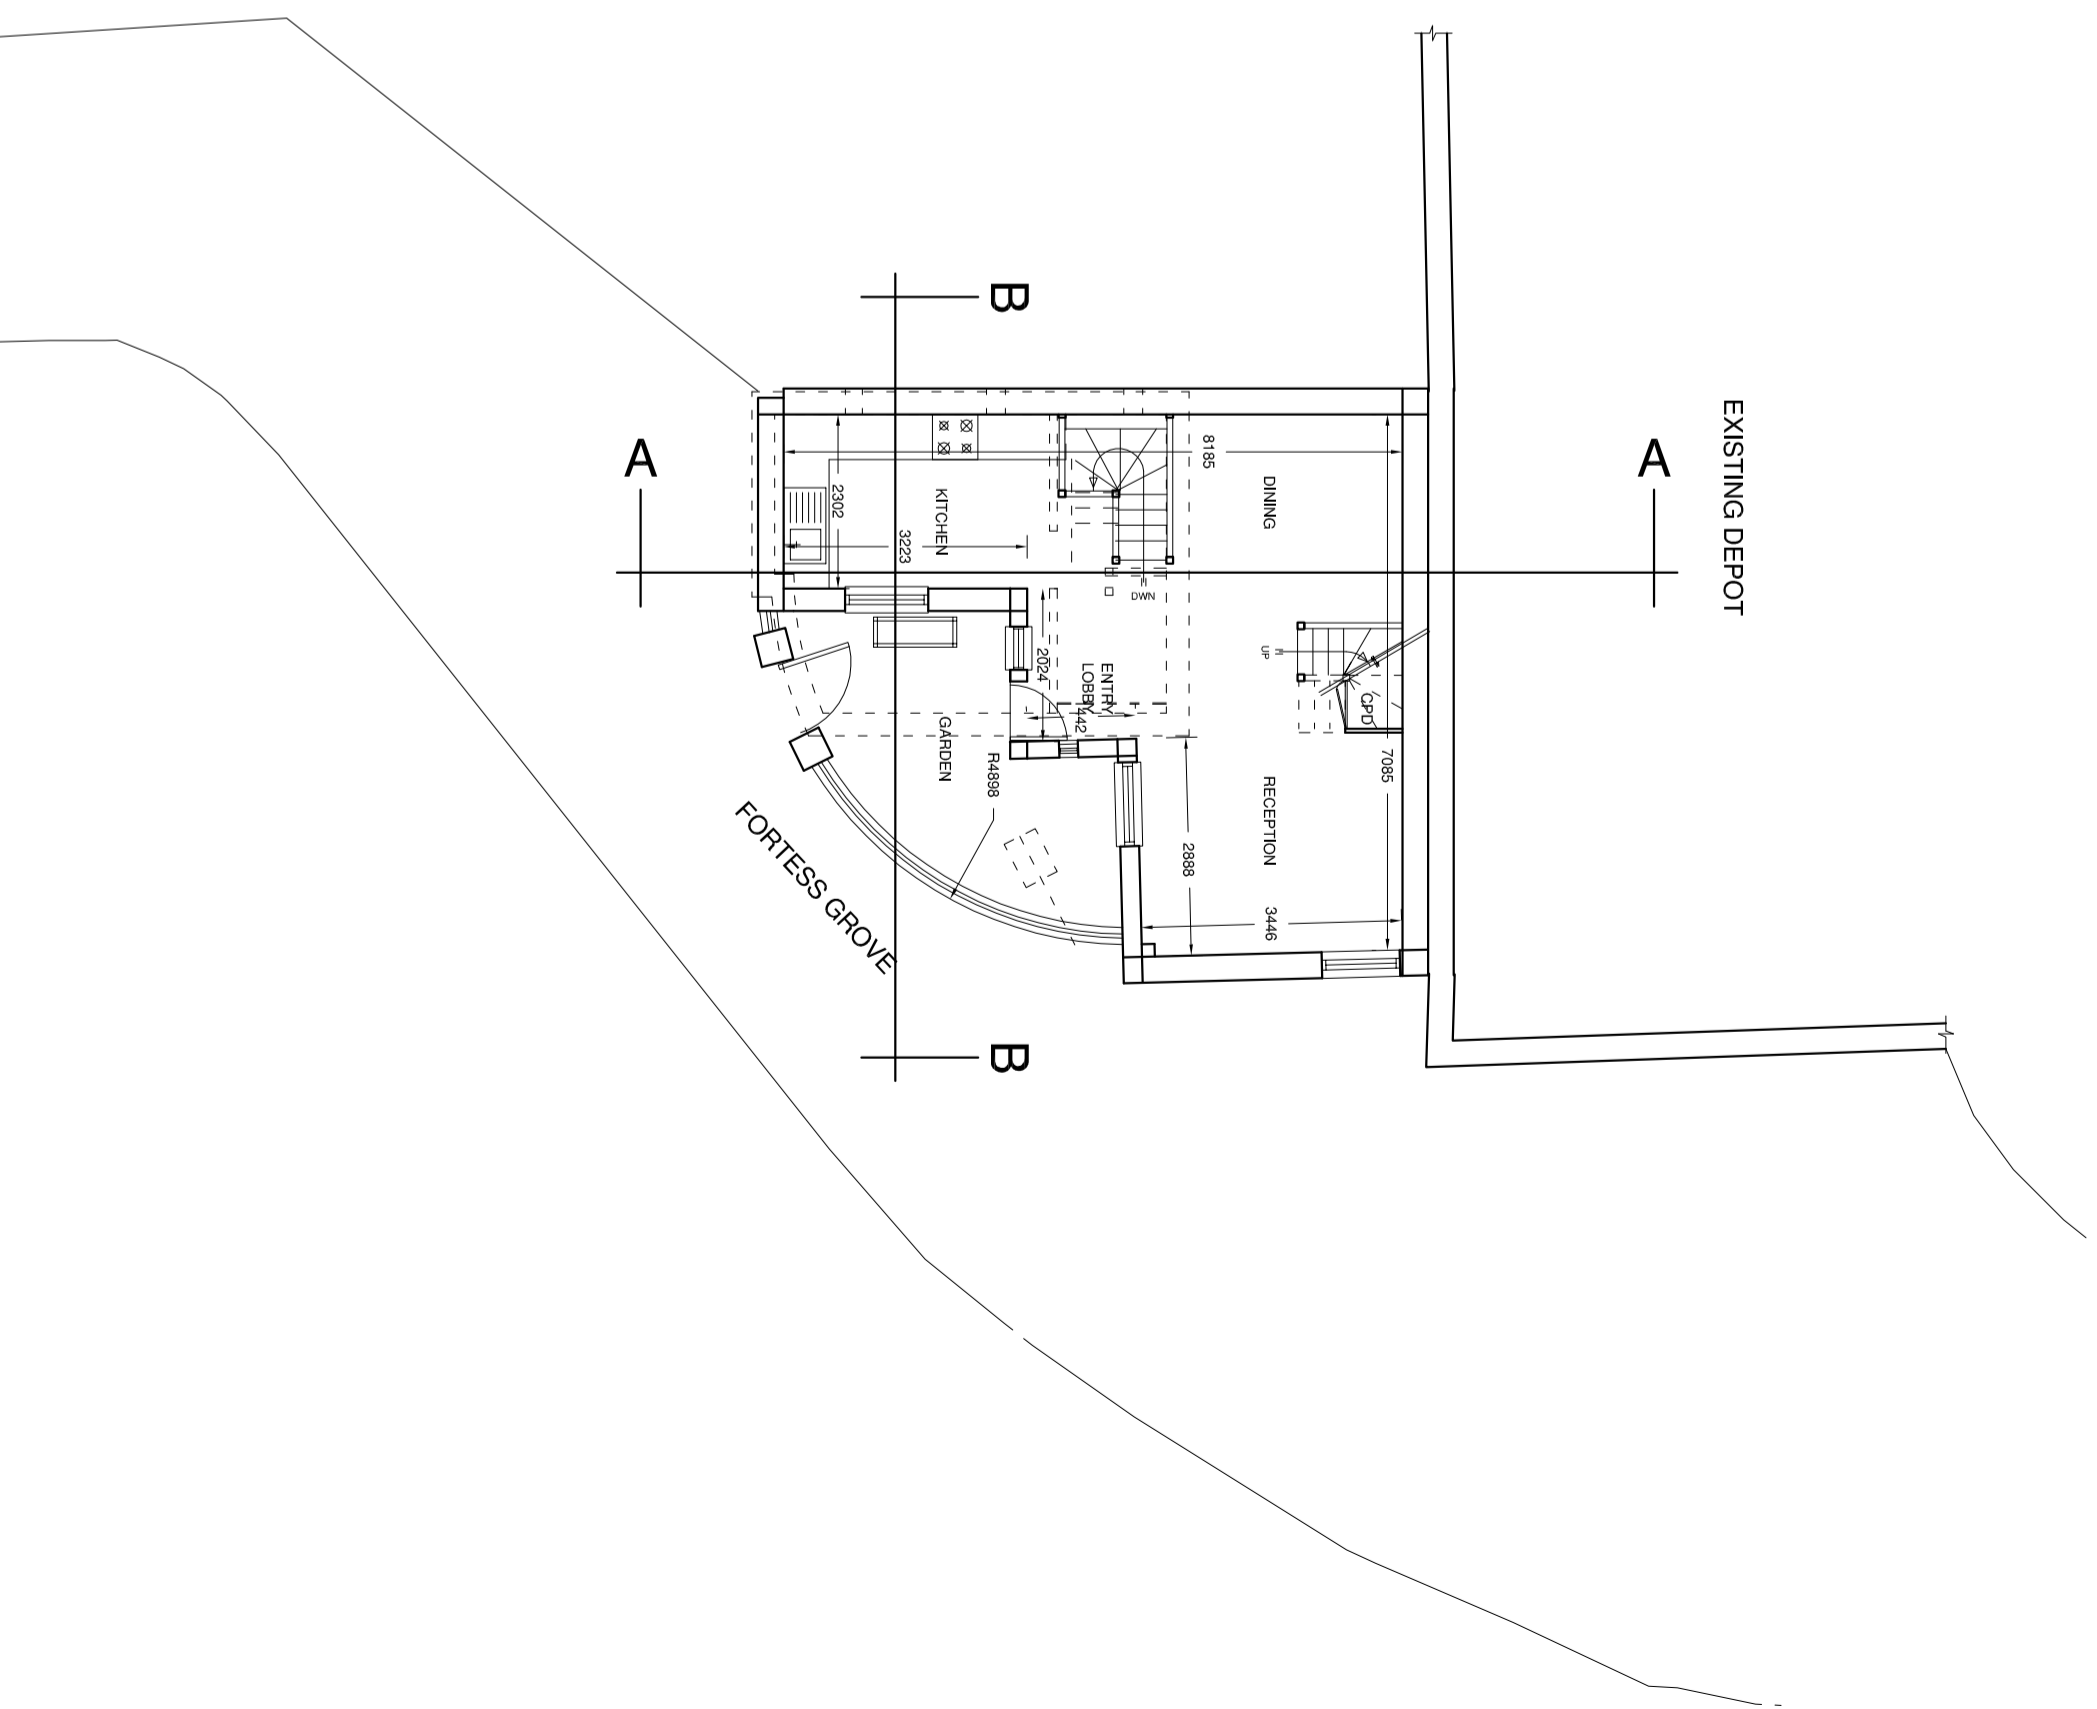

AS BUILT GROUND FLOOR PLAN

Revision
a (00/00/2018)

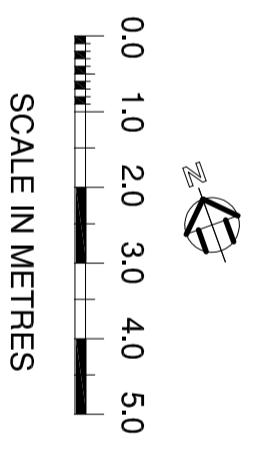

N. Abdelsaid
101 Oakington Ave.
London HA9 8HY
Tel / Fax: 020 8904 4786
Mob: 07958 659982
E-mail: nastrmgib@yahoo.co.uk

Mr Remzi Hassani
20 Fortess Grove
London NW5 2HD
Original and As Built Ground Floor Plans

March 2018
Scale: 1 : 100 @ A2
Dwg : 528.P1.04a