




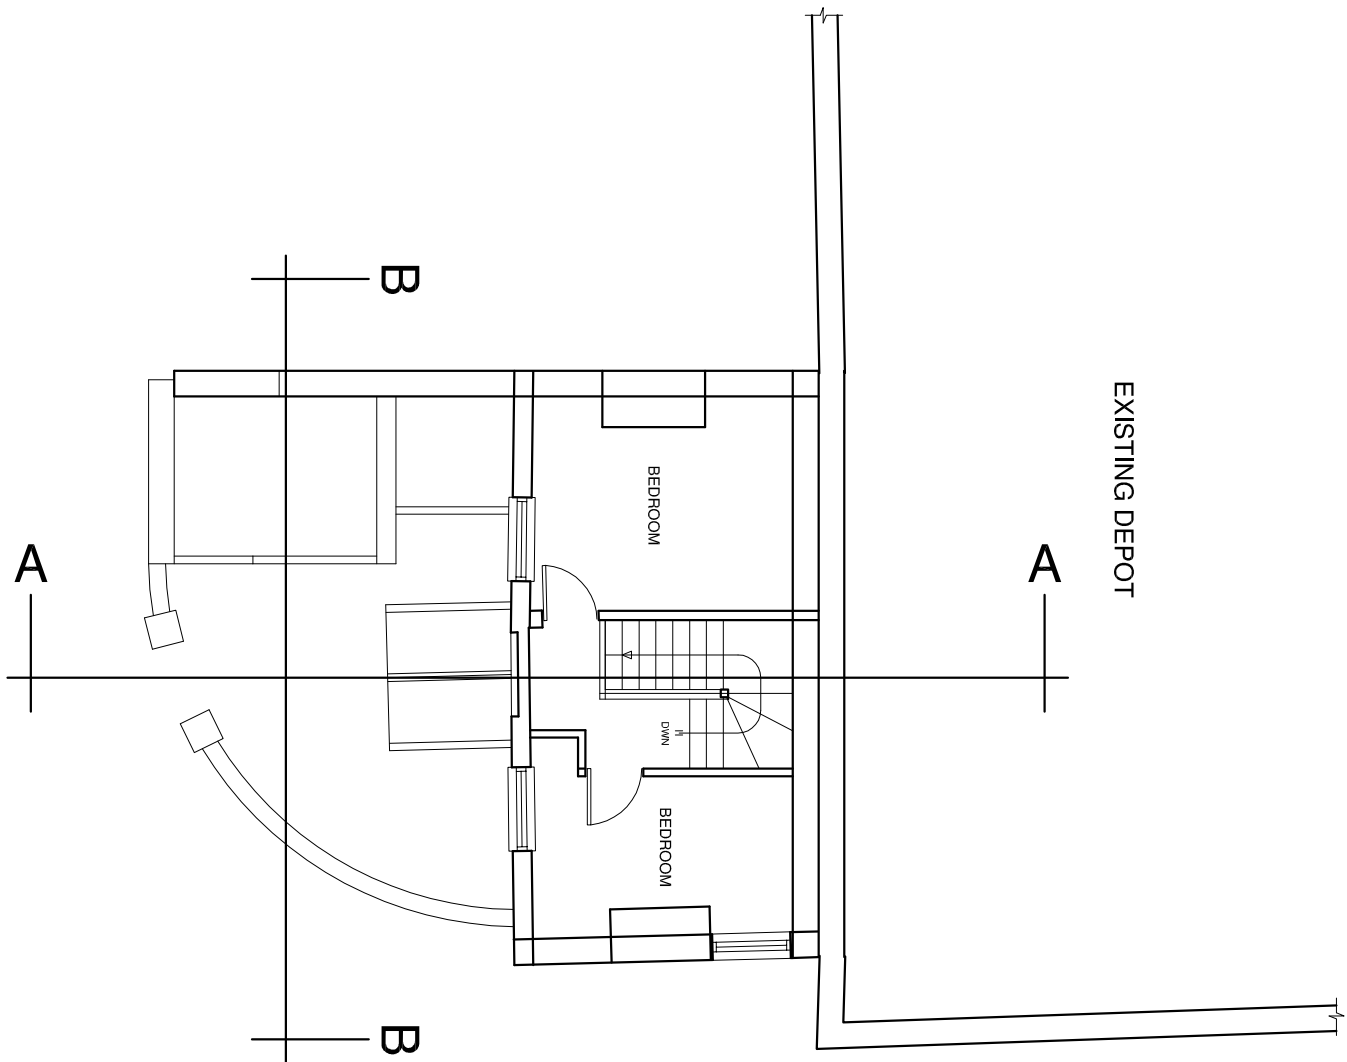

ORIGINAL FIRST FLOOR PLAN

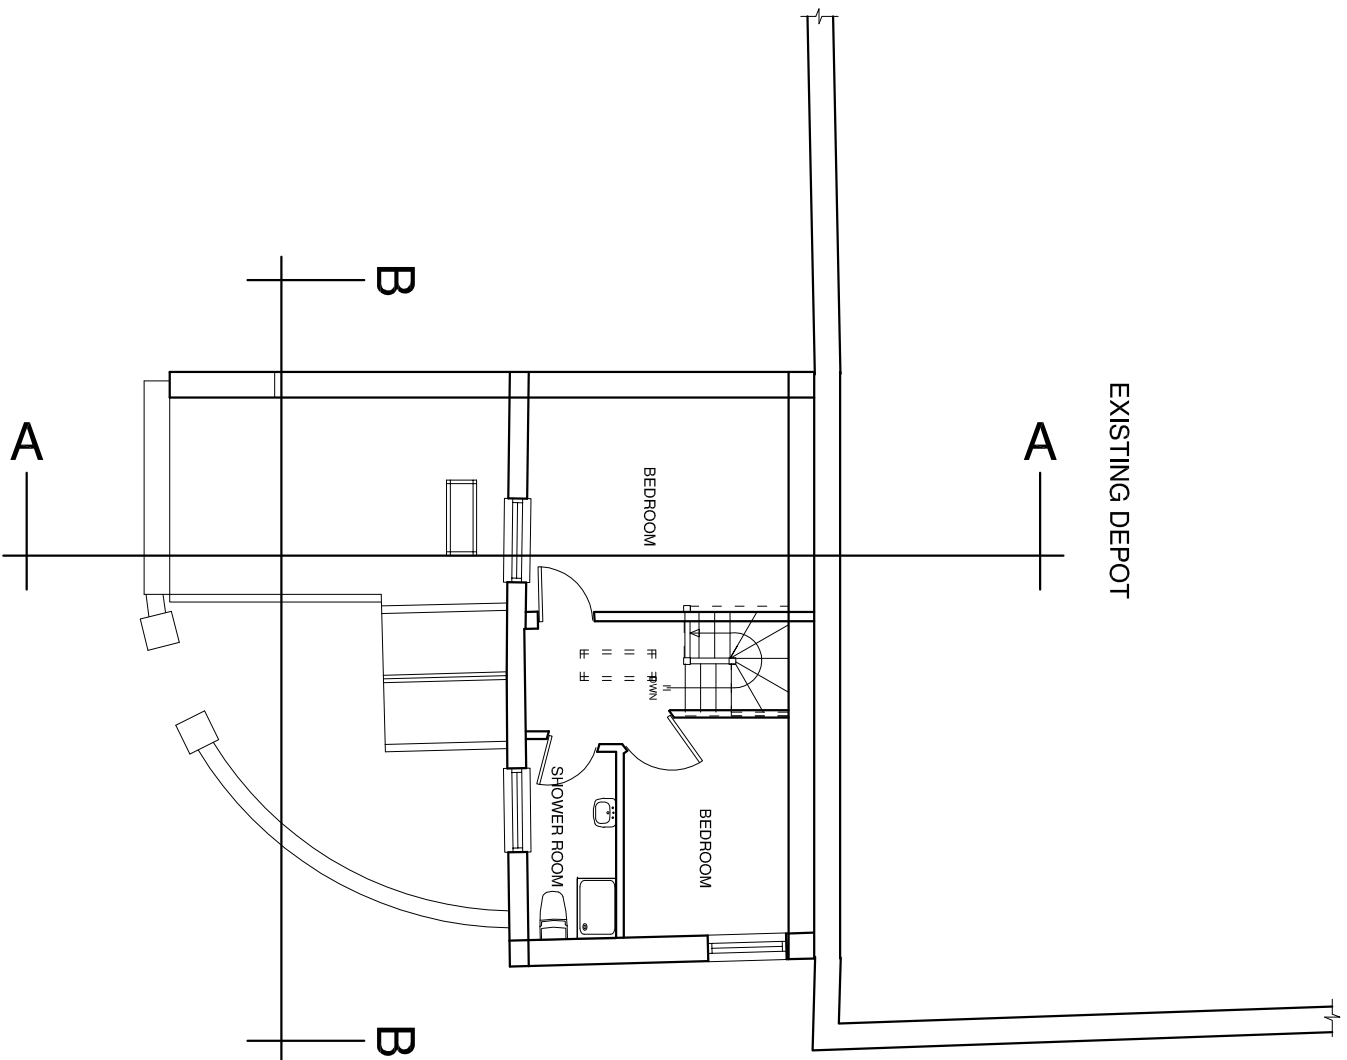


AS BUILT FIRST FLOOR PLAN

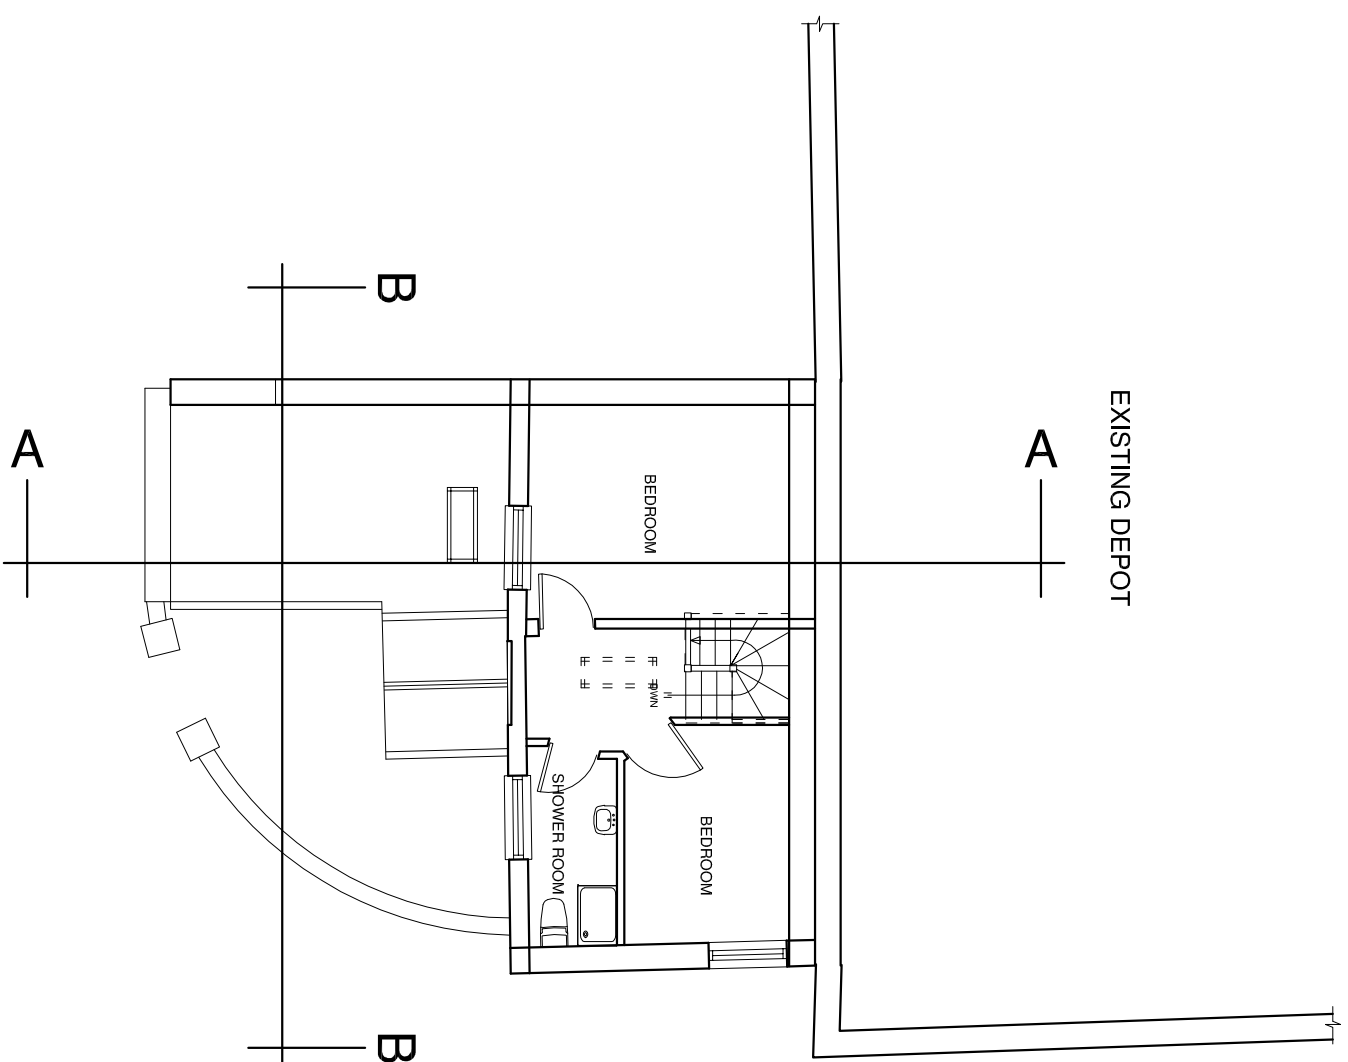

PROPOSED FIRST FLOOR PLAN

Revision
a (00 / 00 / 2018).

Notes

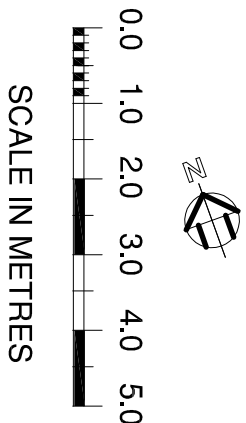

SCALE IN METRES

N. Abdelsaid
101 Oakington Ave.
London HA9 8HY
Tel / Fax: 020 8904 4786
Mob: 07958 659982
E-mail: nastnagib@yahoo.co.uk

Mr Remzi Hassani
20 Fortess Grove
London NW5 2HD
Original, As Built & Proposed First Floor Plans

March 2018
Scale: 1 : 100 @ A2
Dwg : 528.PLT.055