

DRAWING NOTES:
 All dimensions to be checked on site prior to commencement of any works, and/or preparation of any shop drawings.
 Sizes of and dimensions to any structural elements are indicative only. See structural engineers drawings for actual sizes/dimensions.
 Sizes of and dimensions to any service elements are indicative only. See service engineers drawings for actual sizes and dimensions.
 This drawing to be read in conjunction with all other Architect's drawings, specifications and other Consultants' information.
 All proprietary systems shown on this drawing are to be installed strictly in accordance with the Manufacturers/Suppliers recommended details.
 Any discrepancies between information shown on this drawing and any other contract information or manufacturers/suppliers recommendations is to be brought to the attention of the Architect.
 DO NOT SCALE FROM THIS DRAWING.


DRAWING NOTES:

AB1	AS BUILT ISSUE	20.11.17
STATUS	REVISION	DATE


DRAWING As Built Roof Plan	
SCALE 1:400 @ A1 (1:200 @ A3)	DRAWING FILE REF 893_A-x-P-xx-Building
DATE NOV 2017	DRAWN BY MK
DWG No. 893_GA-RF	REVISION AB1
DRAWING STATUS AS BUILT	

Buckley Gray Yeoman Studio 4.04 The Tea Building 56 Shoreditch High Street London E1 6JJ T: 020 7033 9913 F: 020 7033 9914	
CLIENT	ESAS Holdings A.S
PROJECT	Summit House


NOTE:
 For facade remedial works scope refer to Tee Technical & John Broomfield reports.
 For facade cleaning refer to BGY EW Series.

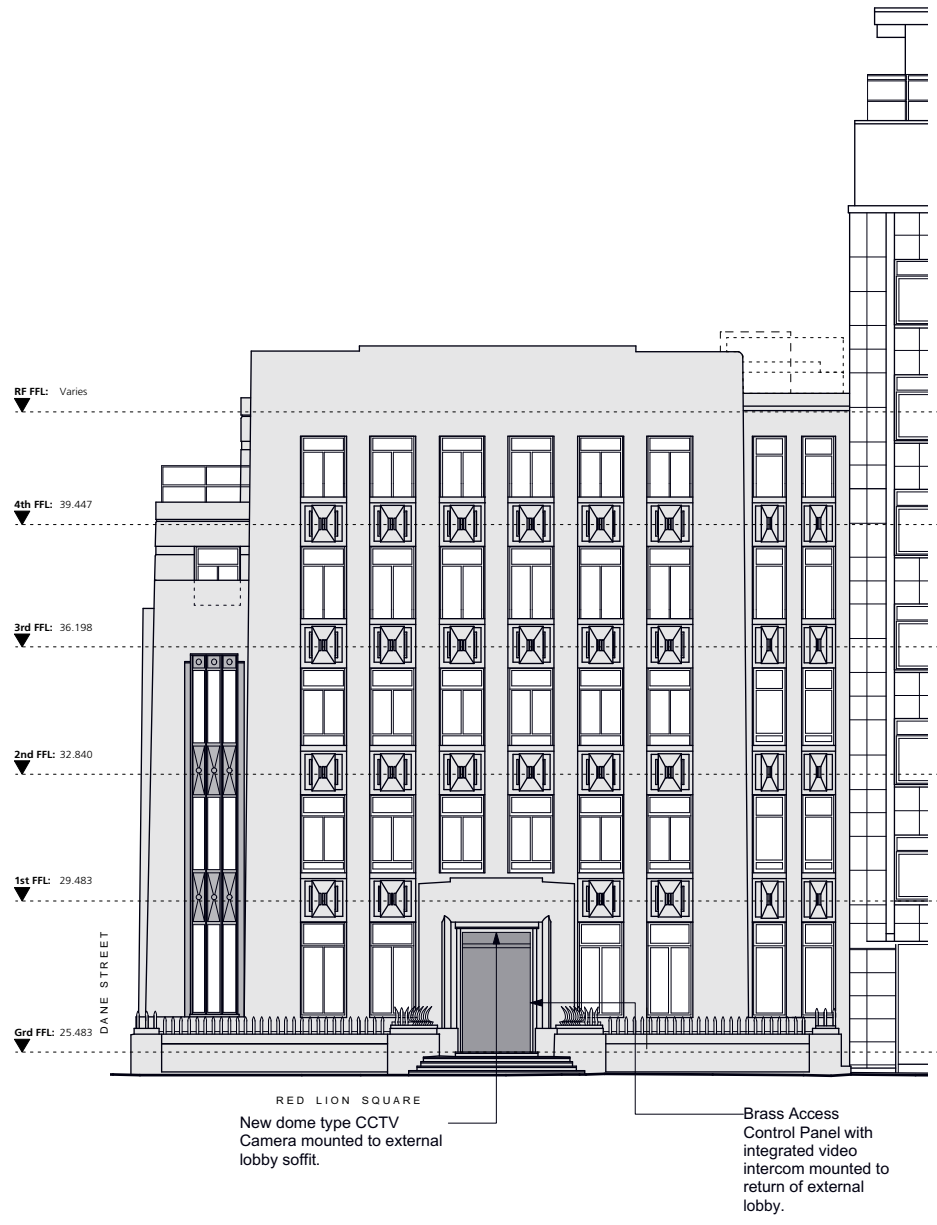

1 Proposed North Elevation (Red Lion Square)
 Scale 1:200@A3

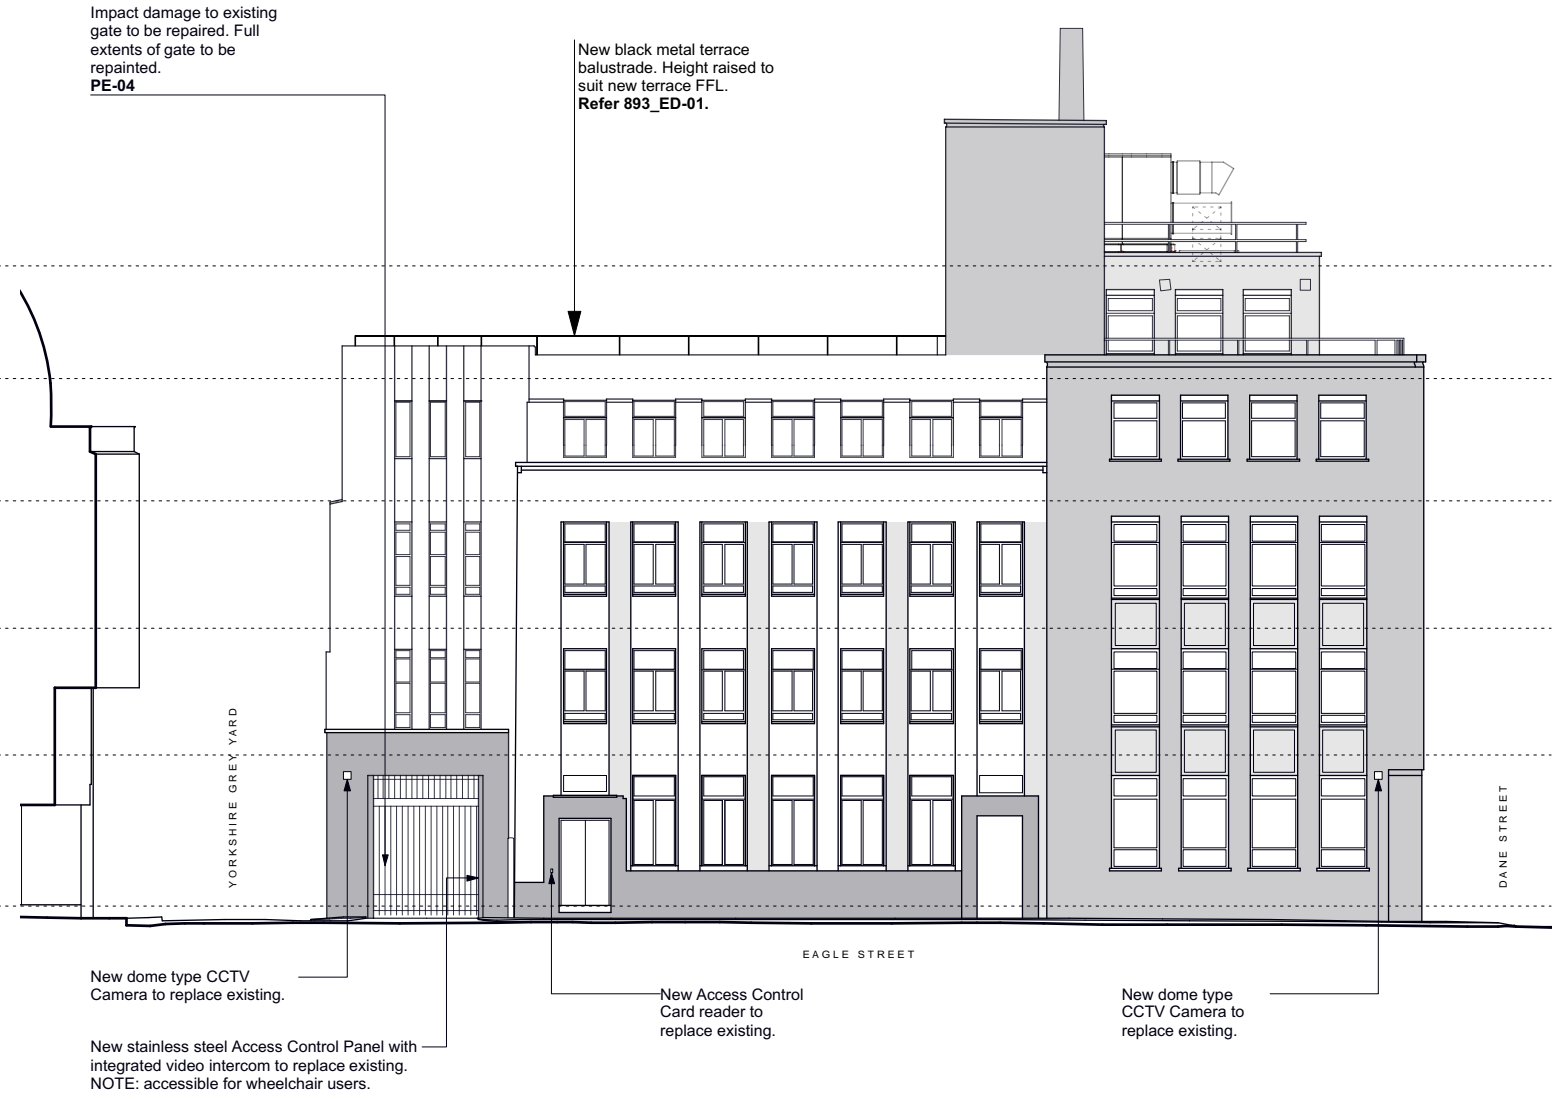

2 Proposed South Elevation (Eagle Street)
 Scale 1:200@A3

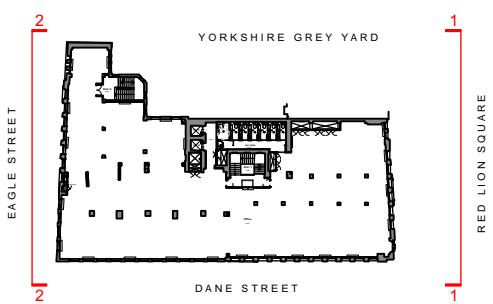

3 Key Plan
 Scale 1:1000@A3




DRAWING NOTES:
 All dimensions to be checked on site prior to commencement of any works, and/or preparation of any shop drawings.
 Sizes of and dimensions to any structural elements are indicative only. See structural engineers drawings for actual sizes and dimensions.
 Sizes of and dimensions to any service elements are indicative only. See service engineers drawings for actual sizes and dimensions.
 This drawing to be read in conjunction with all other Architect's drawings, specifications and other Consultants' information.
 All proprietary systems shown on this drawing are to be installed strictly in accordance with the Manufacturers/Suppliers recommended details.
 Any discrepancies between information shown on this drawing and any other contract information or manufacturers/suppliers recommendations is to be brought to the attention of the Architect.
 DO NOT SCALE FROM THIS DRAWING.


DRAWING NOTES:
 FFLs established by Ridgeway Surveys Ltd

AB2 Updated to include ductwork AB1 AS BUILT ISSUED STATUS REVISION	21.03.18 20.11.17 DATE	DRAWING As Built North and South Elevations SCALE 1:100 @ A1 (1:200 @ A3) DATE NOV 2017 DWG No. 893_GE-01 DRAWING STATUS AS BUILT	DRAWING FILE REF 893_A-x-P-xx-Building DRAWN BY MK REVISION AB2 PROJECT Summit House
		Buckley Gray Yeoman Studio 4.04 The Tea Building 56 Shoreditch High Street London E1 6JJ T: 020 7033 9913 F: 020 7033 9914	
		CLIENT ESAS Holdings A.S	
		INFORMATION CONTAINED ON THIS DRAWING IS THE SOLE COPYRIGHT OF Buckley Gray Yeoman and is not to be reproduced without their permission.	

NOTE:
 For facade remedial works scope refer to Tee Technical & John Broomfield reports.
 For facade cleaning refer to BGY EW Series.

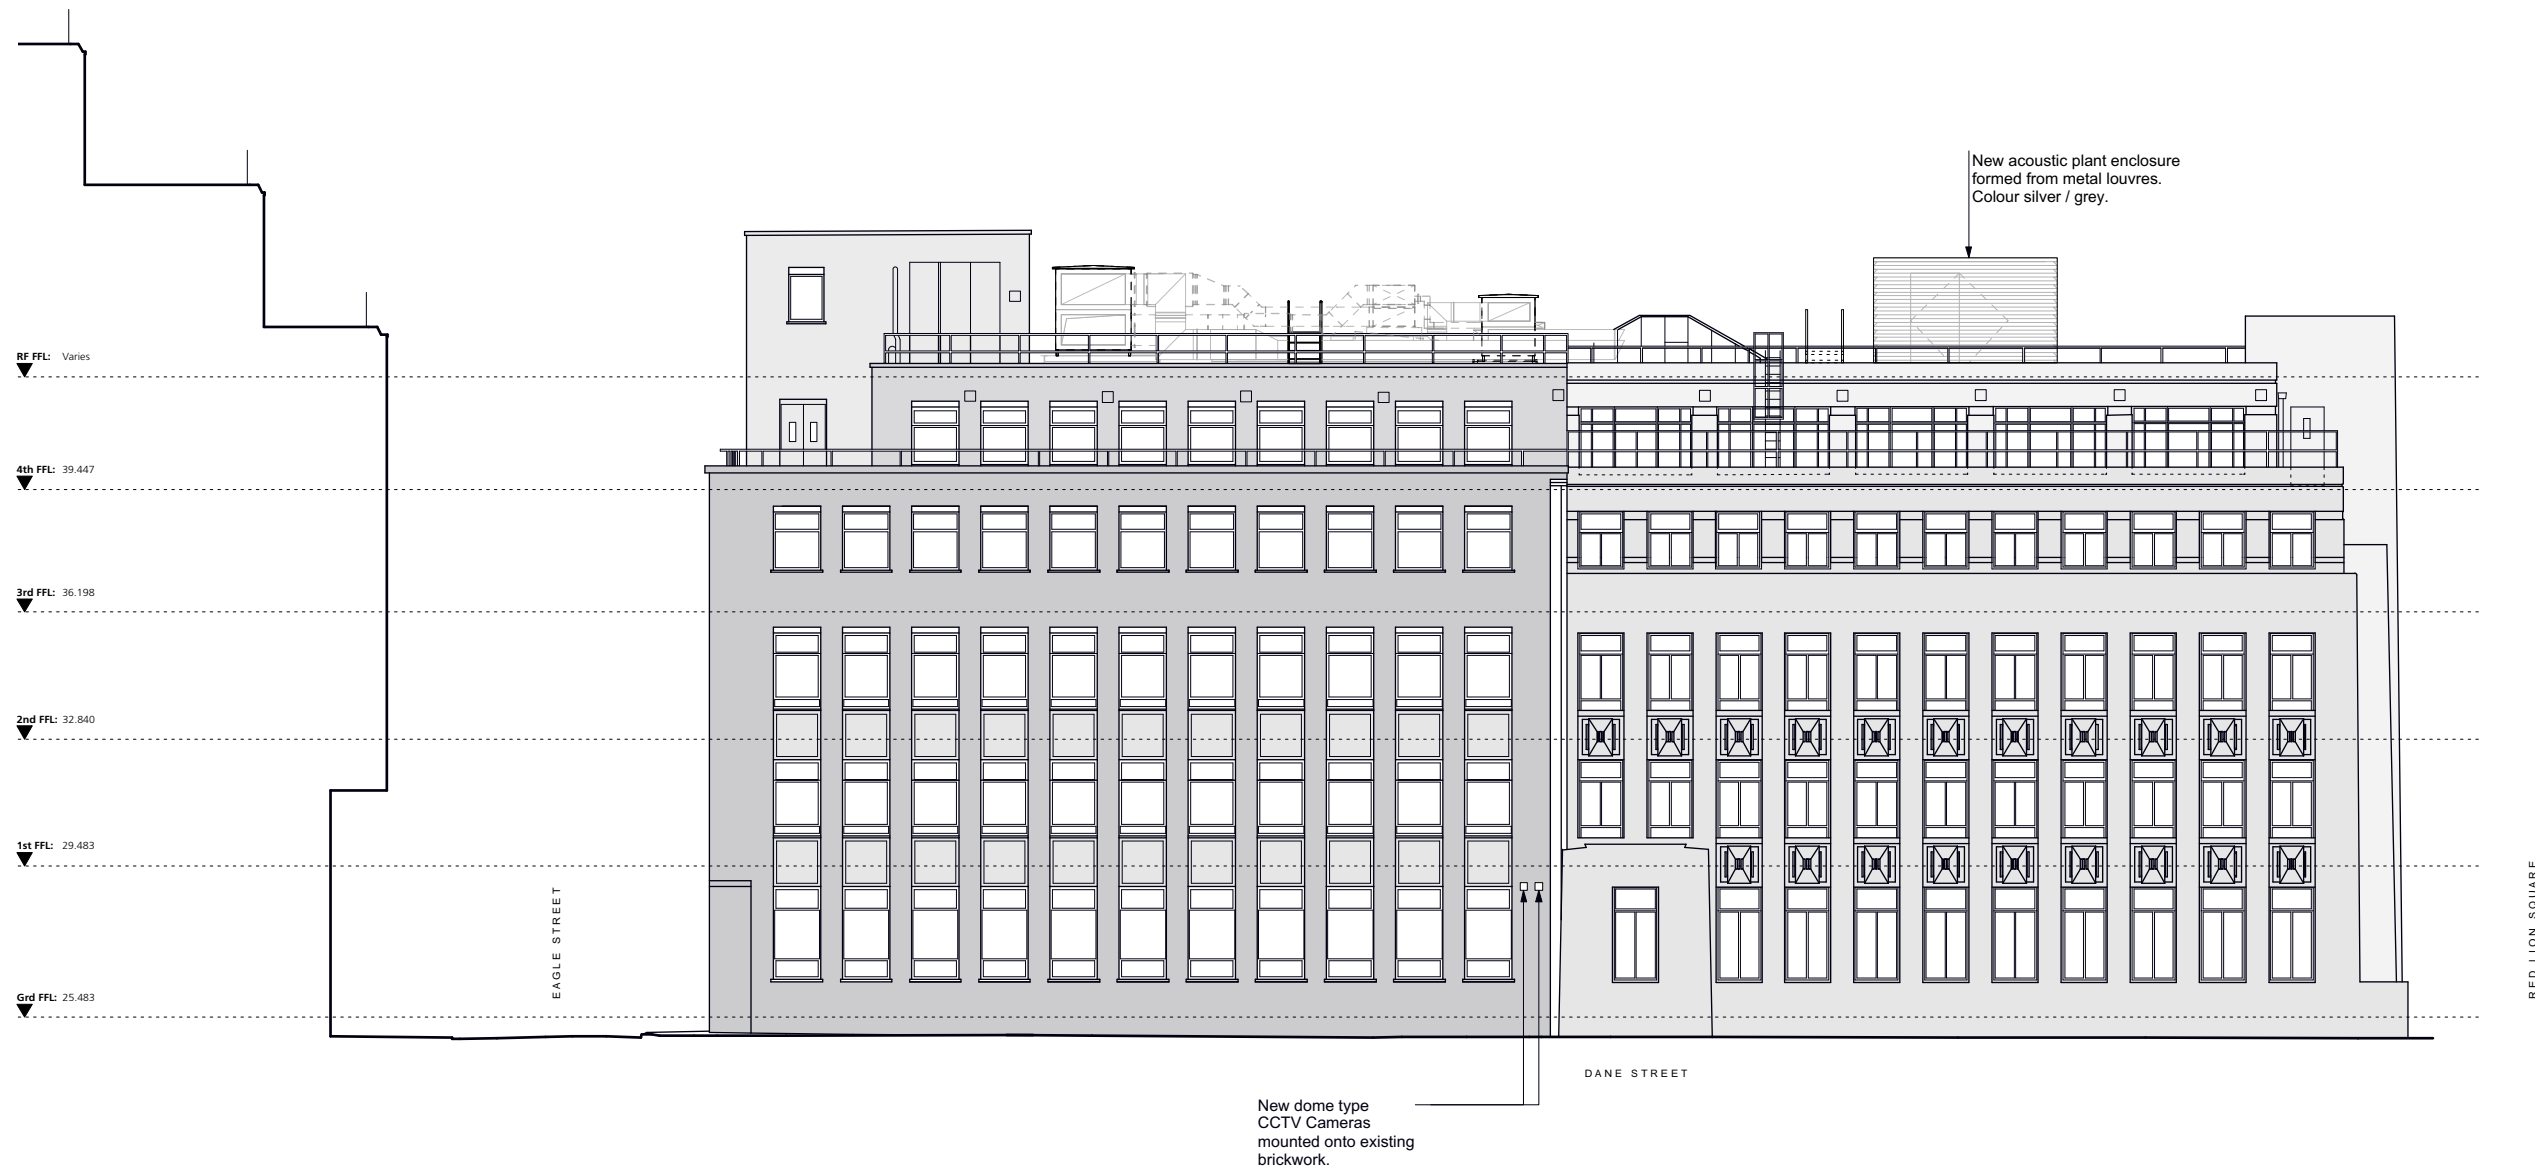

1 Proposed East Elevation (Dane Street)
 Scale 1:200@A3

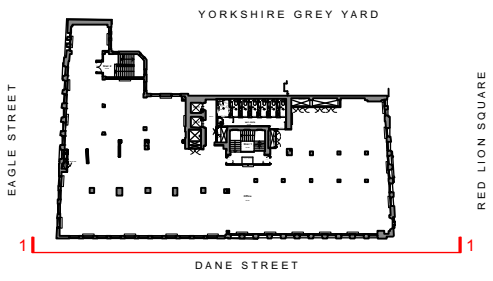

2 Key Plan
 Scale 1:1000@A3



DRAWING NOTES:
 All dimensions to be checked on site prior to commencement of any works, and/or preparation of any shop drawings.
 Sizes of and dimensions to any structural elements are indicative only. See structural engineers drawings for actual sizes and dimensions.
 Sizes of and dimensions to any service elements are indicative only. See service engineers drawings for actual sizes and dimensions.
 This drawing to be read in conjunction with all other Architect's drawings, specifications and other Consultants' information.
 All proprietary systems shown on this drawing are to be installed strictly in accordance with the Manufacturers/Suppliers recommended details.
 Any discrepancies between information shown on this drawing and any other contract information or manufacturers/suppliers recommendations is to be brought to the attention of the Architect.
 DO NOT SCALE FROM THIS DRAWING.

DRAWING NOTES:
 FFLs established by Ridgeway Surveys Ltd


AB2	Updated to include ductwork	21.03.18
AB1	AS BUILT ISSUED	20.11.17
STATUS	REVISION	DATE

DRAWING	
As Built East Elevation	
SCALE	1:100 @ A1 (1:200@ A3)
DATE	NOV 2017
DWG No.	893_GE-02
DRAWING STATUS	AS BUILT

Buckley Gray Yeoman	
Studio 4.04 The Tea Building 56 Shoreditch High Street London E1 6JJ T: 020 7033 9913 F: 020 7033 9914	
CLIENT	ESAS Holdings A.S
PROJECT	Summit House


Information contained on this drawing is the sole copyright of Buckley Gray Yeoman and is not to be reproduced without their permission.

NOTE:
 For facade remedial works scope refer to **Tee Technical & John Broomfield reports**.
 For facade cleaning refer to BGY **EW Series**.

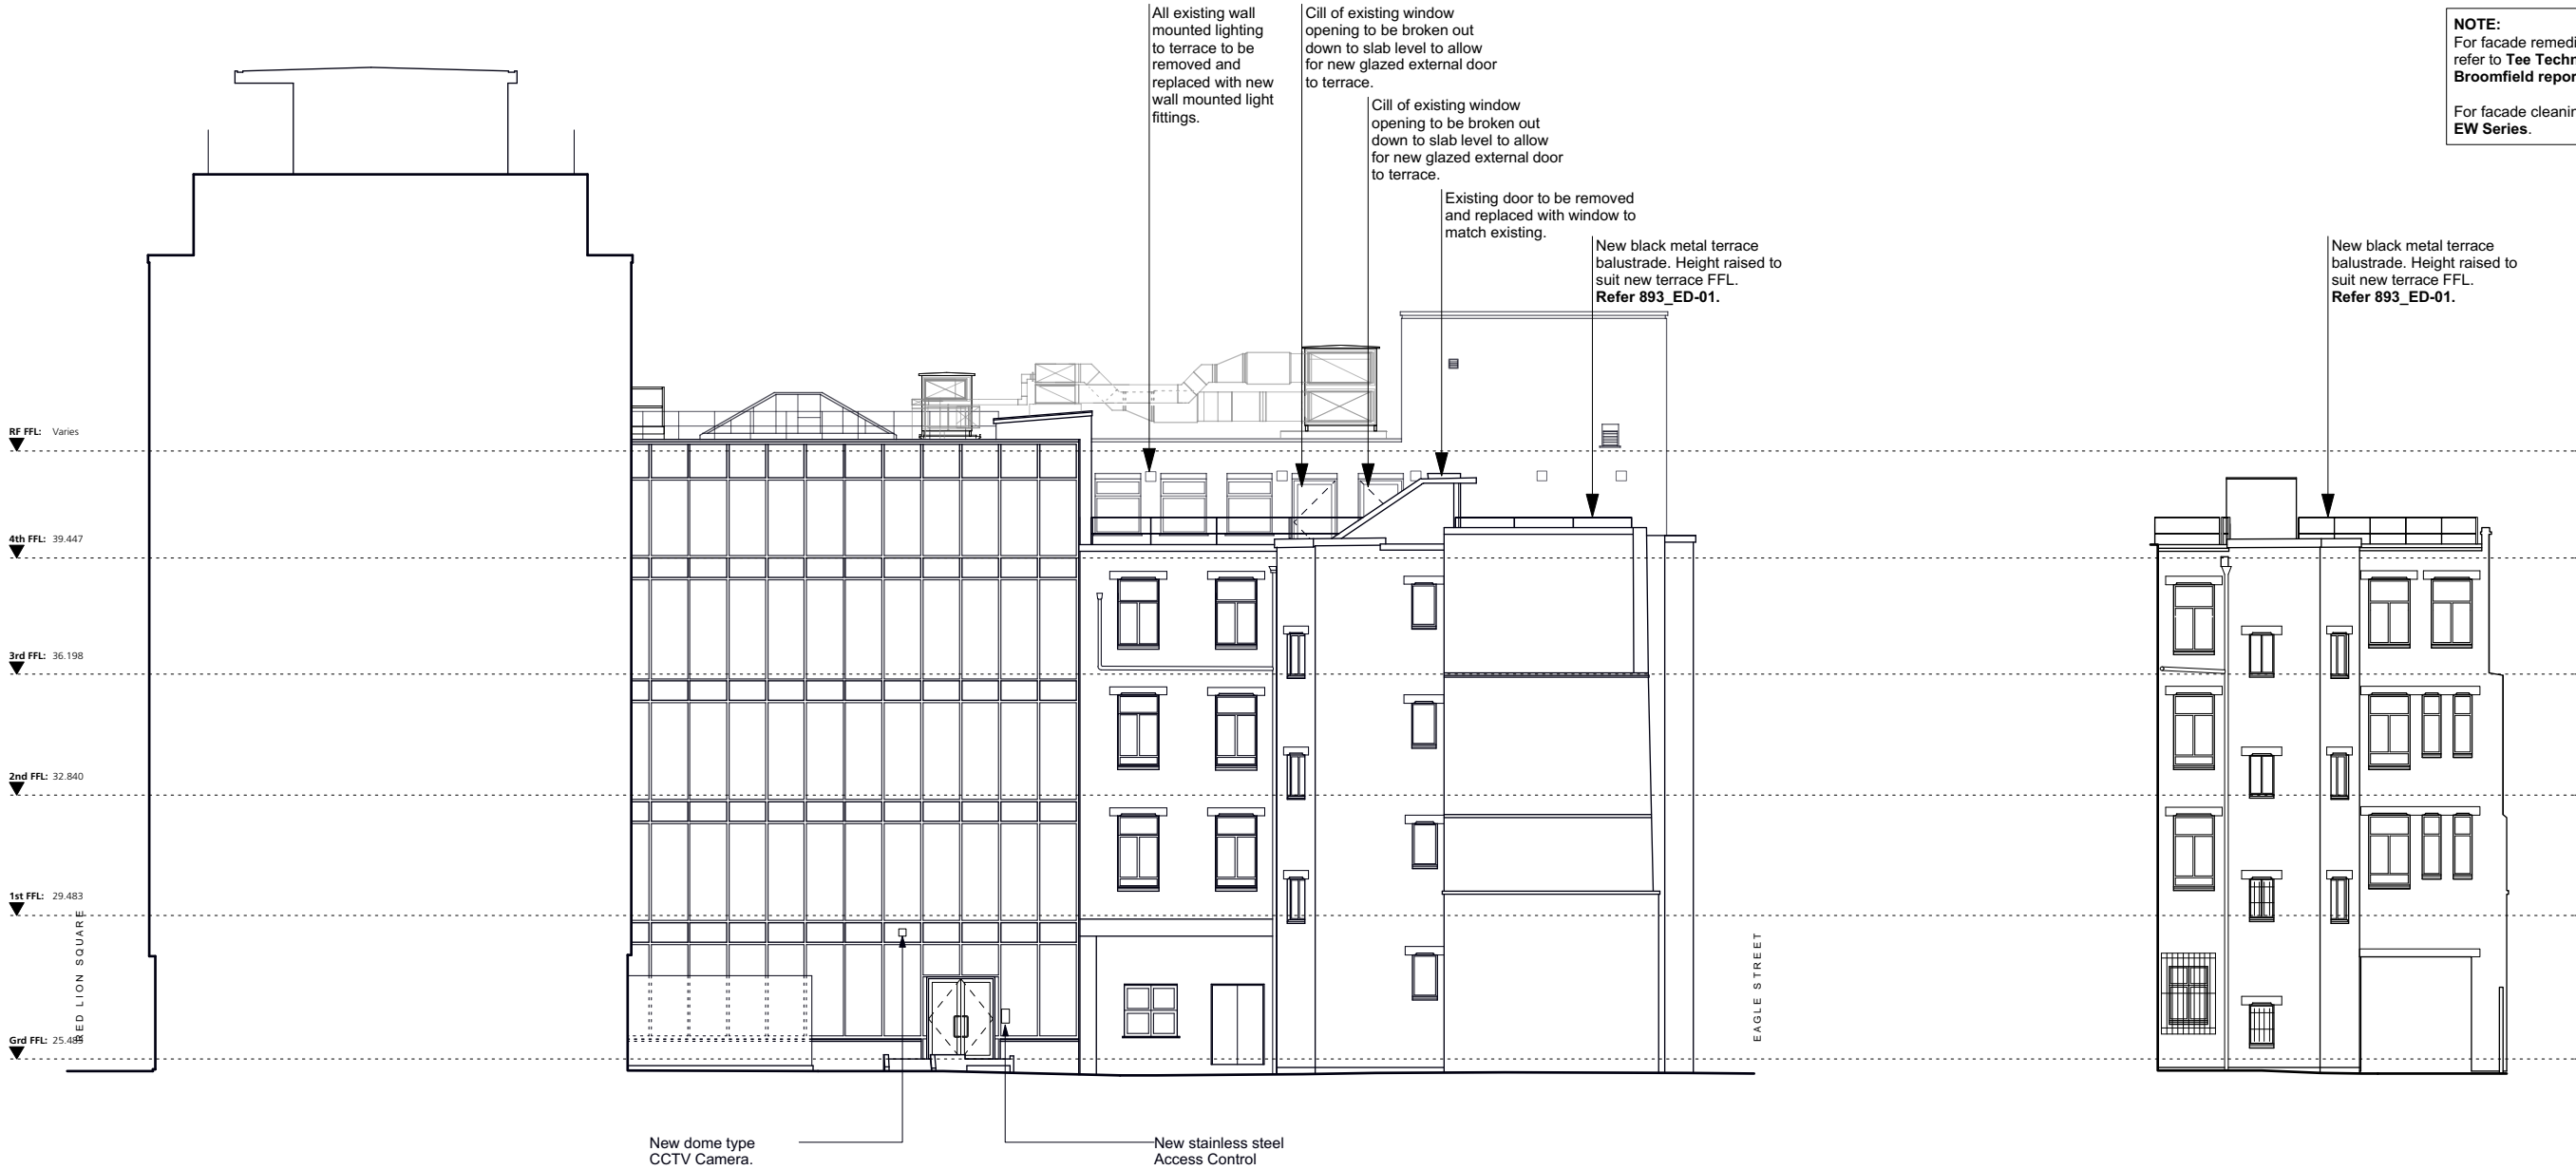

1 Proposed West Elevation (to Lightwell)
 Scale 1:200@A3

2 Proposed North Elevation (to Yard)
 Scale 1:200@A3

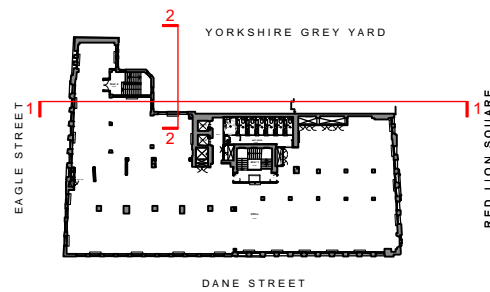

3 Key Plan
 Scale 1:1000@A3



DRAWING NOTES:
 All dimensions to be checked on site prior to commencement of any works, and/or preparation of any shop drawings.
 Sizes of and dimensions to any structural elements are indicative only. See structural engineers drawings for actual sizes and dimensions.
 Sizes of and dimensions to any service elements are indicative only. See service engineers drawings for actual sizes and dimensions.
 This drawing to be read in conjunction with all other Architect's drawings, specifications and other Consultants' information.
 All proprietary systems shown on this drawing are to be installed strictly in accordance with the Manufacturers/Suppliers recommended details.
 Any discrepancies between information shown on this drawing and any other contract information or manufacturers/suppliers recommendations is to be brought to the attention of the Architect.
 DO NOT SCALE FROM THIS DRAWING.

DRAWING NOTES:
 FFLs established by Ridgeway Surveys Ltd

AB2 Updated to include ductwork AB1 AS BUILT ISSUED	21.03.18 20.11.17	DRAWING		Buckley Gray Yeoman Studio 4.04 The Tea Building 56 Shoreditch High Street London E1 6JJ T: 020 7033 9913 F: 020 7033 9914		
		As Built West Elevation			DRAWING FILE REF 893_A-x-P-xx-Building	
		SCALE	1:100 @ A1 (1:200 @ A3)			
		DATE	NOV 2017		DRAWN BY	MK
		DWG No.	893_GE-03		REVISION	AB2
DRAWING STATUS		AS BUILT		CLIENT	ESAS Holdings A.S	
STATUS		REVISION	DATE	PROJECT	Summit House	