
revison	date	author	revision notes
Α	04.08.15	cme	Note amended
В	27.02.18	RR	Extent of demolition revised to reflect consented scheme



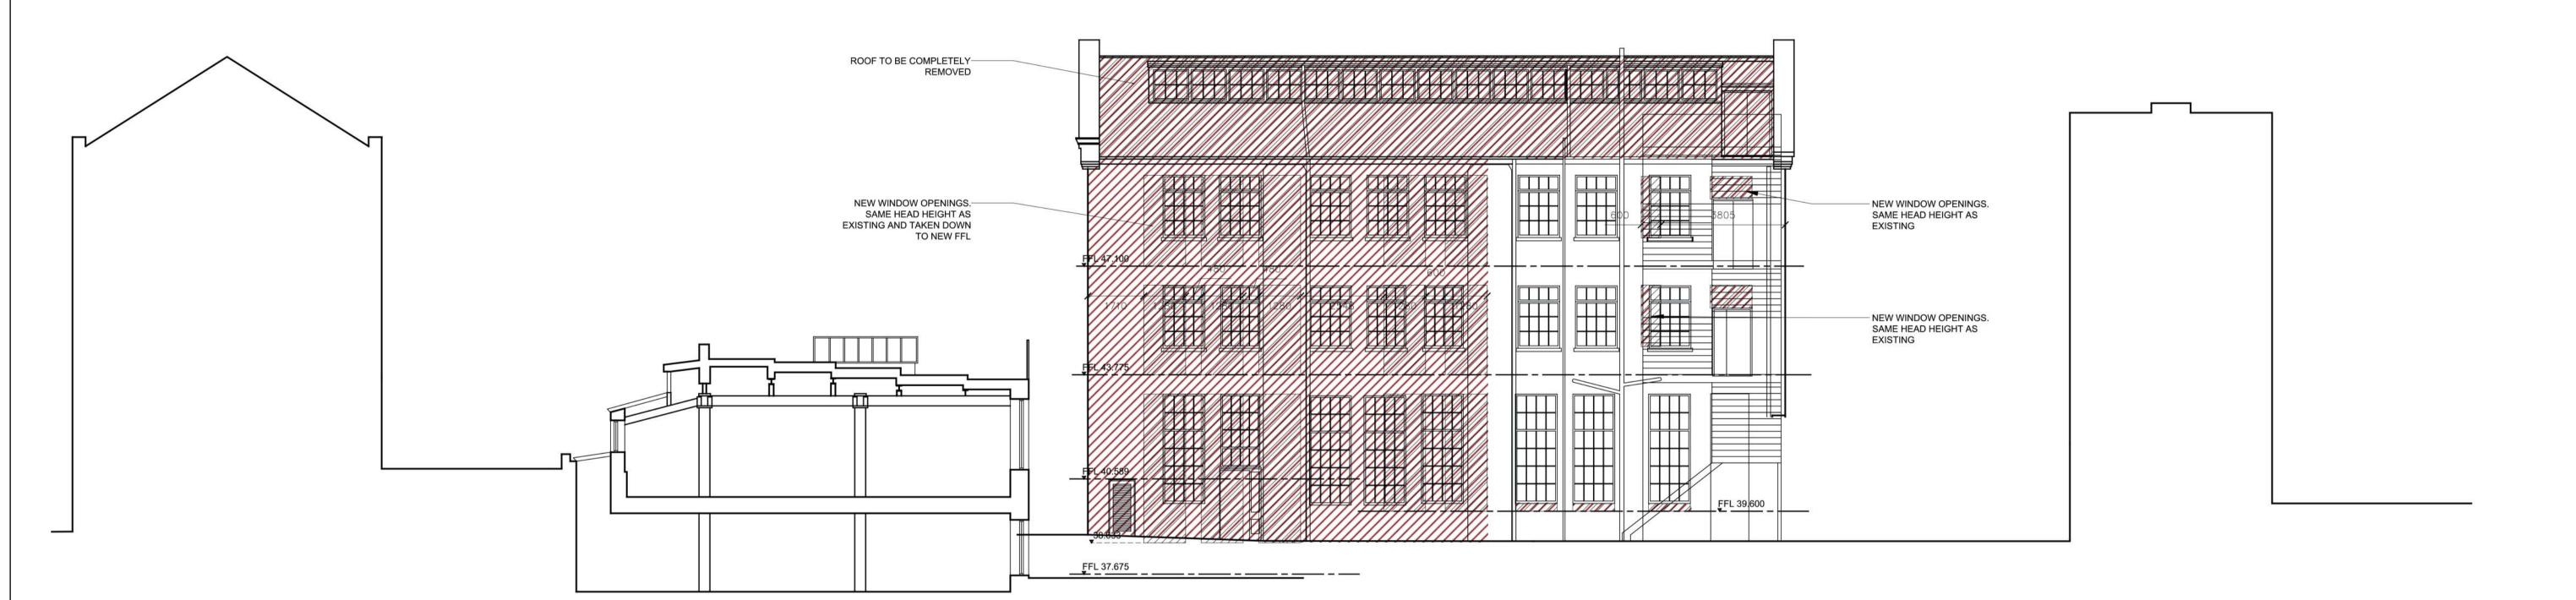

## DOONE SILVER KERR

THIS DRAWING HAS BEEN DERIVED FROM PKS ARCHITECTS LLP CAD DATA AND UPDATED SURVEY INFORMATION SUPPLIED BY RGL SURVEYS LTD.

## PLANNING

DO NOT SCALE FROM THIS DRAWING : Verify all dimensions on site

										0.000	6		
					K			4	5	title	Le		
	_ a	r	C	h	ı	t	0	c t	S.	scale	1:1		
	· •	•	•	•	•	•	•	•		date	07		

	De ner established in the Drawning an aminenesis of the								
<sup>ect</sup> 6 Erskine Road									
4	Leeder House Interior-Demolition Mark-up								
le	1:100 @ A1	<sup>author</sup> cme	dwg no.	rev.					
9	27.05.15	<sup>job no.</sup> 835	155-04	В					