



**Symbol & Abbreviation Key.**

	BARBED WIRE FENCE
	POST & RAIL FENCE
	CLOSE BOARD FENCE
	RAILINGS
	CHAIN LINK FENCE
	OTHER FENCE
	KERB
	DROPPED KERB
	GULLY CHANNEL
	TOP / BOTTOM OF BANK
	FOLIAGE
	DITCH
	VERGE
	OVERHEAD CABLES
	GATE
	HEDGE
	TREE - BROAD LEAVED
	TREE - CONIFEROUS
	BUSH
	BUILDING
	BOREHOLE
	SURVEY STATION
	ORDNANCE SURVEY BENCH MARK

A/C	AIR CONDITIONING UNIT	KO	KERB OFFLET
AV	AIR VALVE	LC	LIGHTING COLUMN
BOL	BOLLARD	LP	LAMP POST
BH	BOREHOLE	NP	NAME PLATE
BL	BED LEVEL	NB	NOTICE BOARD
BM	BENCH MARK	PR	PIPE RISER
BT	BRITISH TELECOM	RP	RODDING POINT
CTV	CABLE TV	RS	ROAD SIGN
CL	COVER LEVEL	SP	SIGN POST
CR	CABLE RISER	SV	STOP VALVE
DP	DOWN PIPE	TL	TRAFFIC LIGHT
ER	EARTH ROD	TP	TELEGRAPH POLE
EP	ELECTRICITY POLE	TOP	TOP OF FENCE
EM	ELECTRICITY MARKER	TOH	TOP OF HEDGE
FB	FUSE BOX	TOR	TOP OF RAILINGS
FH	FIRE HYDRANT	TOS	SERVICE LEVEL
FP	FENCE POST	TOW	TOP OF WALL
FL	FLOOR LEVEL	UTL	UNABLE TO LIFT
GV	GAS VALVE	VM	VALVE MARKER
GM	GAS MARKER	VP	VENT PIPE
GU	GULLY	WL	WATER LEVEL
HM	HYDRANT MARKER	WM	WATER MARKER
IL	INVERT LEVEL	WO	WASH OUT

**General.**  
 This survey has been prepared with a scaling accuracy for a plot at a scale of 1:200.  
 All tree heights and spreads are approximate. We have tried to identify tree types, however if tree species are critical specialist advice should be gained.  
 Drainage pipe sizes have been measured from the surface. Chamber access has not been gained for safety reasons, therefore sizes should be regarded as approximate.  
 Some detail may have been omitted due to parked vehicles.

**Notes.**  
 Coordinates related to OS National Grid from ST06 by GPS (No scale factor added). Levels related to GPS.

A	Roof plan added	RW	22/04/16
Rev	Details of Revision	Drawn	Date

Surveyed	Drawn	Date	Checked	Date	Approved	Date
ET	RW	19/04/16	GM	20/04/16	GM	20/04/16



Interlock Surveys Limited  
 St. Andrews House  
 Radford Semele  
 Leamington Spa  
 Warwickshire  
 CV31 1TF


T: 01926 330123  
 F: 01926 330120  
 E: info@interlocksurveys.co.uk

**Client.**  
 KYSON  
 STUDIO 28  
 SCRUTTON STREET  
 LONDON, EC2A 4RP


**Title.**  
**TOPOGRAPHICAL SURVEY**  
 THE ALLIANCE PUB  
 40-42 MILL LANE  
 NW6 1NR

Dwg No. **160175** Sheet **1 of 1**


Scale 1:100 A2 Sheet Rev. A

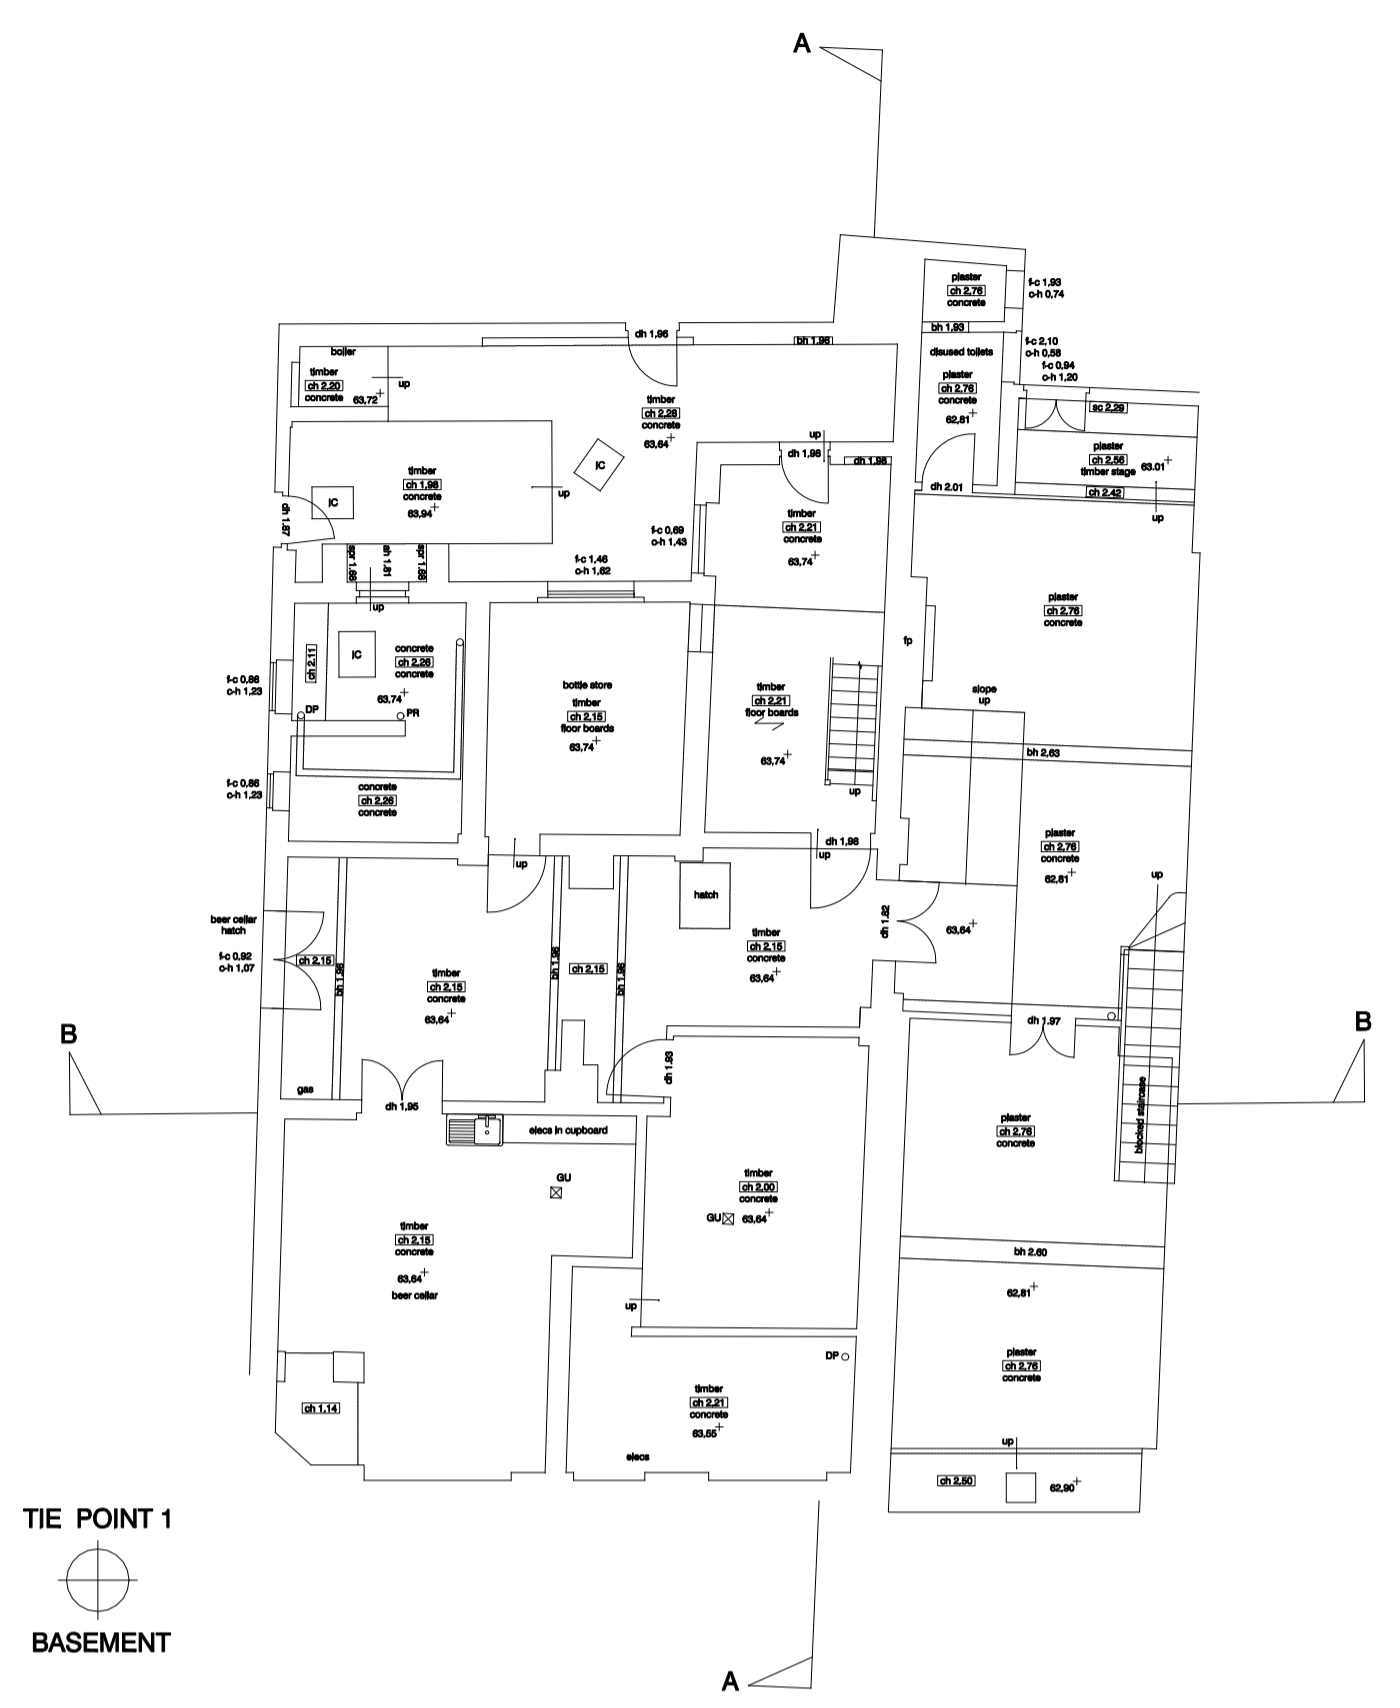


TIE POINT 1  
BASEMENT

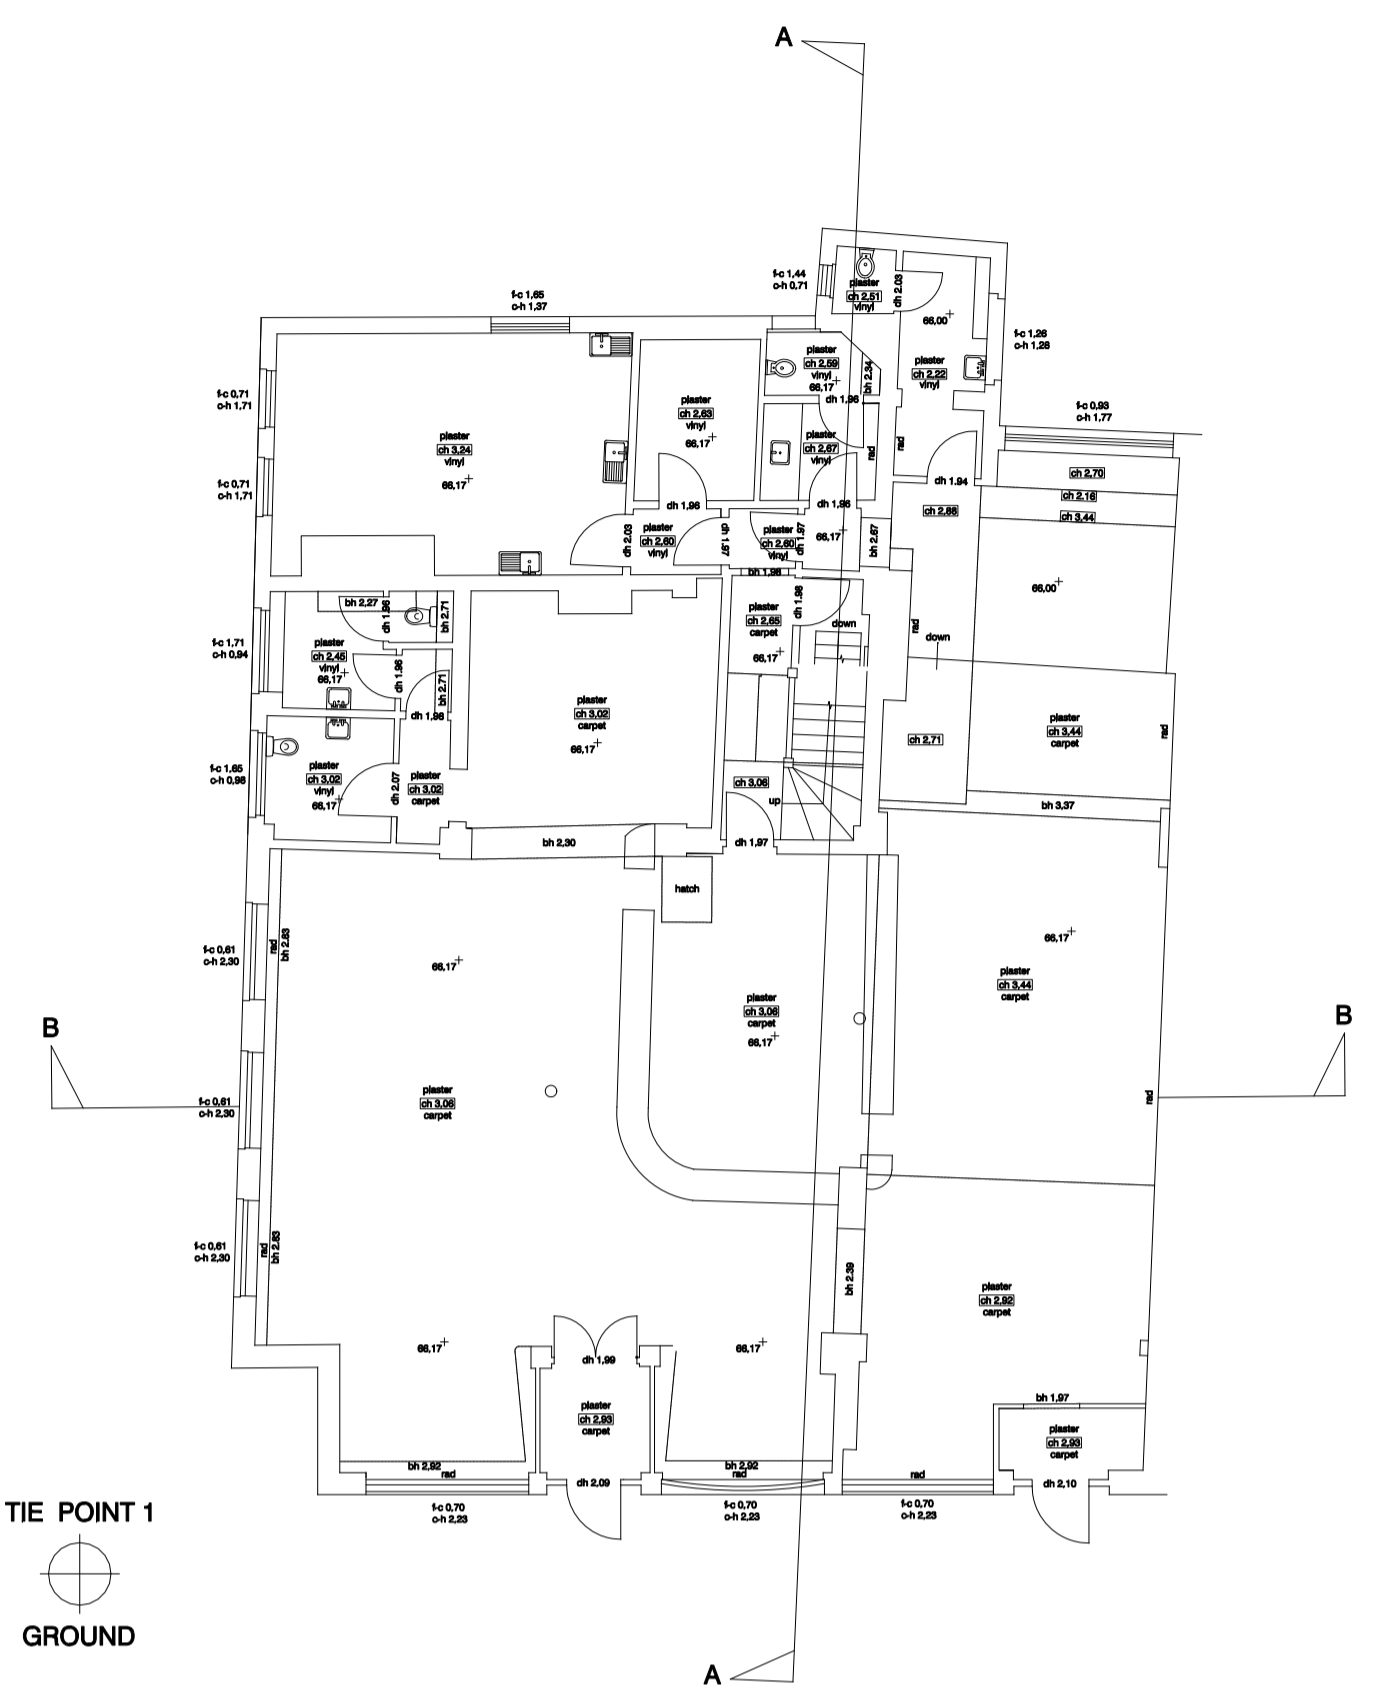


TIE POINT 1  
GROUND

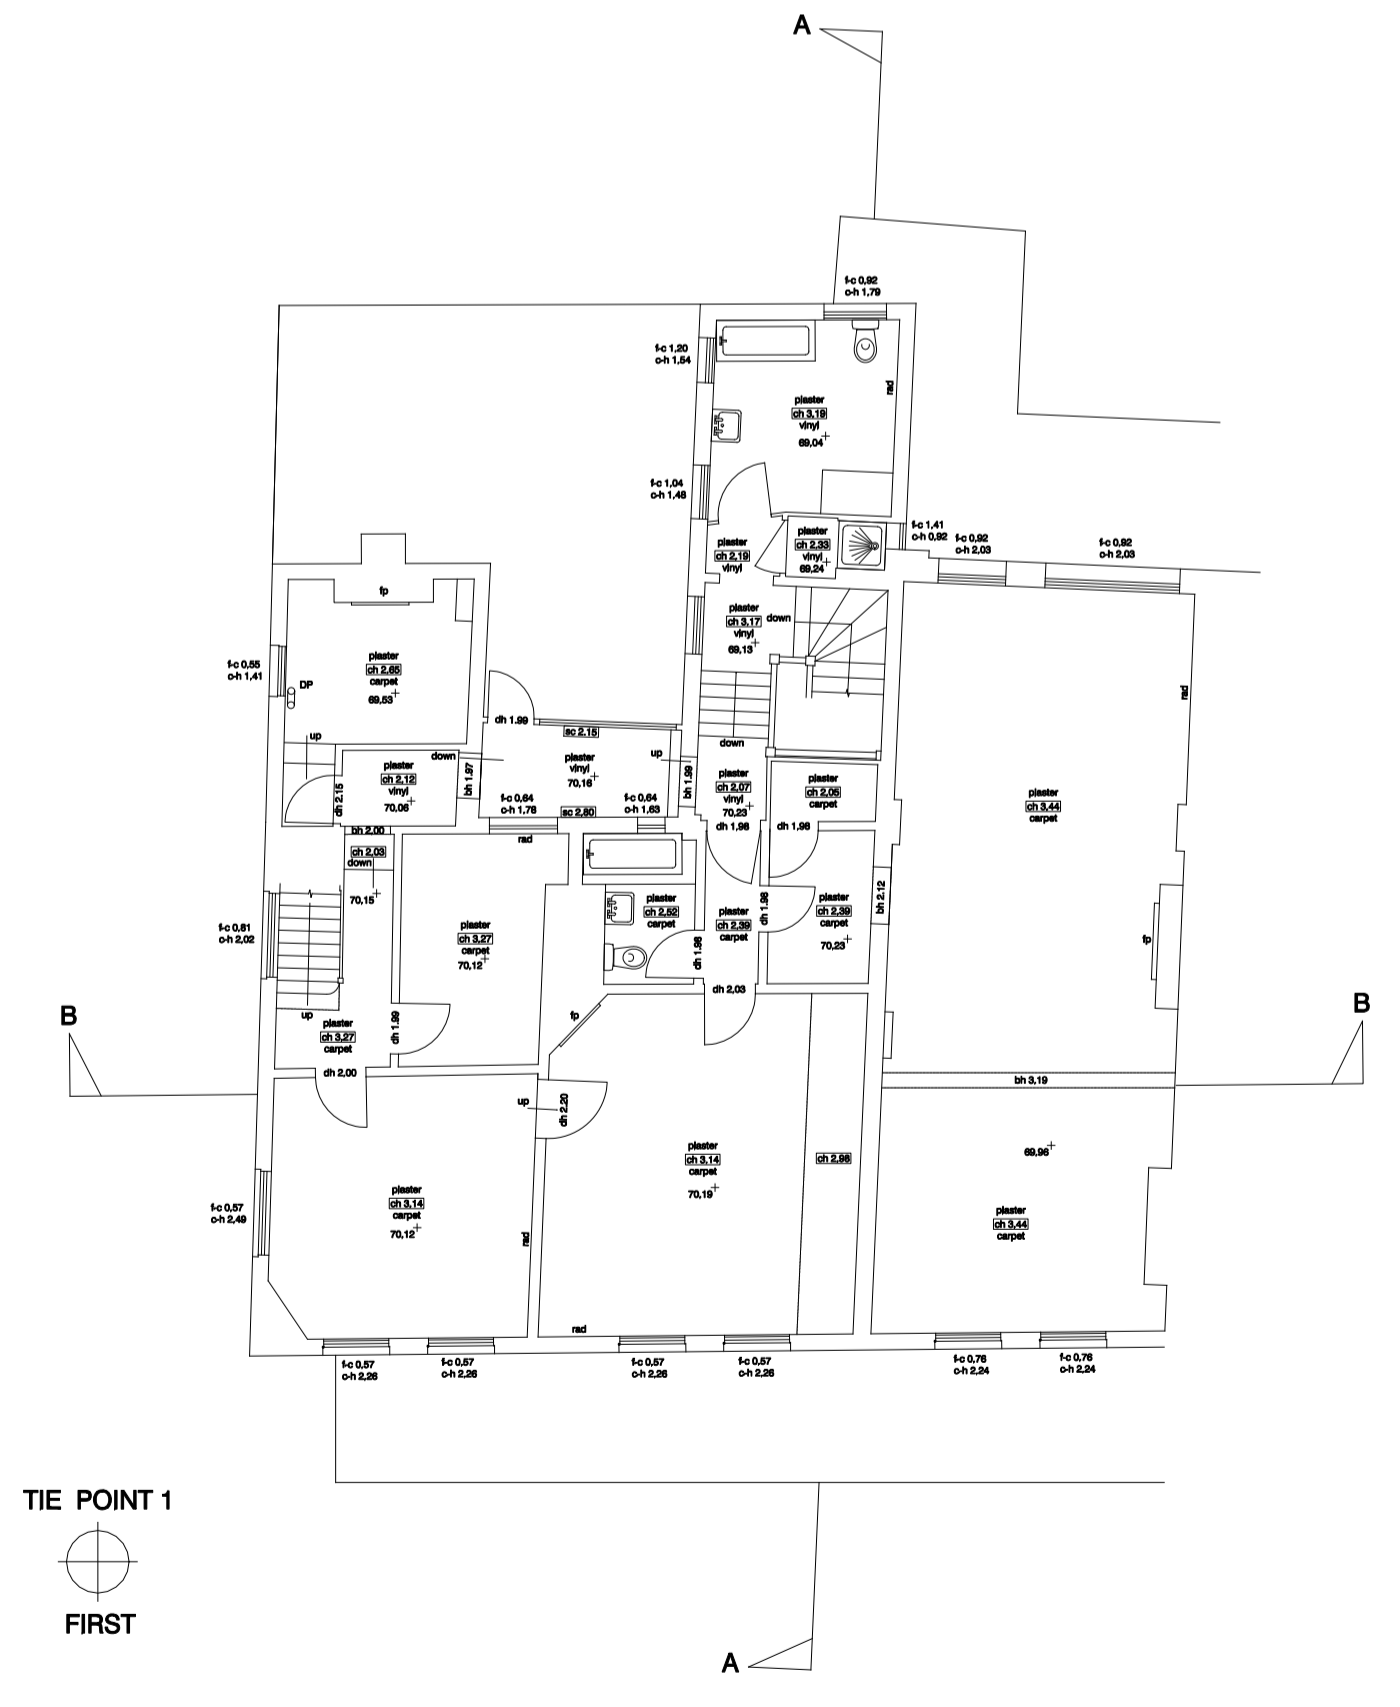

TIE POINT 1  
FIRST

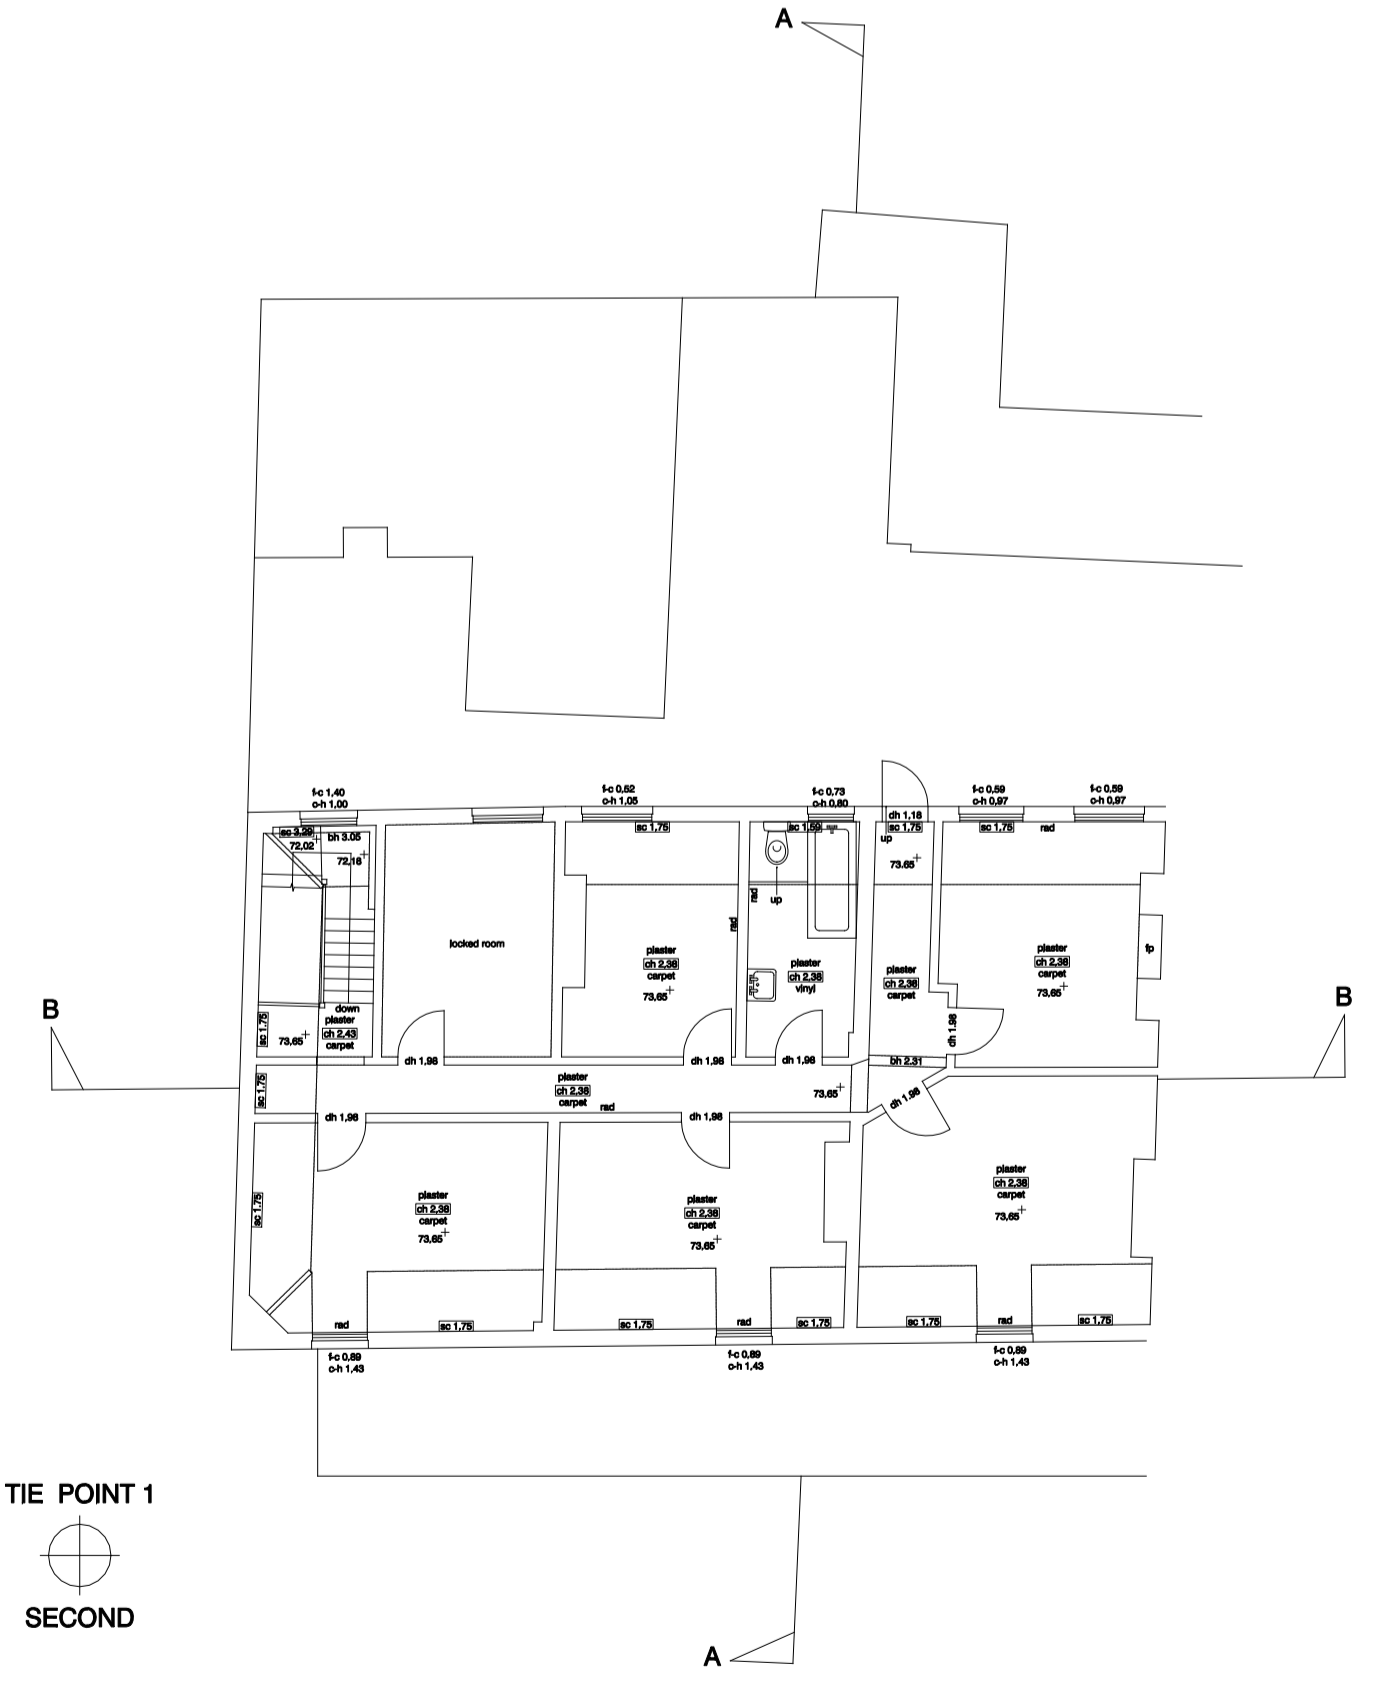

TIE POINT 1  
SECOND

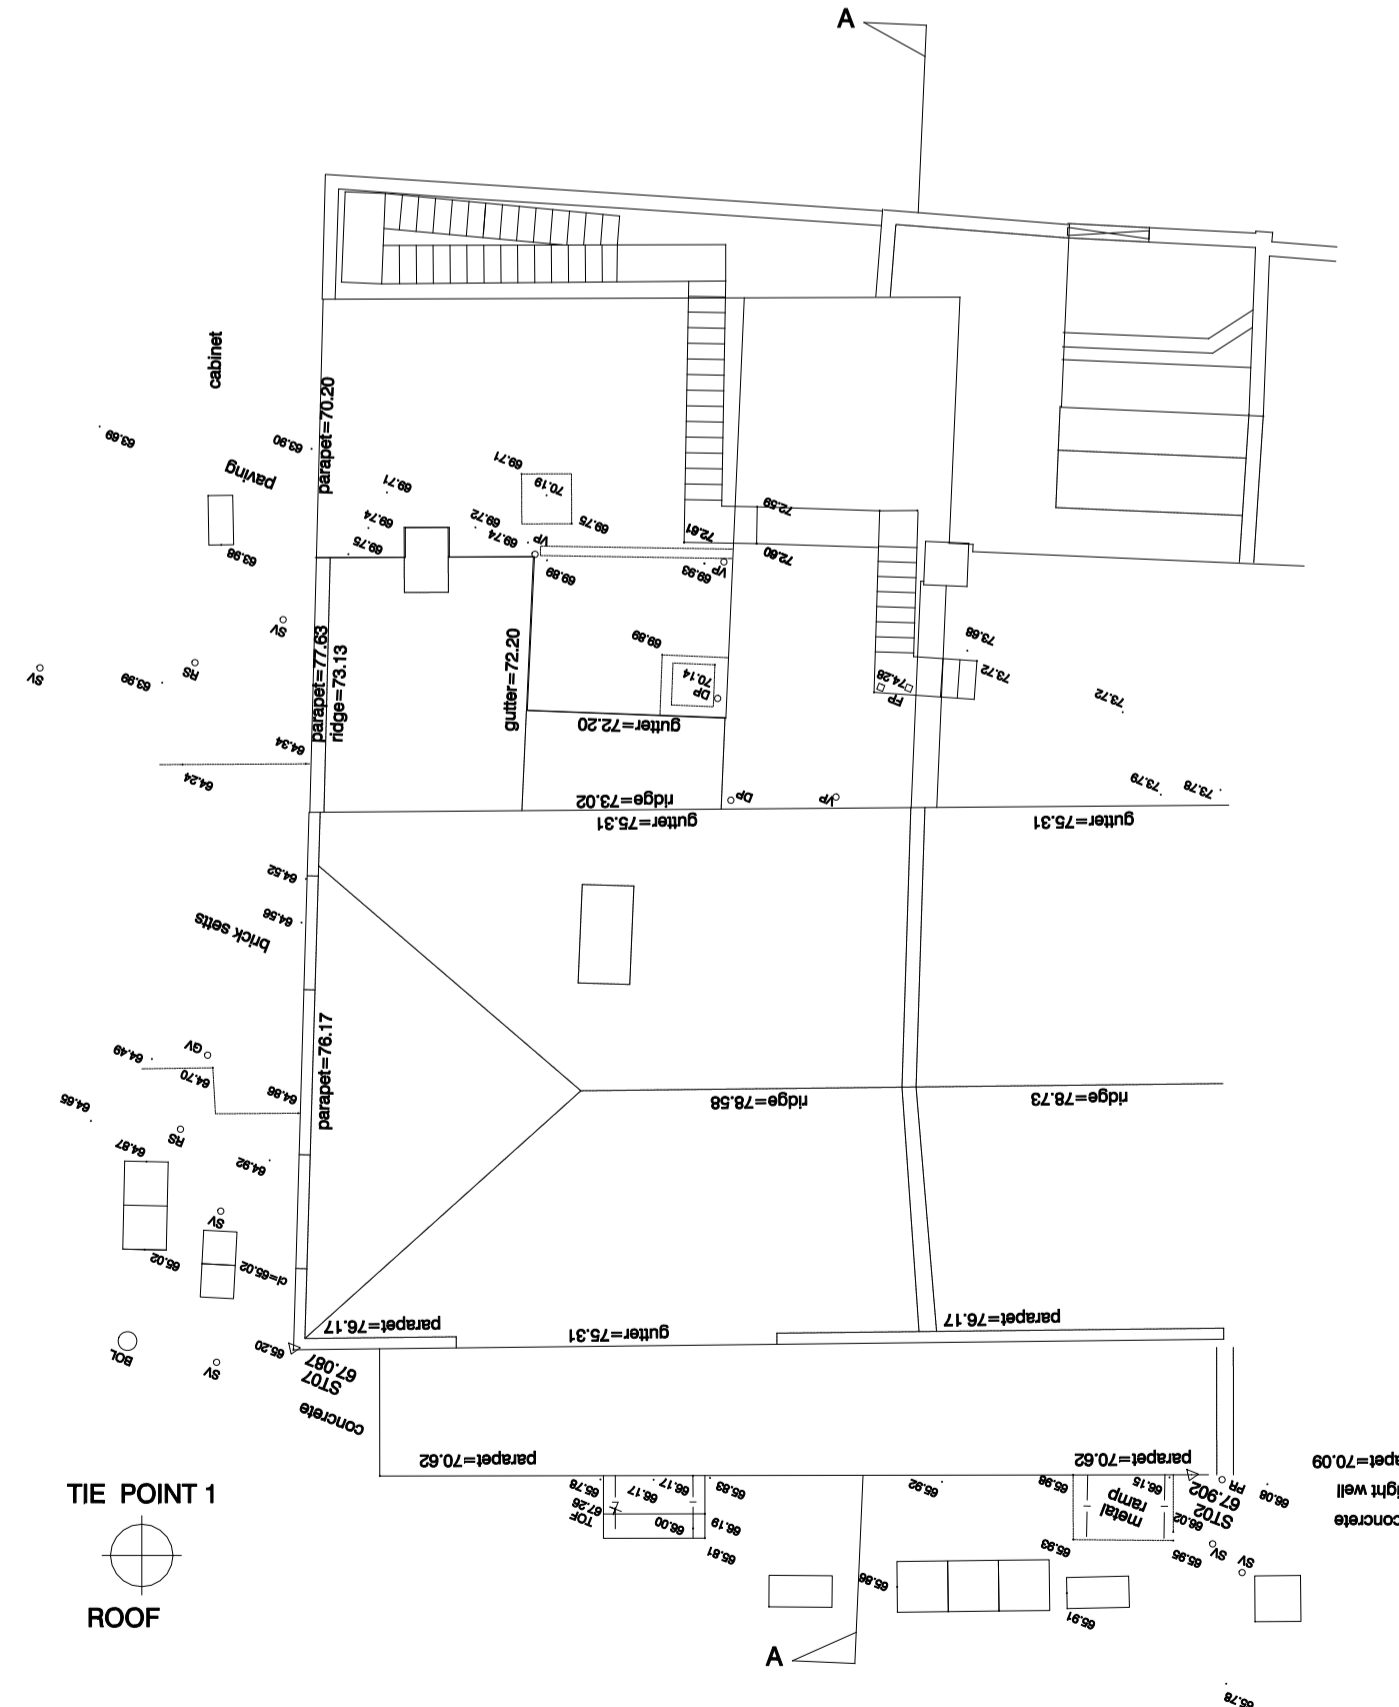

TIE POINT 1  
ROOF

Symbol & Abbreviation Key.

SANITARY (INDICATIVE ONLY)

- WC
- BIDET
- URINAL
- WASH HAND BASIN
- SINK
- SLUICE
- SINK & DRAINER
- SHOWER TRAY
- BATH

ANNOTATION

- ah 1.90 ARCH HEIGHT
- sp 1.78 SPRINGER HEIGHT
- bh 2.43 BEAM HEIGHT TO UNDERSIDE
- us 2.43 UNDERSIDE
- dh 1.90 DOOR HEIGHT
- fc 1.55 FLOOR TO CILL HEIGHT
- ch 0.99 CILL TO HEAD HEIGHT
- ch 2.88 CEILING HEIGHT
- sc 1.88 HIGHEST / LOWEST POINT OF SLOPING CEILING
- sc 2.88 SUSPENDED CEILING HEIGHT

OTHER ABBREVIATIONS

- a/c AIR CONDITIONING UNIT
- bl BOILER
- ck COOKER
- cbd CUPBOARD
- elec ELECTRICS
- fb FLOOR BOARDS (SYMBOL INDICATES BOARD DIRECTION)
- fr PIPE RISER
- rad RADIATOR
- rl ROOF LIGHT
- rsd ROLLER SHUTTER DOOR
- tk TANK

Notes.  
Levels related to topographical survey 160175

A	Section line added	RW	22/04/16
Rev	Details of Revision	Drawn	Date

Surveyed	Drawn	Date	Checked	Date	Approved	Date
RT	RW	20/04/16	RGT	21/04/16	RGT	21/04/16



Interlock Surveys Limited  
St. Andrews House  
Radford Semele  
Leamington Spa  
Warwickshire  
CV31 1TF

T: 01926 330123  
F: 01926 330120  
E: info@interlocksurveys.co.uk

Client.  
KYSON  
STUDIO 28  
SCRUTTON STREET  
LONDON  
EC2A 4RP

Title.  
**MEASURED BUILDING**  
THE ALLIANCE PUB  
40-42 MILL LANE  
NW6 1NR



Elevation 1

Level Datum 62.00m




Elevation 2



Elevation 3

Level Datum 62.00m

**KEY TO ELEVATIONS  
(N.T.S)**

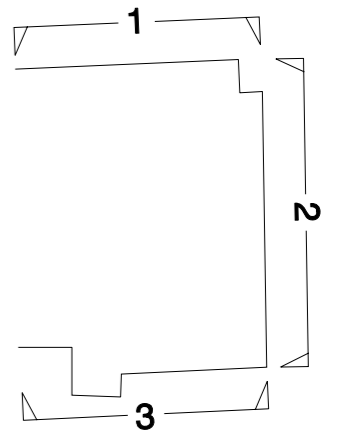

**Notes.**  
Levels related to topographical survey 160175

Rev	Details of Revision	Drawn	Date
A	Section B-B added	RW	22/04/16

Surveyed	Drawn	Date	Checked	Date	Approved	Date
ET	RW	21/04/16	RGT	21/04/16	RGT	21/04/16

Interlock Surveys Limited  
St. Andrews House  
Radford Semele  
Leamington Spa  
Warwickshire  
CV31 1TF


T: 01926 330123  
F: 01926 330120  
E: info@interlocksurveys.co.uk

**Client.**  
KYSOON STUDIO 28  
SCRUTTON STREET  
LONDON  
EC2A 4RP


**Title.**  
**ELEVATIONS**  
THE ALLIANCE PUB  
40-42 MILL LANE  
NW6 1NR

Dwg No. **160175 ELE** Sheet **1 of 2**

Scale 1:100 A2 Sheet Rev. A

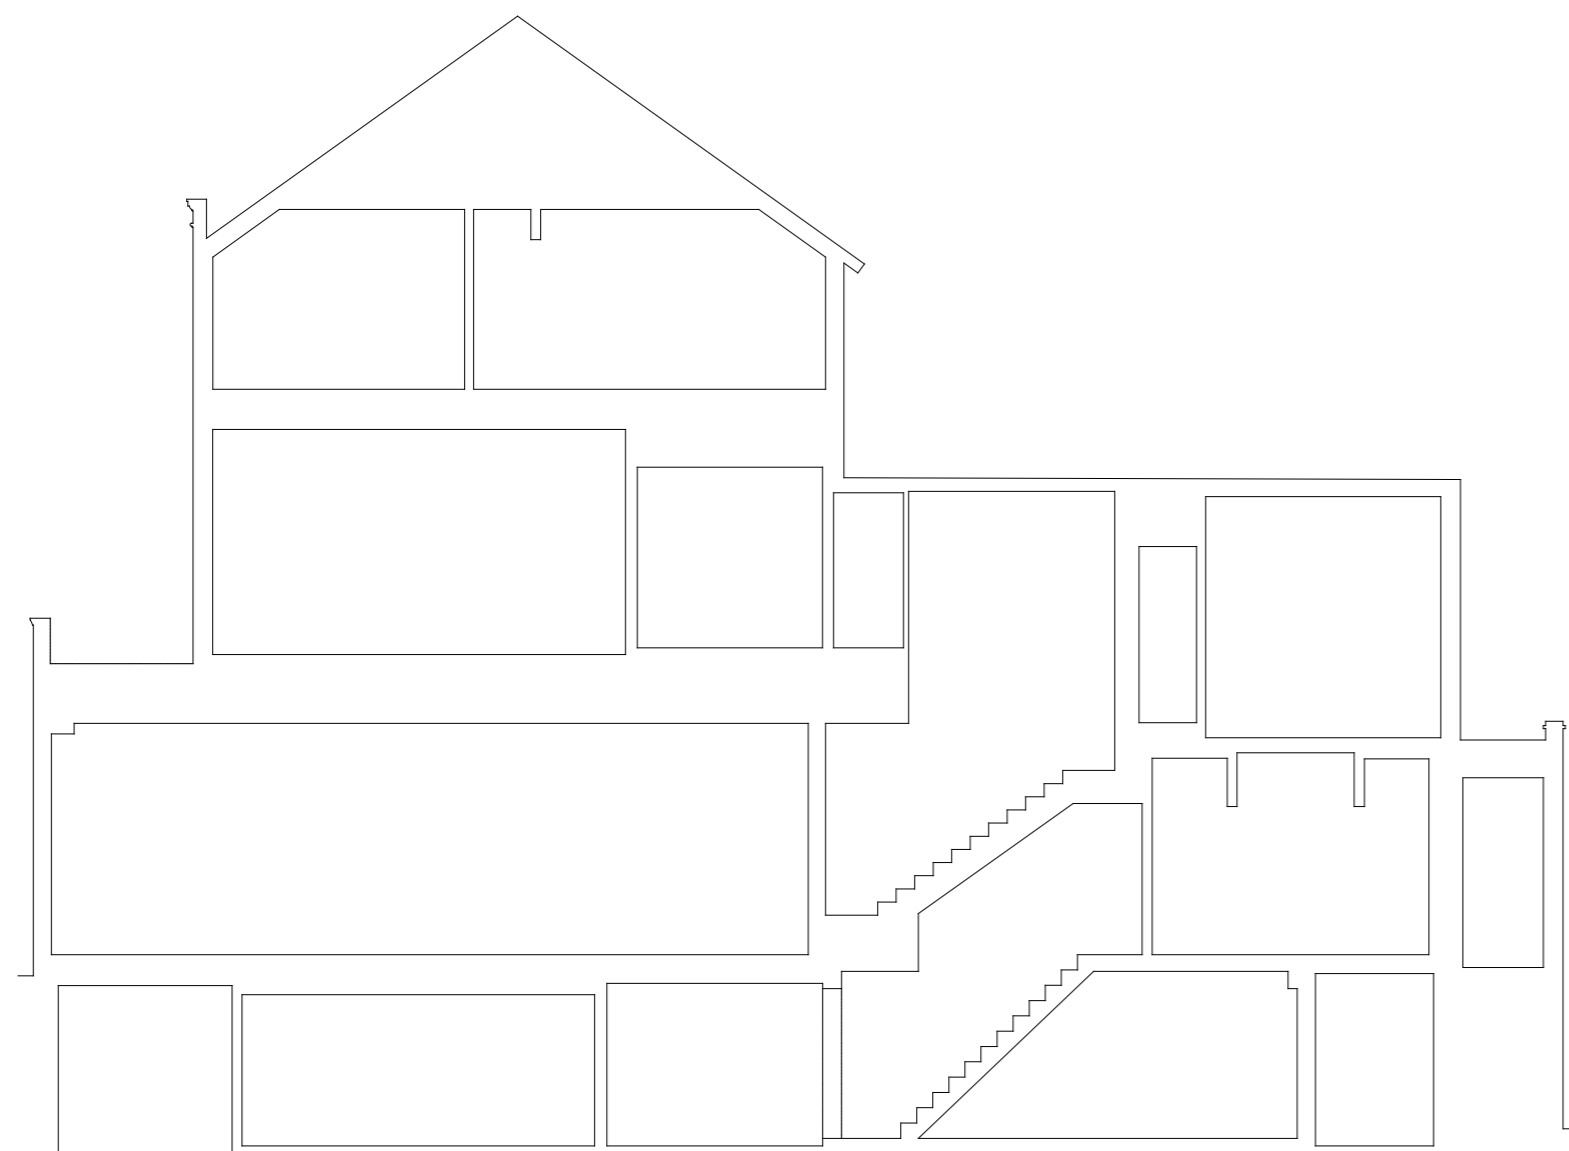


Section A-A

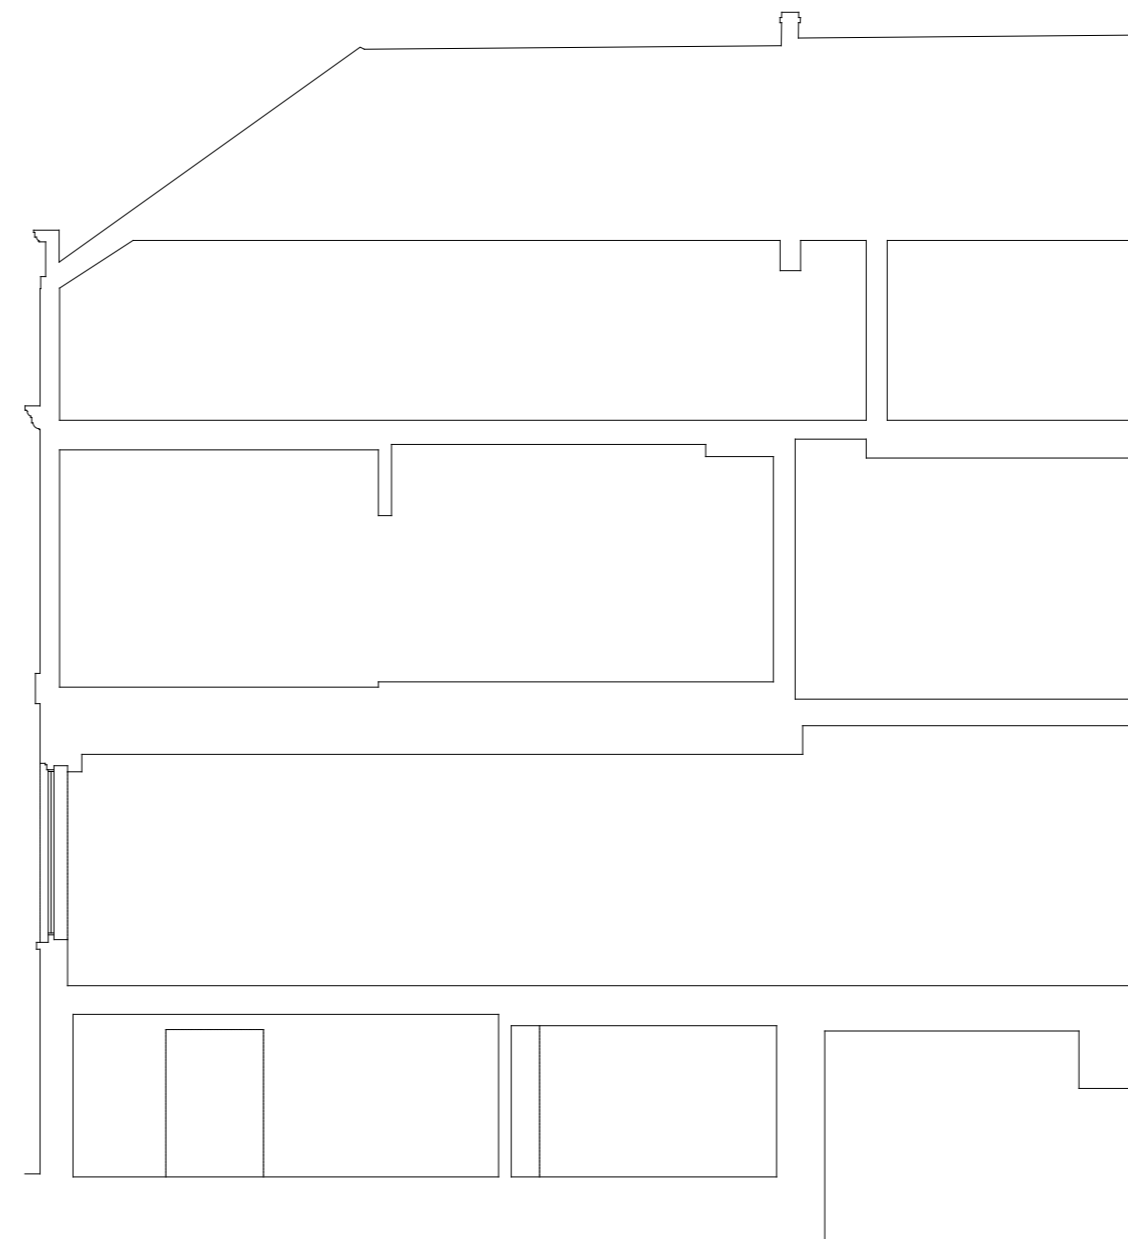

Section B-B

Level Datum 62.00m

**KEY TO ELEVATIONS  
(N.T.S)**

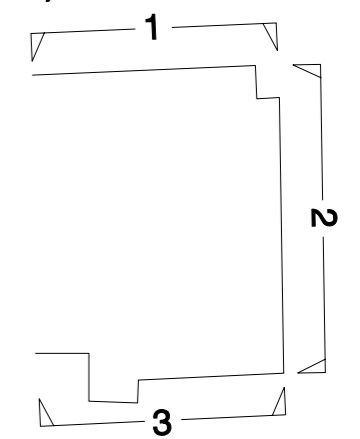

**Notes.**  
Levels related to topographical survey 160175

Rev	Details of Revision	Drawn	Date
A	Section B-B added	RW	22/04/16

Surveyed	Drawn	Date	Checked	Date	Approved	Date
ET	RW	21/04/16	RGT	21/04/16	RGT	21/04/16



**INTERLOCK SURVEYS**

Interlock Surveys Limited  
St. Andrews House  
Radford Semele  
Leamington Spa  
Warwickshire  
CV31 1TF

T: 01926 330123  
F: 01926 330120  
E: info@interlocksurveys.co.uk

**Client.**  
KYSON STUDIO 28  
SCRUTTON STREET  
LONDON  
EC2A 4RP

**Title.**  
**ELEVATIONS**  
THE ALLIANCE PUB  
40-42 MILL LANE  
NW6 1NR

Dwg No. **160175 ELE** Sheet **2 of 2**

Scale 1:100 A2 Sheet Rev. A