


NOTE

1. For Wall Types and S/O refer to 22 series drawings.
2. Refer to internal room elevations for extent of wall types/panelling.

NOTES FOR EMP TEAM

- Areas marked with red line are to be developed/previous comments to be incorporated.
- Drainage demarcations to be added with types, numbers and levels for clarity, also refer to M&E engineers information.
- Note added to refer to room elevations to confirm extent of wall types/panelling. (Internal room elevations to follow).

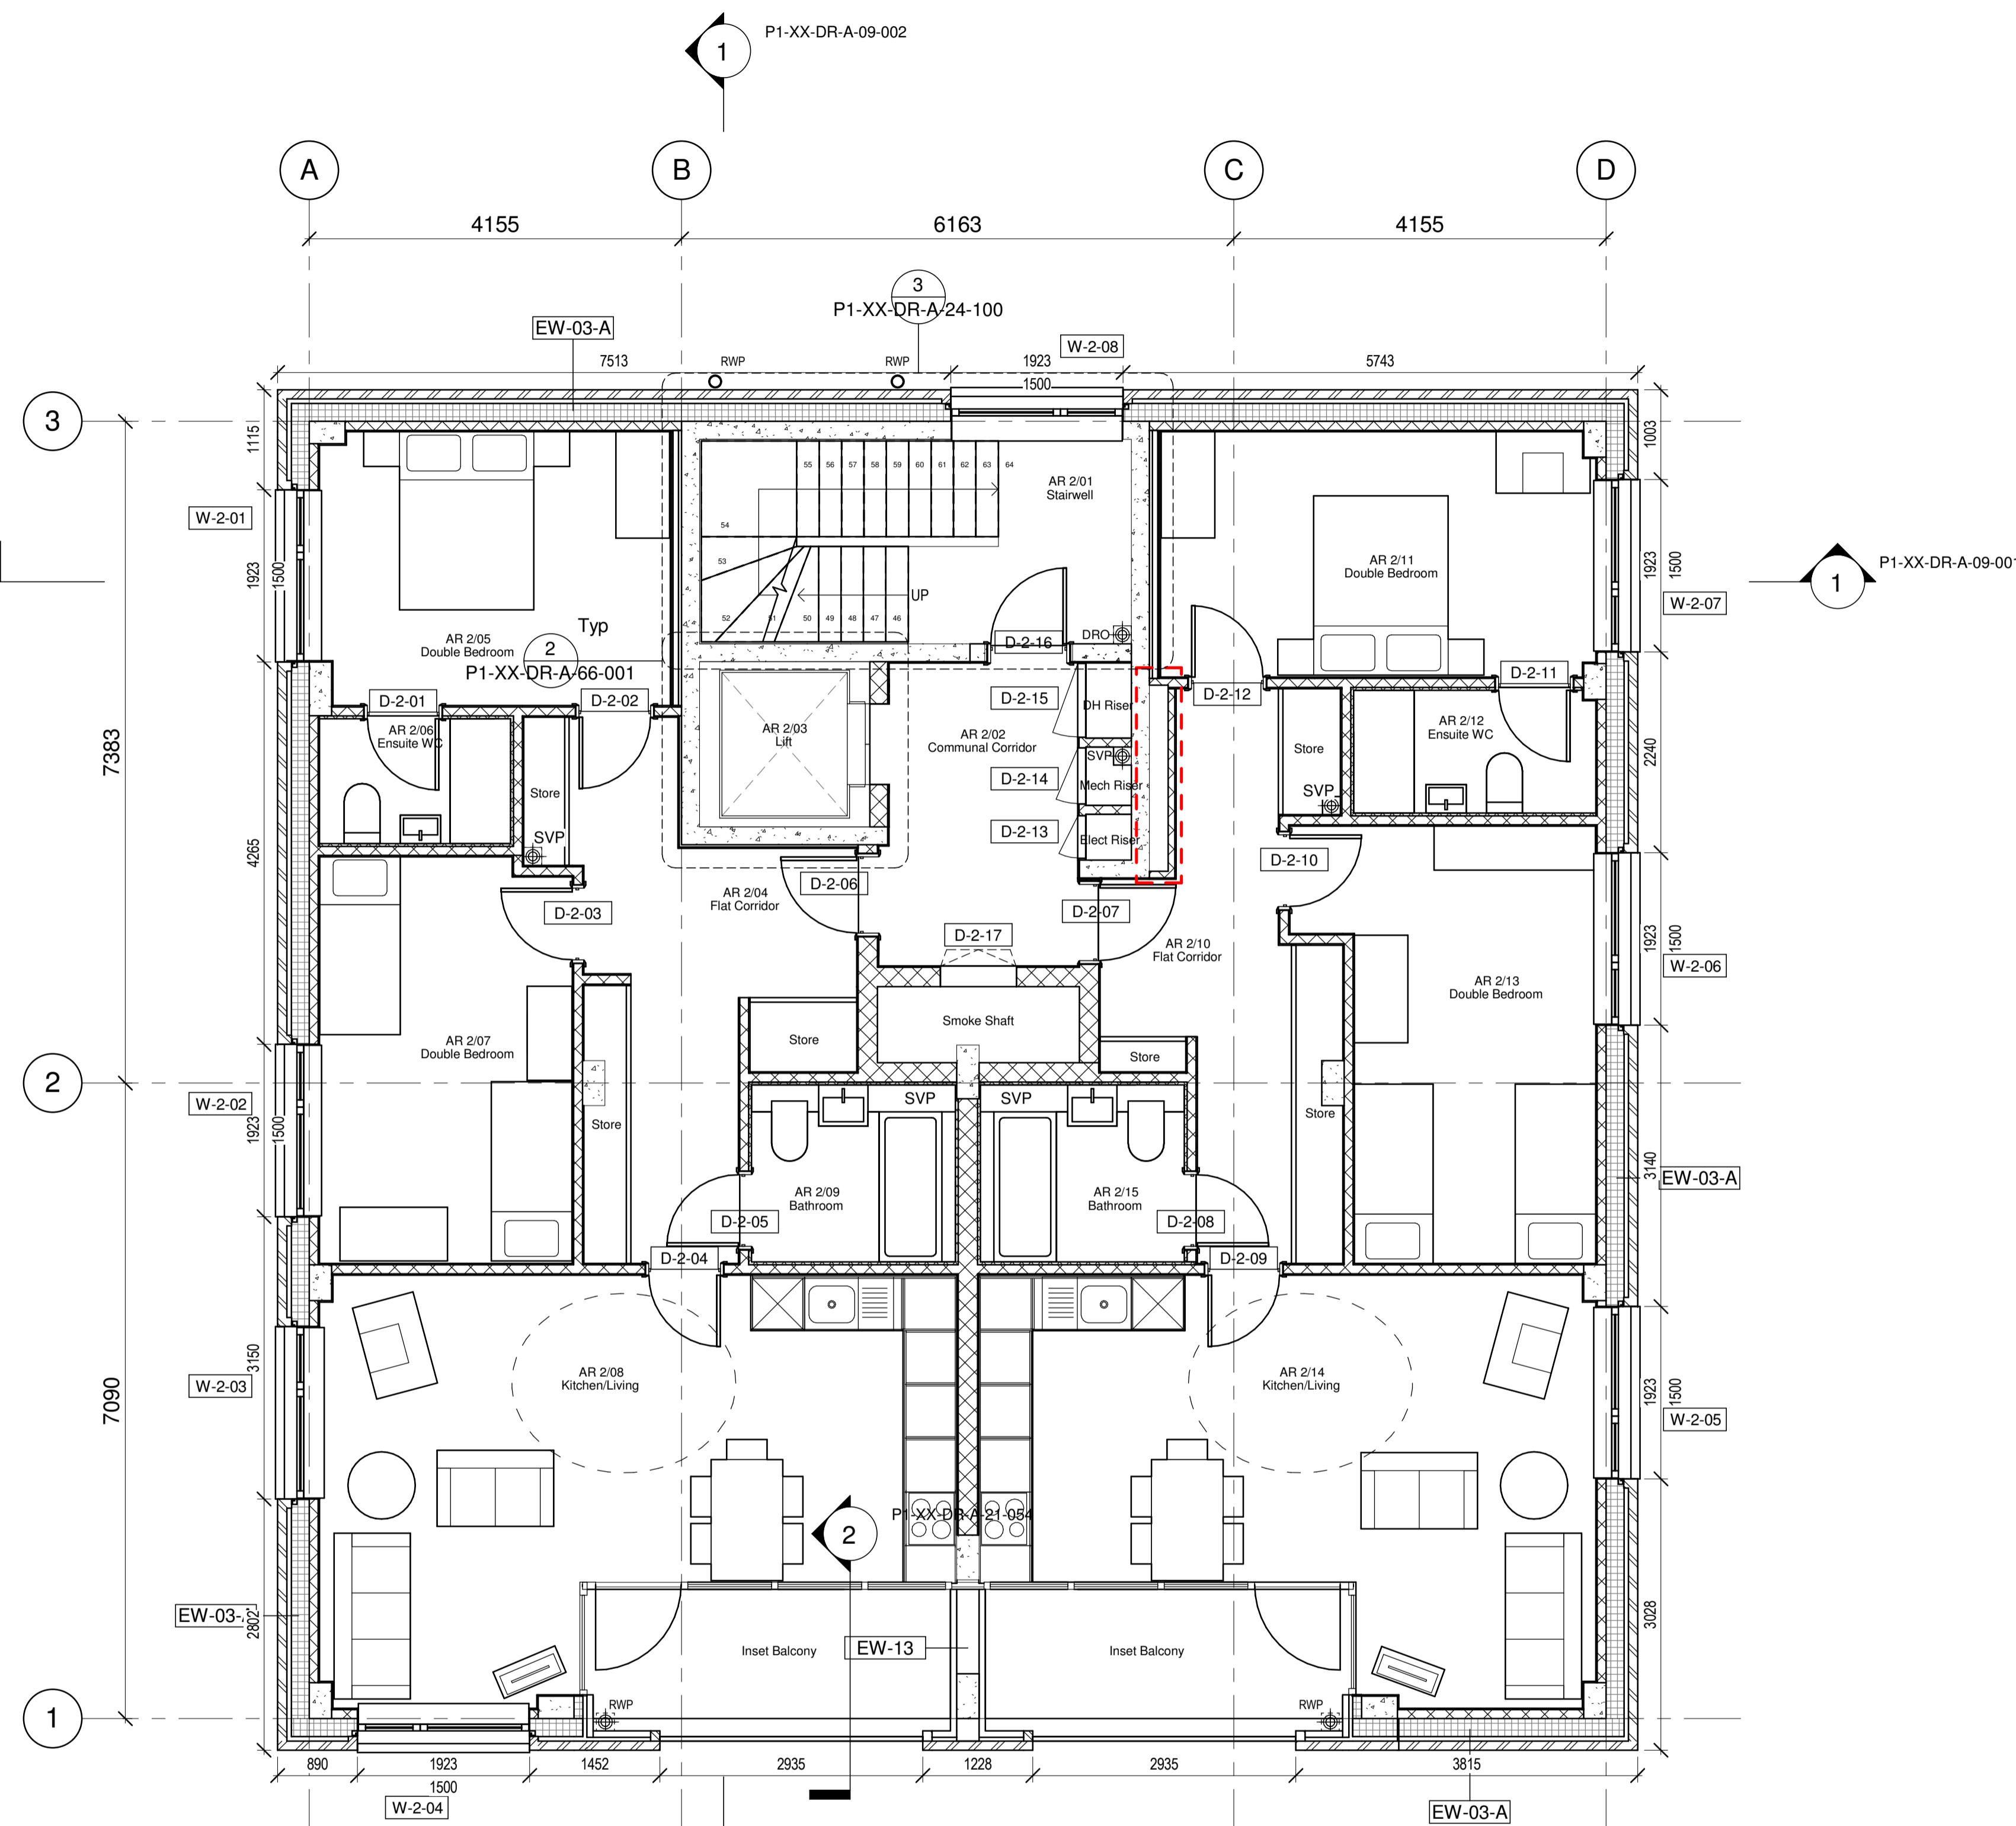

| 1         | First Construction Issue | ST    | NF      | 27/03/18 |
|-----------|--------------------------|-------|---------|----------|
| rev       | description              | drawn | checked | date     |
| revisions |                          |       |         |          |

status: CONSTRUCTION  
 This drawing is protected under The Copyright, Designs and Patents Act 1988. Not scale. Figured dimensions only are to be taken from this drawing. All dimensions are to be checked on site before any work is put in hand. If in doubt, ASK.

**P T A L**  
 PETER TAYLOR ASSOCIATES LIMITED  
 7 CURZON STREET  
 MAYFAIR LONDON W1J 5HG  
 -  
 TELEPHONE + 44 (0)20 7495 3837  
 FACSIMILE + 44 (0)20 7493 3475  
 EMAIL MAYFAIR@PTAL.CO.UK  
 -  
 WWW.PTAL.CO.UK

client: Neilcott Construction Group  
 Excel House  
 Cray Avenue  
 Orpington  
 Kent  
 BR5 3ST



project: Central Somers Town  
 Plot 1

title: Block A - GA Second Floor Plan

scale: As indicated @ A1  
 date: 16/10/17  
 drawn: ST  
 checked: NF

Project ID: 170044  
 Originator: PTA  
 Drawing No: P1-02-DR-A-07-102  
 revision: C1

