


NOTE

1. For Wall Types and S/O refer to 22 series drawings.
2. Refer to internal room elevations for extent of wall types/panelling.

NOTES FOR EMP TEAM

- Areas marked with red line are to be developed/previous comments to be incorporated.
- Drainage demarcations to be added with types, numbers and levels for clarity, also refer to M&E engineers information.
- Note added to refer to room elevations to confirm extent of wall types/panelling. (Internal room elevations to follow).

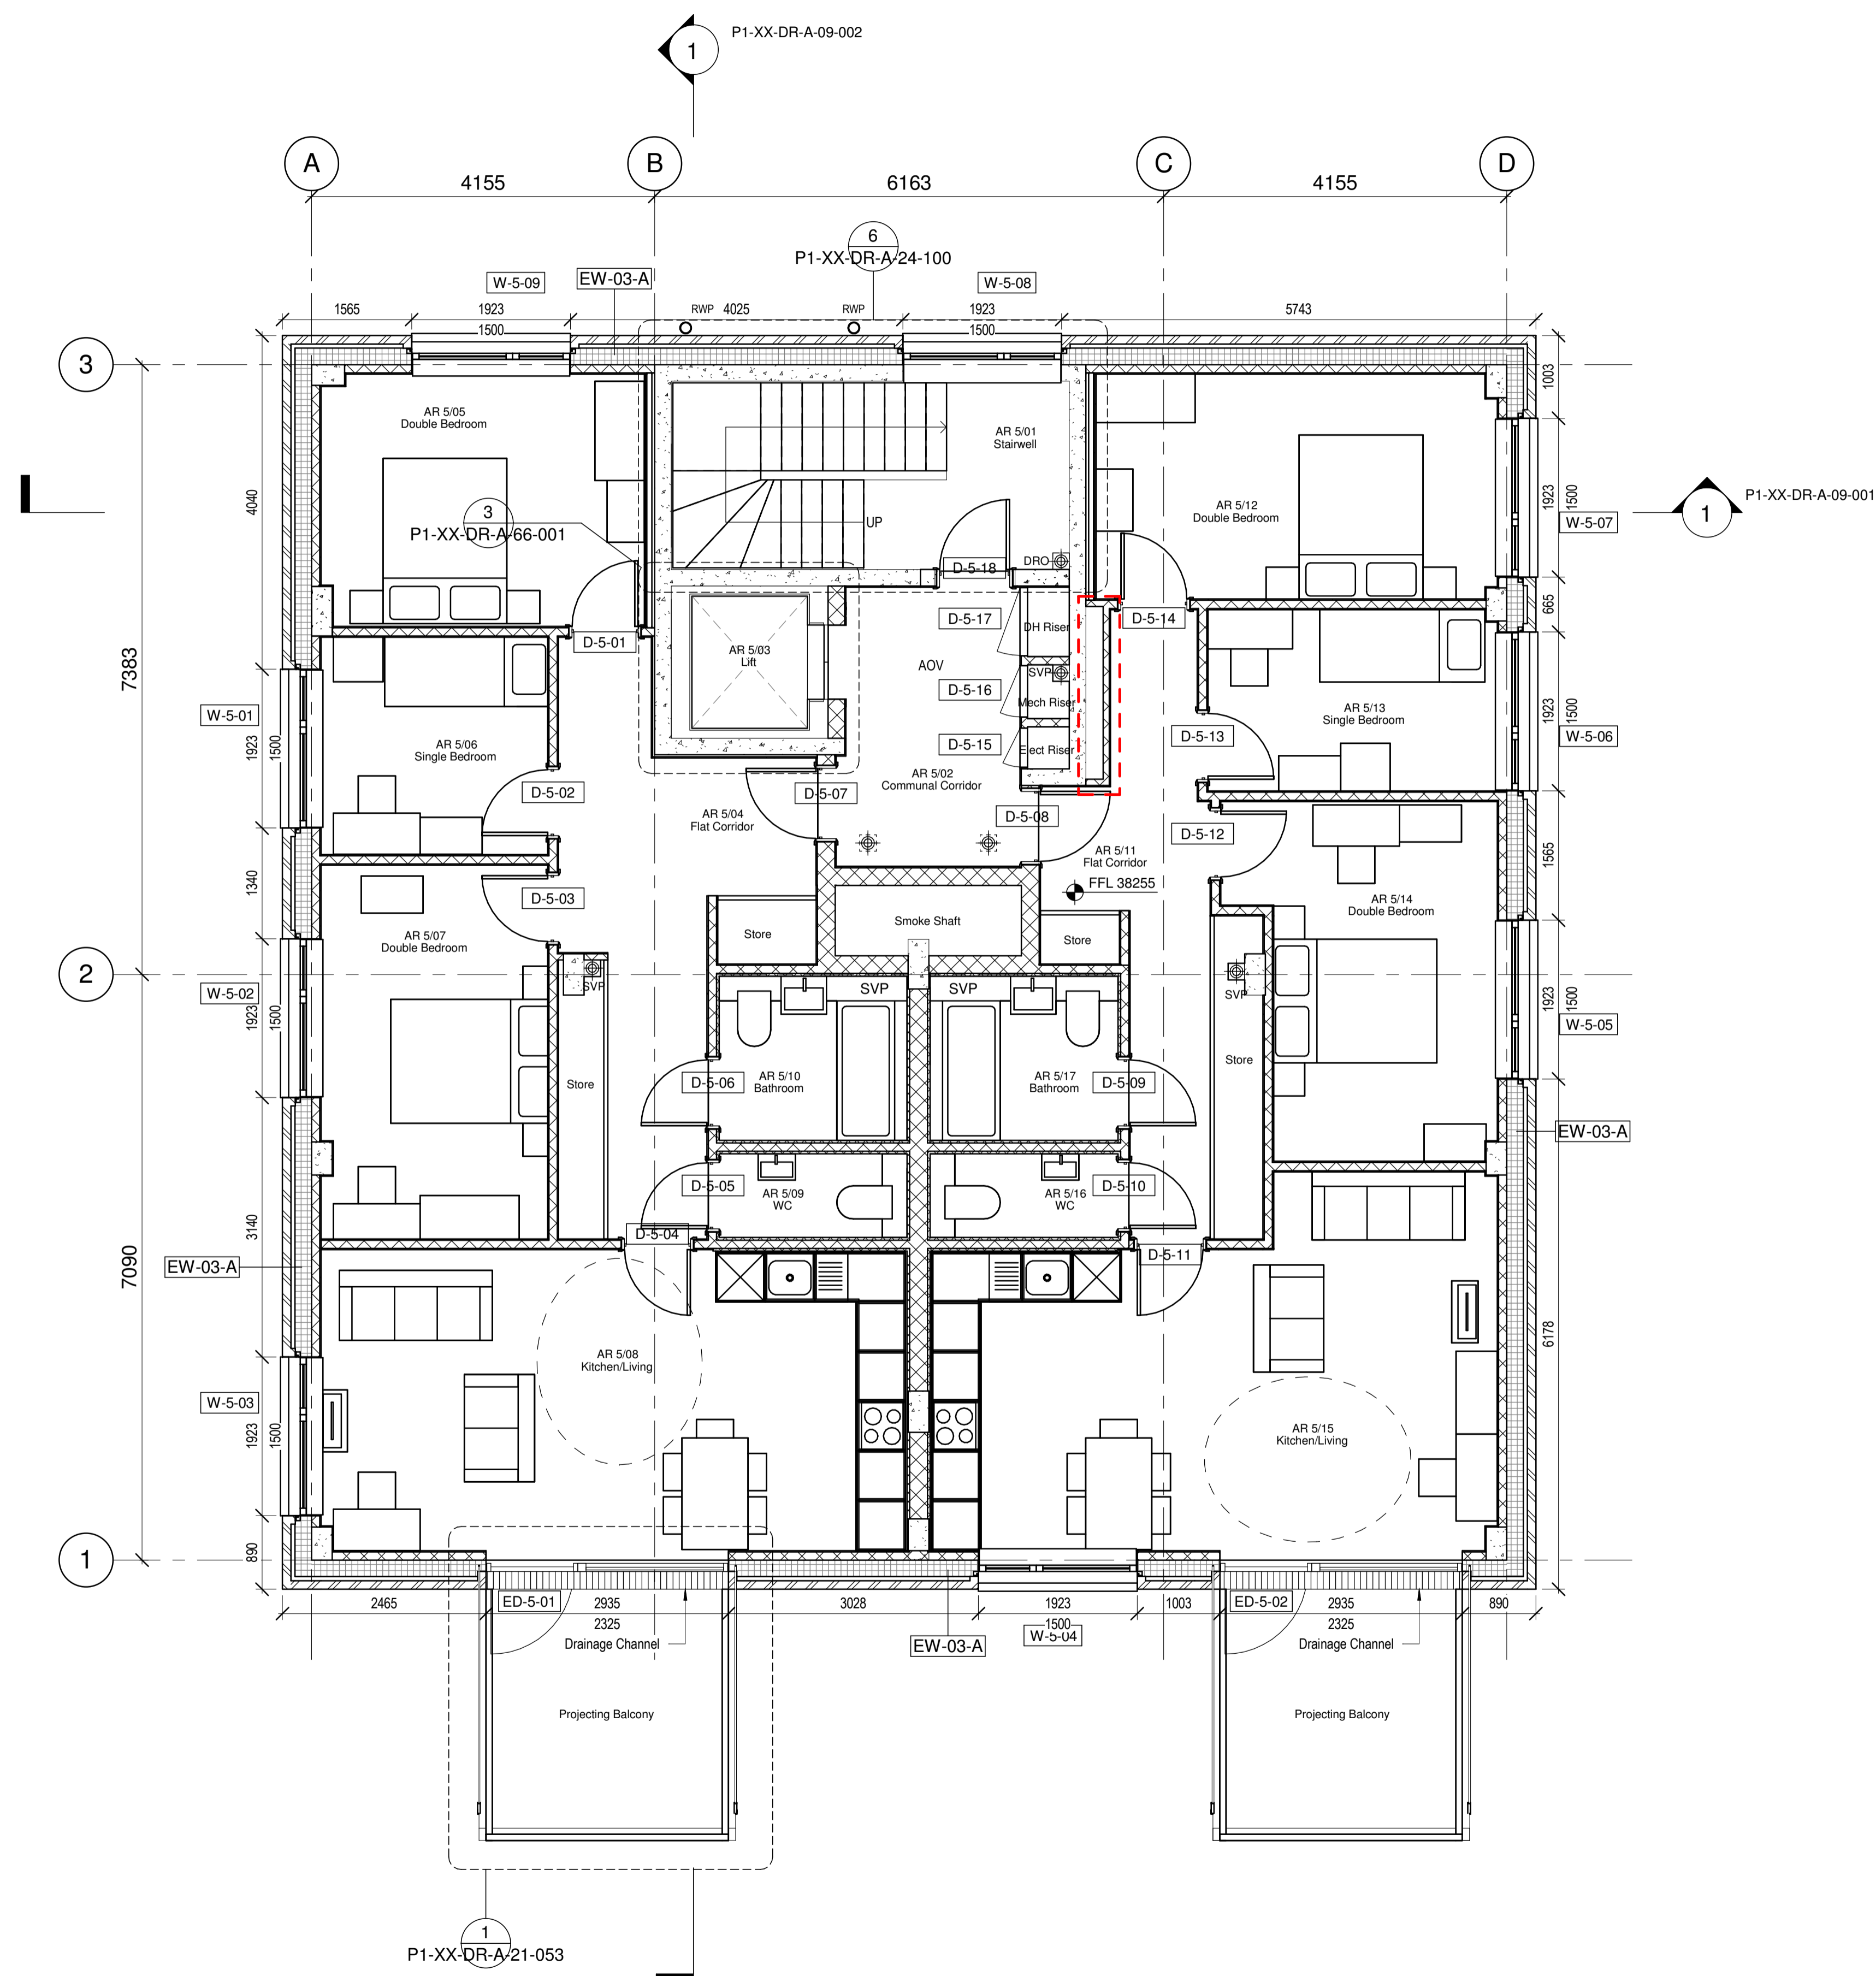

rev	description	drawn	checked	date
1	First Construction Issue	ST	NF	27/03/18
revisions				

status: CONSTRUCTION
 This drawing is protected under The Copyright, Designs and Patents Act 1988. Do not scale. Figured dimensions only are to be taken from this drawing. All dimensions are to be checked on site before any work is put in hand. If in doubt, ASK.

P T A L
 PETER TAYLOR ASSOCIATES LIMITED
 7 CURZON STREET
 MAYFAIR LONDON W1J 5HG
 -
 TELEPHONE + 44 (0)20 7495 3837
 FACSIMILE + 44 (0)20 7493 3475
 EMAIL MAYFAIR@PTAL.CO.UK
 -
 WWW.PTAL.CO.UK

client: Neilcott Construction Group
 Excel House
 Cray Avenue
 Orpington
 Kent
 BR5 3ST



project: Central Somers Town
 Plot 1

title: Block A - GA Fifth Floor Plan

scale: As indicated @ A1
 date: 16/10/17
 drawn: NF
 checked: Checker

Project ID: 170044
 Originator: PTA
 Drawing No: P1-05-DR-A-07-105
 revision: C1

