


Notes:
 Drawing units are metres.
 Stair slope arrows point up
 Direction of floor boards
 Direction of roof slope (up)

Abbreviations:

Notes:
 THIS SURVEY HAS BEEN CARRIED OUT WITH AN ACCURACY CONSISTENT WITH A
 SCALE OF 1:50.
 METRICATIONS WILL BE WITHIN THE TOLERANCE
 ASSOCIATED WITH THIS AND SMALLER SCALES ONLY.
 ALL LEVELS ARE IN METRES, RELATED TO OS DATUM.
 UNITS ARE MILLIMETRES.

St. Katharine's - The Danish Church in London

SITE SURVEY


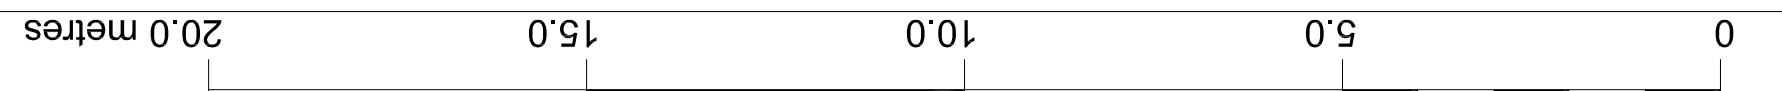


SURVEYED & DRAWN BY:
James Brennan
 Chartered Surveyor
 www.brennans.co.uk
 UNIT 6 WARREN HOUSE
 DEPFORD ROAD, BAKEWELL
 DERBY DT10 9JG
 EMAIL: mail@brennans.co.uk

Architect/Surveyor:
C.F. MOLLER
 Metropolitan Wharf,
 70 Wapping Wall,
 London, E1W 3SS
 Tel: +44 (0)207 4271530

Client:

Drawing no. 16-82-SS-01
 Issue date March 2017
 Issue status B
 Scale 1:100 @ A1

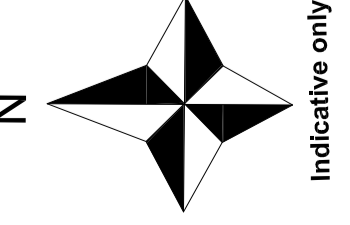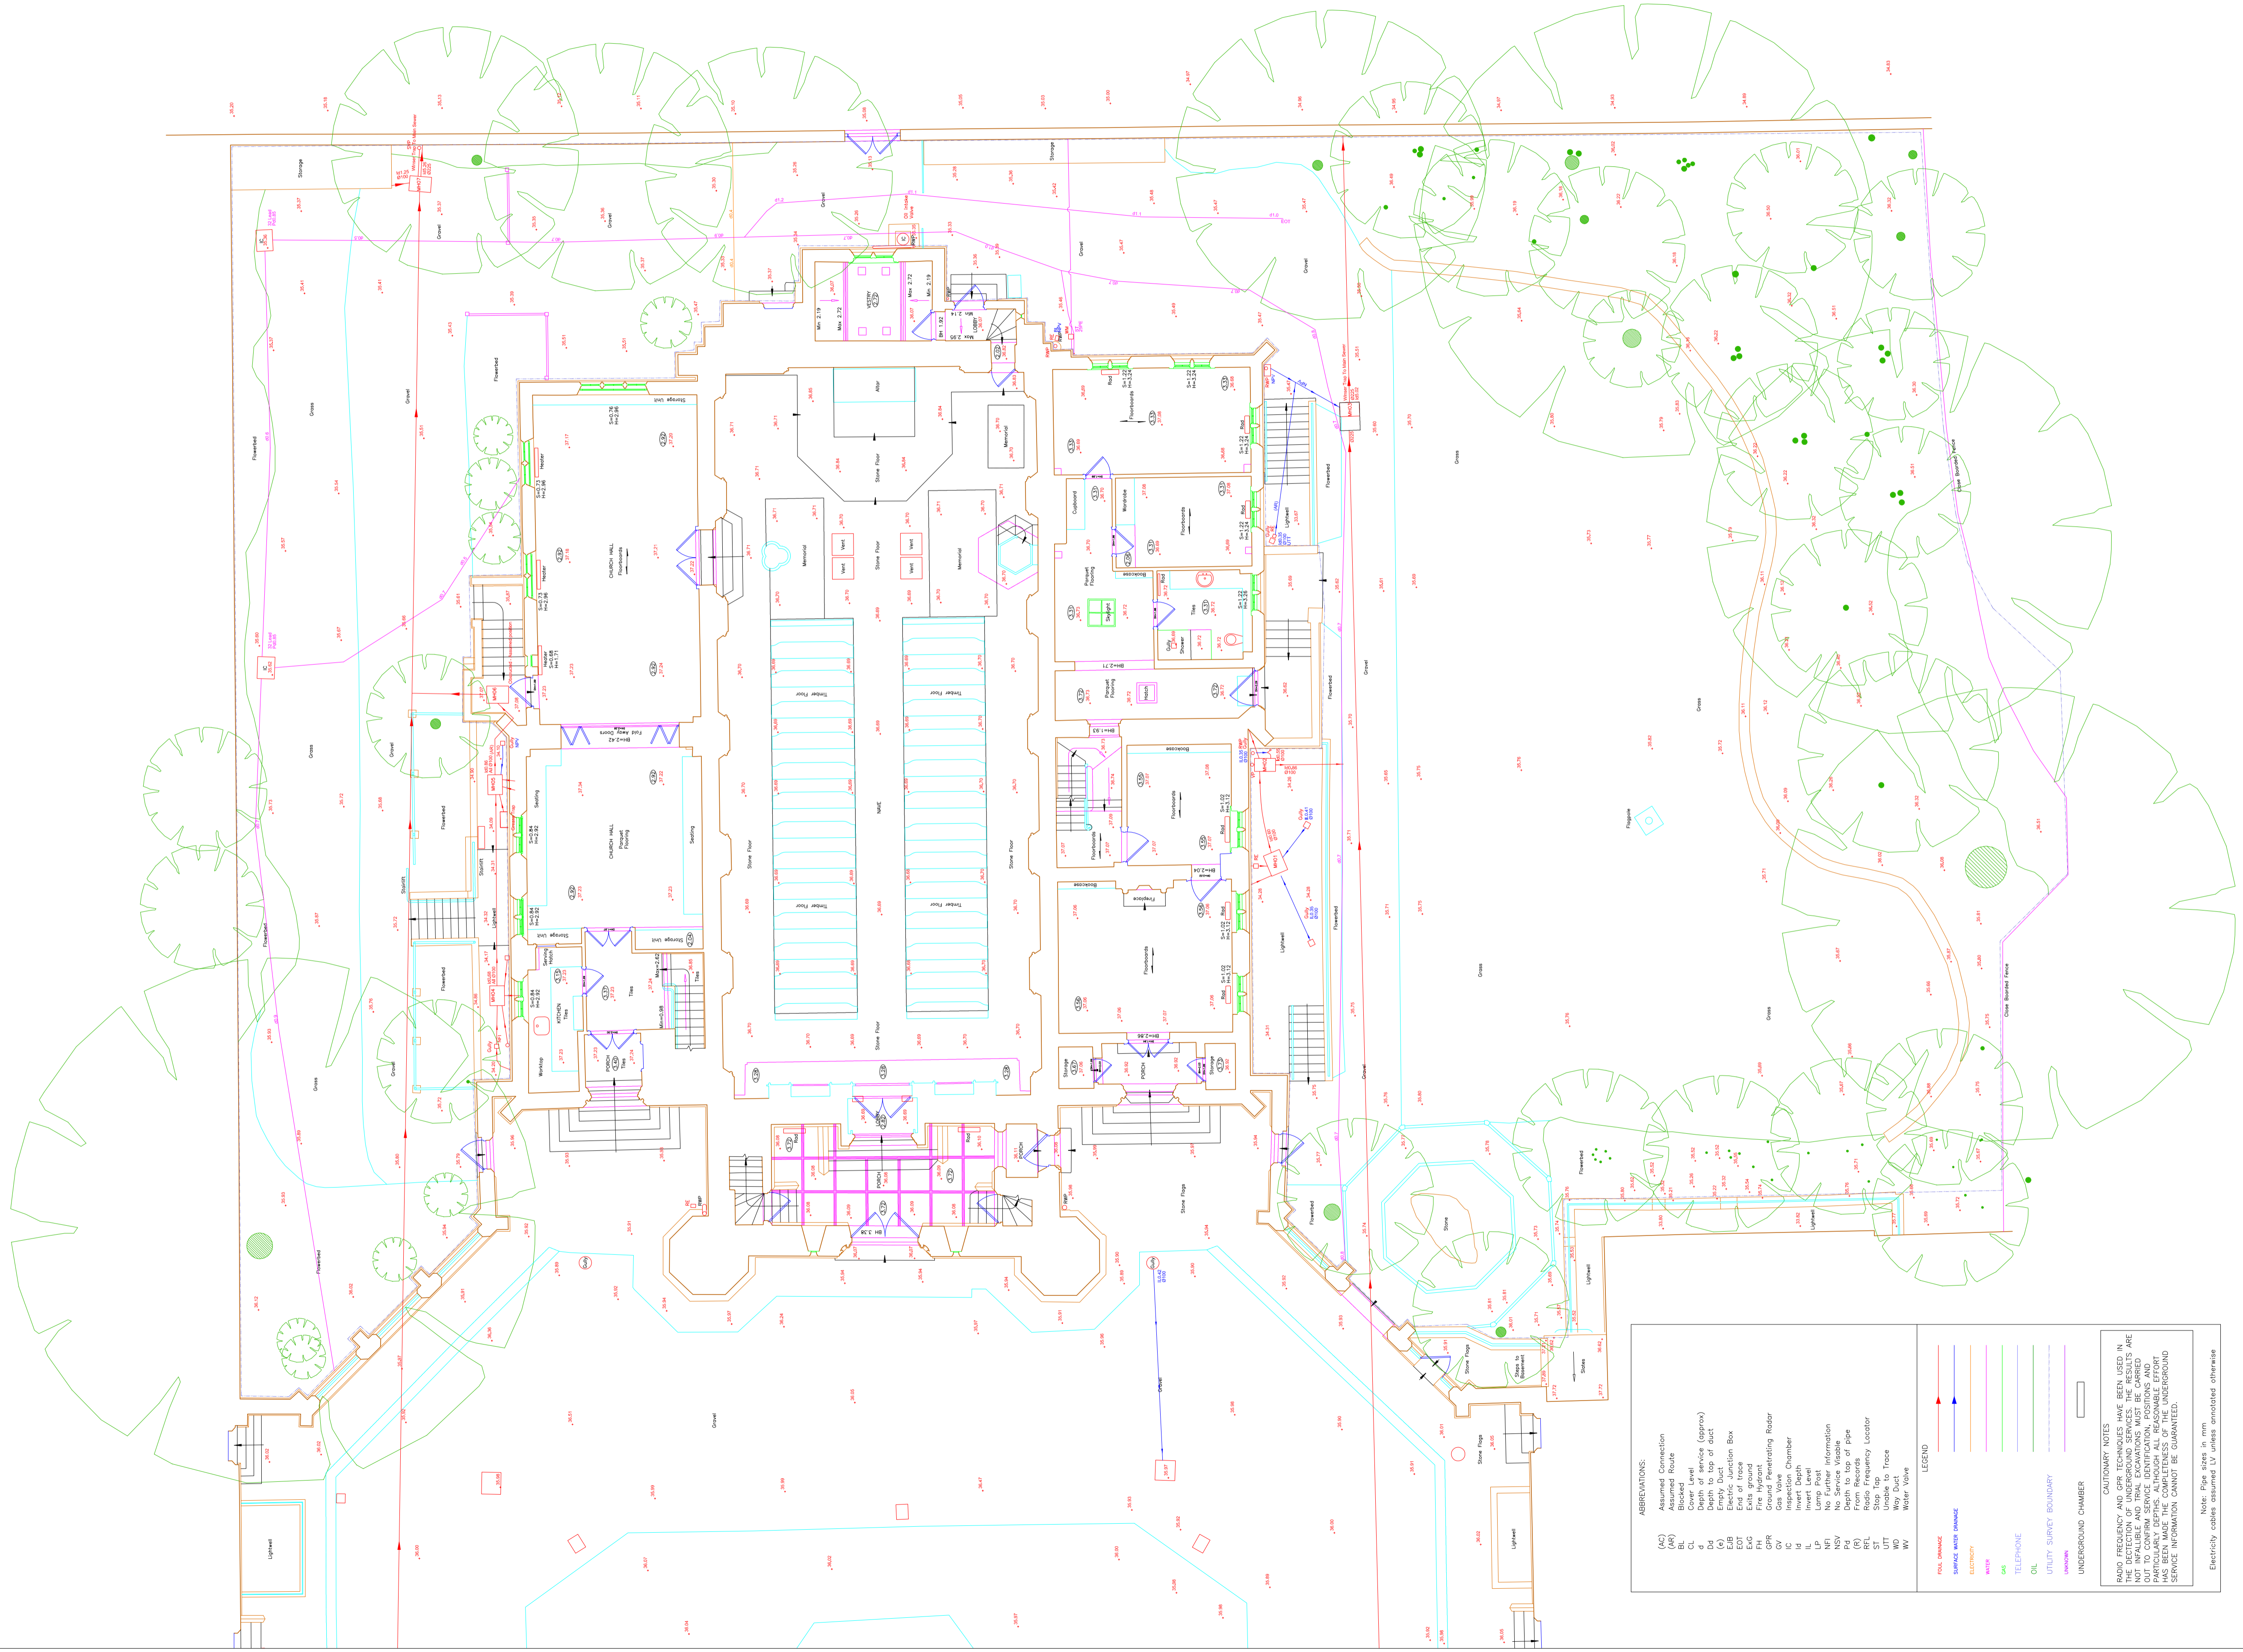

Indicative only

ABBREVIATIONS:

- (AC) Assumed Connection
- (AR) Assumed Route
- BL Blocked
- CL Cable
- d Depth of service (approx)
- DA Depth to top of duct
- EJB Electric Junction Box
- ECJ End of cable
- FI Fire hydrant
- GRP Ground Penetrating Radar
- IC Inspection Chamber
- Id Invert Depth
- Lp Lamp Post
- NEL No further information
- NSL No further information
- PD Depth to top of pipe
- RC Rec from Records
- ST Stop Tap
- UTT Unable to Trace
- WV Water Valve

LEGEND

- RED LINE ROAD
- ORANGE LINE SERVICE SERVICE SERVICE
- GREEN LINE ELECTRICITY
- PURPLE LINE WATER
- BLUE LINE GAS
- YELLOW LINE TELEPHONE
- BROWN LINE OIL
- BLACK LINE UTILITY SURVEY BOUNDARY
- WHITE LINE UNDERGROUND CHAMBER

CAUTIONARY NOTES
 THIS SURVEY HAS BEEN MADE BY VISUAL INSPECTION AND THE RESULTS ARE NOT INFALLIBLE AND TRIAL EXCAVATIONS MUST BE CARRIED OUT TO VERIFY PARTICULARS, PARTICULARLY DEPTHS, ALTHOUGH ALL REASONABLE EFFORT HAS BEEN MADE TO COMPLETE THE UNDERGROUND SERVICE INFORMATION. SERVICE INFORMATION CANNOT BE GUARANTEED.

Note: Pipe sizes in mm.
 Electrically cables assumed LV unless annotated otherwise