


Notes:
 Drawing units are metres.
 Stair/ slope arrows point up
 Direction of floor boards
 Direction of roof slope (up)

Notes:
 THIS SURVEY HAS BEEN CARRIED OUT WITH AN ACCURACY CONSISTENT WITH A SCALE OF 1:50.
 METROLOGICAL MEASUREMENTS WILL BE WITHIN THE TOLERANCE ASSOCIATED WITH THIS AND SMALLER SCALES ONLY.
 ALL LEVELS ARE IN METRES, RELATED TO OS DATUM.
 UNITS ARE MILLIMETRES.

St. Katharine's - The Danish Church in London


SITE SURVEY

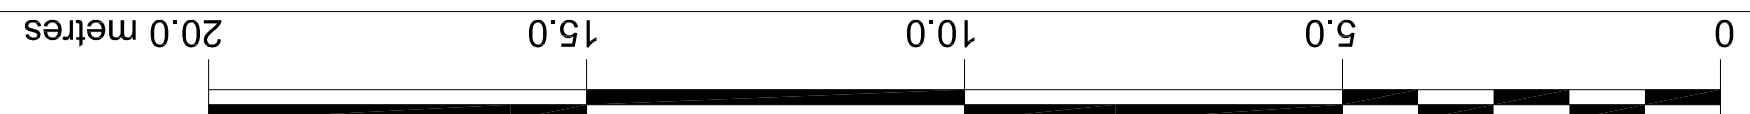

James Brennan
 Chartered Surveyor
 www.brennansurveys.co.uk
 UNIT 6 WARREN HOUSE
 DEPALE BUSINESS PARK
 ASHFORD ROAD, BAKWELL
 DEPT CT TEL: 01629 814654
 EMAIL: mail@brennansurveys.co.uk

C.F. MOLLER
 Architect/ Surveyor
 Metropolitan Wharf,
 70 Wapping Wall,
 London, E1W 3SS
 Tel: +44 (0)207 4271530

Drawing no. 16-82-SS02
 Issue date March 2017
 Issue status B
 Scale 1:100 @ A1

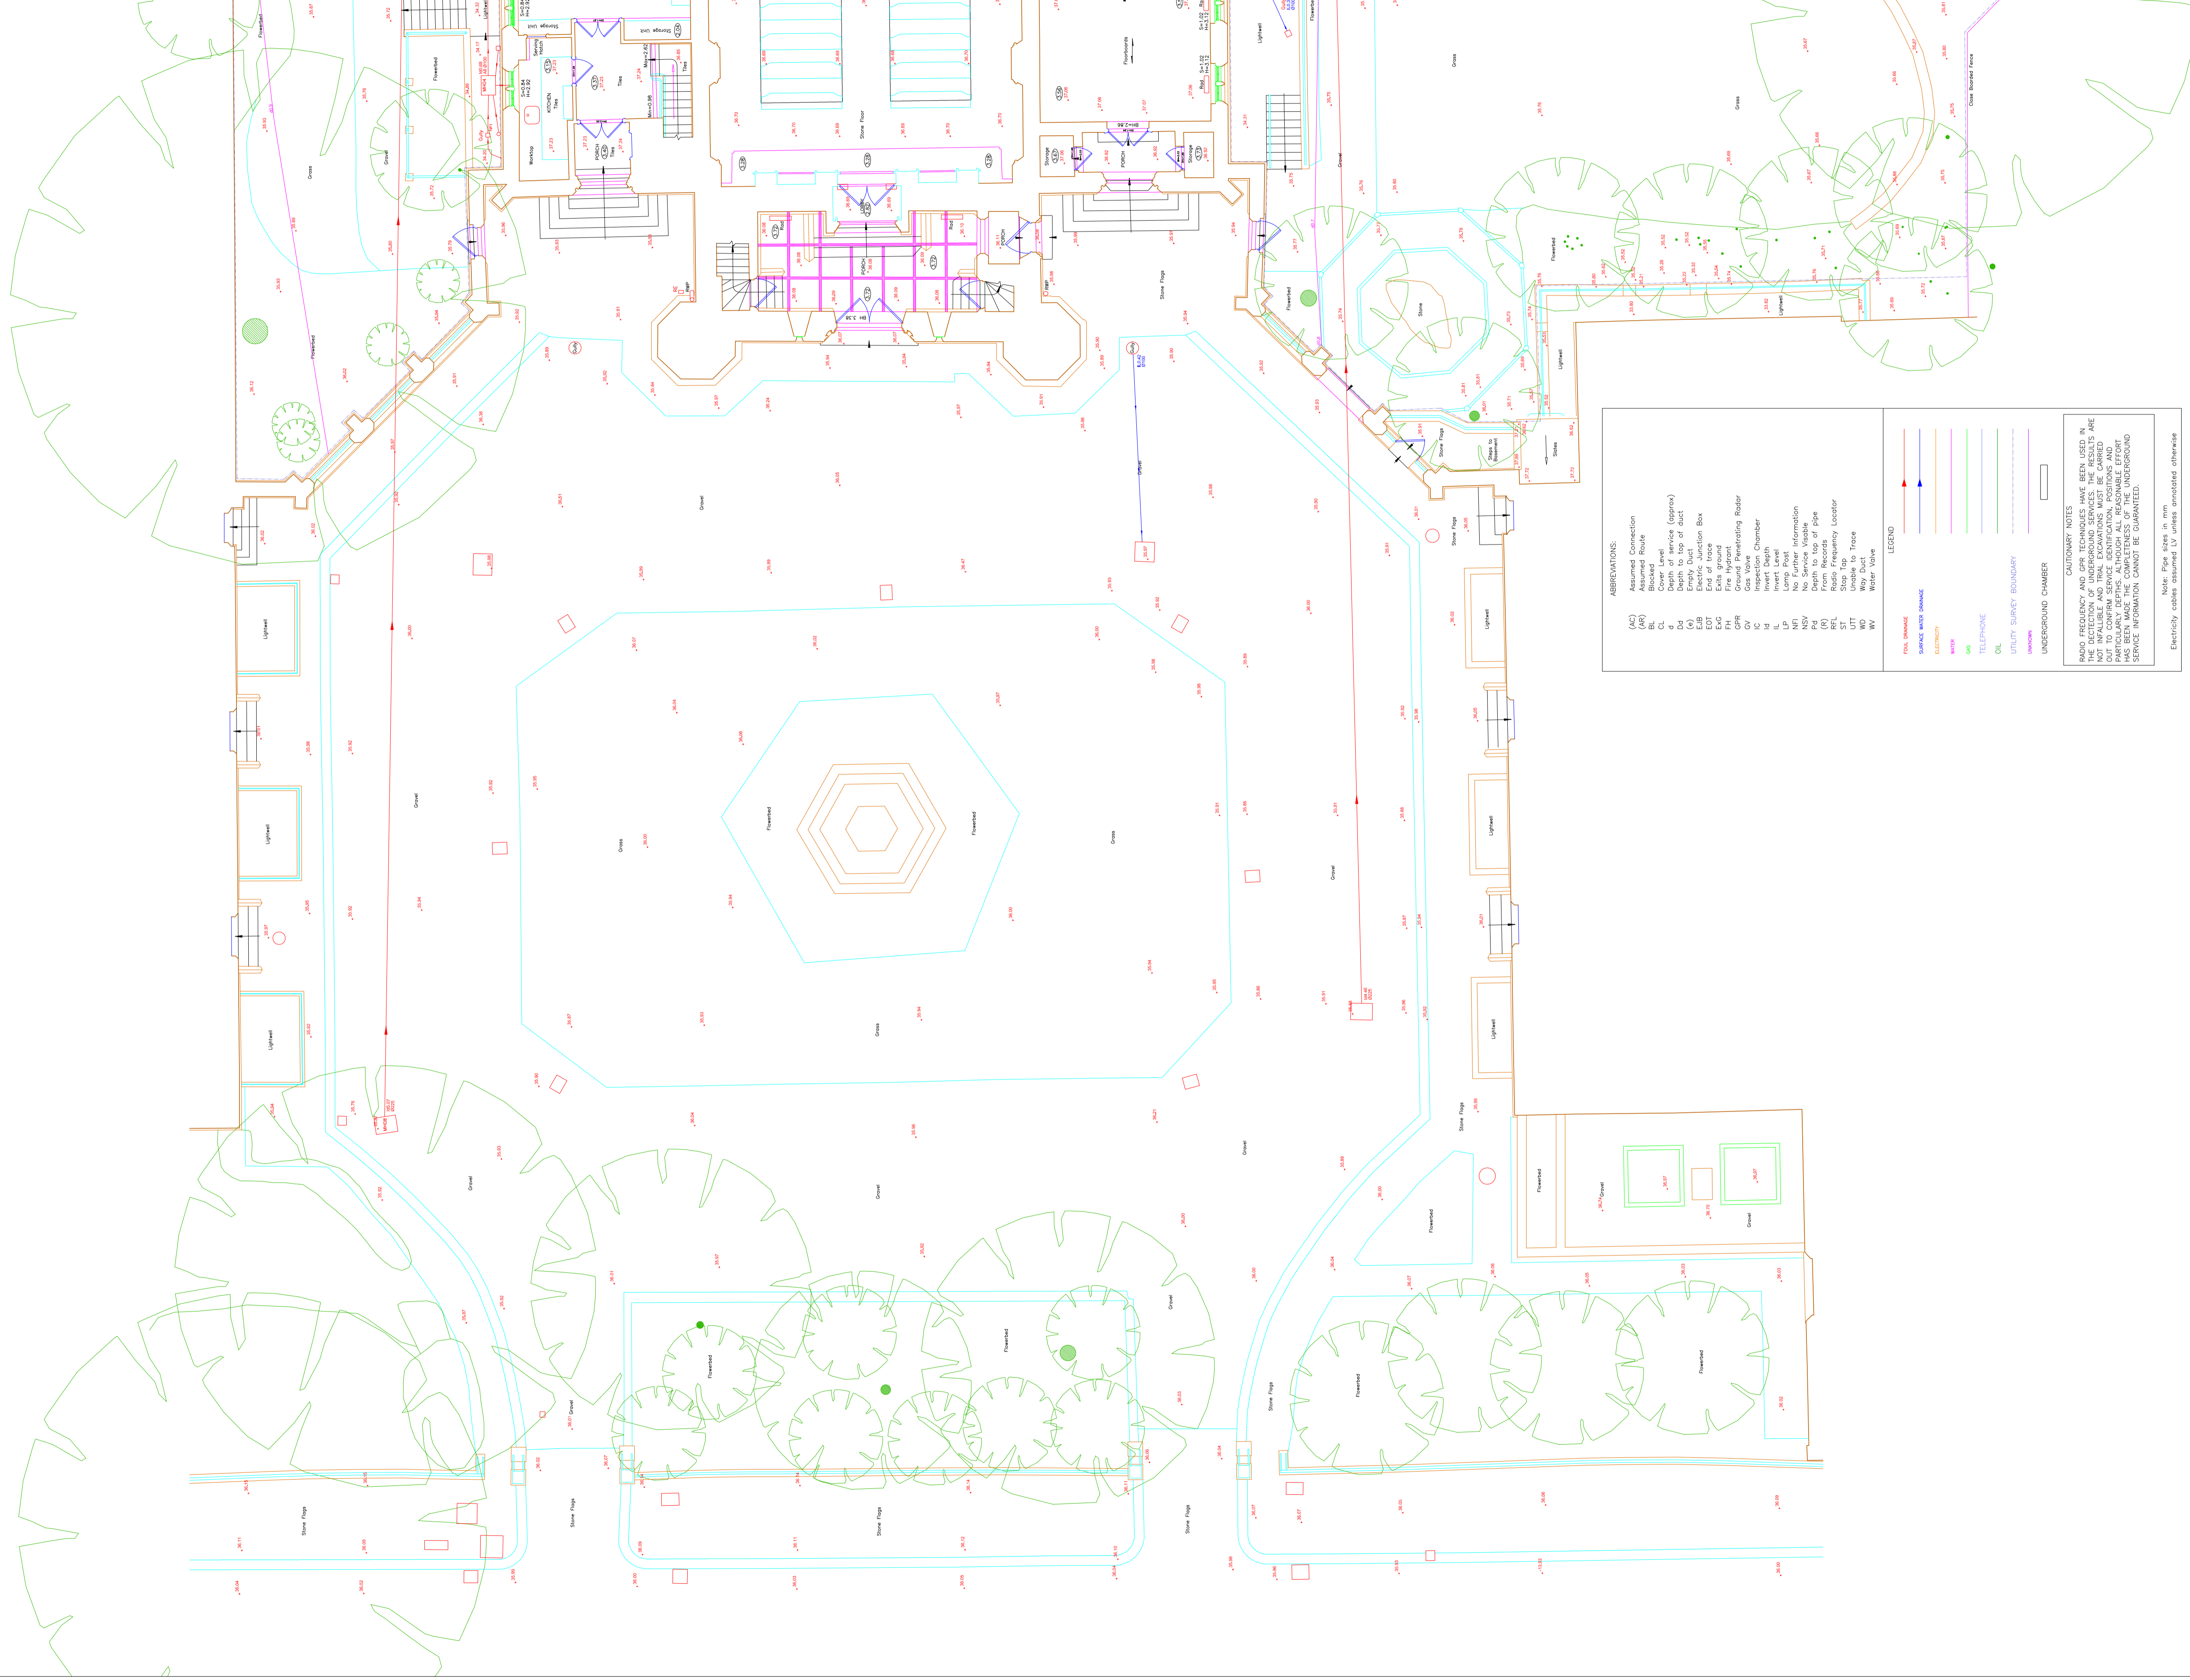

LEGEND

- Red line: MAIN DRAINAGE
- Blue line: DRAINAGE WITH DRAINAGE
- Green line: ELECTRICITY
- Yellow line: GAS
- Orange line: TELEPHONE
- Black line: OIL
- Blue dashed line: UTILITY SURVEY BOUNDARY
- Red dashed line: UNDERGROUND CHAMBER

ABBREVIATIONS:

- (AC) Assumed Connection
- (AS) Assumed Route
- BL Base Level
- d Depth of service (approx)
- Da Depth to top of duct
- Os End of service
- EAB Electric Junction Box
- ECOT End of route
- FH Fire Hydrant
- GPR Ground Penetrating Radar
- IC Inspection Chamber
- id Invert Depth
- Li Lump Point
- LiP Invert
- NET No Further Information
- NR From Records
- PaG Depth to top of pipe
- ST Stop Tap
- UTT Untrace to Trace
- UV Water Valve
- WV

CAUTIONARY NOTES
 THIS SURVEY AND THE INFORMATION CONTAINED HEREIN HAS BEEN OBTAINED BY THE SURVEYOR AND HIS EMPLOYEES BY VISUAL OBSERVATION AND BY THE USE OF SURVEYING INSTRUMENTS. THE SURVEYOR HAS NOT MADE ANY EXCAVATIONS OR TESTS TO VERIFY THE ACCURACY OF THE INFORMATION CONTAINED HEREIN. THE SURVEYOR HAS MADE THE INFORMATION CONTAINED HEREIN AVAILABLE TO YOU FOR YOUR INFORMATION ONLY. THE SURVEYOR HAS MADE THE INFORMATION CONTAINED HEREIN AVAILABLE TO YOU FOR YOUR INFORMATION ONLY. THE SURVEYOR HAS MADE THE INFORMATION CONTAINED HEREIN AVAILABLE TO YOU FOR YOUR INFORMATION ONLY.

Note: Pipe sizes in mm
 Electricity cables assumed LV unless indicated otherwise

