

Rev No	Description	Drawn By	Date
A	ISA & BSA of New Installation	RW	25/05/14
B	Revised Planning and Survey	RW	15/07/14
C	New detailed ground floor and 1000mm safety	CS	28/07/14
D	Finalize report for A. Shawley	CS	01/08/14
E	Finalize report signed	CS	11/08/14

Notes

This drawing represents a performance guide upon which the contractor/subcontractor must base his/her working drawings & details. Include all necessary tolerances prior to manufacture and installation.

Contractor to must undertake a full survey of the area to establish all dimensions & ensure accurate setting out.

Advise on suitability of all details shown to ensure structural stability, ease and economy of construction.

Refer to digital master artwork in regard to all graphic work shown.


AS BUILT

bedrock
 Bedrock Design Consultants Ltd
 2nd Floor, 39 Gold Street, Northampton,
 NN1 1PA
 T 01604 250002
 F 01604 250003
 info@bedrockdesign.co.uk

Client: **Caffe Nero**
 Project: **Holborn**
 Description: **External Seating**

Scale	Drawn by	Date
1:75@A3	CA	23/03/17
Drawing No	Revision	
CN640 - 100	E	

This drawing is the copyright of Bedrock Design Consultants Ltd. This drawing cannot be copied, reproduced, related or disclosed to any person without prior permission in writing from the design.

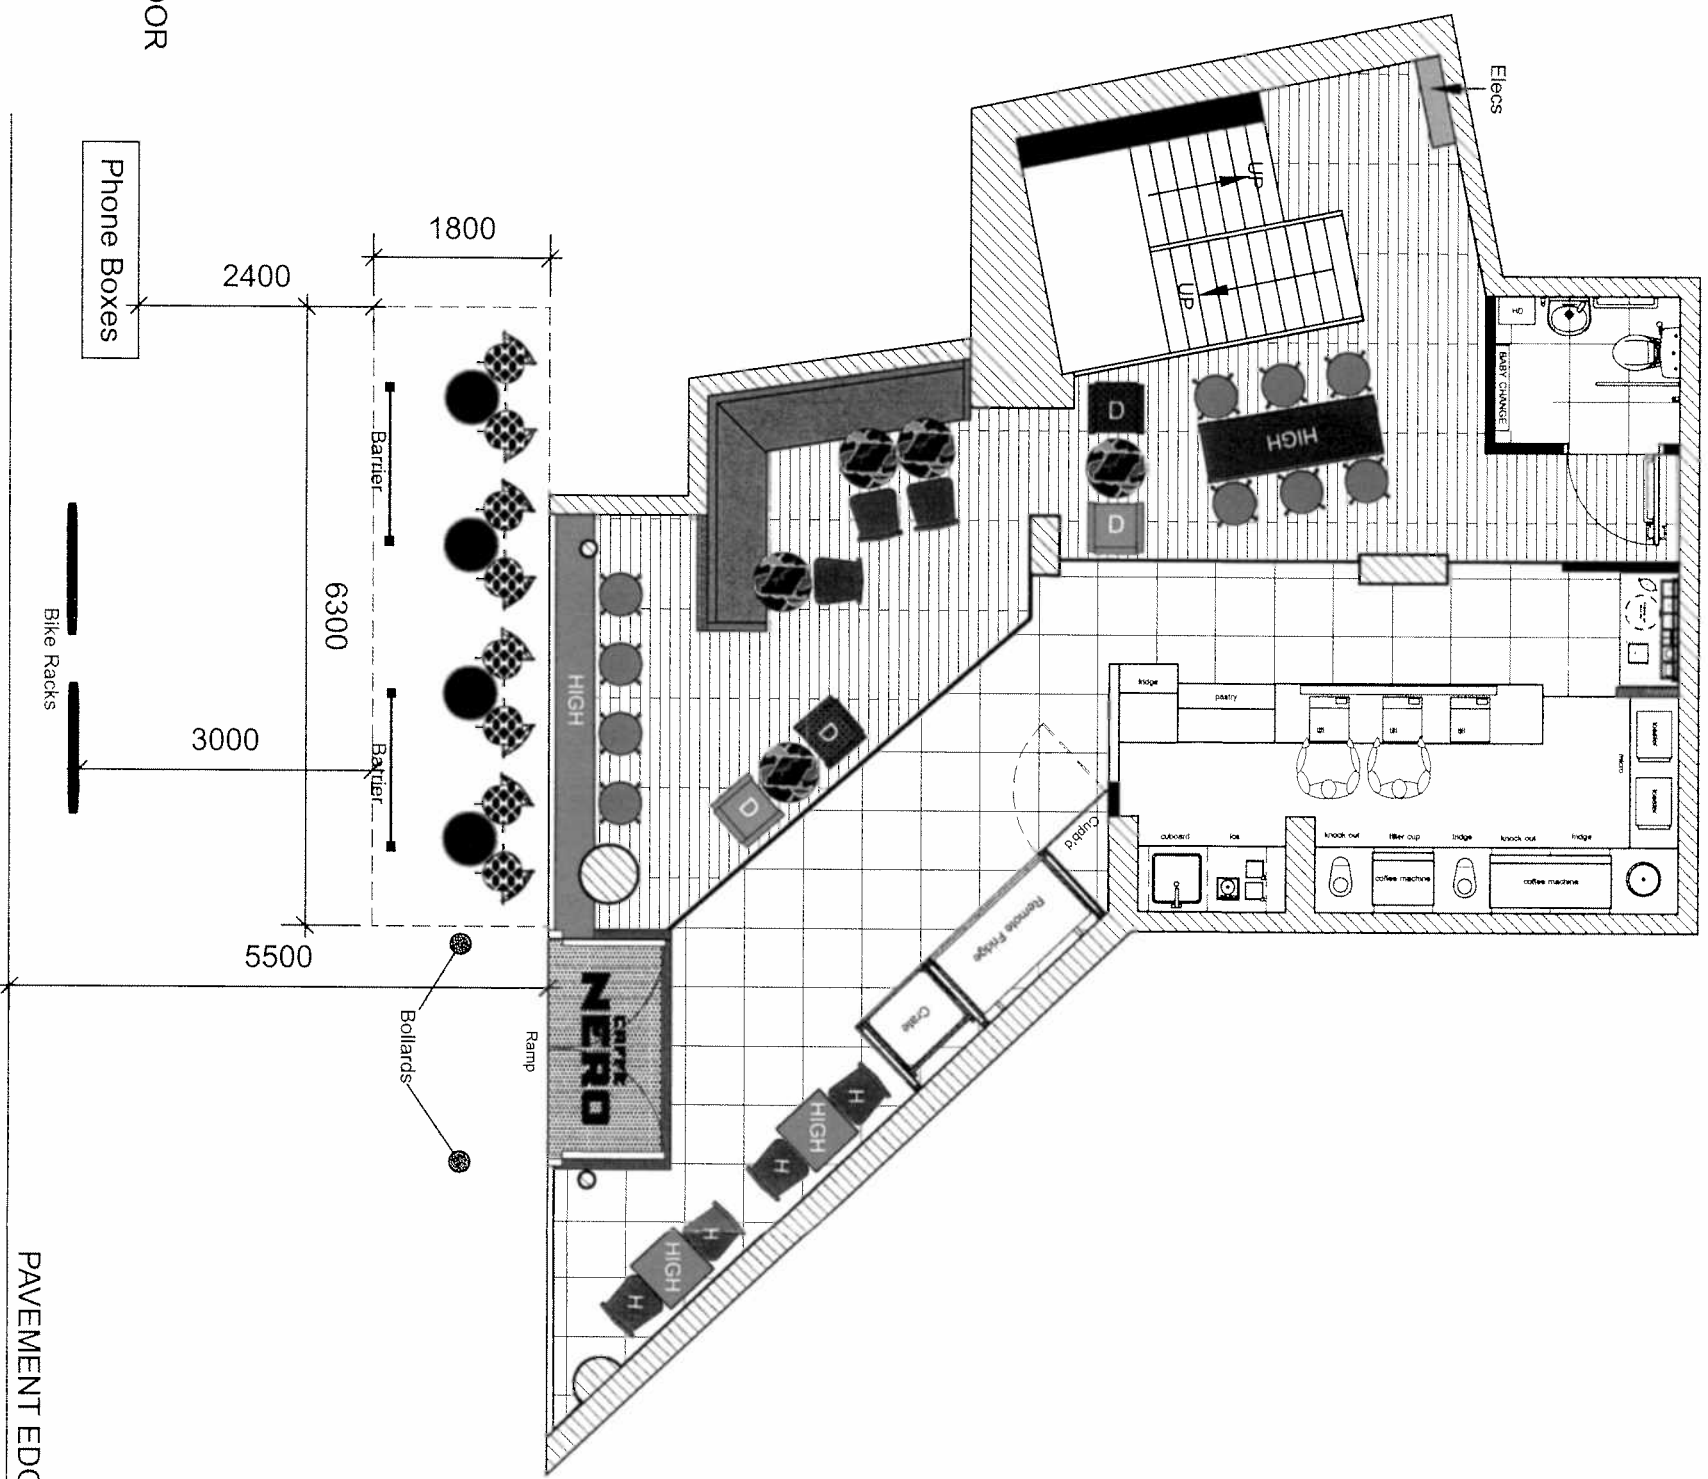

GROUND FLOOR
 24 Seats

PAVEMENT EDGE