

NOTES:

The drawing must not be scaled and all dimensions are to be checked on site before work is commenced.
The drawing is to be read in conjunction with all other Structural Engineers and Service Engineers drawings and written specifications.

SPECIFICATIONS:

REVISION

N	DATE	NOTES
1	20.09.16	HEIGHT OF END PART OF EXTENSION REDUCED
2	02.12.16	PROJECTION OF EXTENSION REDUCED

PROJECT:
LANCASTER GROVE


DRAWING N:
LG-A-PP-PP002-B

- PRELIMINARY
- PLANNING APPROVAL
- CONSTRUCTION
- DESIGN INFORMATION
- TENDER
- AS BUILT

DRAWING:
PROPOSED FIRST FLOOR/ROOFS EXTENSION PLAN
DRAINAGE

CLIENT: Mr & Mrs Silver

LOCATION: 45 Lancaster Grove, NW3 4HB

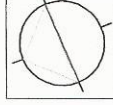

DATE: 30.06.15


SCALE: 1:100 @A3

REV: 1

PROJECT DESIGNER:

120 Fortune Green Road
NW6 1DN / London
t. 0207 4355008

DESIGNER:
Marco Ferrara-Bardile
marco@rmfstudio.com
t. 0797 5644556

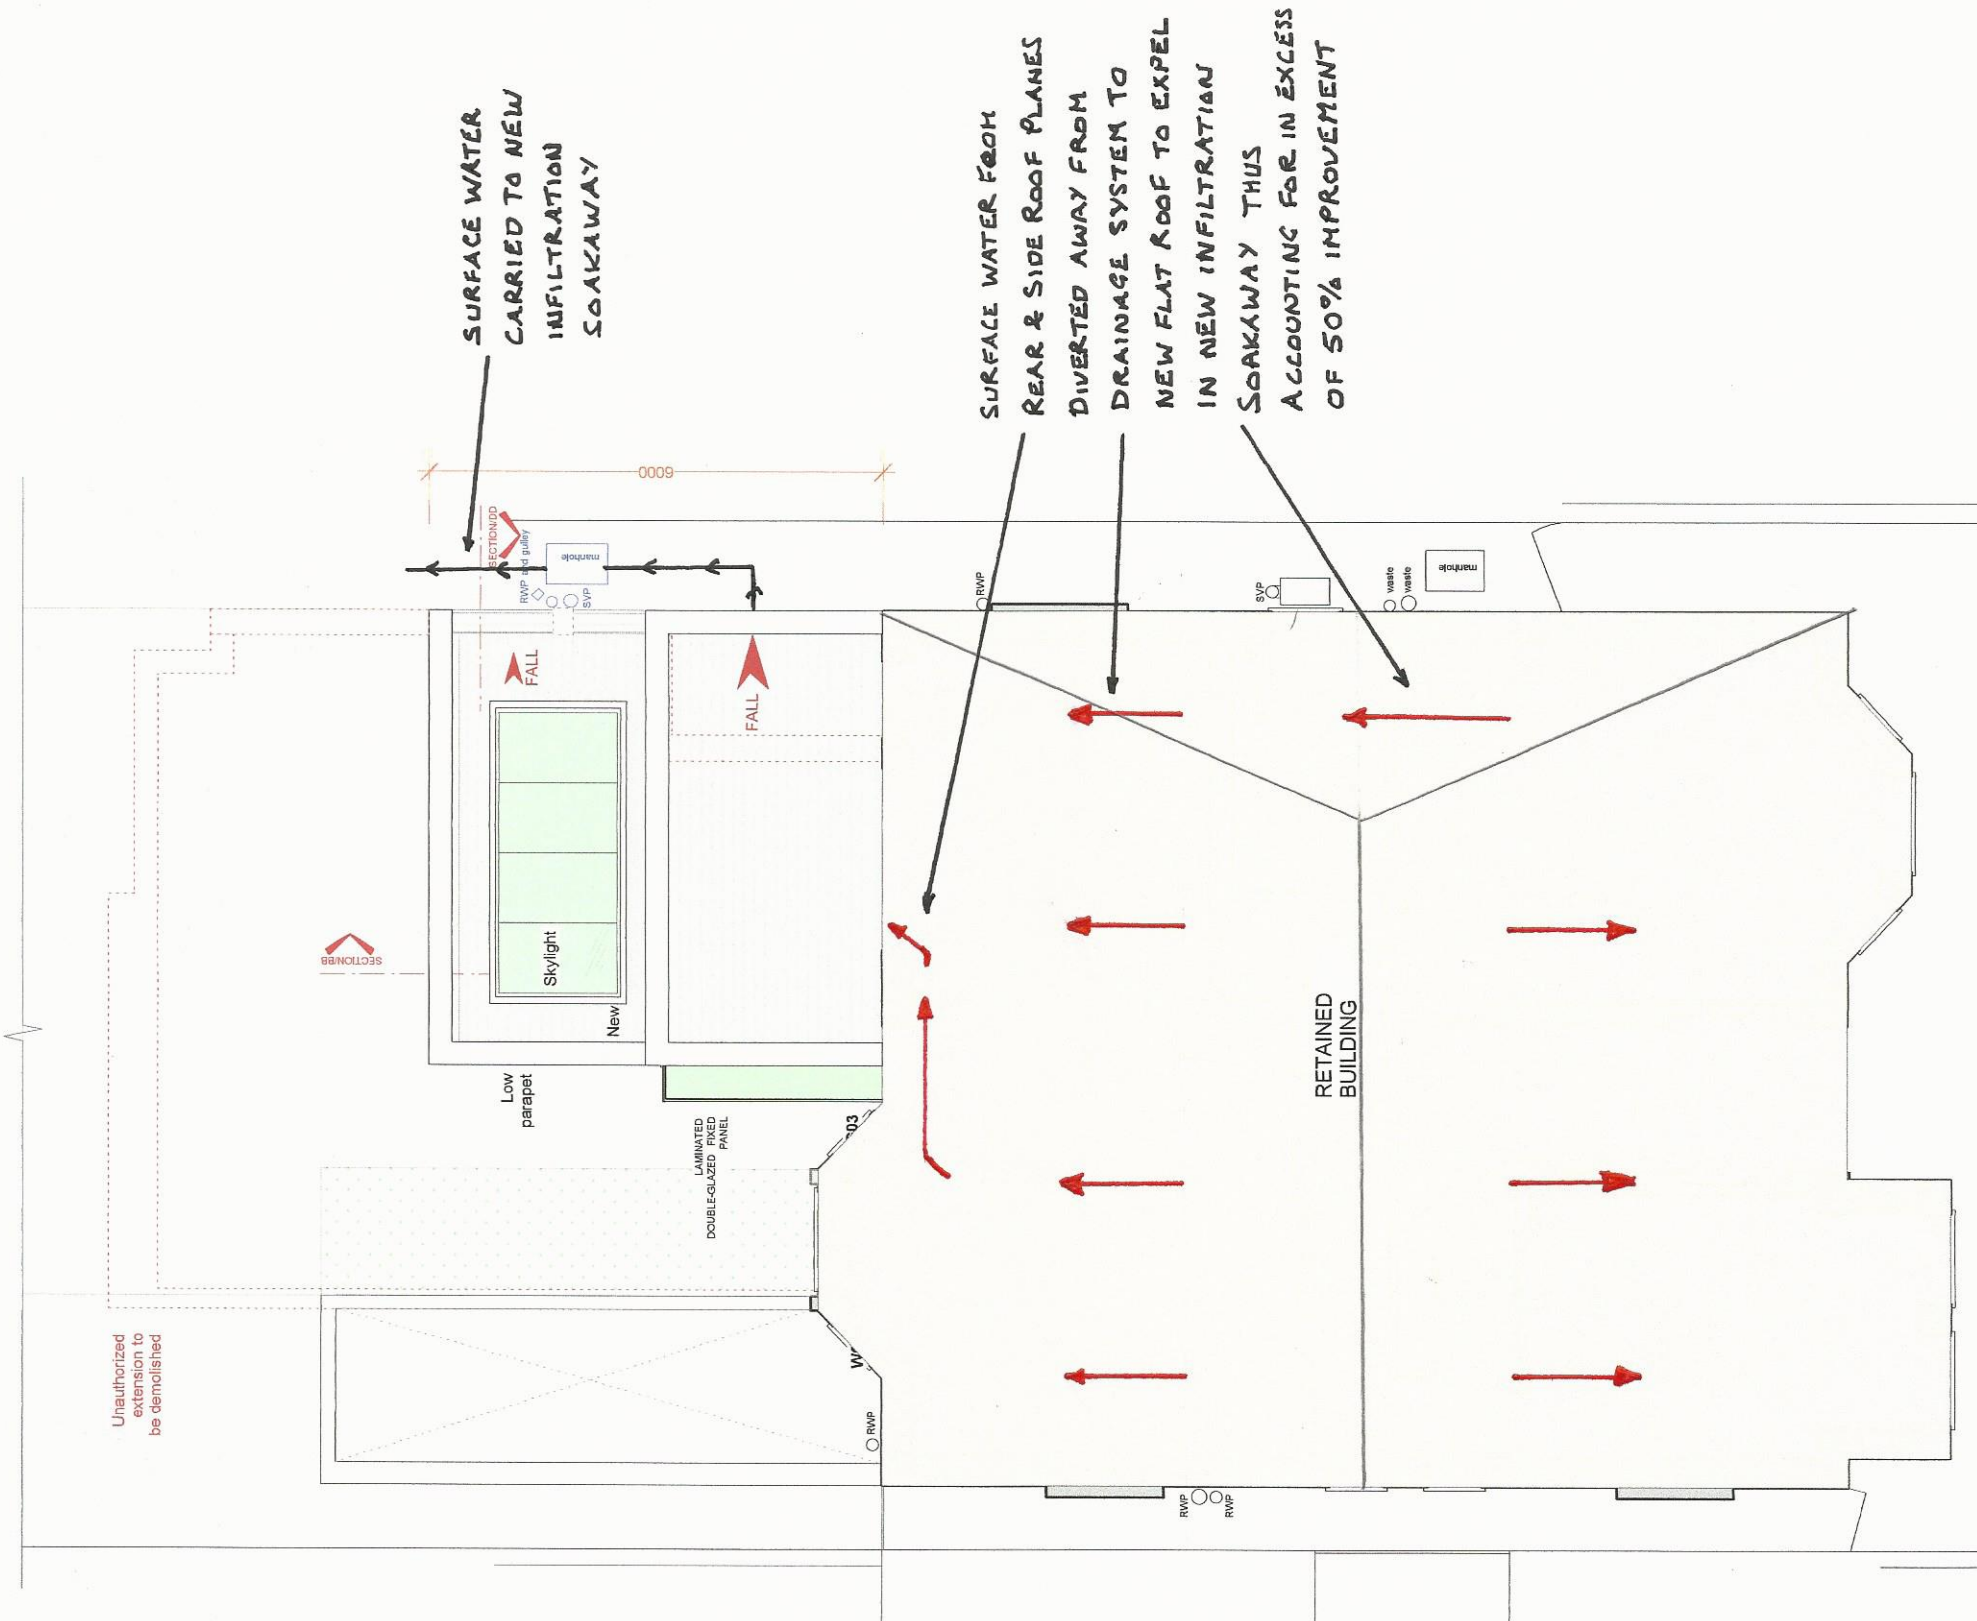

SURFACE WATER CARRIED TO NEW INFILTRATION SOAKAWAY

SURFACE WATER FROM REAR & SIDE ROOF PLANES DIVERTED AWAY FROM DRAINAGE SYSTEM TO NEW FLAT ROOF TO EXPEL IN NEW INFILTRATION SOAKAWAY THUS ACCOUNTING FOR IN EXCESS OF 50% IMPROVEMENT

3 LANCASTER GROVE-PROPOSED/ROOF PLAN
Scale: 1:100