

**NOTES:**

The drawing must not be scaled and all dimensions are to be checked on site before work is commenced.  
 The drawing is to be read in conjunction with all other Structural Engineers and Service Engineers drawings and written specifications.

**SPECIFICATIONS:**

**REVISION**

| N | DATE     | NOTES                                   |
|---|----------|---|
| 1 | 20.09.16 | HEIGHT OF END PART OF EXTENSION REDUCED |
| 2 | 02.12.16 | PROJECTION OF EXTENSION REDUCED         |

**PROJECT:**  
LANCASTER GROVE


**DRAWING N:**  
LG-A-PP-EL001-A

**DRAWING:**  
**PROPOSED REAR ELEVATION DRAINAGE**

- PRELIMINARY
- PLANNING APPROVAL
- CONSTRUCTION
- DESIGN INFORMATION
- TENDER
- AS BUILT

**CLIENT:** Mr & Mrs Silver

**LOCATION:** 45 Lancaster Grove, NW3 4HB

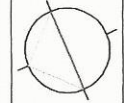


**DATE:** 22.04.15  
**SCALE:** 1:100 @A3  
**REV:** 2

**PROJECT DESIGNER:**



120 Fortune Green Road  
 NW6 1DN / London  
 t. 0207 4355008  
**DESIGNER:**  
 Marco Ferrara-Bardile  
 marco@rmfstudio.com  
 t. 0797 5644556

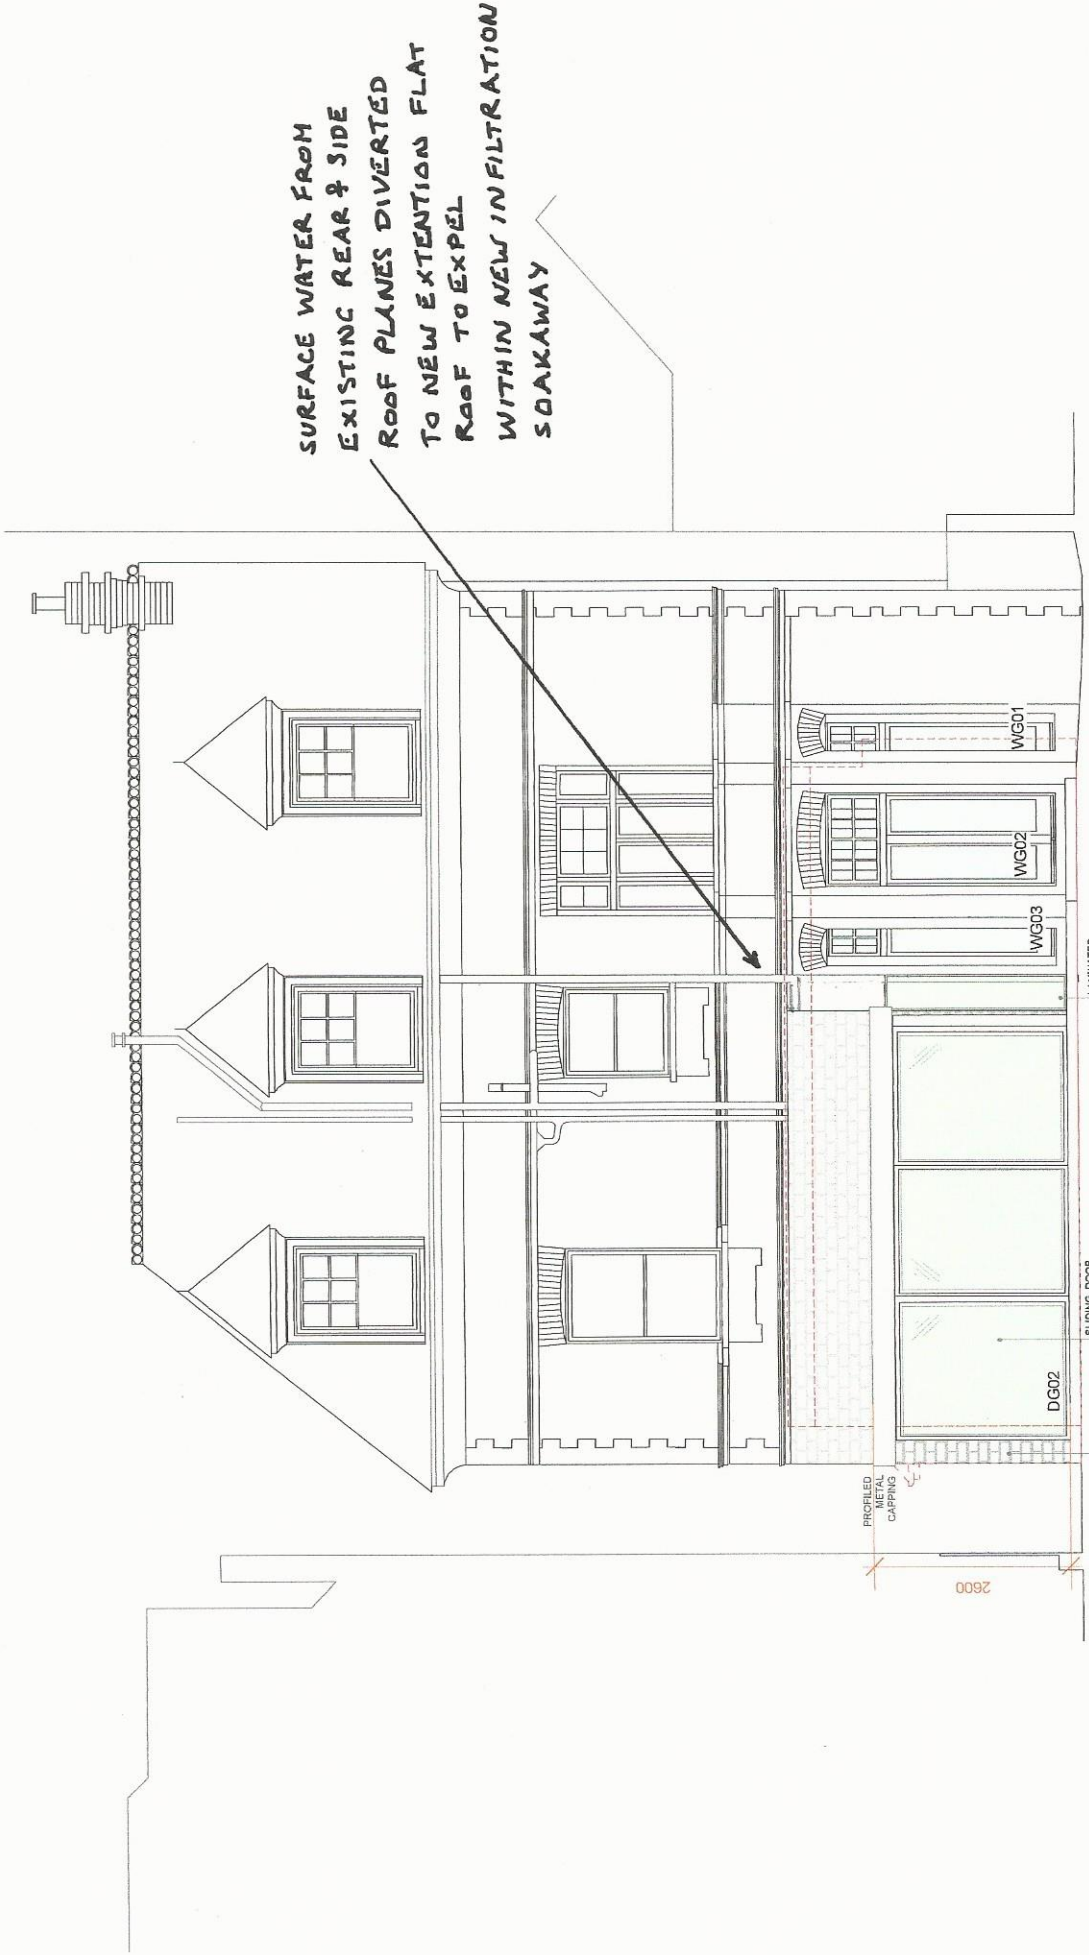

**4 LANCASTER GROVE-PROPOSED/ REAR ELEVATION**  
 Scale: 1:100