

NOTES  
1. DO NOT SCALE FROM THIS DRAWING  
2. ALL DIMENSIONS IN MILLIMETRES  
UNLESS OTHERWISE STATED

LEGEND	
BL	Base Level
CI	Cast Iron
CL	Cover Level
G	Gully
IL	Invert Level
MH	Manhole
PF	Pitch Fibre
RG	Road Gully
RWP	Rain Water Pipe
SA	Survey Abandoned
STG	Solid Top Gully
SVP	Soil Vent pipe
uPVC	Polyvinyl Chloride
UTL	Unable To Locate
UTR	Unable To Raise
UTT	Unable To Trace
VC	Vitrified Clay
— Foul Water	
— Surface water	
--- Assumed Runs	


REV BY APP DATE



12-16 David Road, Poyle Trading Estate, Colnbrook, SL3 ODG t: 01753 810999  
esolutions@ukdnwaterflow.co.uk www.ukdnwaterflow.co.uk

CLIENT  
ENGENUITI  
3B MALTINGS PLACE  
TOWER BRIDGE ROAD  
LONDON  
SE1 3JB


PROJECT  
ST GILES CIRCUS  
BOOK MEWS  
LONDON

DRAWING TITLE  
UND PLAN  
879-C-SK009a  
St Giles Zone 3  
Drainage to be abandoned  
markups  
JW 20/10/2017

SCALE		1:100	
SURVEYED	T BAAR	DRAWN	T BAAR
DATE	MAY 2014	APPROVED	R JONES
JOB No.	42589	PLOTTED	A I
DRAWING No.			

CAD 62619-3



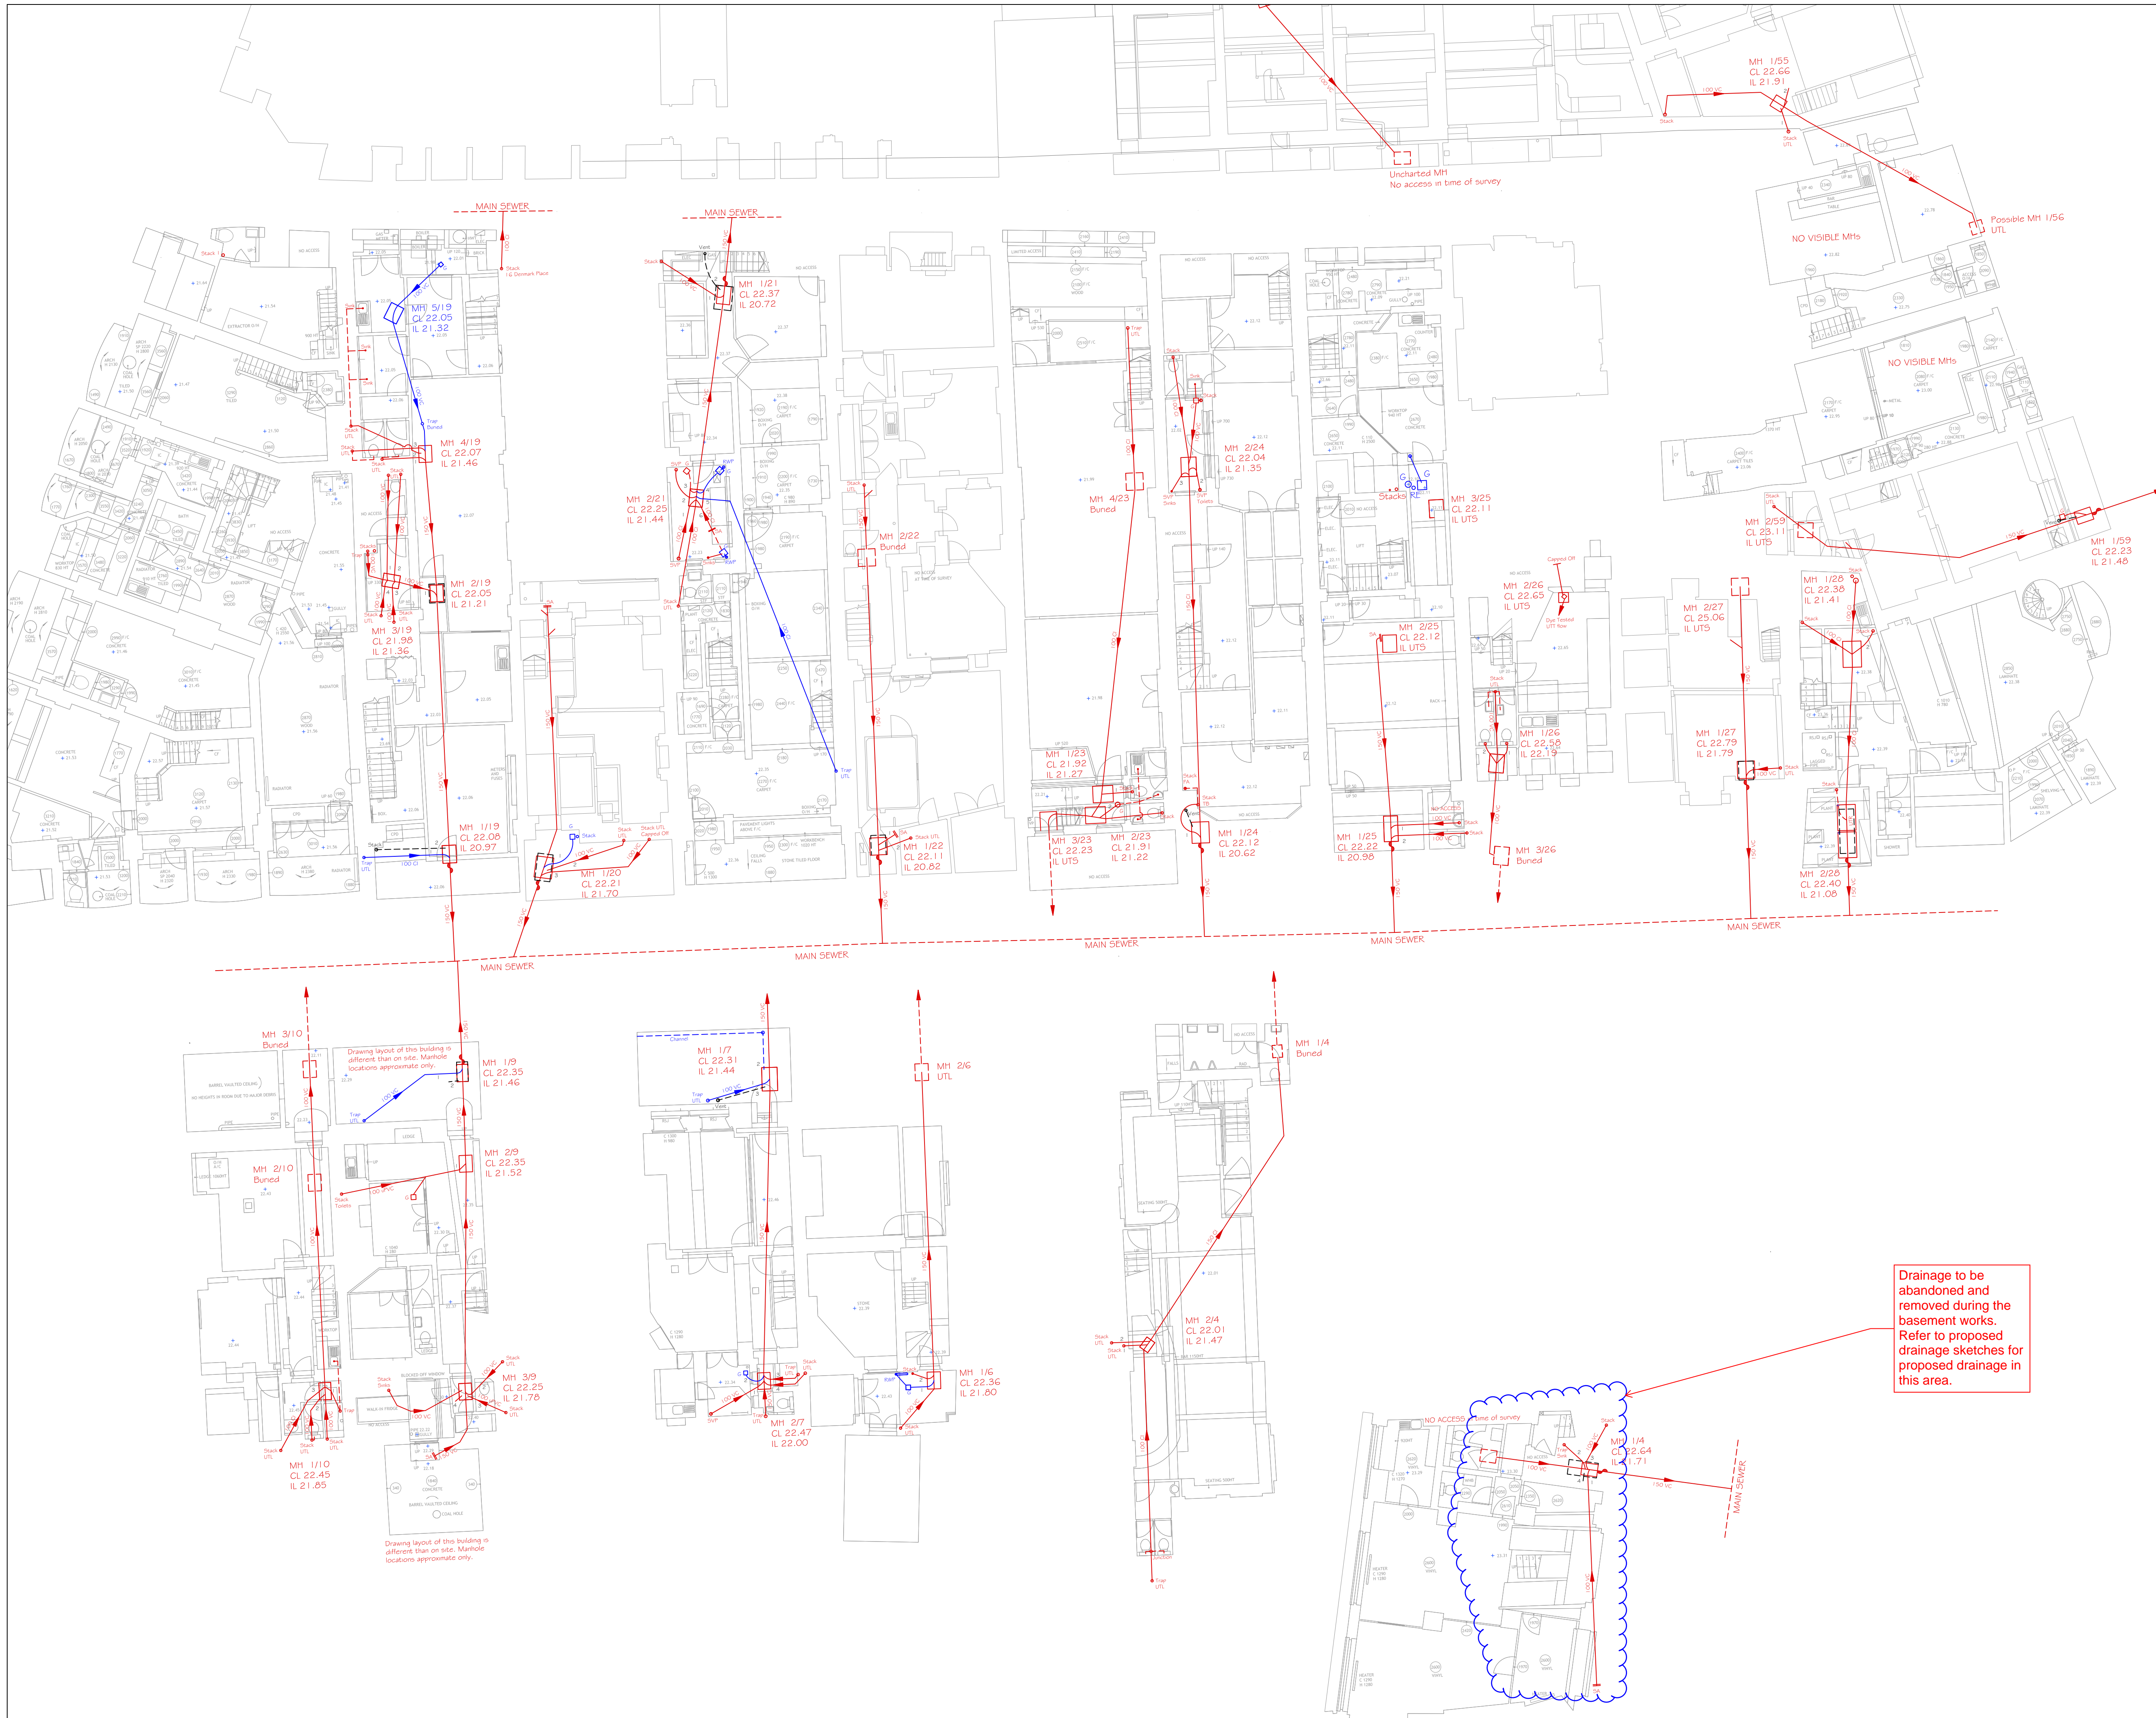

NOTES  
1. DO NOT SCALE FROM THIS DRAWING  
2. ALL DIMENSIONS IN MILLIMETRES  
UNLESS OTHERWISE STATED

LEGEND	
BL	Base Level
CI	Cast Iron
CL	Cover Level
G	Gully
IL	Invert Level
MH	Manhole
PF	Pitch Fibre
RG	Road Gully
RWP	Rain Water Pipe
SA	Survey Abandoned
STG	Solid Top Gully
SVP	Soil Vent pipe
uPVC	Polyvinyl Chloride
UTL	Unable To Locate
UTR	Unable To Raise
UTT	Unable To Trace
VC	Vitrified Clay
— Foul Water	
— Surface water	
--- Assumed Runs	


REV BY APP DATE



12-16 David Road, Poyle Trading Estate, Colnbrook, SL3 0DG t: 01753 810999  
esolutions@ukdnwaterflow.co.uk www.ukdnwaterflow.co.uk

CLIENT  
ENGENUITI  
3B MALTINGS PLACE  
TOWER BRIDGE ROAD  
LONDON  
SE1 3JB

PROJECT  
ST GILES CIRCUS  
DENMARK STREET AND DENMARK PLACE  
LONDON

DRAWING TITLE  
UND 879-C-SK009b  
St Giles Zone 3  
Drainage to be abandoned  
markups  
JW 20/10/2017  
PLAN

SCALE		1:100	
SURVEYED	T BAAR	DRAWN	T BAAR
DATE	MAY 2014	APPROVED	R JONES
JOB No.	42589	PLOTTED	A I
DRAWING No.			