



ENTRANCE COURTYARD: PLAN

Scale 1:50 @ A1, 1:100 @ A3

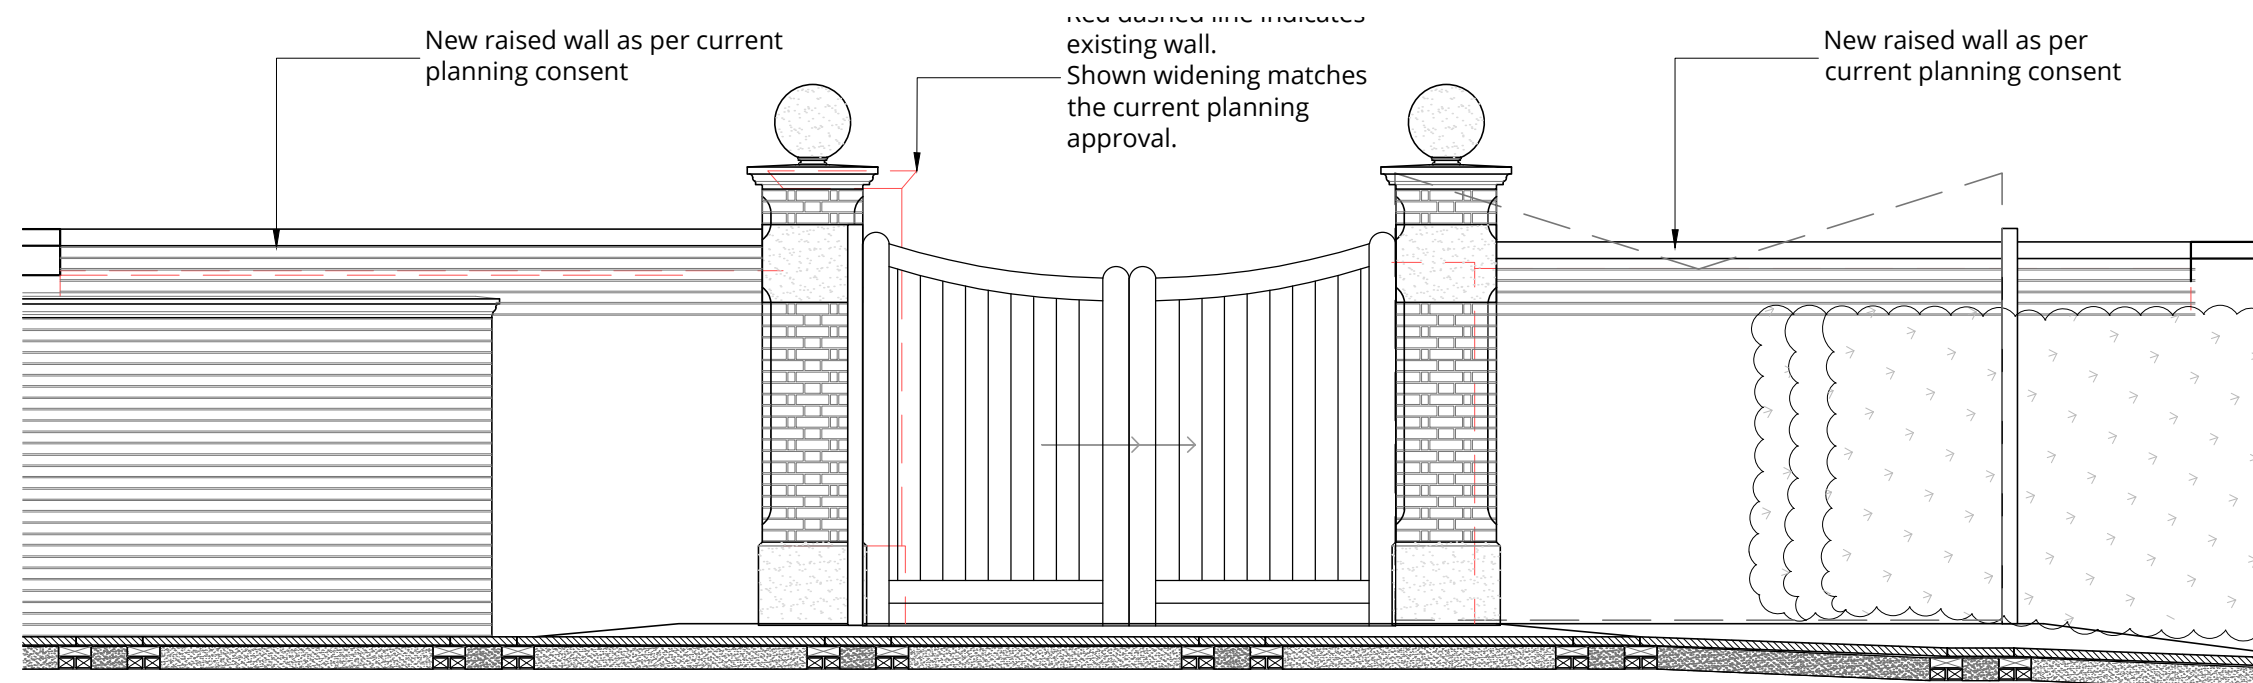

INTERNAL ELEVATION

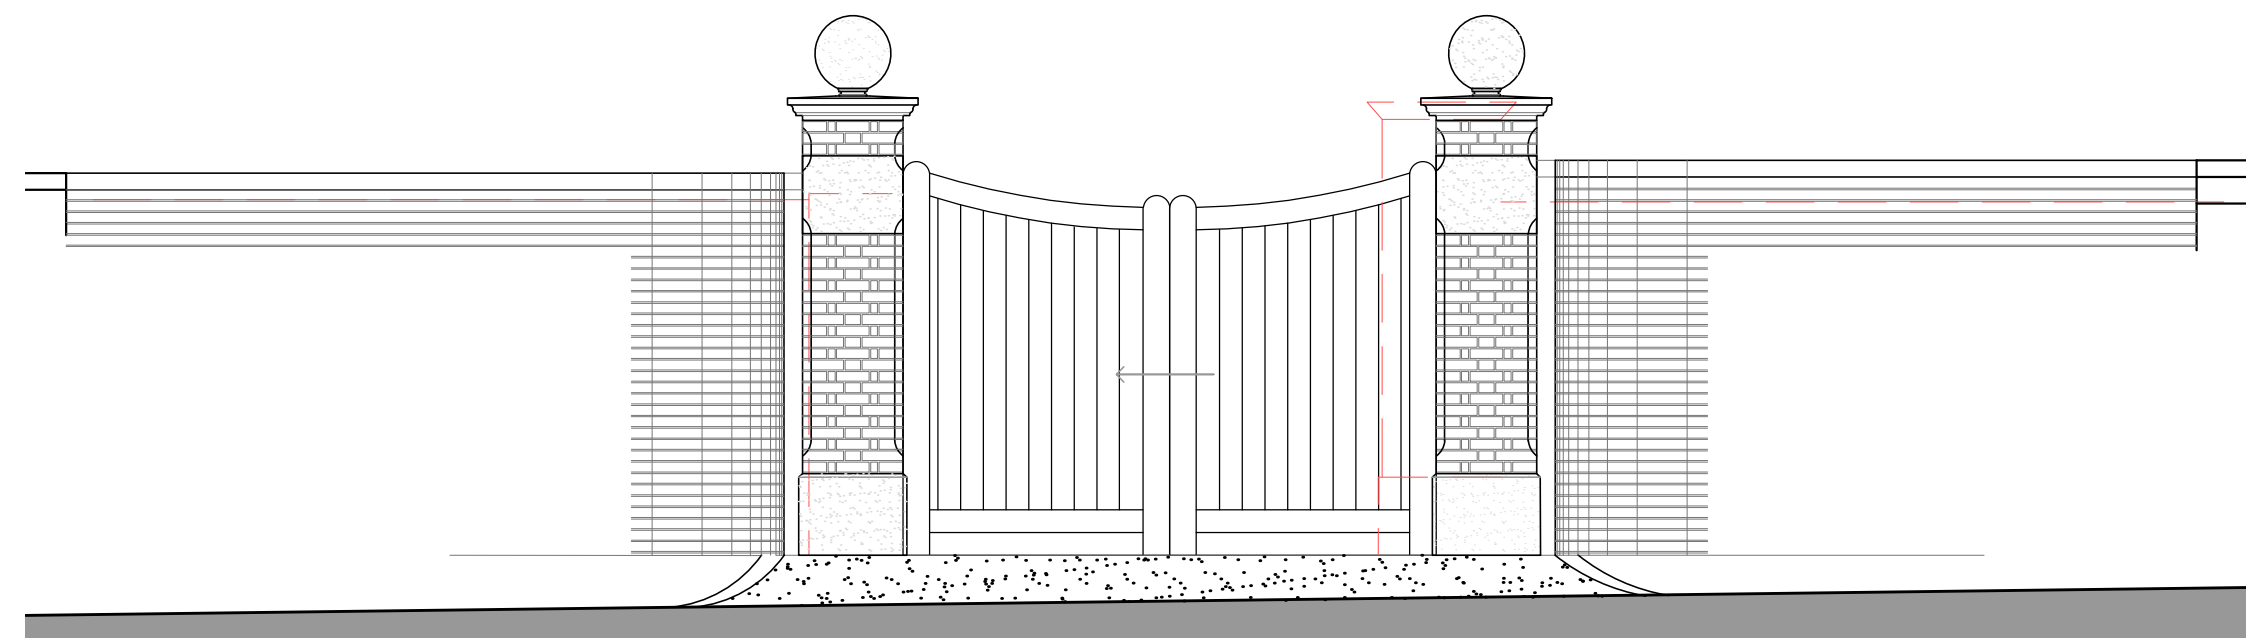

EXTERNAL ELEVATION

w o l f f
ARCHITECTS

16 lambton place
notting hill
london w11 2sh
t +1 020722393125
fax 020722293357
info@wolffarchitects.co.uk

This drawing is prepared under copyright and all
rights are reserved. No part of this drawing may
be reproduced or stored in a retrieval system
without the written permission of the
Architect. (Design Copyright Act 1988)

This drawing may not be used for purposes other
than that for which it is provided. It is supplied
without liability for accuracy or omission.

Drawings only to be used for planning application
purpose. All dimensions to be checked on site. All
drawings subject to planning authority approval.

REV
O FIRST ISSUE
A Updated details
B Proposed entrance gates
C Red Line
D Elevations
E Front Entrance Re-design

DATE
10.11.14
05.10.17
15.01.18
23.01.18
24.01.18
30.05.18

0 2 4 m
1:50 @ A1
1:100 @ A3

REV
O FIRST ISSUE
A Updated details
B Proposed entrance gates
C Red Line
D Elevations
E Front Entrance Re-design

DATE
10.11.14
05.10.17
15.01.18
23.01.18
24.01.18
30.05.18

STATUS
PLANNING STAGE

PROJECT
Heath Park, Hampstead
London, NW3 7ET

DATE
10.11.14

SCALE
1:50/1:100

DWG NO.
1204-PL-352

DRAWING TITLE
Entrance courtyard:
Plan

REV NO.
E