



Appendix F

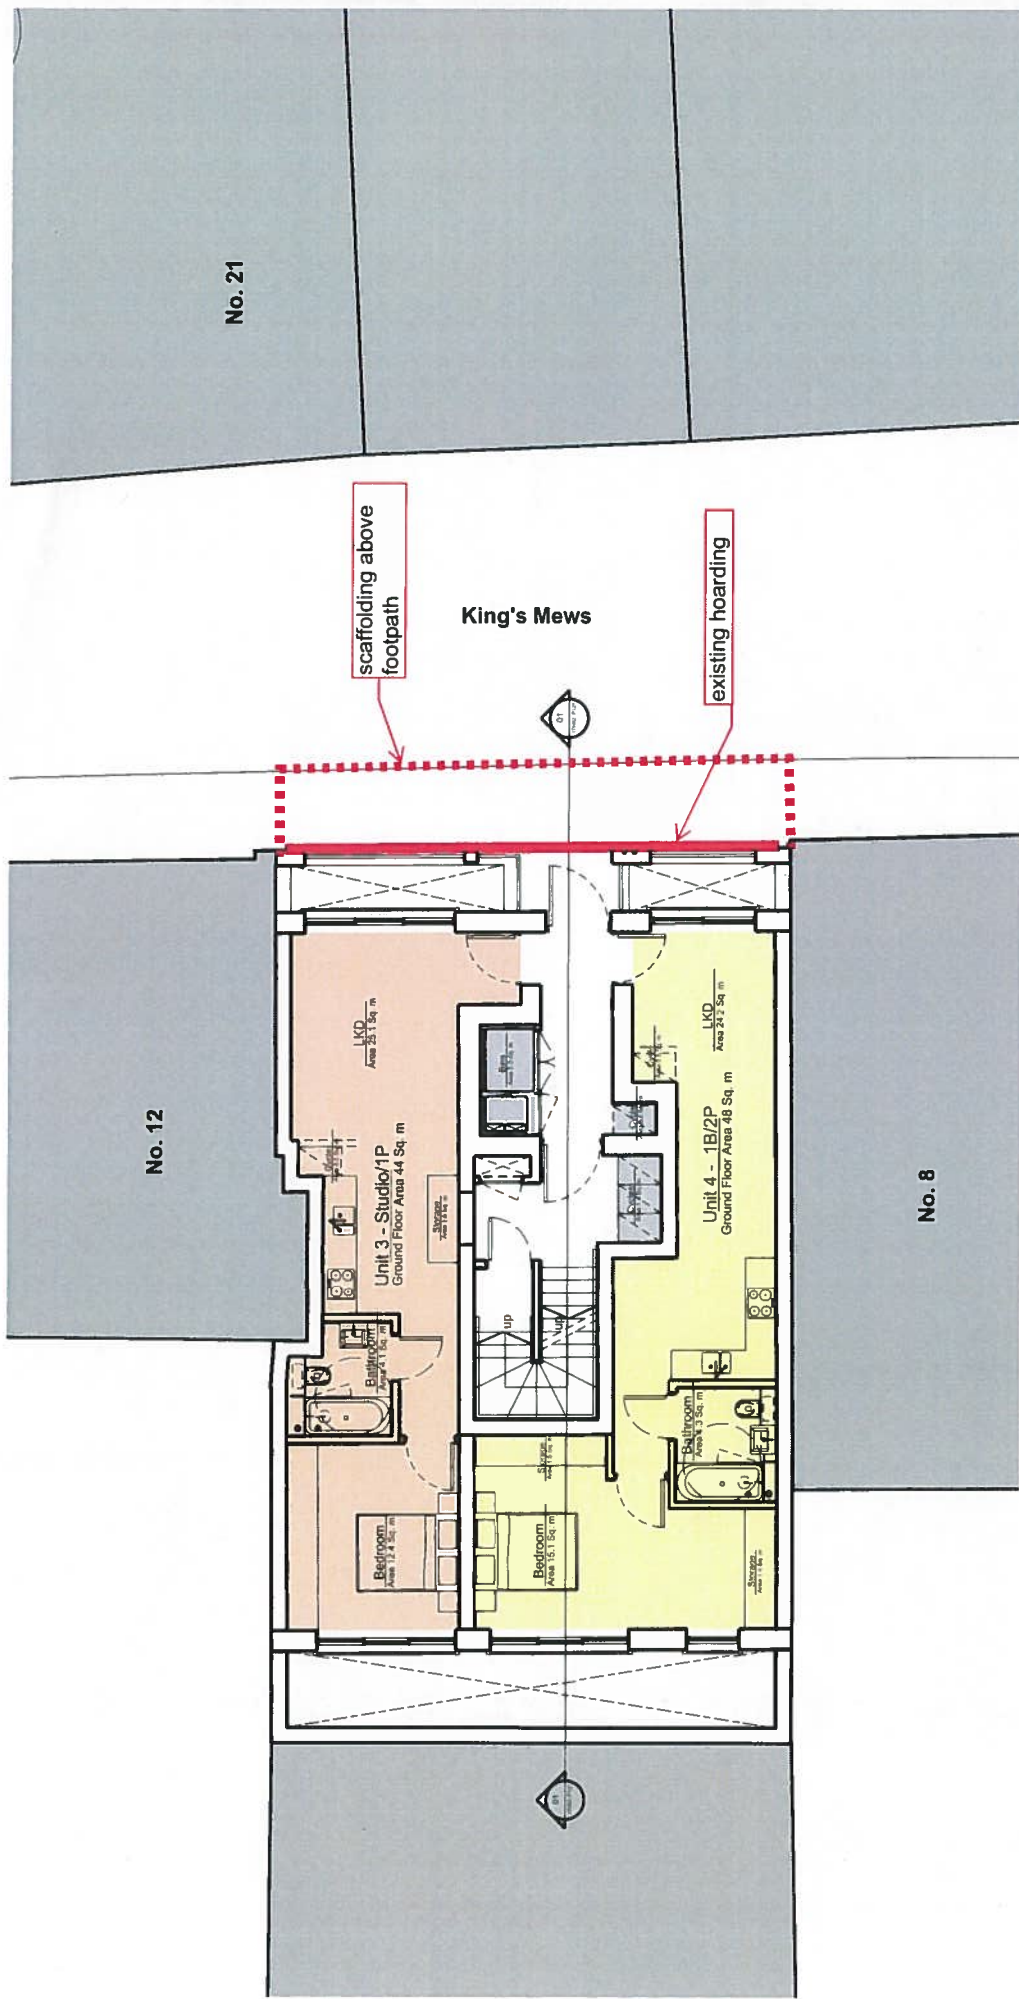


01 Ground Floor Plan
JTH02_P100 SCALE 1:100@A3

Temporary Structures

General Notes: This drawing is copyright of Matthew Alchurch Architects Limited	 the boothouse design studio 27 ferry road teddington tw11 9nn t: 020 8973 0050 e: info@maa-architects.com w: www.maa-architects.com	Client: Barrios Developments Ltd. Project Name: 10-11 King's Mews Drawing Title: Ground Floor Plan Project No: JTH02 Drawing No: P100 Revision: P01 Scale: 1:100 @ A3 Date: 04.08.17 Status: Planning Drawn By: JGW Checked By: VP Date: 04.08.17 Rev: P01 Issue for planning Description:
---	--	---

Outline of Approved Planning Application 20126315/P

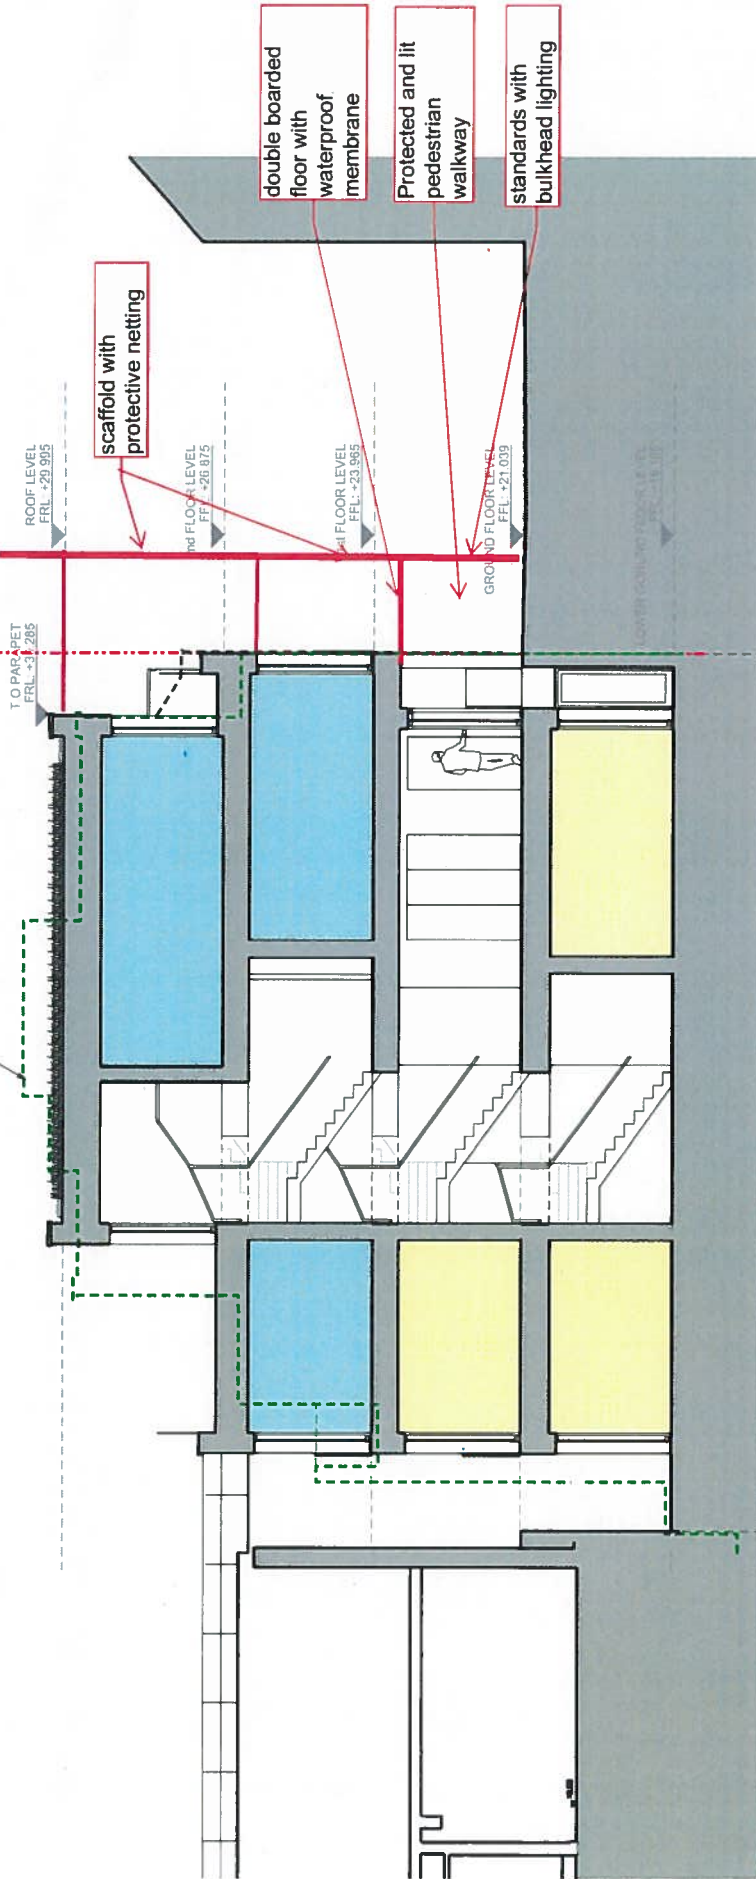

01 Proposed Section A - A

SCALE 1:100@A3

Scaffold markup

General Notes:

This drawing is copyright of Matthew Alchurch Architects Limited



License No. 0132015390

Scale:

A3



P01 Issue for planning
Rev: Description:

04.08.17 JGW MA
Date Dm by: Cld by:

Client:

Barrios Developments Ltd.

Project Name:

10-11 King's Mews

Drawing Title:

Proposed Section A - A

Project No:

JTH02

Drawn By:

JGW

Checked By:

VP

Status:

Planning

Revision:

P01

Scale:

1:100 @ A3

Date:

04.08.17

MAA Architects

the boothouse design studio
27 ferry road teddington tw11 9nn
t: 020 8873 0050
e: info@maa-architects.com
w: www.maa-architects.com