



LOWER GROUND FLOOR PLAN - (AS PROPOSED)
 (EXTRACT FROM SAPP 566-02C)

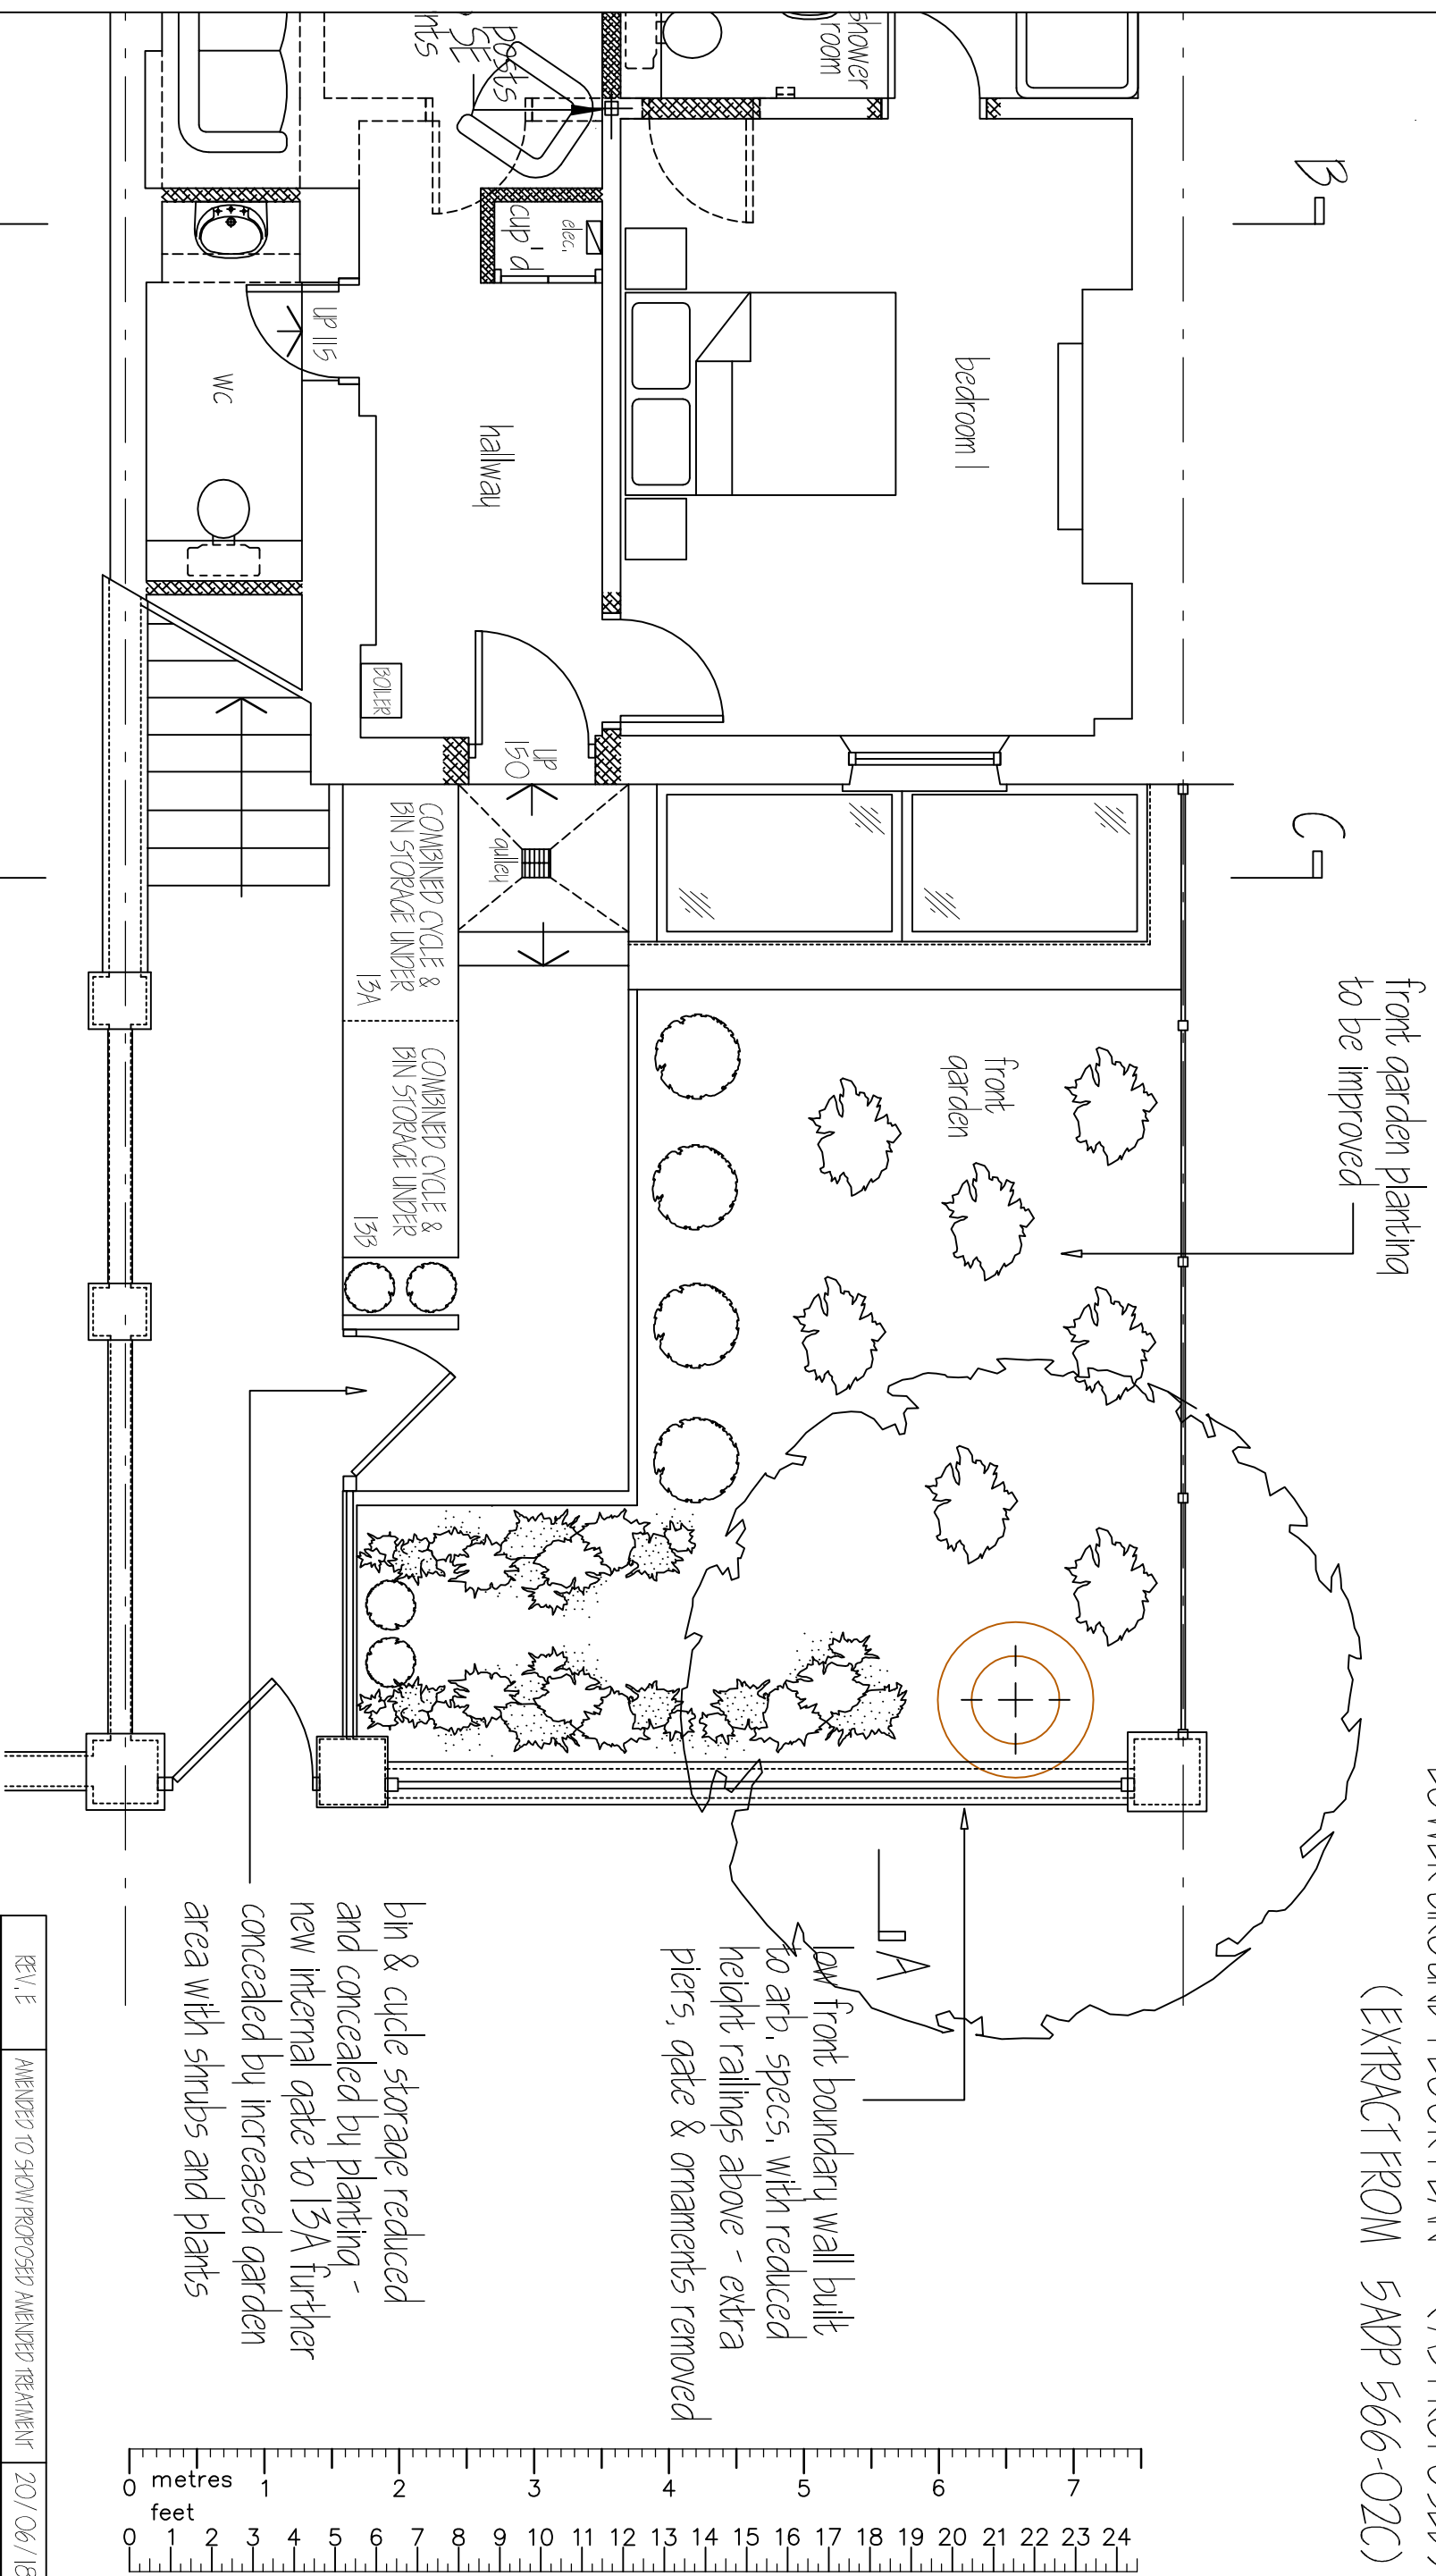

bin & cycle storage reduced and concealed by planting - new internal gate to 15A further concealed by increased garden area with shrubs and plants

low front boundary wall built to arb. specs. with reduced height railings above - extra piers, gate & ornaments removed

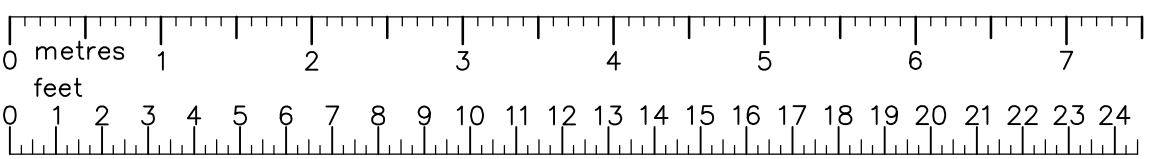

REV. E	AMENDED TO SHOW PROPOSED AMENDED TREATMENT	20/06/18
REV. D	AMENDED TO SHOW BOUNDARY TREATMENT AS BUILT	22/09/17
REV. C	AMENDED AS PER PLANNING CONCERNS	09/12/15
REV. B	AMENDMENTS AS PER CLIENT REQUIREMENTS	05/09/15

Drawing Title: **PROPOSED PLAN**

Scale: 1:50 @ A5
 Date: June 2018
 Drawing No.: SAPP 566-02E SHEET 1 OF 3

Client: Mr. K. Lalwal

Project: 13 St. Augustines Road
 Camden, London
 NW1 9RL

Matthew J. Scholes
 5 Arches Design & Planning
 50 Oak Road, Ginton
 Peterborough - PE6 7LD
 Tel. 07788 721 131
 mgscholes@hotmail.com