


STANWAY LITTLE ASSOCIATES
 CHARTERED TOWN PLANNERS CHARTERED ARCHITECTS
 The Studios 72 Ruskin Walk London SE24 9LZ
 Tel 0207 733 1106 Email peterstanway@peterstanway.com

Project 32 Burghley Road London NW5 1UE


Dwg. Title As built as at January 2018 Job No. 1975
 Scale 1:100 @ A2 Date January 2018 Dwg. No. AB 1A

Rev A June 2018 minor revisions removing double line and increasing width of brick pier

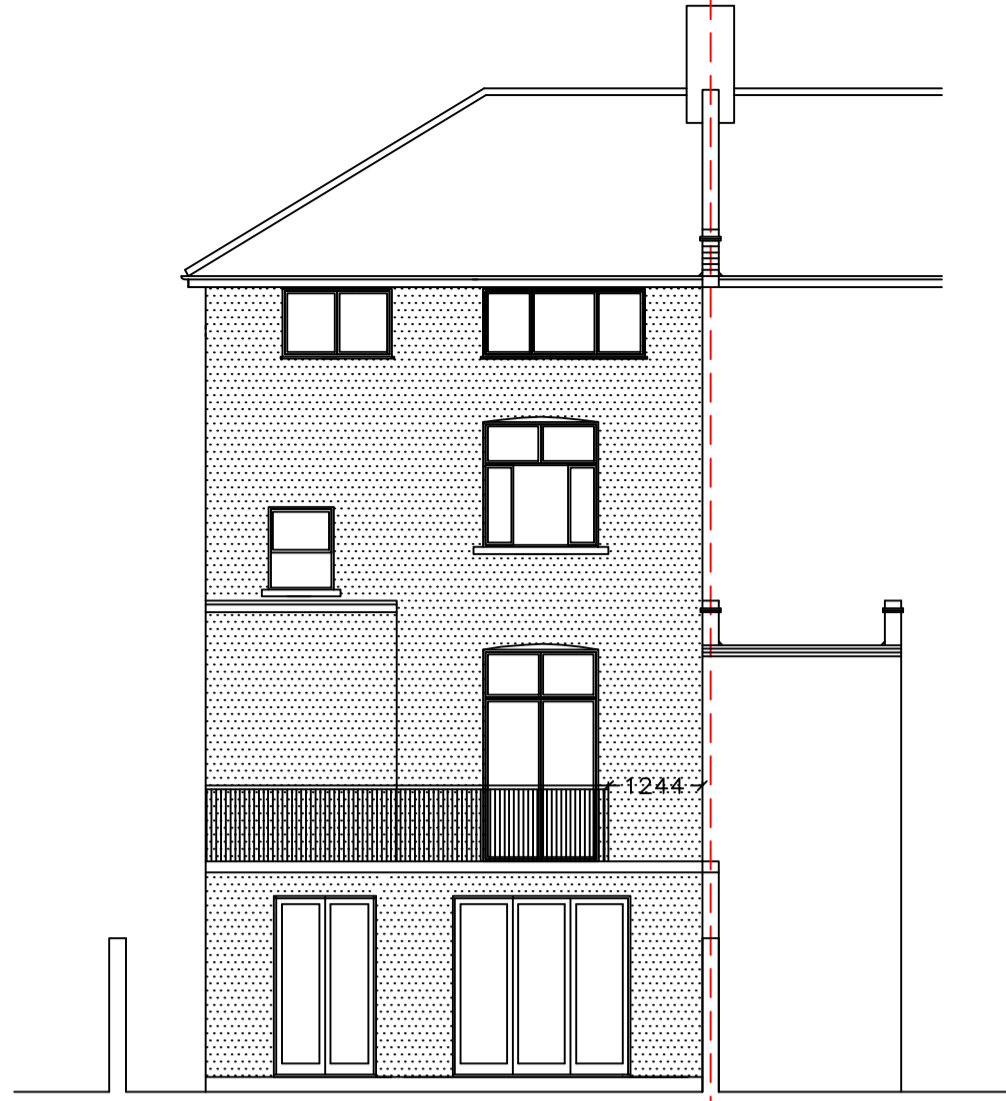


AS-BUILT AS AT JANUARY 2018
 N B The terrace has not been constructed as at March 2018 but the terrace is still proposed

Centre line of Party Wall

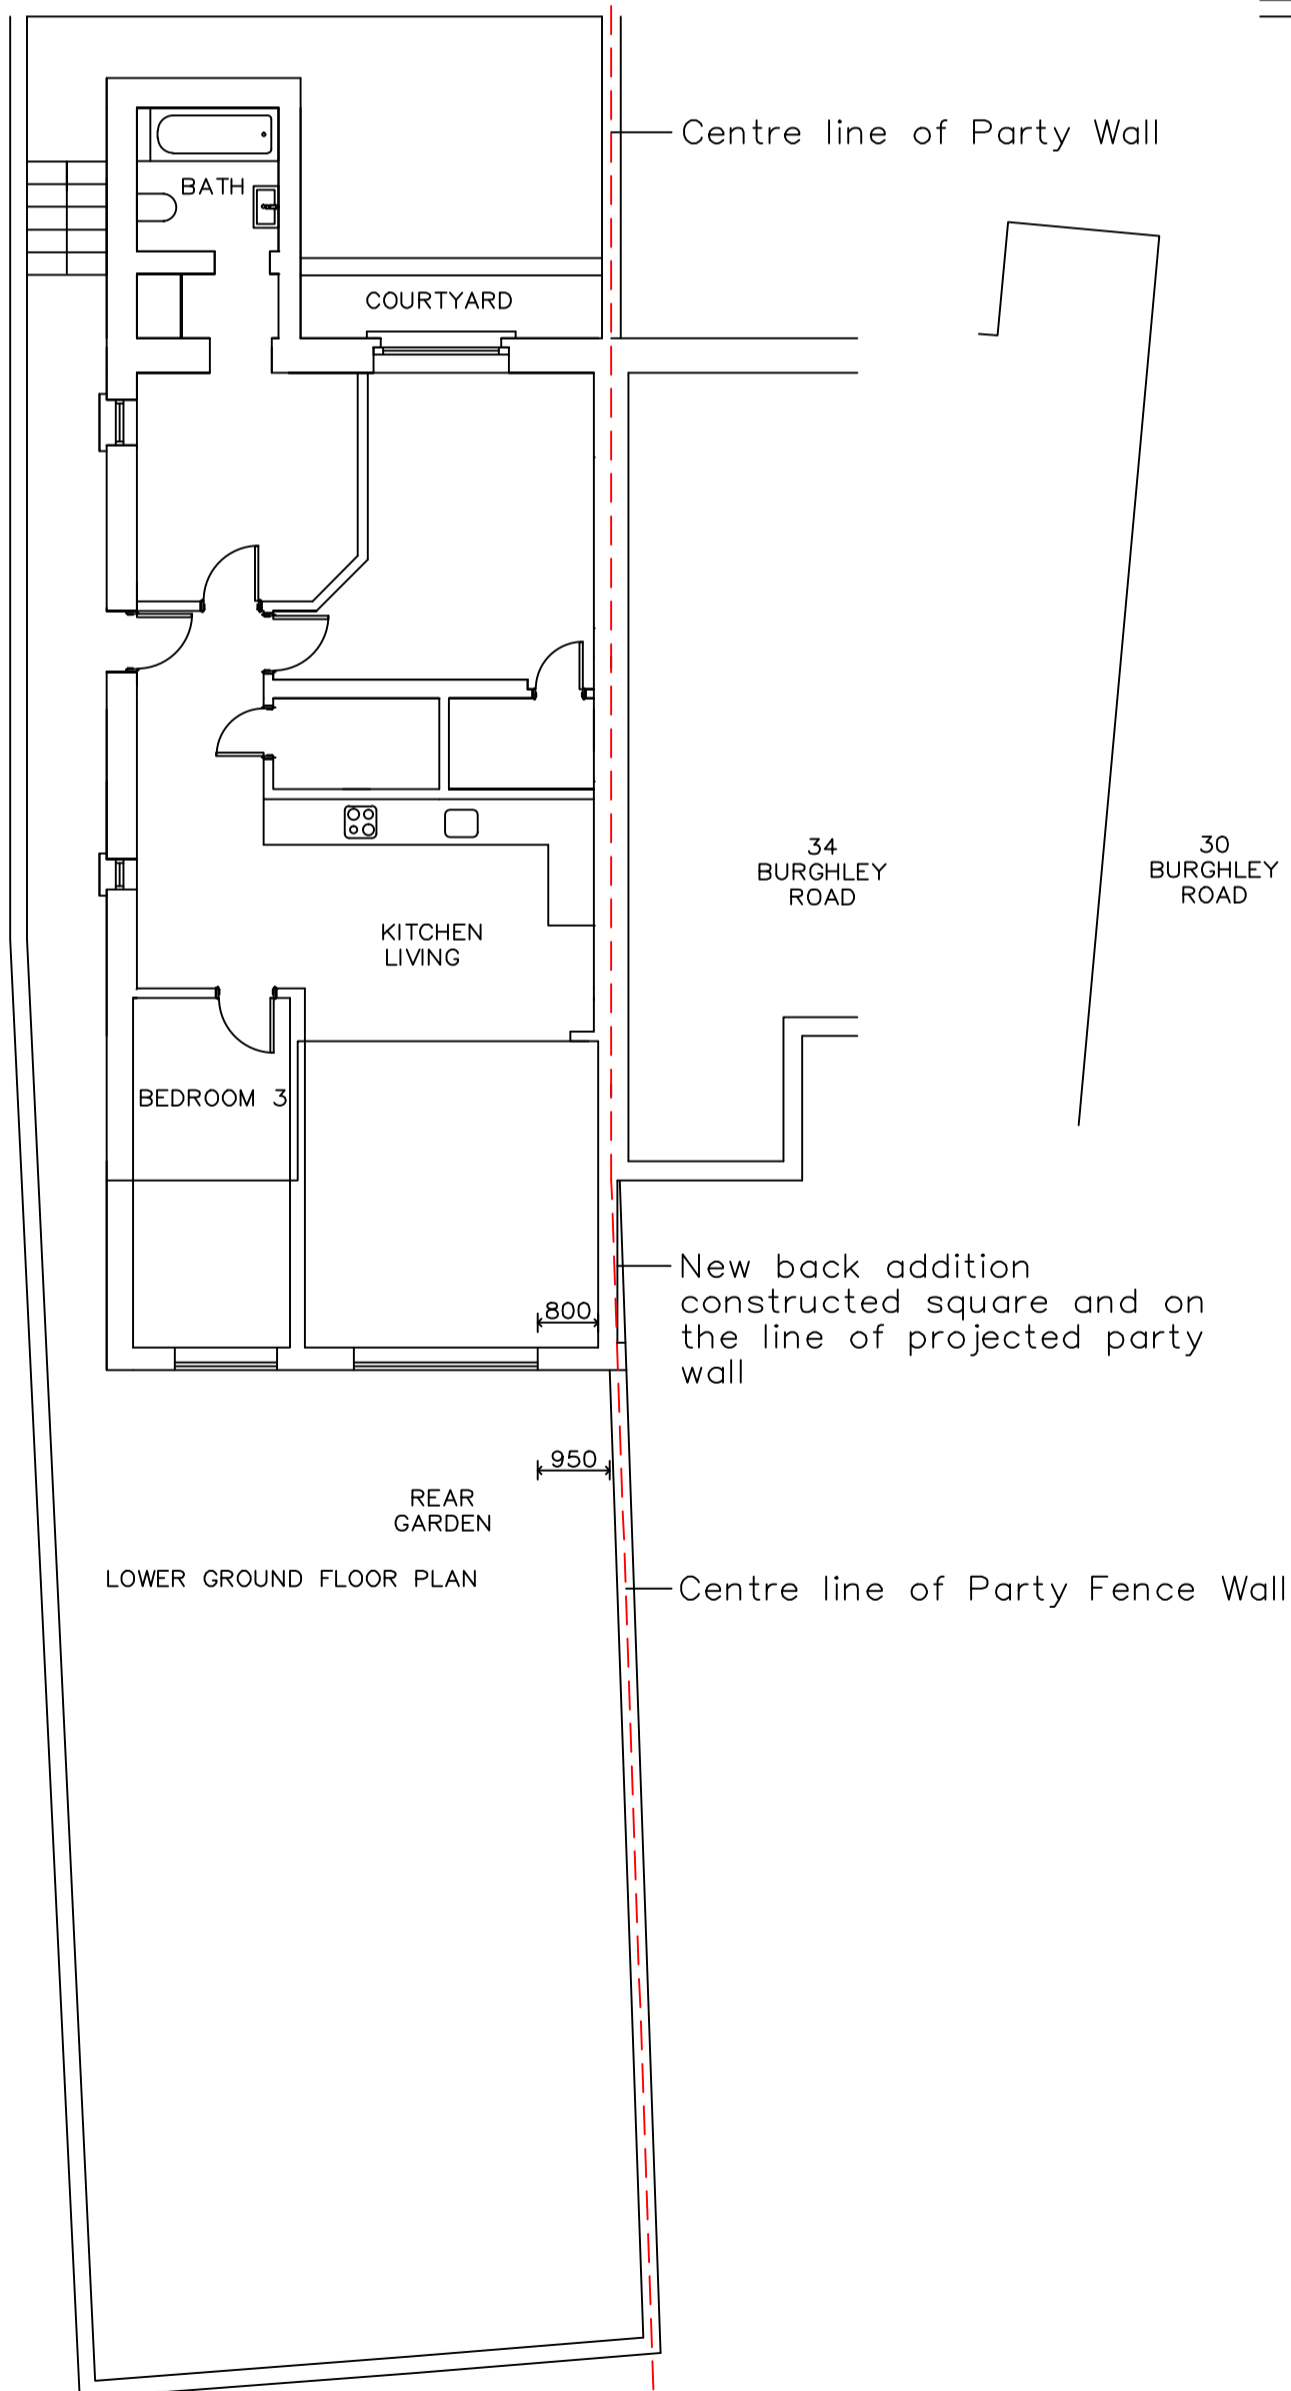

LOWER GROUND FLOOR PLAN

Centre line of Party Fence Wall

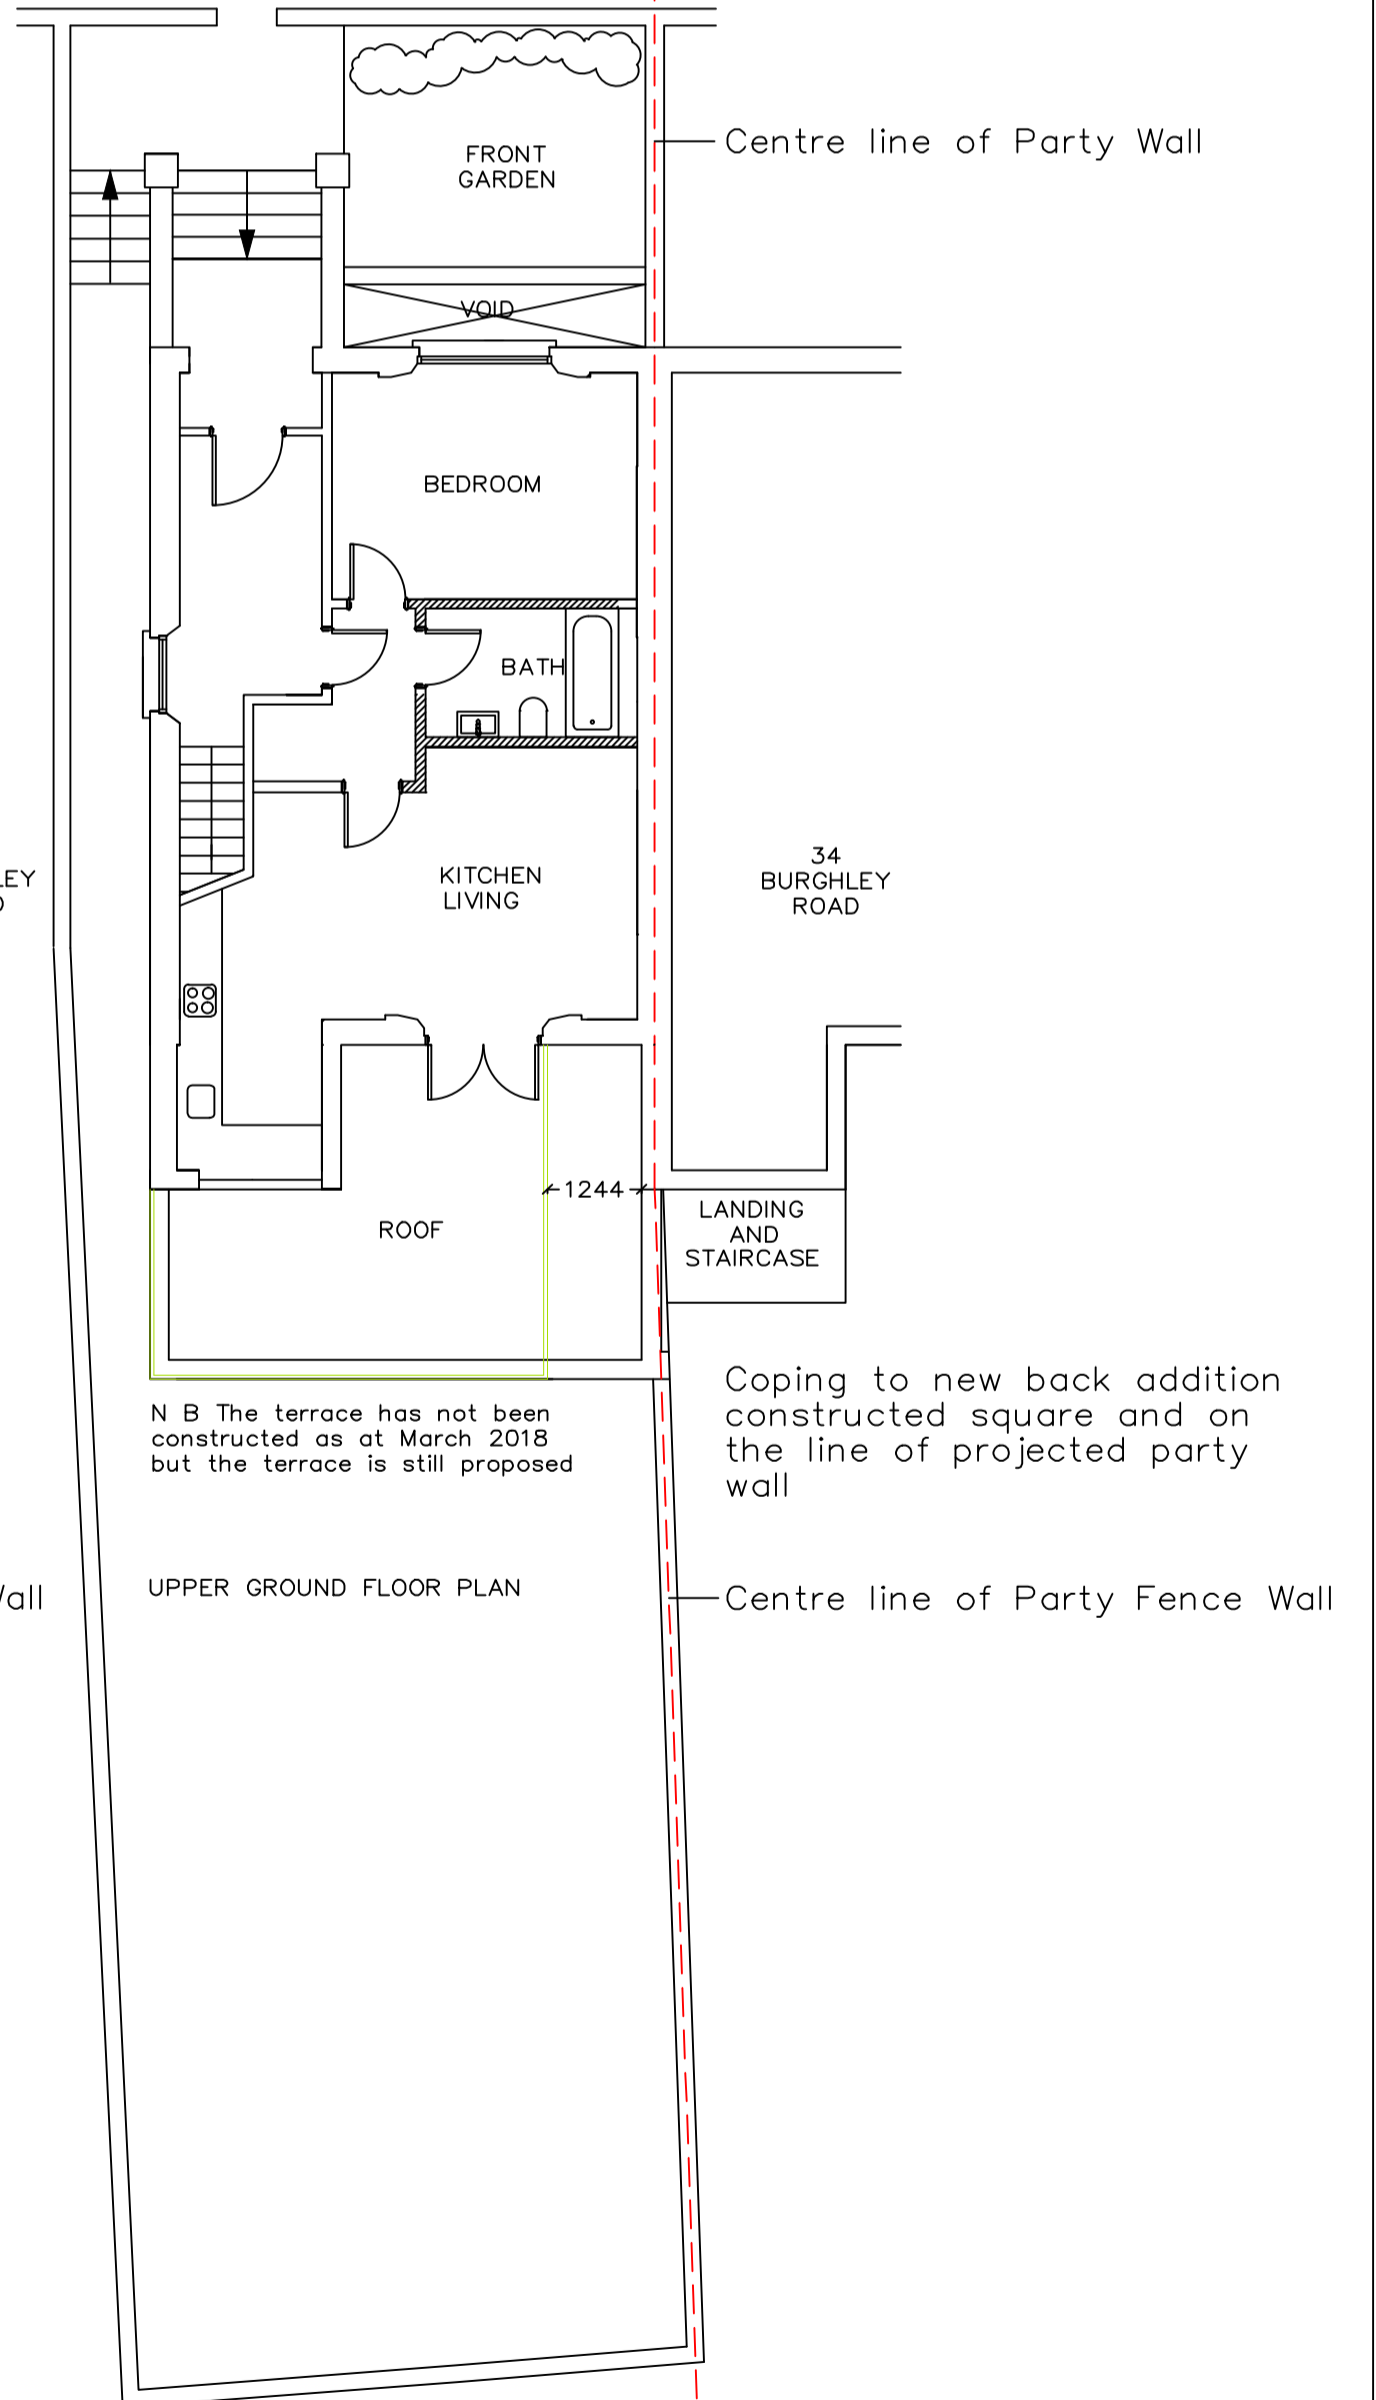

UPPER GROUND FLOOR PLAN

Centre line of Party Fence Wall

N B The terrace has not been constructed as at March 2018 but the terrace is still proposed

Coping to new back addition constructed square and on the line of projected party wall

