


AS BUILT



E-E Cross section


1:50

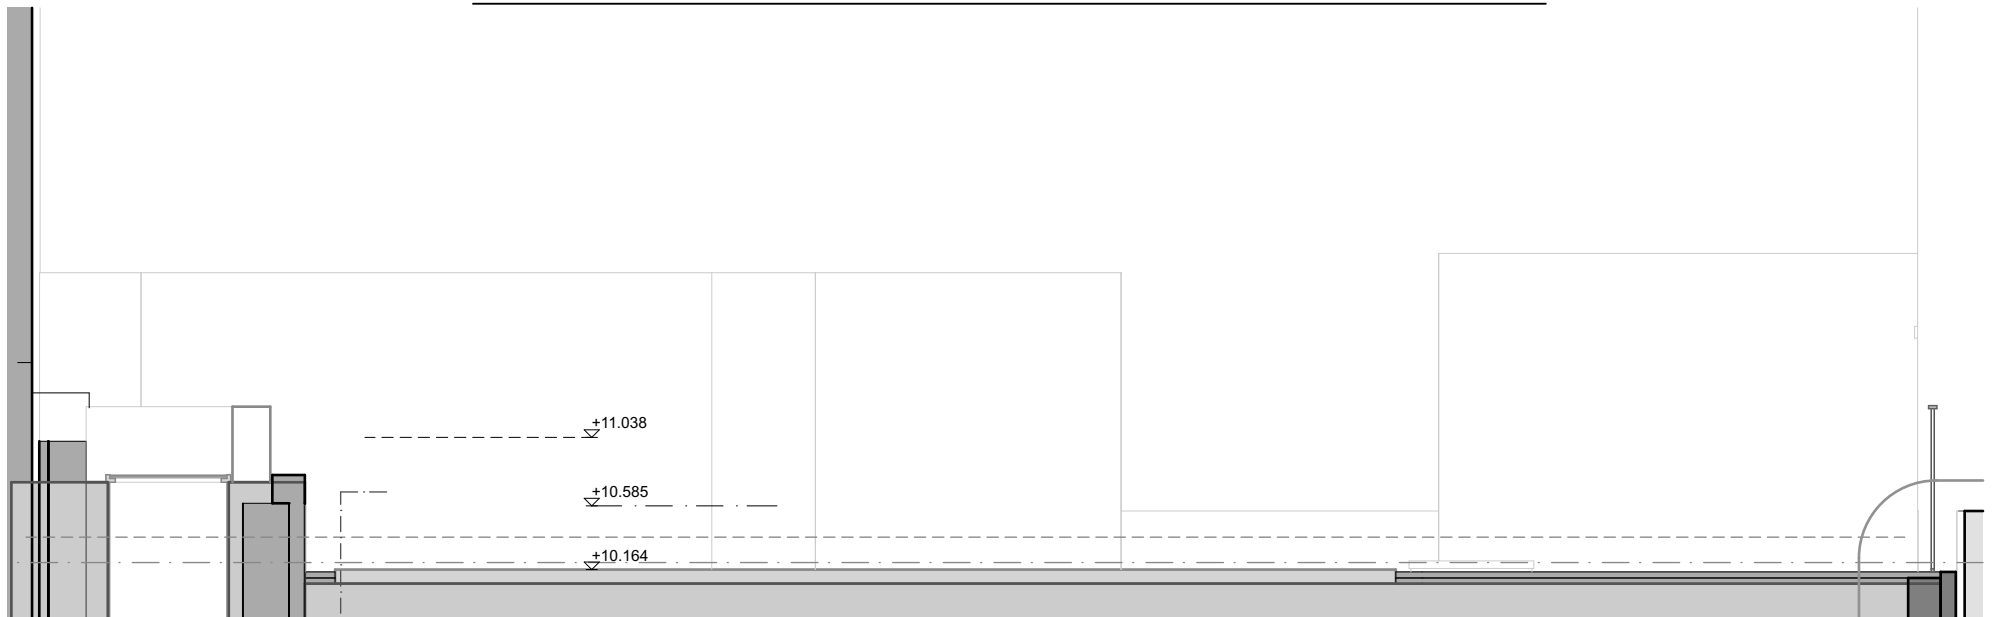

A-A

Long section (1)



1:50

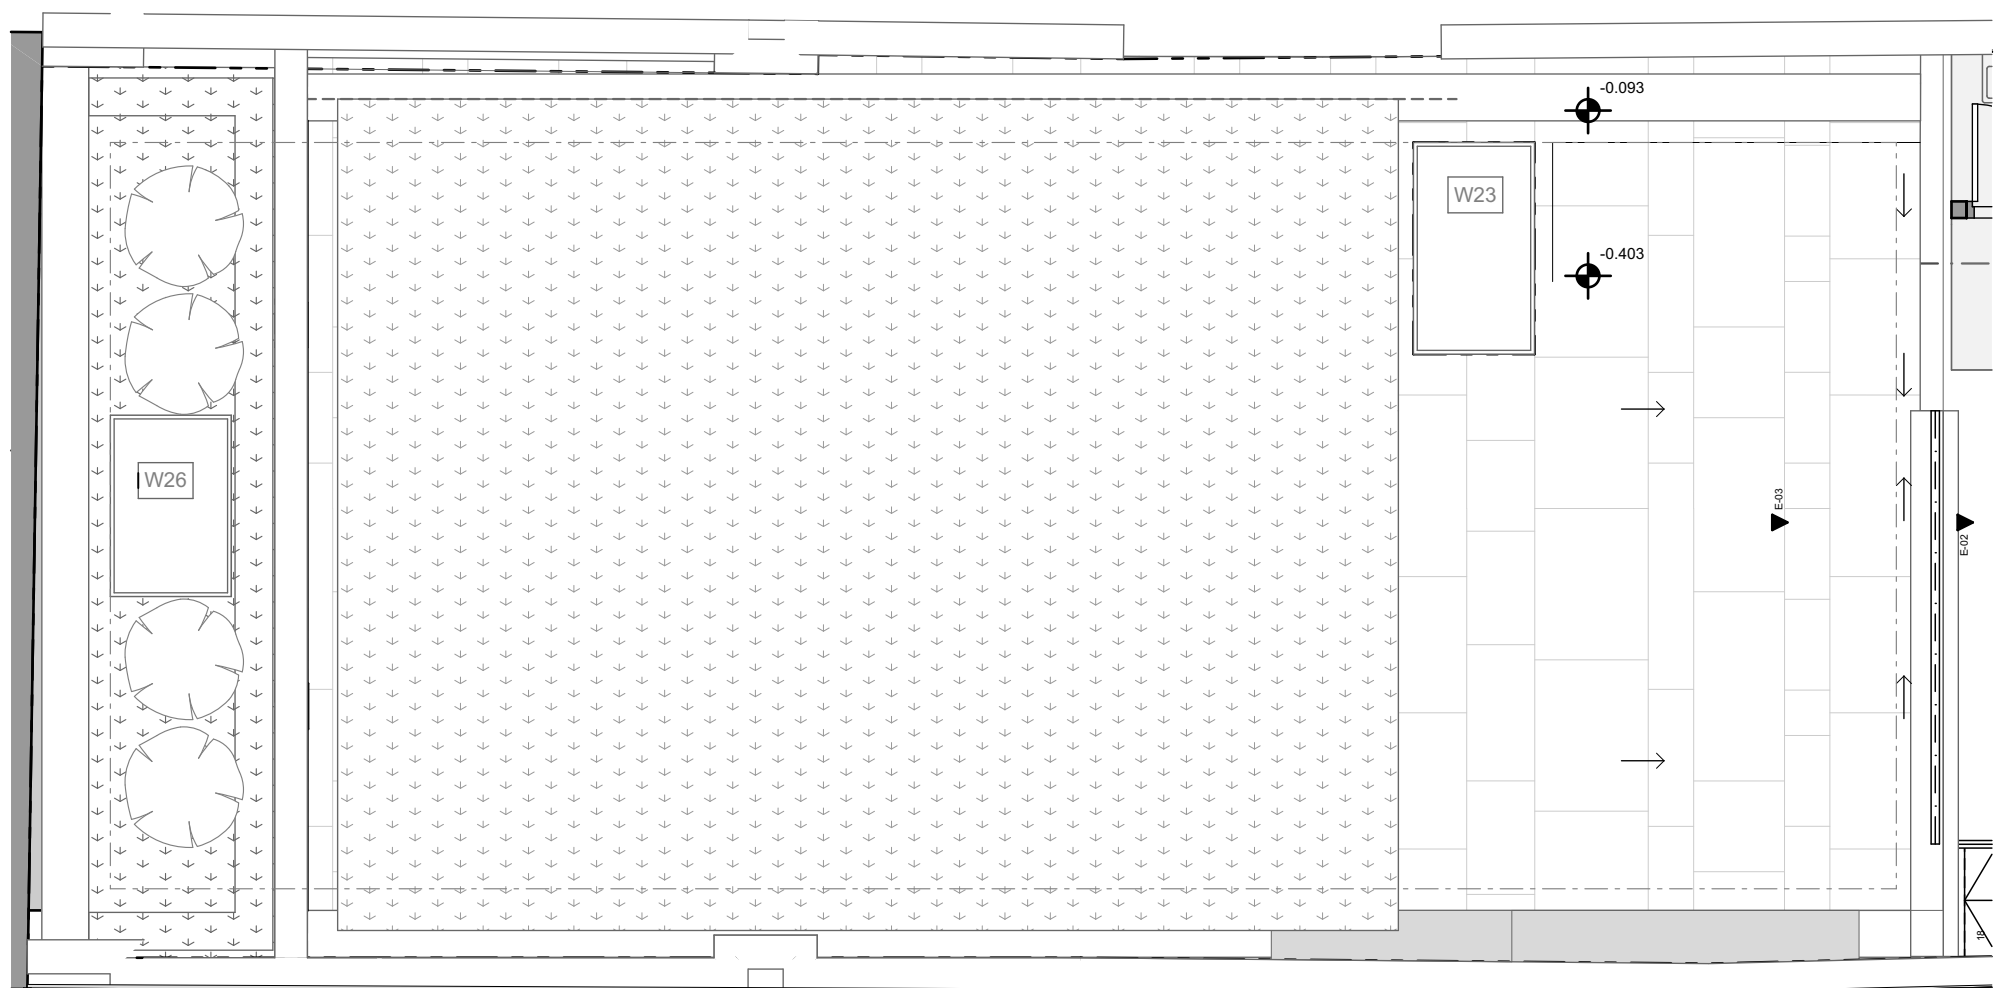

0.

Rear Garden Landscape Plan

1:50

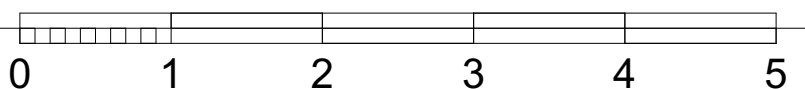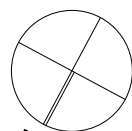

GENERAL NOTES

DO NOT SCALE FROM THIS DRAWING.  
DISCREPANCIES BETWEEN THIS AND OTHER  
DRAWINGS & INFORMATION TO BE REFERRED BACK  
TO CONSULTANTS TO REVIEW.  
DIMENSIONS IN MILLIMETERS UNLESS OTHERWISE  
INDICATED.

0315 57 Doughty Street

57 Doughty Street  
London  
WC1N

Existing Garden  
1:50@A3

Drg No:0315-12.1.2 Rev:  
31/07/2018

**Jacques Partnership**  
Architecture and Planning  
Studio 5, Fosse Farm Barns  
Nettleton  
Chippenham  
Wilts SN14 7NJ  
01249 783533