


This drawing is protected under Copyright and at no time may any portion of this drawing be reproduced or copied in anyway without the permission of Morgan Lovell.
All dimensions must be checked on site and NOT scaled from this drawing.

SUBJECT TO SITE SURVEY
CHECK SURVEY UNDERTAKEN ONLY
BUILDING PARAMETERS TAKEN FROM DRAWINGS PROVIDED
BUILDING PARAMETERS TAKEN FROM AS BUILT DRAWINGS PROVIDED

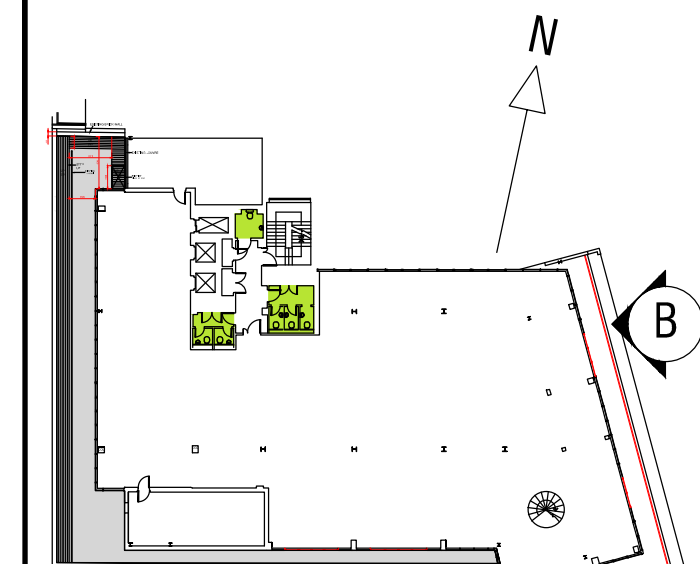

LOCATION PLAN



C	REVISED TO SUIT PLANNING OFFICERS COMMENTS	NS	07.08.18
B	NEW DESIGN FOR ACOUSTIC LOUVRE	NS	30.07.18
A	100mm ACOUSTIC LOUVRE ADDED	TC	16.07.18
-	DRAWING FIRST ISSUED	TC	16.05.18
Rev	Revision	By	Date

FOR PLANNING

Morgan Lovell

16 Noel Street London W1F 8DA
T: 0207 734 4466 F: 0207 734 2968 E: contact@morganlovell.com
W: http://www.morganlovell.com


Client
SAFFRON HOUSE

Project
6-10 KIRBY STREET
LONDON
EC1N 8TS

Title
GROUND TO 5TH, PROPOSED REAR ELEVATION

Scale	Date	Designer/Drawn By	Checked By / Date
1:50@A1	26.06.18	TC/TC	

Drawing Number			
Project No.	Floor	Drawing No.	Rev
ML2918	G-5	903	C

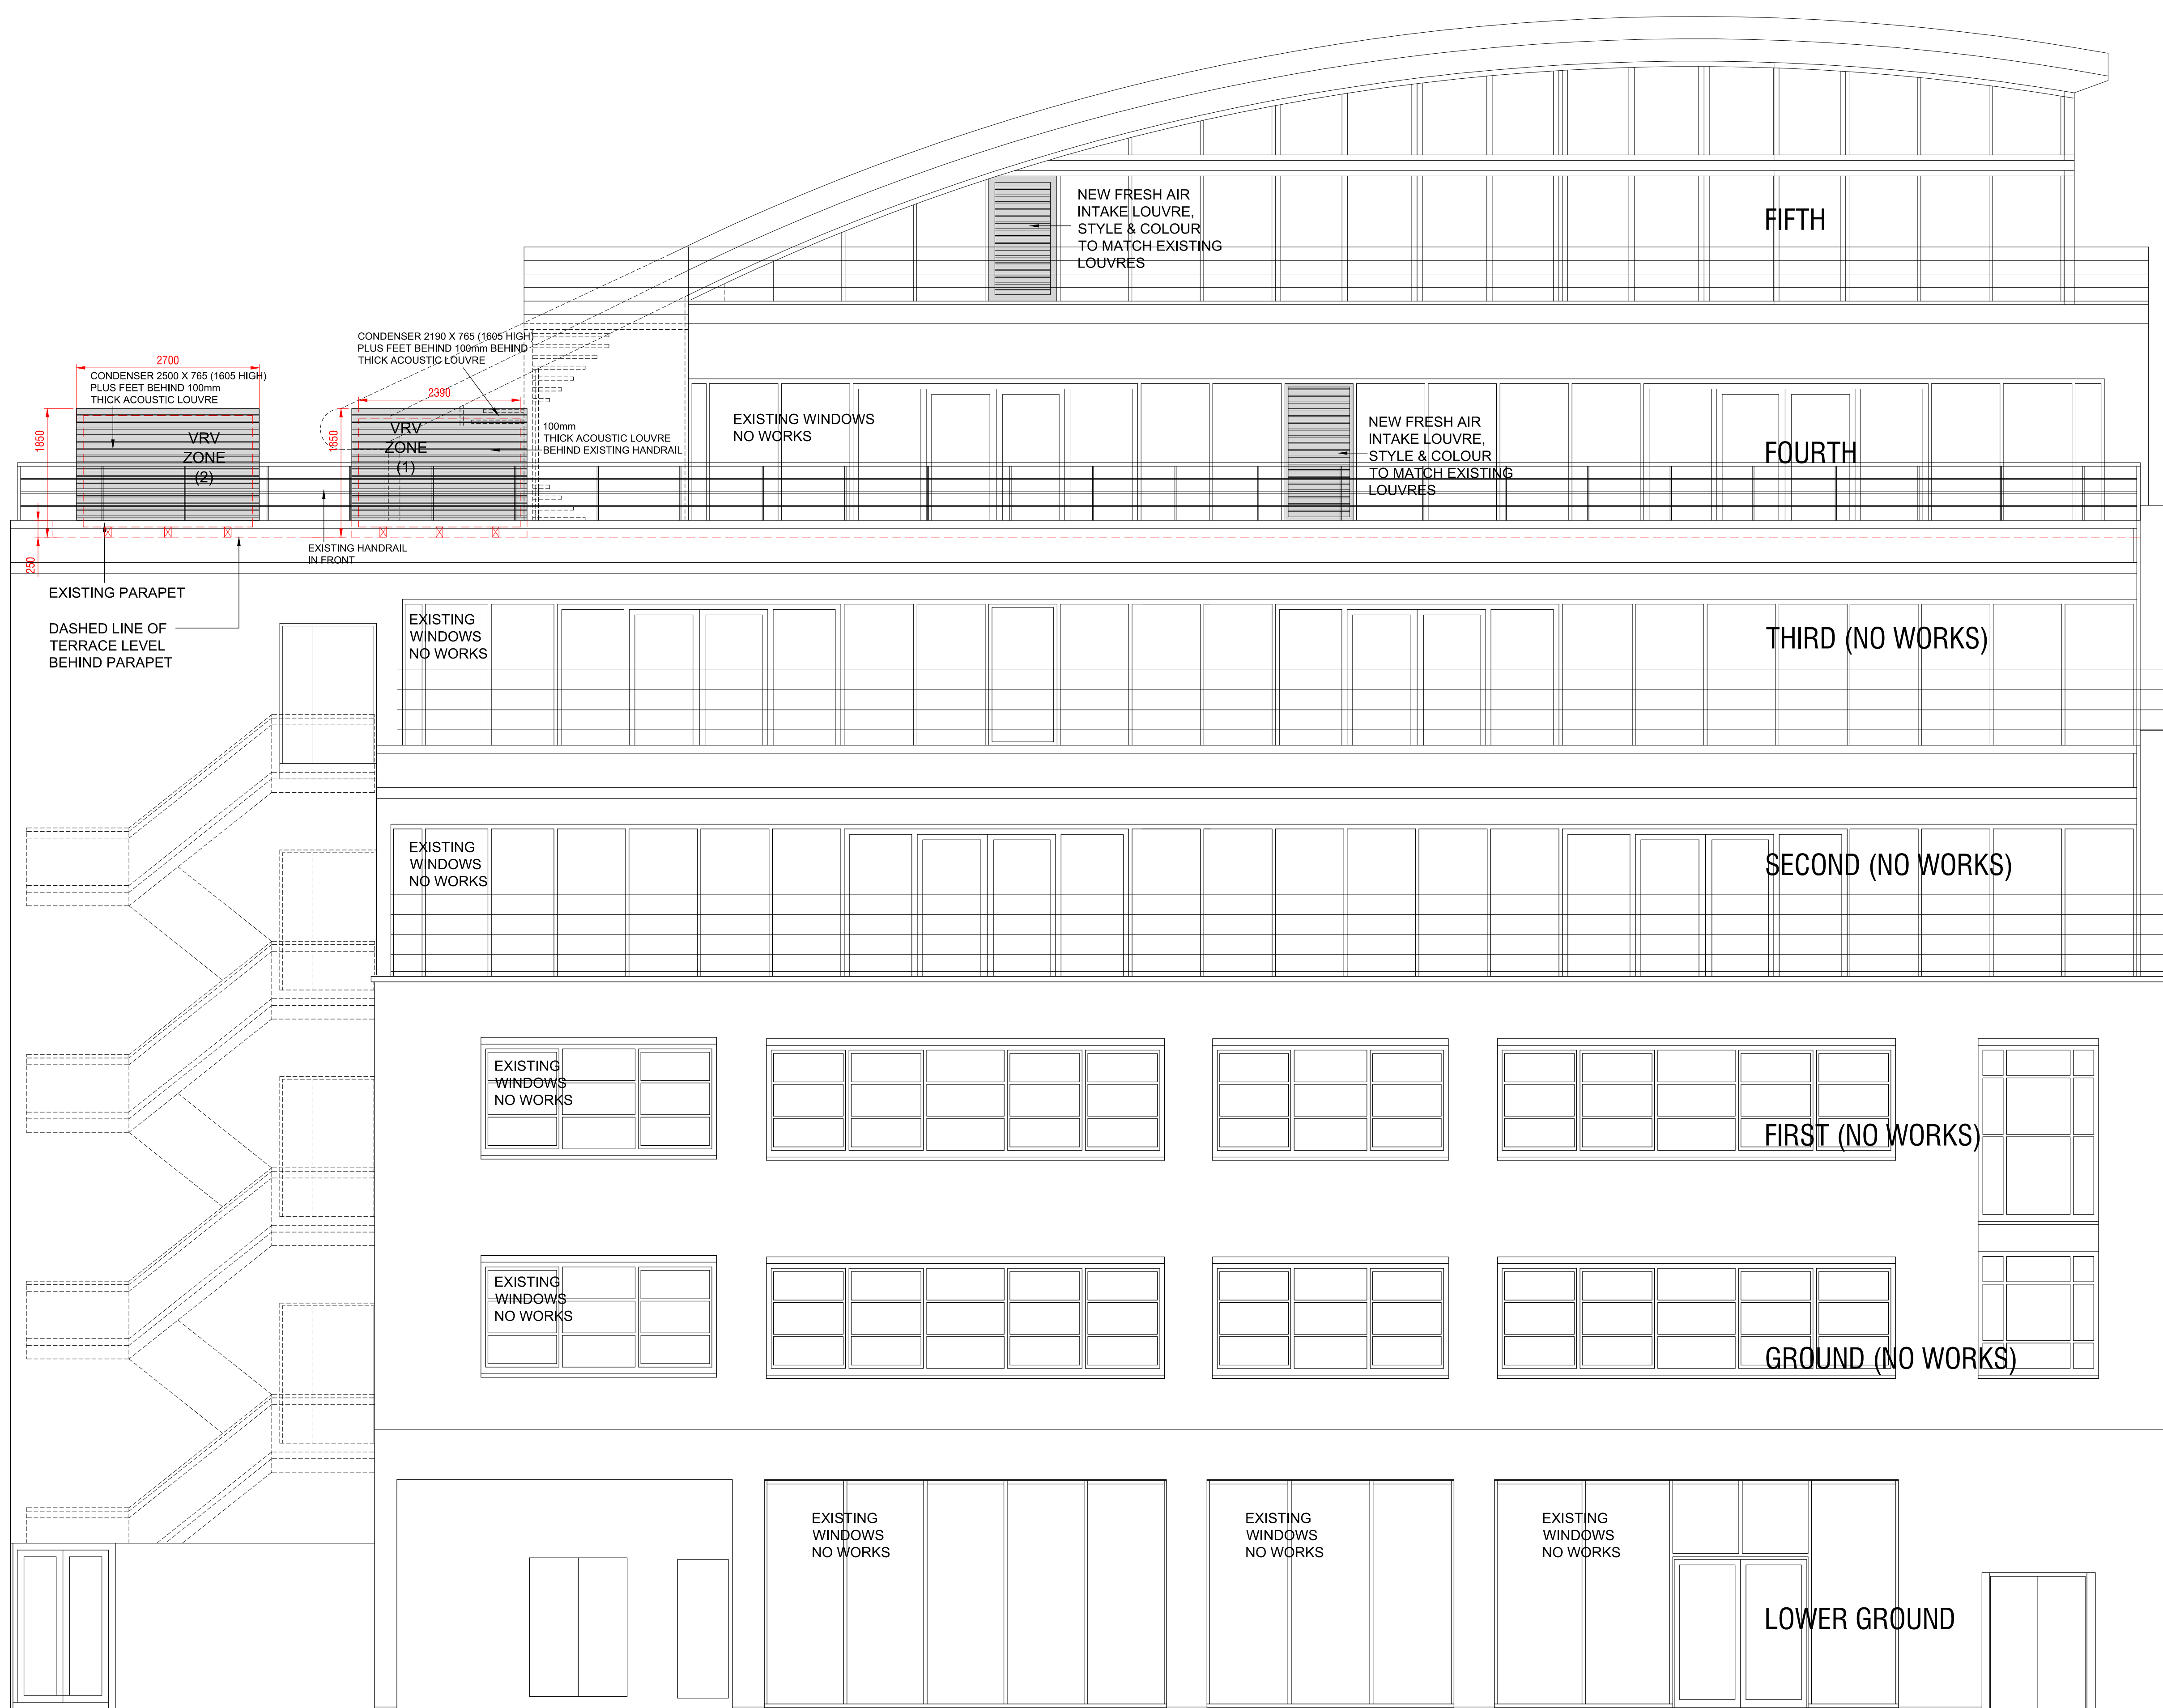

SAFFRON HILL ELEVATION

PROPOSED ELEVATION (B)
1:50@A1

