




ALL

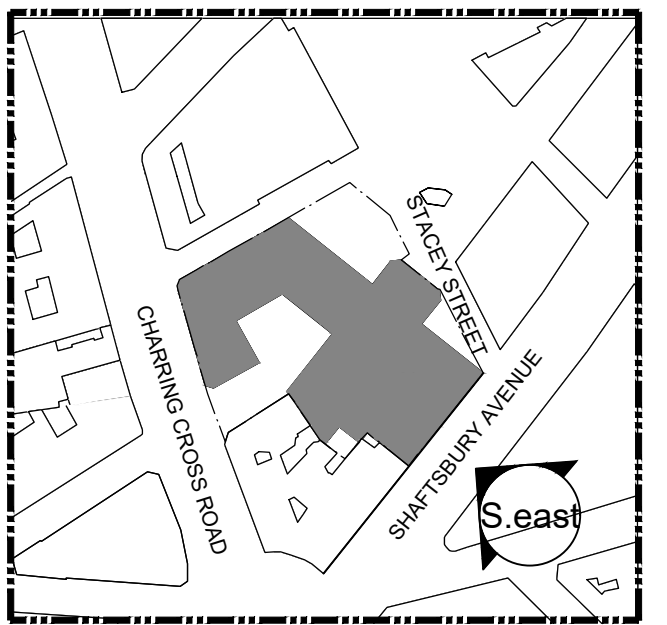

LOCATION PLAN

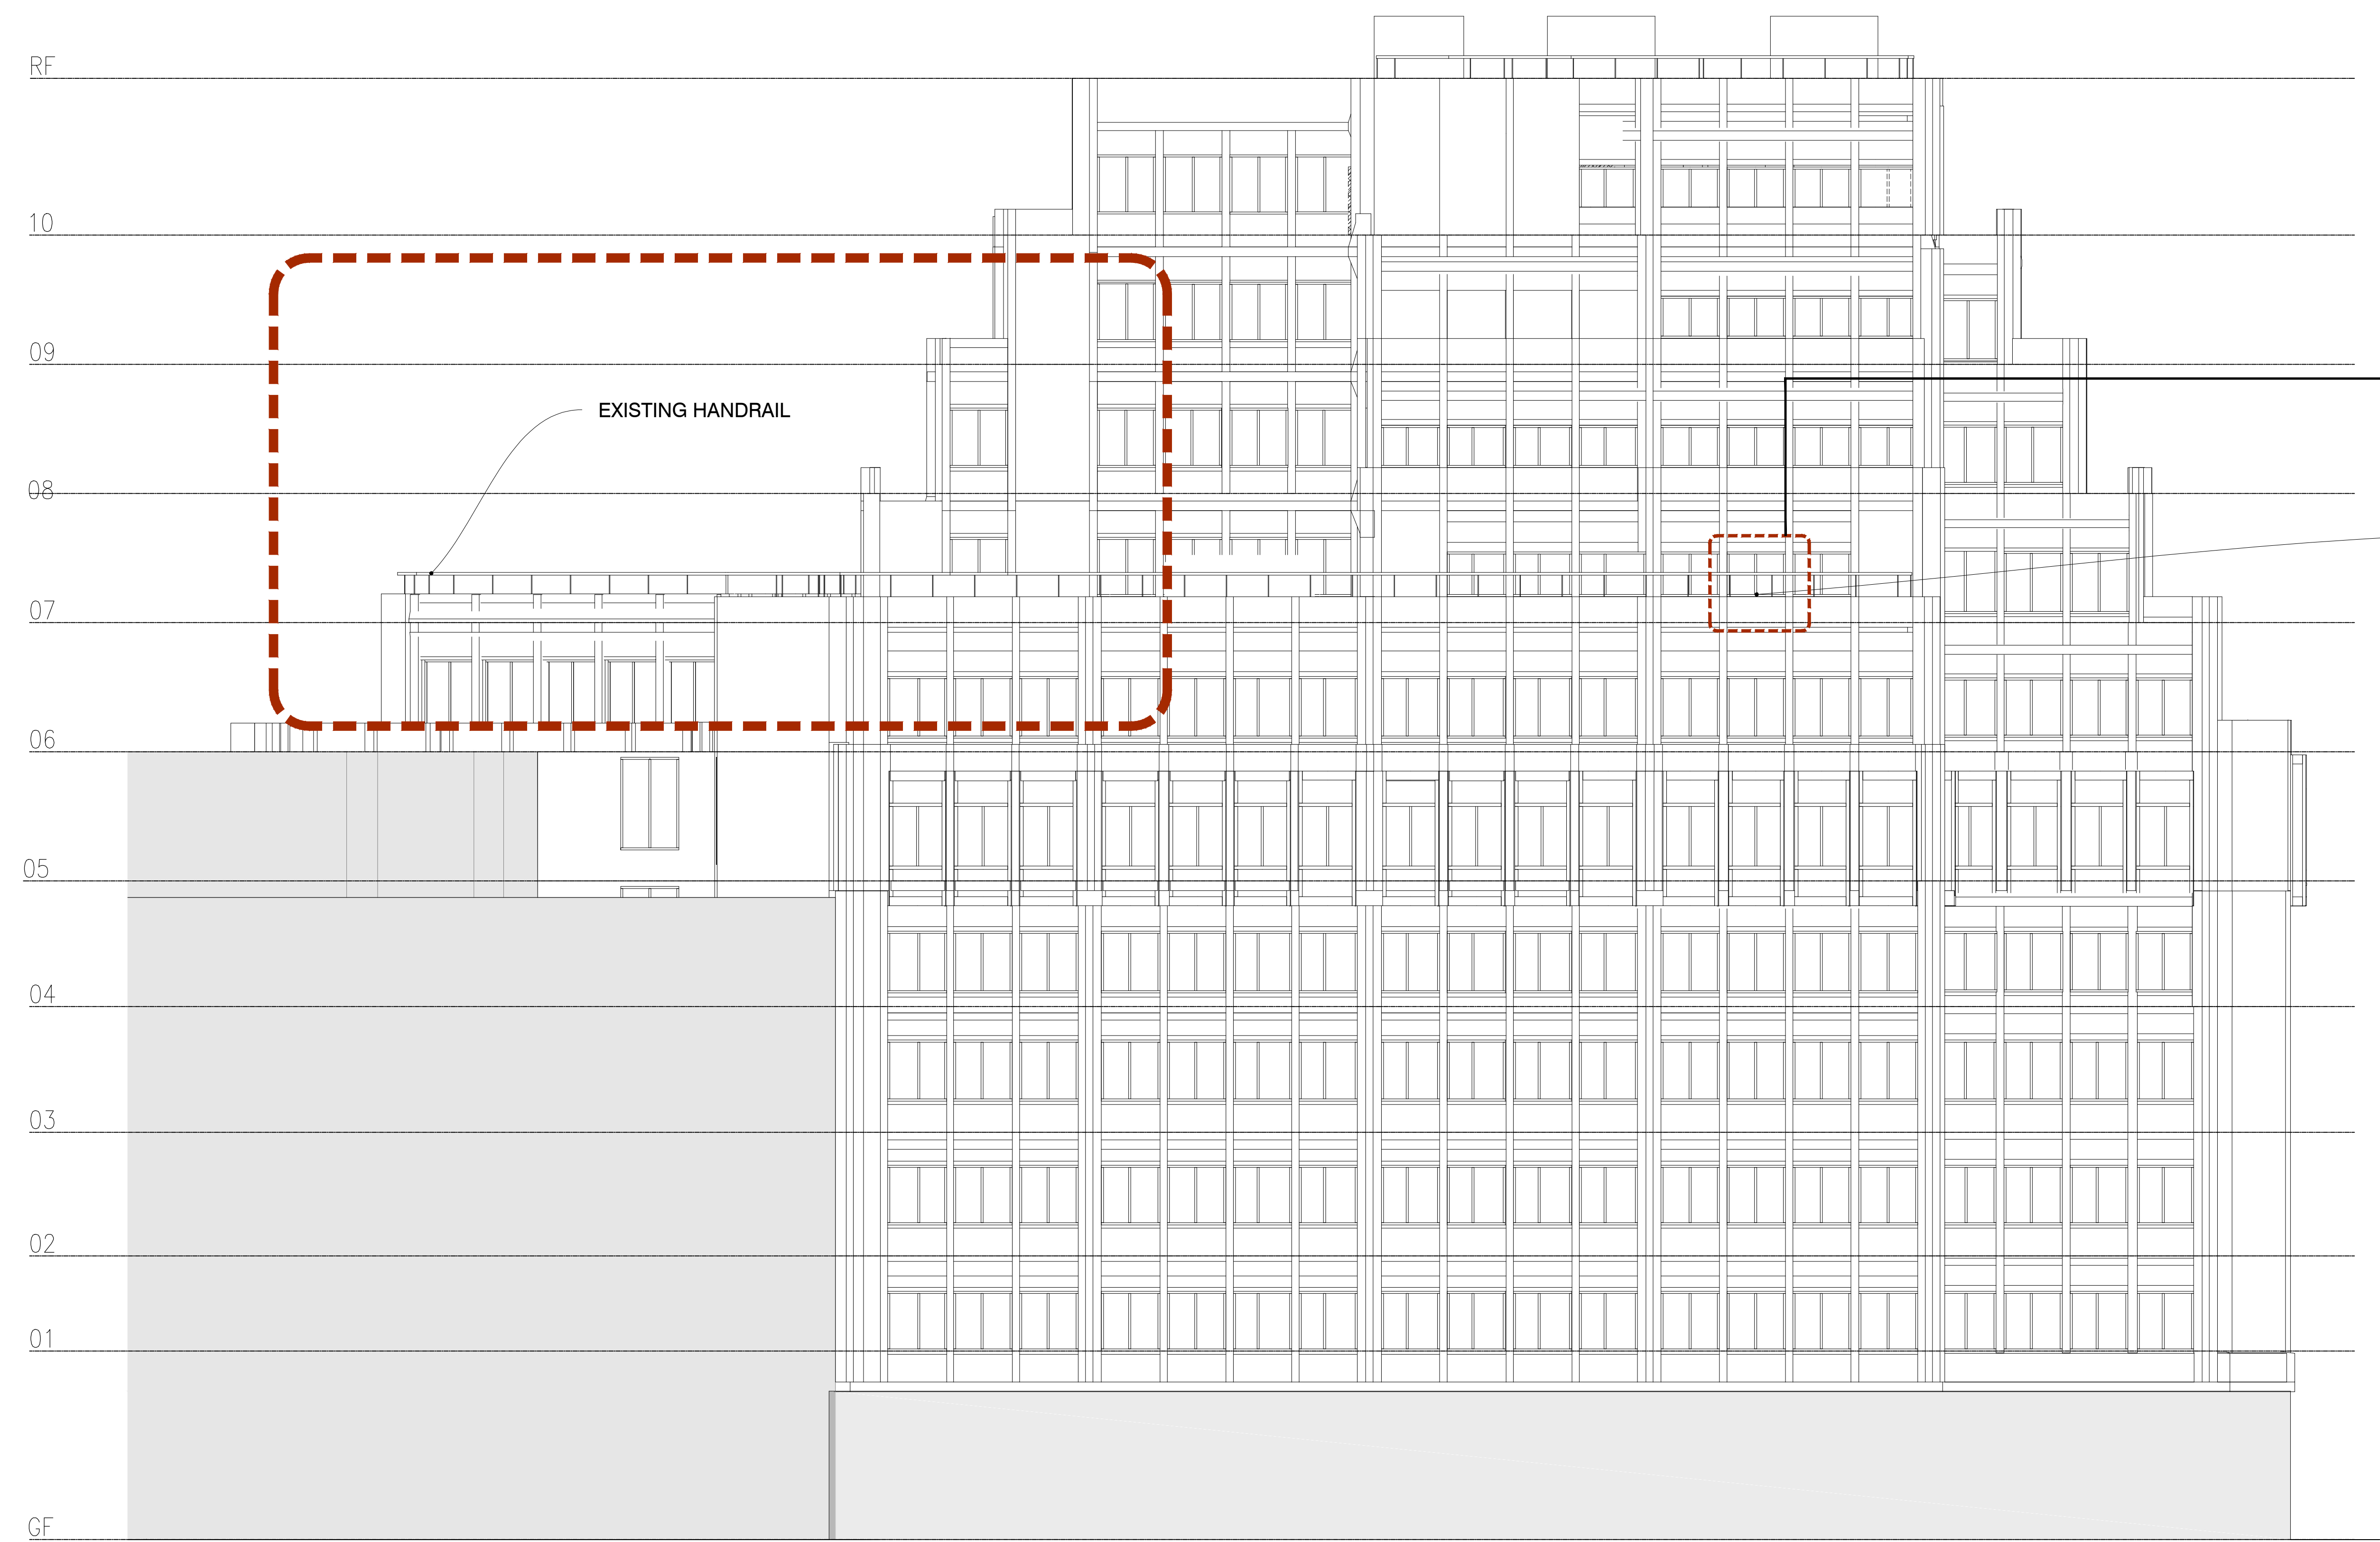


SOUTH EAST ELEVATION

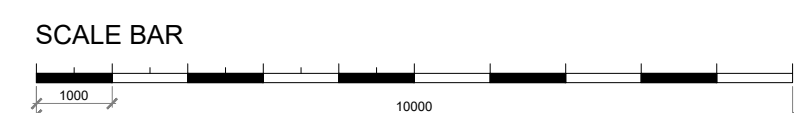

detail
01

PROPOSED NEW DOUBLE ACCESS
DOOR TO REPLACE EXISTING WINDOW
BAY
FINISHES /MATERIALS TO MATCH
EXISTING/REPLACEMENT WINDOWS
SEE TYPICAL DOOR DETAIL

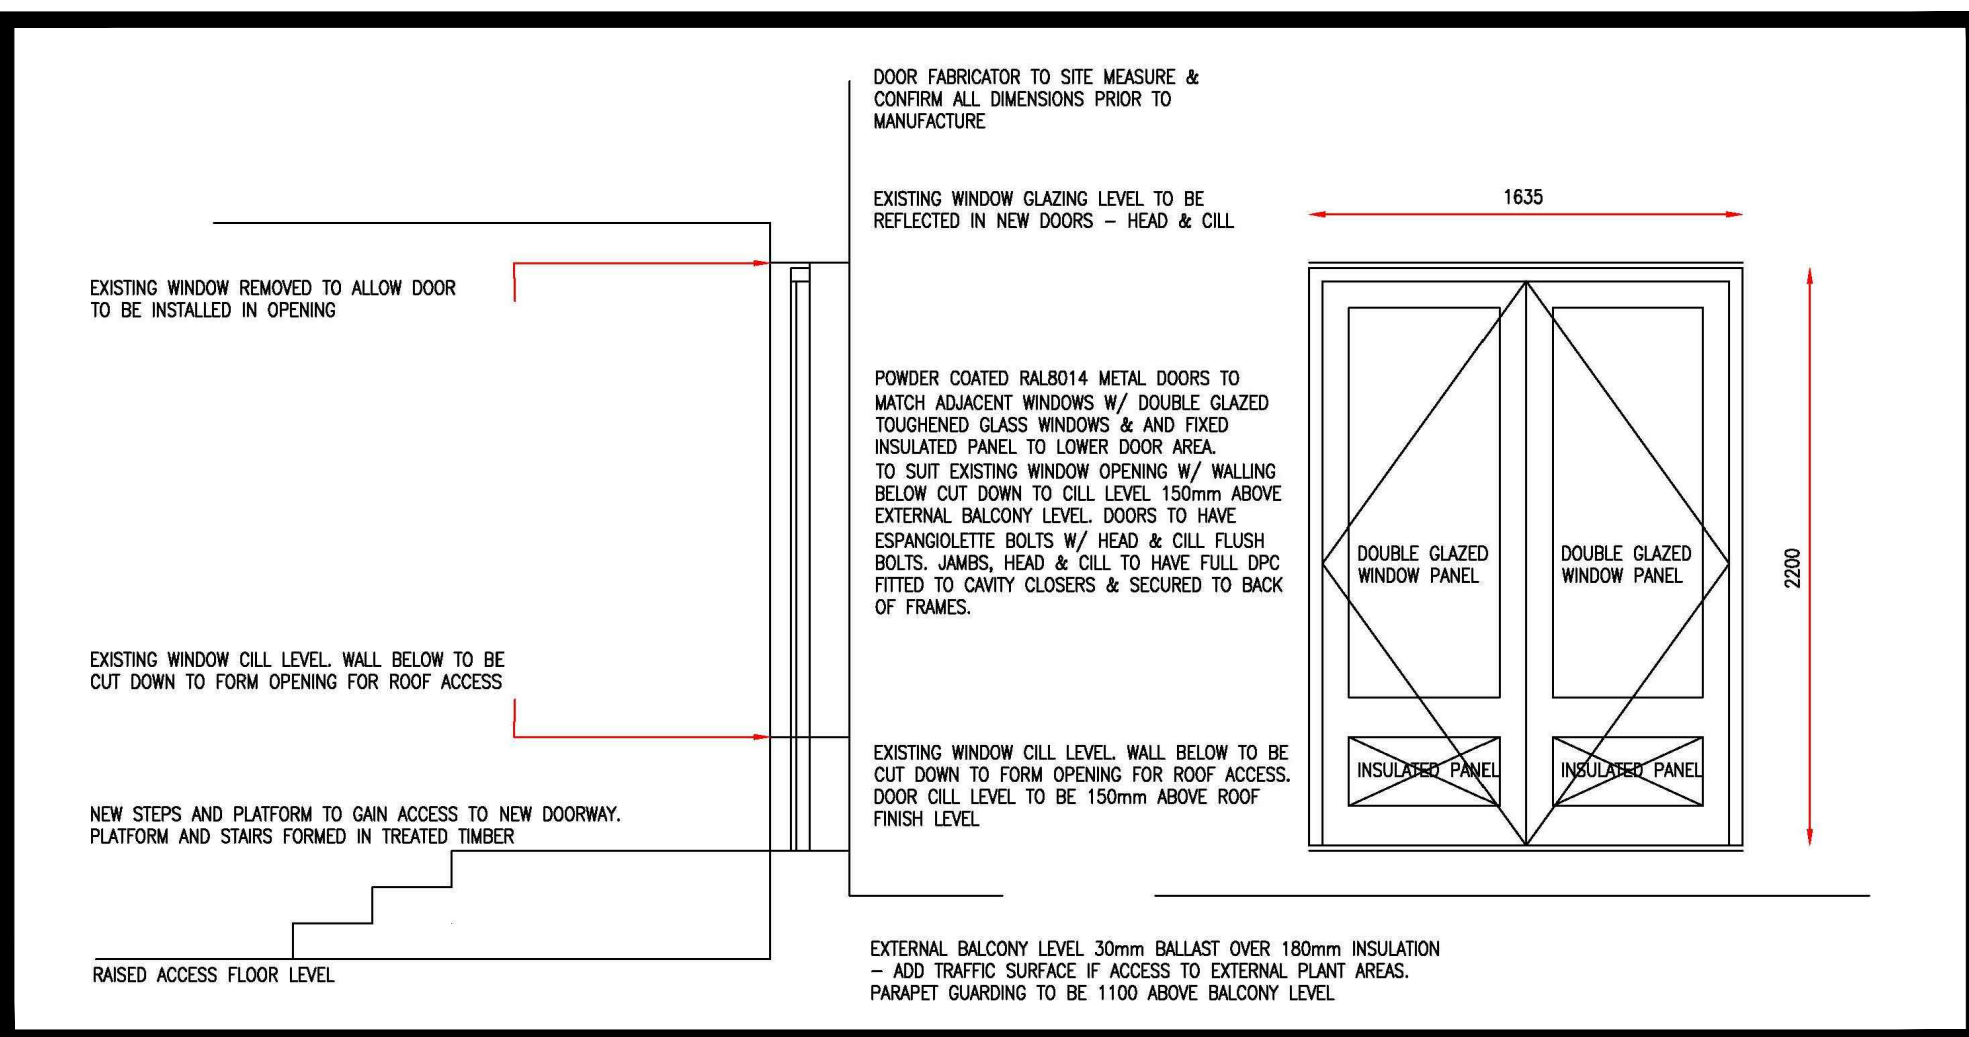

sketch detail 01 - Proposed Replacement Access Doors
scale : nts

-	Drawing first produced	AN/NJ	28.08.18		
Rev	Descriptive amendments	Drawn by	Date		
Pre-Design - Construction - As Built					
Planning Application					
Client					
WeWork					
Client Contact					
Site Address					
125 Shaftesbury Avenue					
Drawing Title					
South East Elevation - Proposed					
Account Manager					
Designer/ Senior Tech.Designer / Project Manager					
N.HASSEY / J.VAUGHAN / L.GRAYLAND					
Scale	Drawn By	First Drawing Date			
1:100 @ A0	AN	22/08/18			
Contract Number	Floor	Detail	Revision		
1124	ALL	PA-05.1	-		

1tb. Aldwych House
71-91 Aldwych
London
WC2B 4HN