

**create**  
CONSULTING  
ENGINEERS LTD

[www.createconsultingengineers.co.uk](http://www.createconsultingengineers.co.uk)

**11-12 INGESTRE ROAD, LONDON, NW5 1UX**

**Flood Risk Assessment and Drainage Strategy – Volume 2 of 4**

**PLANS**  
**(Continued)**



Revision History:

Site Legend:

AB	Air Brick	GV	Gas Valve
ACU	Air Conditioning Unit	IC	Inspection Cover
ASP	Artificial Stone Paving	IL	Invert level
BT	British Telecom	LP	Lamp Post
CL	Cover Level	MKR	Marker (Service)
DYL	Double Yellow Line	MP	Metal Post
EL	Electricity	OH	Overhead
FAI	Fresh Air Inlet	OST	Oil Storage Tank
FB	Flower Bed	PB	Post Box
FH	Fire Hydrant	PL	Pavement Light
G	Gully	RE	Rodding Eye
		RS	Road Sign
		SNP	Street Name Plate

Building Legend:

SYL	Single Yellow Line	CA	Centre of Arch
TCB	Telephone Call Box	CH	Ceiling Height
TP	Telegraph Pole	CWT	Cold Water Tank
TW	Top of Wall	DH	Door Head
TF	Top of Fence	ESP	Electricity Switch Panel
UL	Unable To Lift	F	Frame Height
VP	Vent Pipe	GDH	Glazed Door Height
CP	Concrete Post	GRL	Glazed Roof Light
WP	Water Valve	HWT	Hot Water Tank
CB	Close Boarded Fence	RSD	Roller Shutter Door
/CB	Interwoven Panel		
/W	Vertical Board		
/VB			

Levels:

Level data has been obtained with Kinematic GPS corrections via the Ordnance Survey's network, OS Net.

RWP	Rain Water Pipe	SA	Spring of Arch
SA	Spring of Arch	SCH	Suspended Ceiling Height
SCH	Suspended Ceiling Height	SD	Sliding Door
SD	Sliding Door	SP	Soil Pipe
SP	Soil Pipe	SVP	Soil and Vent Pipe
SVP	Soil and Vent Pipe	USB	Underside of Beam
USB	Underside of Beam	WP	Waste Pipe
WP	Waste Pipe	WST	Water Storage Tank
WST	Water Storage Tank		

Project: 12 Ingestre Road, London, NW5 1UX

Drawing Title: Ground and First Floor Plan

Scale: 1:100 @ A1

Date: April 2013


Drawing No: 03 of 03


Blueprint Surveys Ltd

Land and Measured Building Surveys

Tel: 0844 5610758

E-Mail: [admin@blueprintsurveys.co.uk](mailto:admin@blueprintsurveys.co.uk)

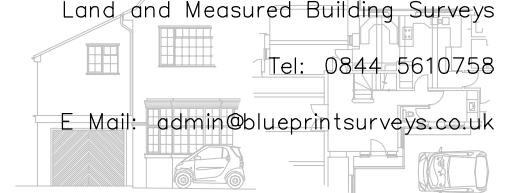


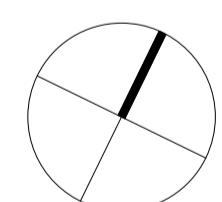

FOR COMMENT

Project  
 11-12 Ingestre Road, Camden  
 Assisted Living Development  
 Drawing Title  
 Proposed Plans  
 Basement Plan  
 Date 05/06/18 Scale 1:100 @ A1 Drawn by DC Check by PN  
 Project No 27463 Drawing No A-P11-00 Revision A



Basement Floor Plan  
 1:100

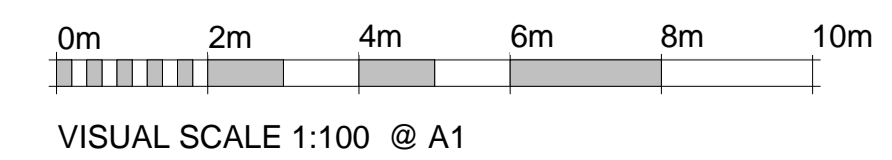

**BARTON WILLMORE**  
 DRAFT  
 Planning • Master Planning & Urban Design • Architecture • Landscape Planning & Design • Environmental Planning • Graphics Communication • Public Engagement • Research  
 bartonwillmore.co.uk  
 Offices at Bristol Cambridge Cardiff Edinburgh Leeds London Manchester Newcastle Reading Solihull Southampton

INGESTRE ROAD


Public Realm to be updated to BW Landscape details

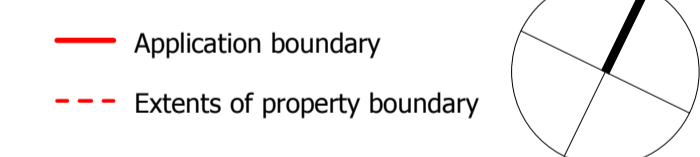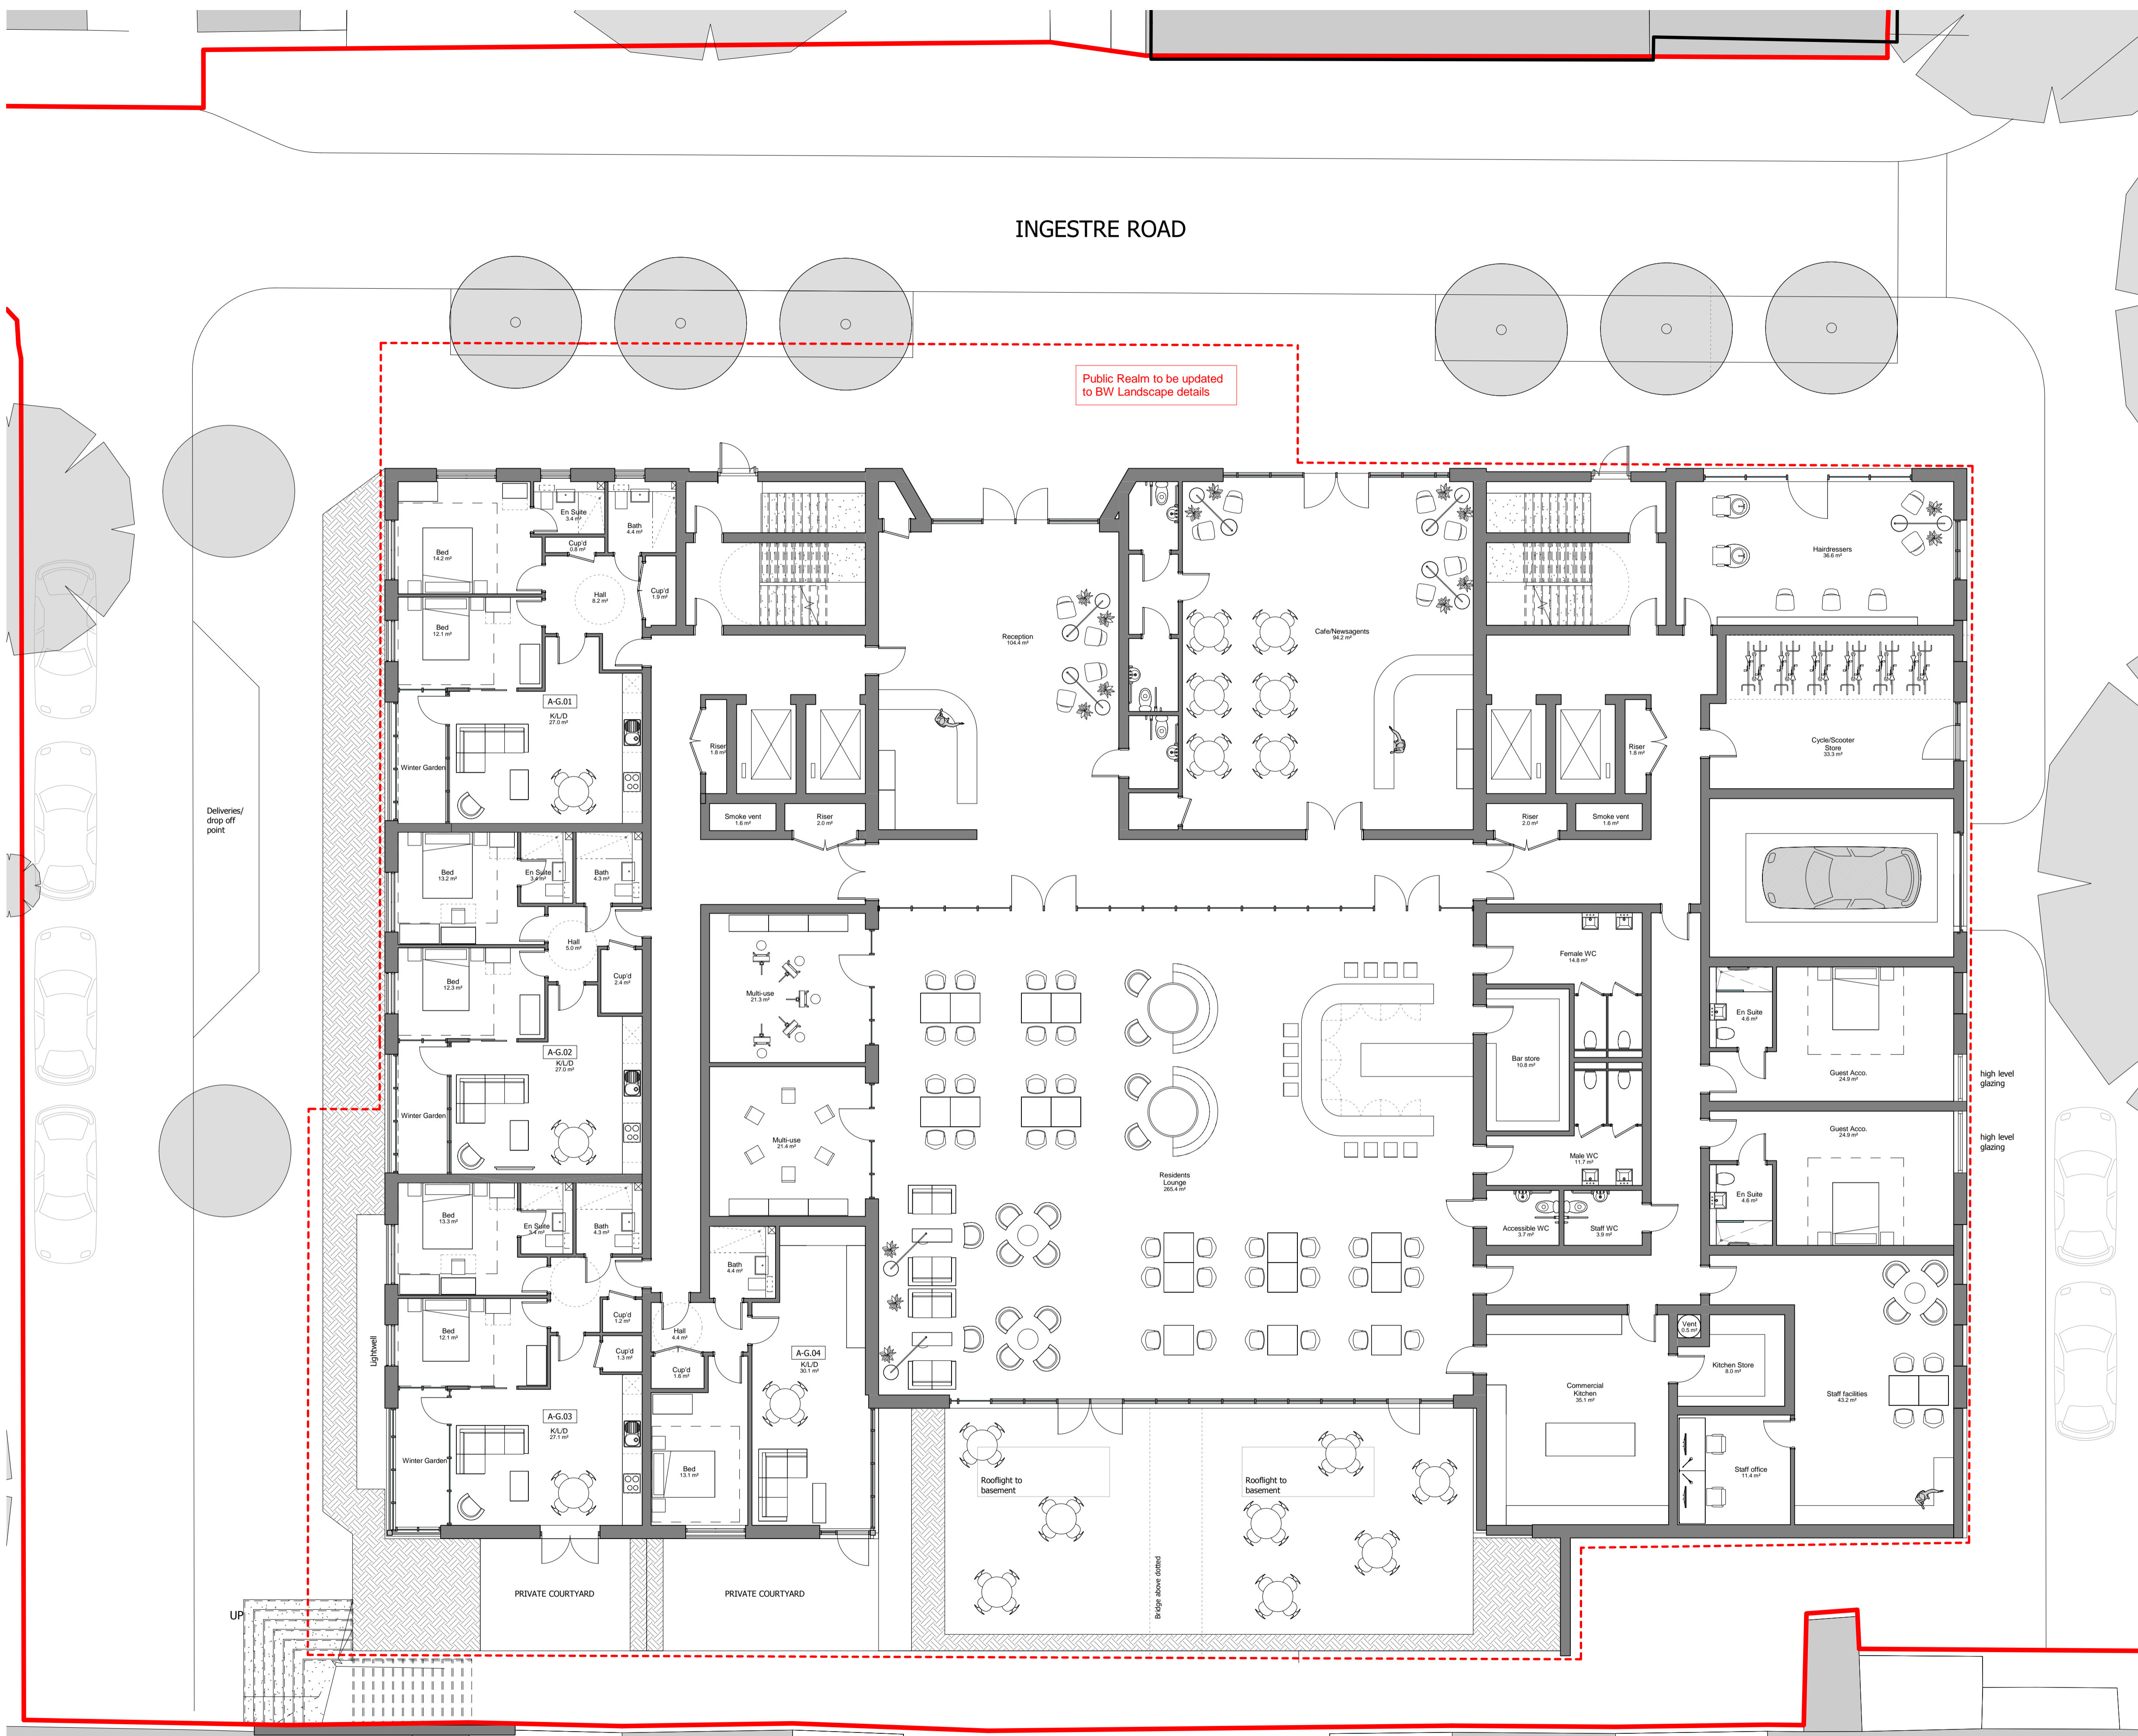



FOR COMMENT

Project  
 11-12 Ingestre Road, Camden  
 Assisted Living Development  
 Drawing Title  
 Proposed Plans  
 Ground Floor  
 Date 05/06/18 Scale As indicated @ A1 Drawn by DC Check by PN  
 Project No 27463 Drawing No A-P11-01 Revision A

00 Ground Floor Plan  
 1 : 100

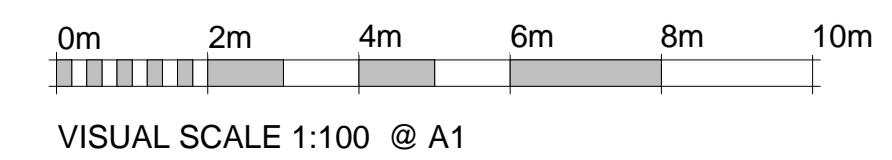


**BARTON WILLMORE**  
 DRAFT  
 Planning • Master Planning & Urban Design • Architecture • Landscape Planning & Design • Environmental Planning • Graphics Communication • Public Engagement • Research  
 bartonwillmore.co.uk  
 Offices at Bristol Cambridge Cardiff Edinburgh Glasgow London Manchester Newcastle Reading Southampton

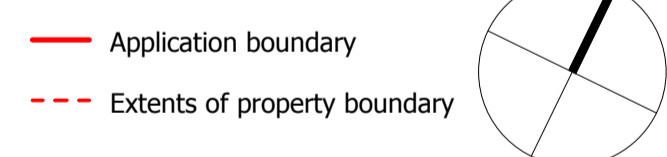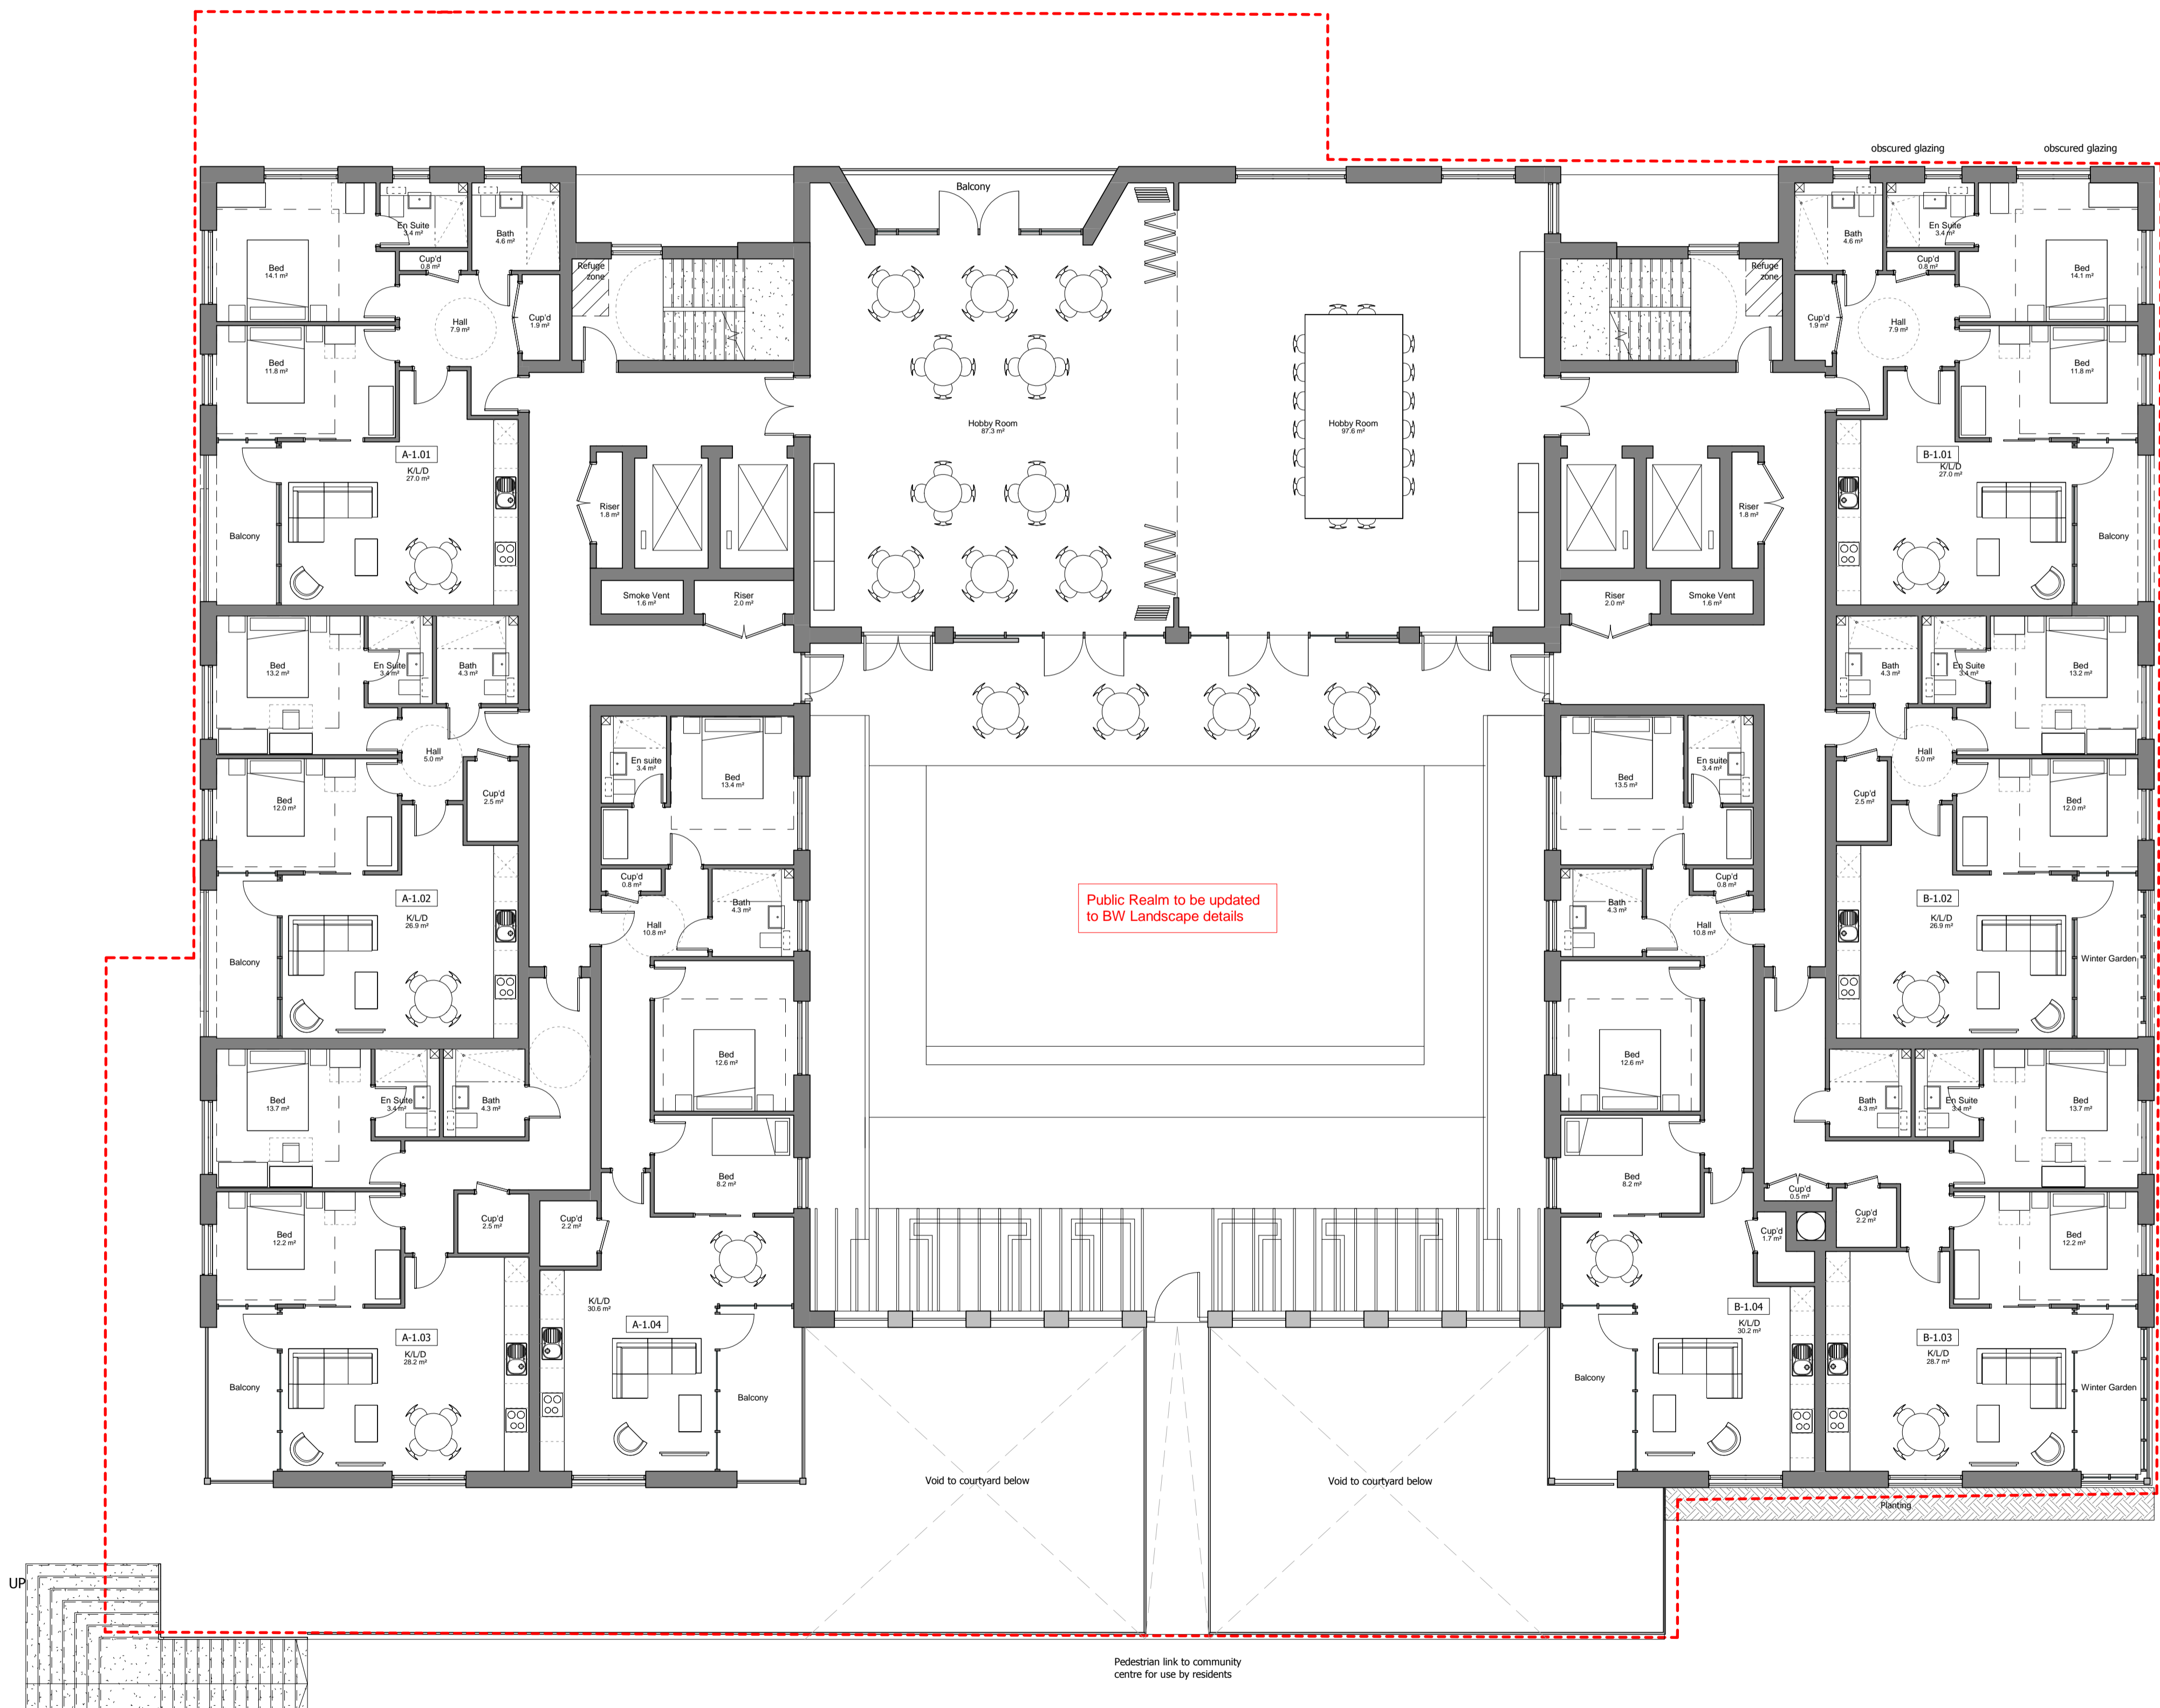



**FOR COMMENT**

Project  
 11-12 Ingestre Road, Camden  
 Assisted Living Development  
 Drawing Title  
 Proposed Plans  
 First Floor  
 Date 05/06/18 Scale As indicated @ A1 Drawn by DC Check by PN  
 Project No 27463 Drawing No A-P11-02 Revision

**01 First Floor Plan**  
 1 : 100

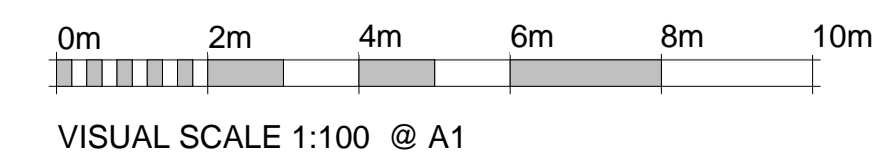


**BARTON DRAFT WILLMORE**  
 Planning • Master Planning & Urban Design • Architecture • Landscape Planning & Design • Environmental Planning • Graphics Communication • Public Engagement • Research  
 bartonwillmore.co.uk  
 Offices at Bristol Cambridge Cardiff Edinburgh Glasgow London Manchester Newcastle Reading Solihull Southampton

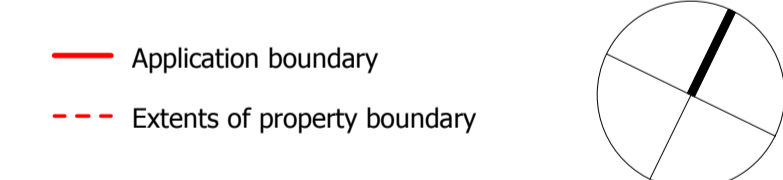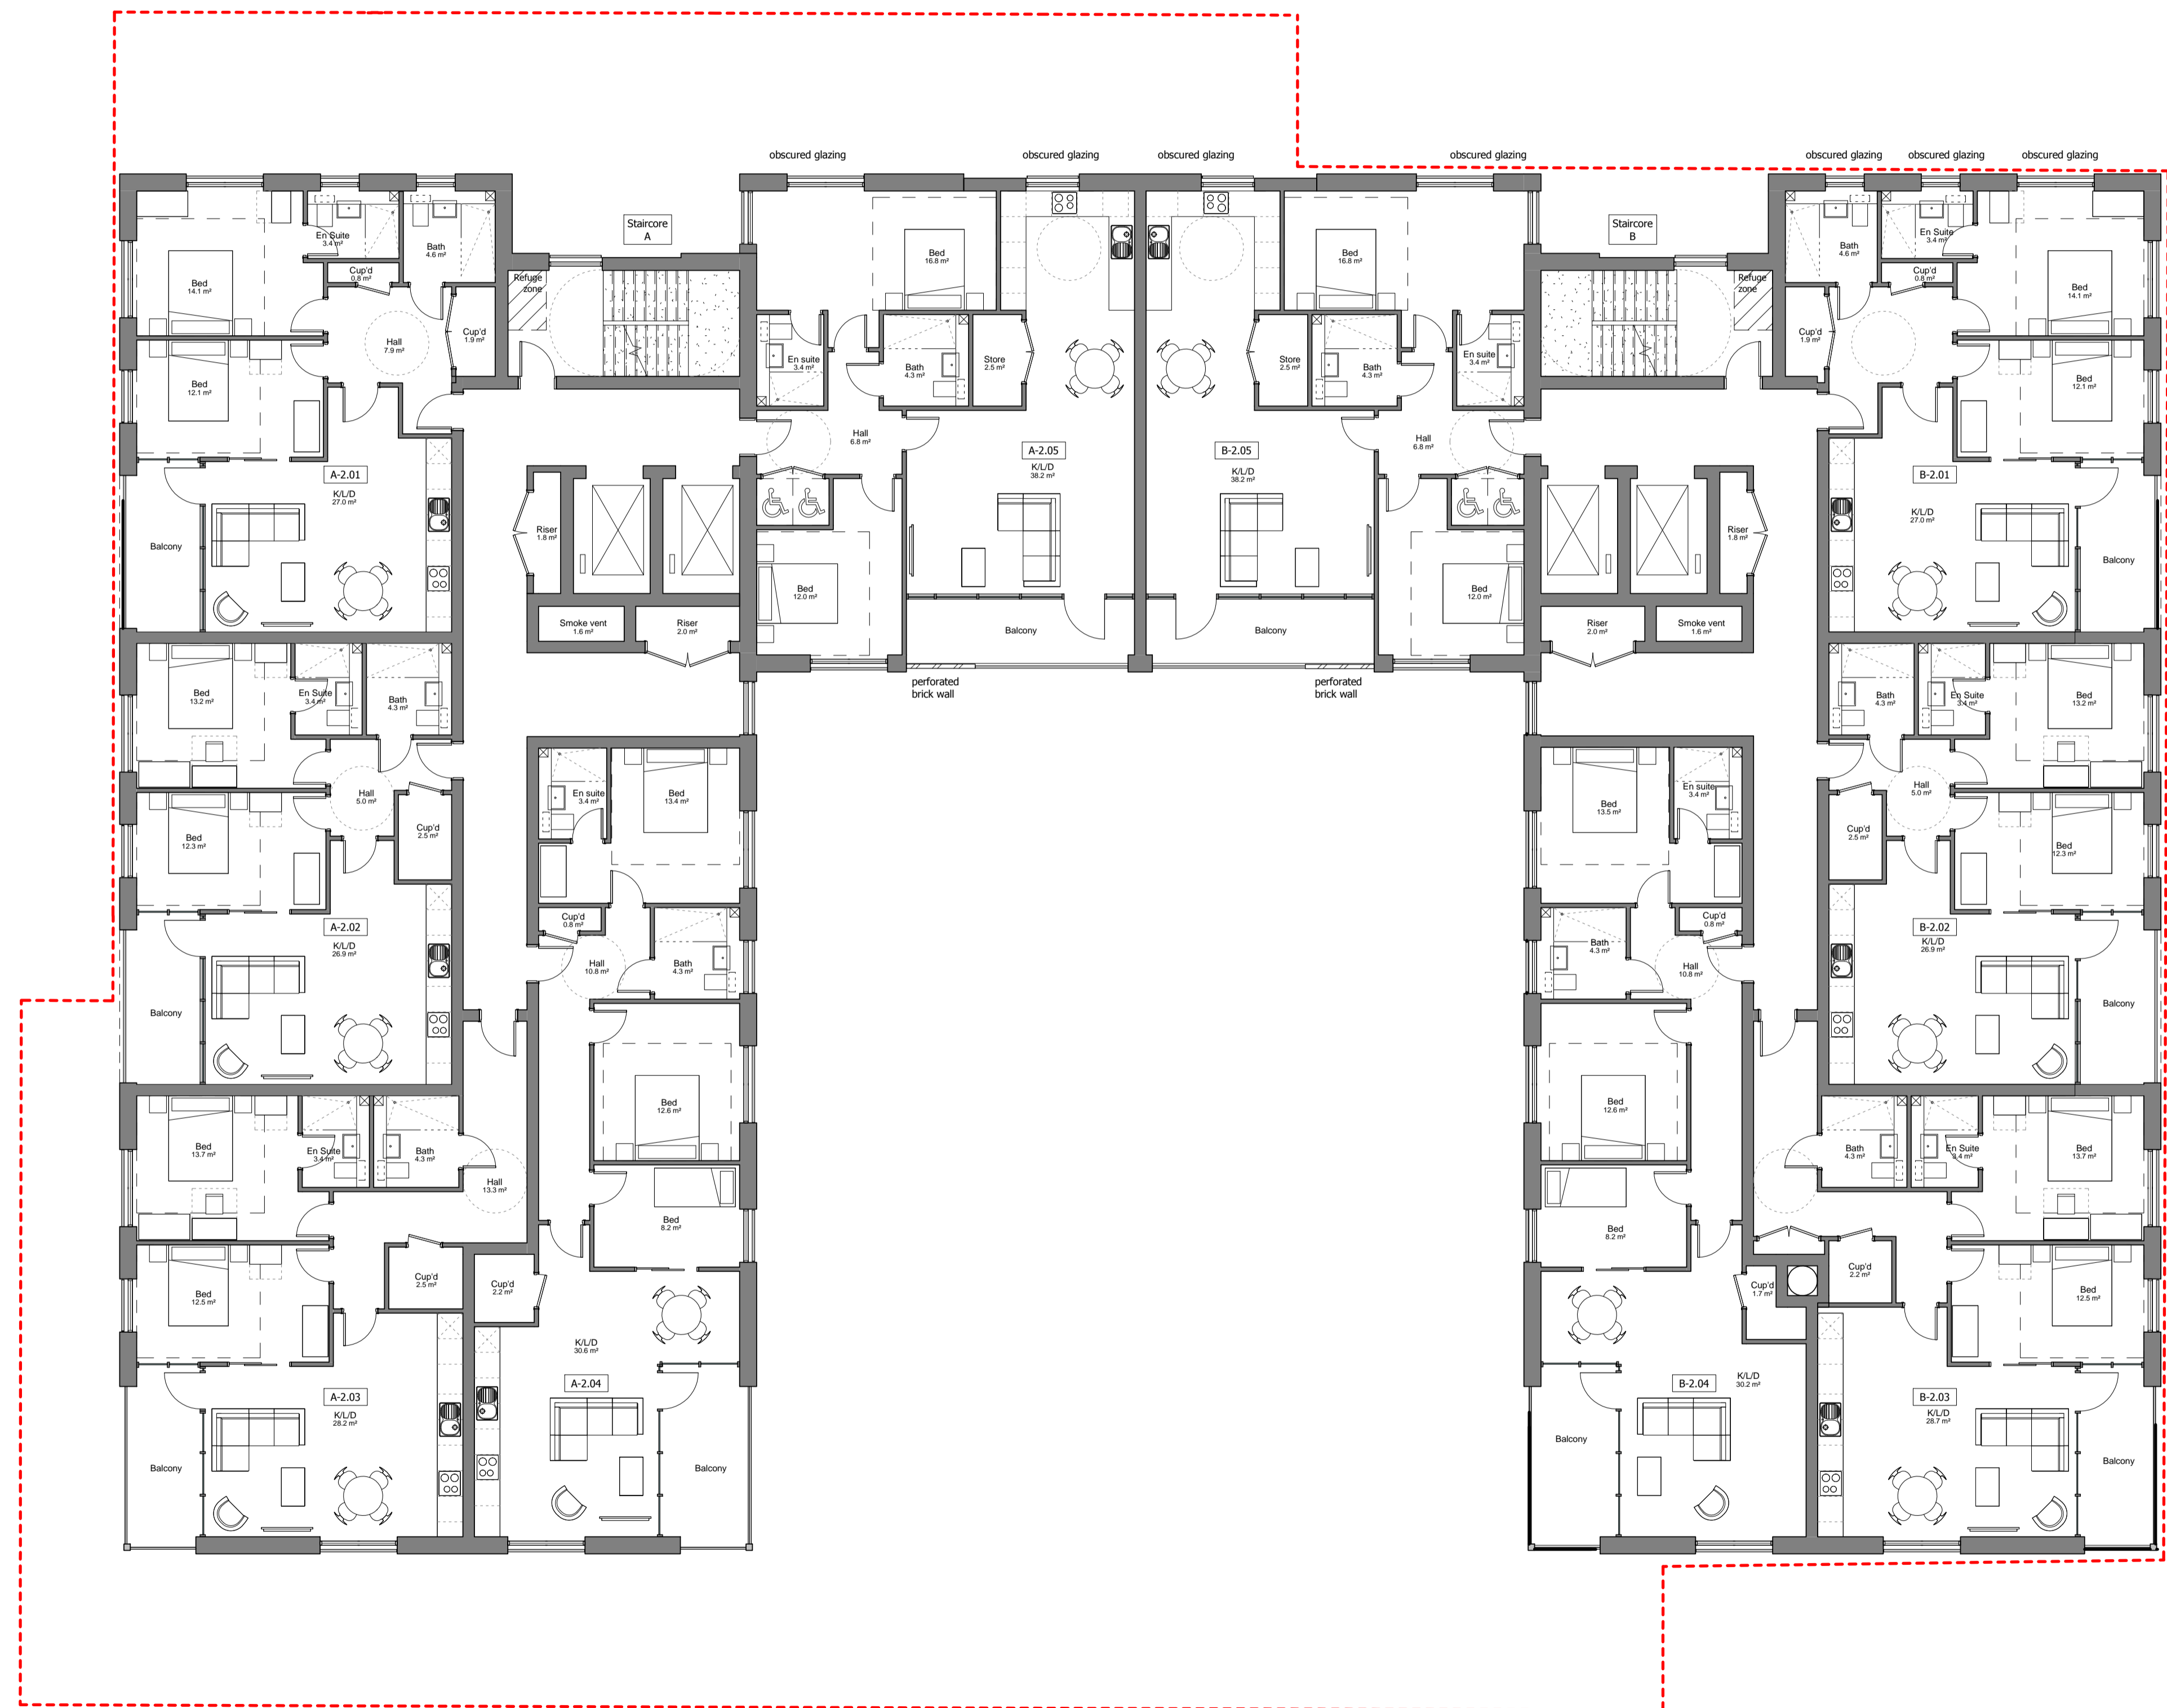



**FOR COMMENT**

Project  
 11-12 Ingestre Road, Camden  
 Assisted Living Development  
 Drawing Title  
 Proposed Plans  
 Second Floor  
 Date 05/06/18 Scale As indicated @ A1 Drawn by DC Check by PN  
 Project No 27463 Drawing No A-P11-03 Revision A

**02 Second Floor Plan**  
 1 : 100

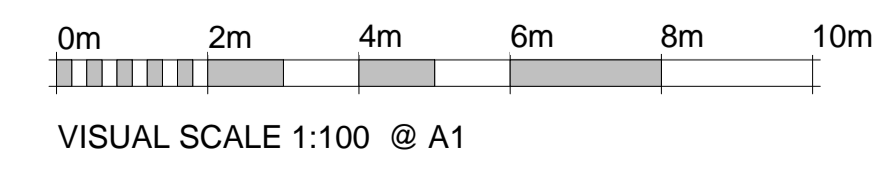


**BARTON DRAFT WILLMORE**  
 Planning • Master Planning & Urban Design • Architecture • Landscape Planning & Design • Environmental Planning • Graphics Communication • Public Engagement • Research  
 bartonwillmore.co.uk  
 Offices at Bristol Cambridge Cardiff Edinburgh Glasgow London Manchester Newcastle Reading Solihull Southampton

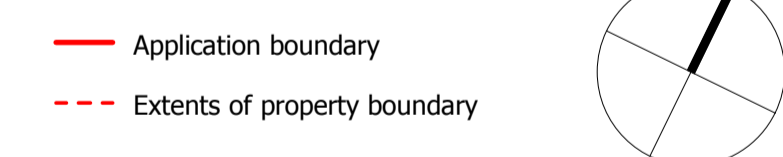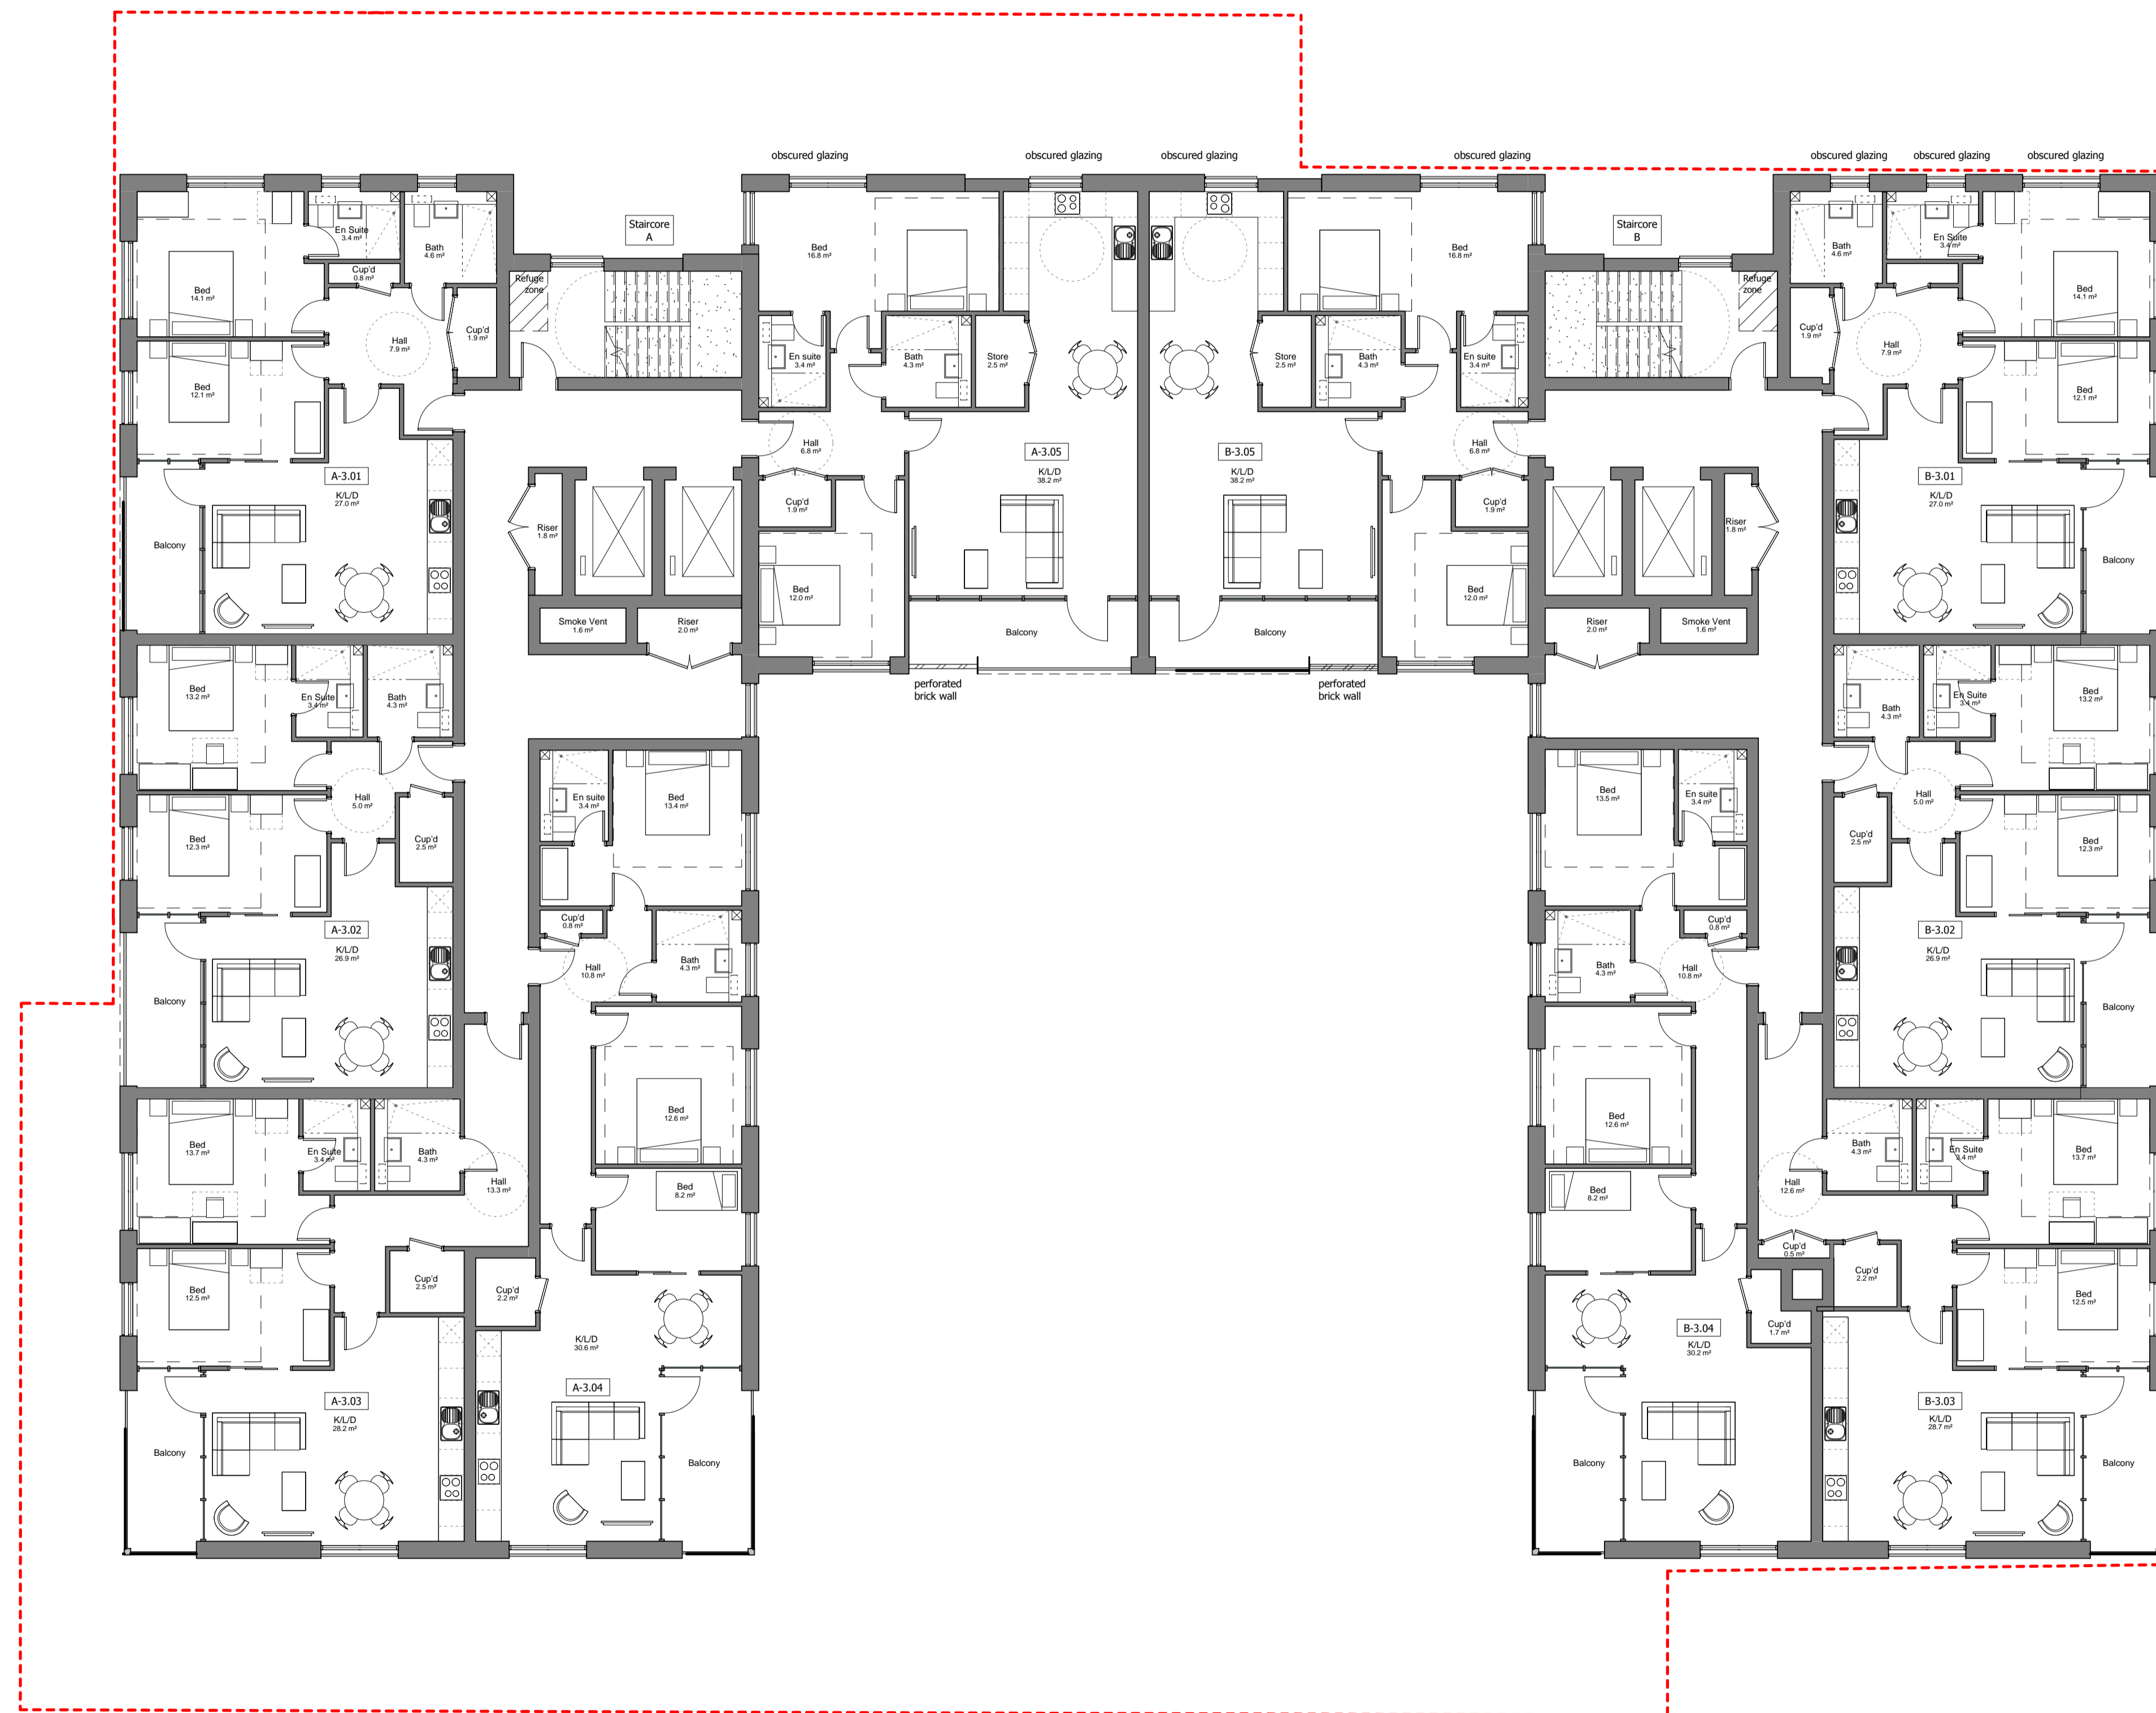

**FOR COMMENT**



Project  
 11-12 Ingestre Road, Camden  
 Assisted Living Development  
 Drawing Title  
 Proposed Plans  
 Third Floor  
 Date 05/06/18 Scale As indicated @ A1 Drawn by DC Check by PN  
 Project No 27463 Drawing No A-P11-04 Revision

**03 Third Floor Plan**  
 1 : 100

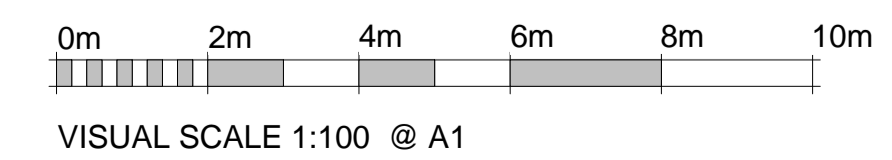

**BARTON DRAFT WILLMORE**  
 Planning • Master Planning & Urban Design • Architecture • Landscape Planning & Design • Environmental Planning • Graphics Communication • Public Engagement • Research  
 bartonwillmore.co.uk  
 Offices at Bristol Cambridge Cardiff Edinburgh Glasgow London Manchester Newcastle Reading Solihull Southampton




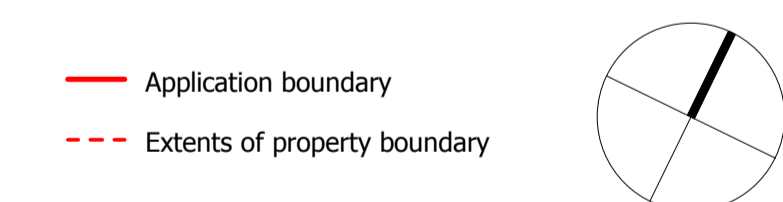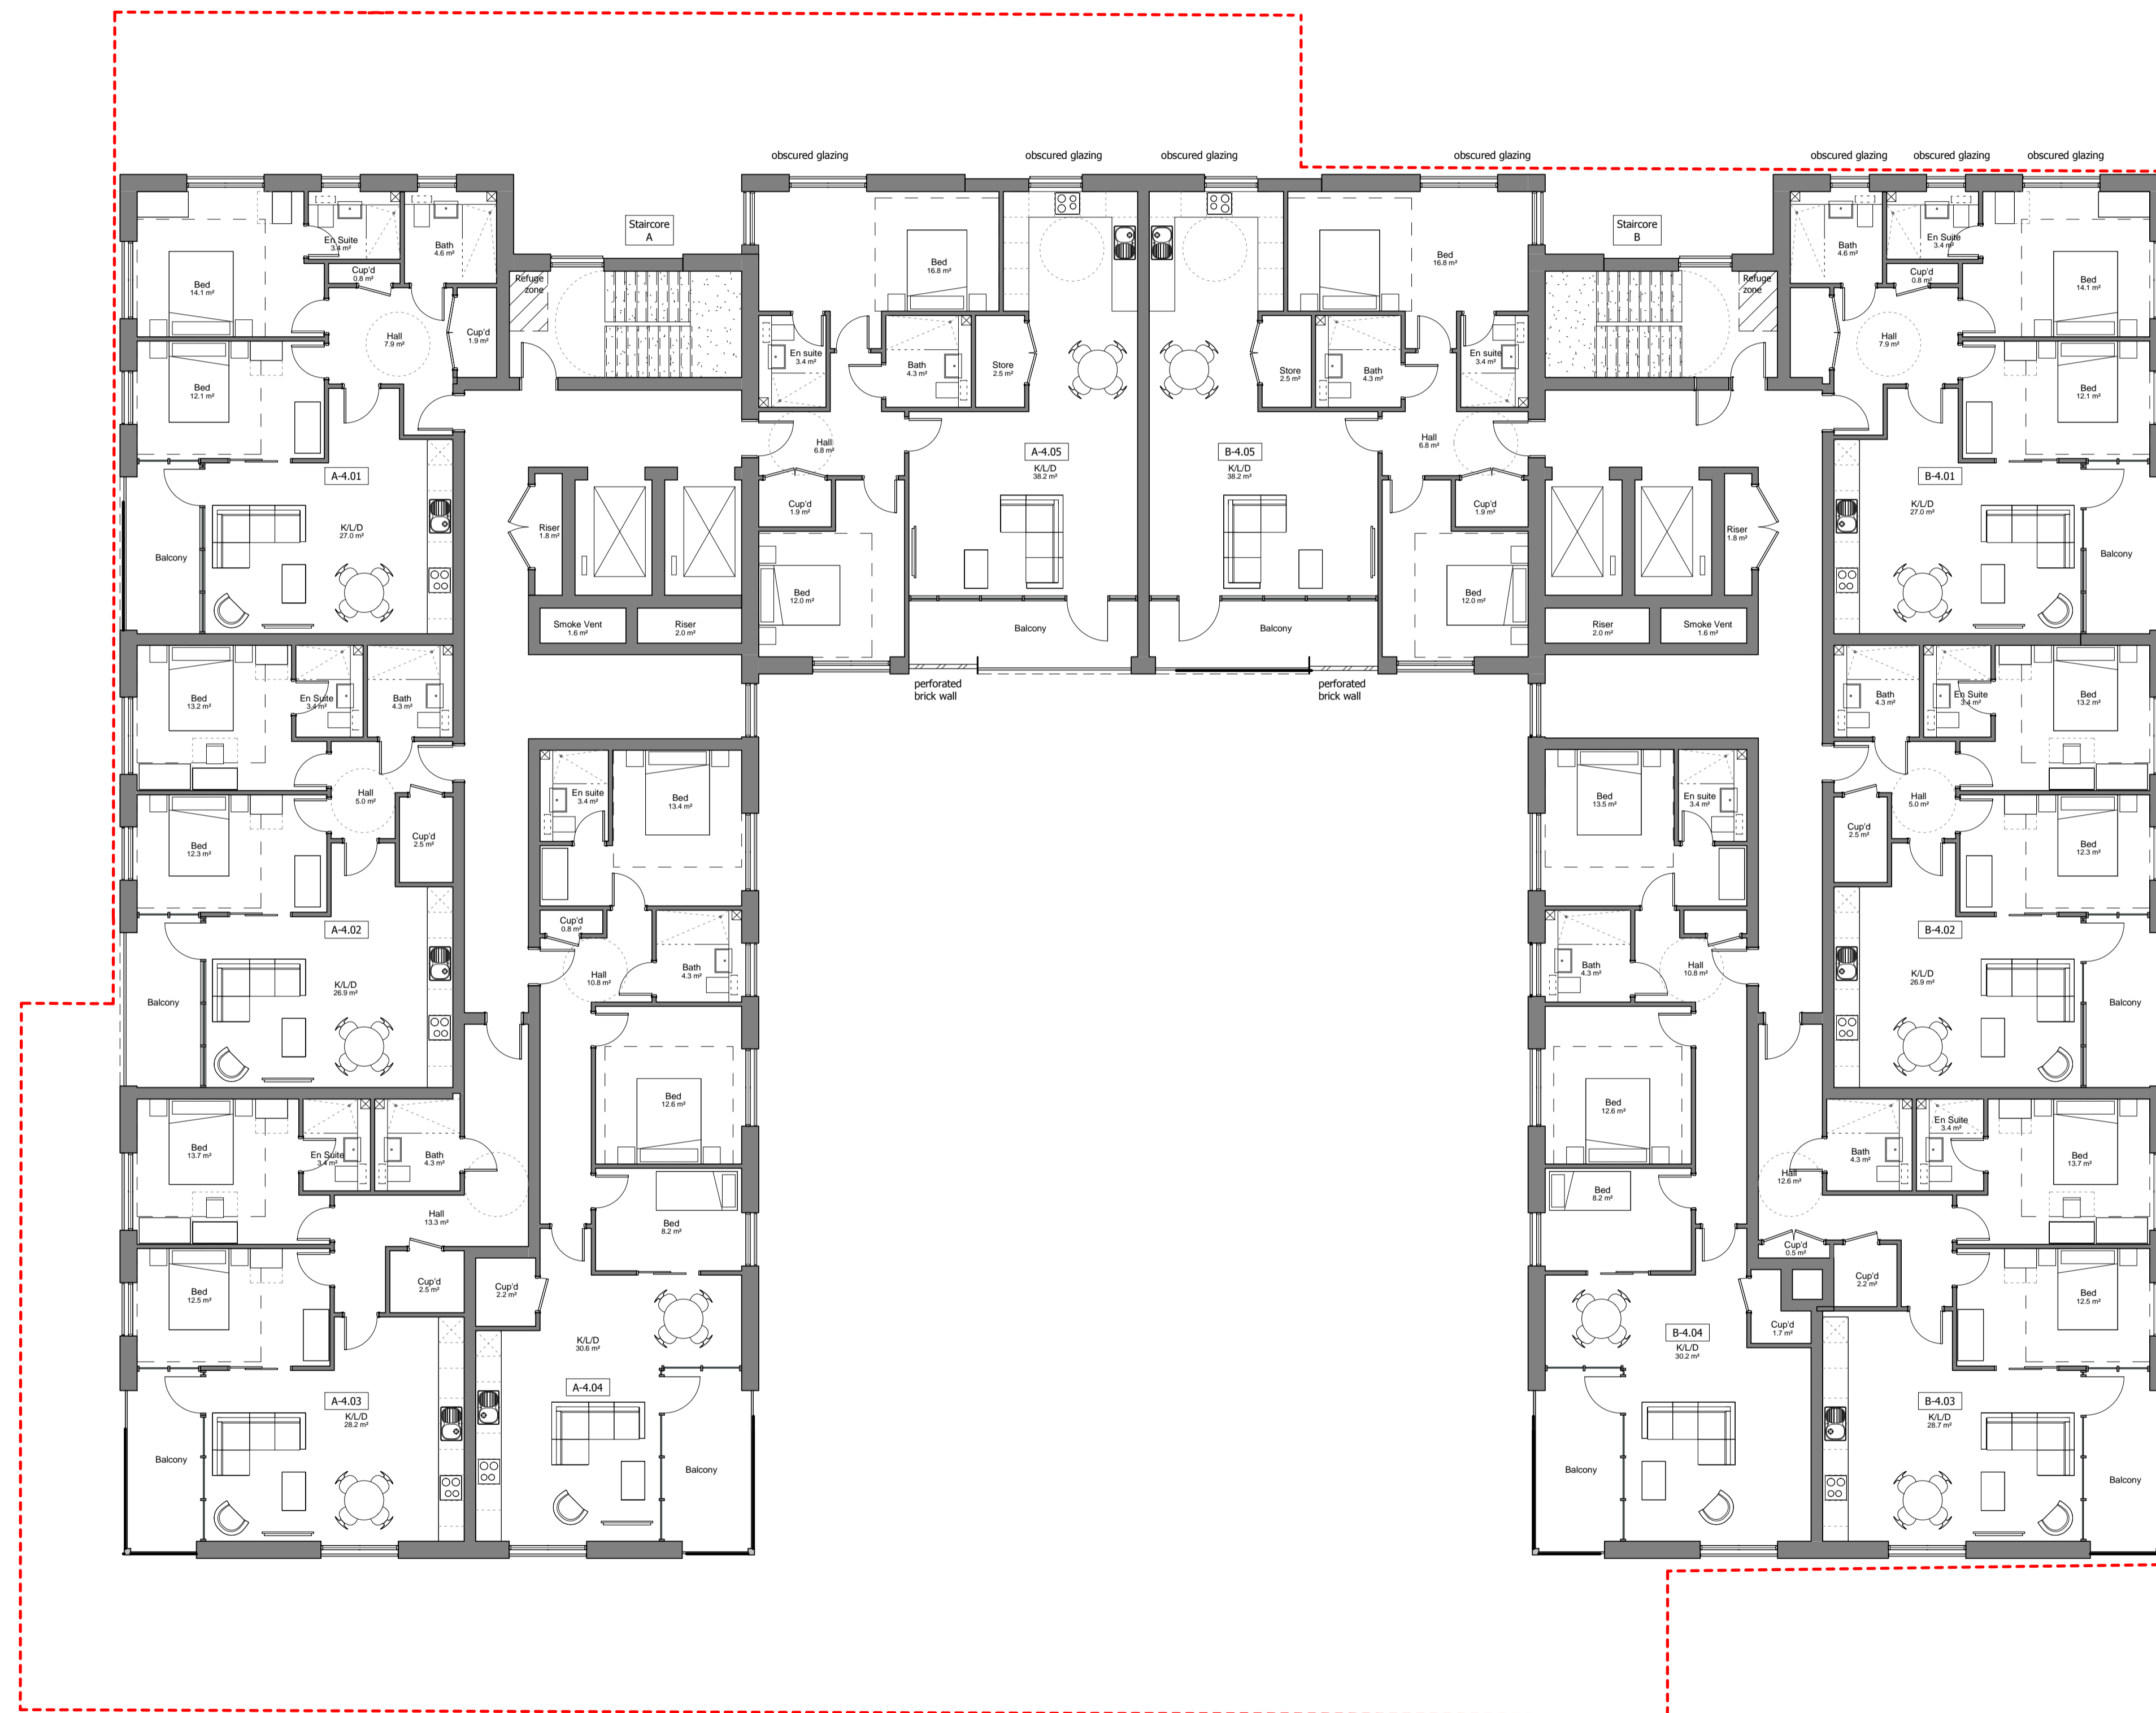


**FOR COMMENT**

Project  
 11-12 Ingestre Road, Camden  
 Assisted Living Development  
 Drawing Title  
 Proposed Plans  
 Fourth Floor Plan  
 Date 05/06/18 Scale As indicated @ A1 Drawn by DC Check by PN  
 Project No 27463 Drawing No A-P11-05 Revision

**04 Fourth Floor Plan**  
 1 : 100

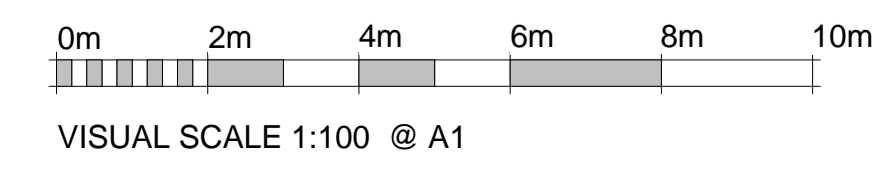


**BARTON DRAFT WILLMORE**  
 Planning • Master Planning & Urban Design • Architecture • Landscape Planning & Design • Environmental Planning • Graphics Communication • Public Engagement • Research  
 bartonwillmore.co.uk  
 Offices at Bristol Cambridge Cardiff Edinburgh Leeds London Manchester Newcastle Reading Solihull Southampton

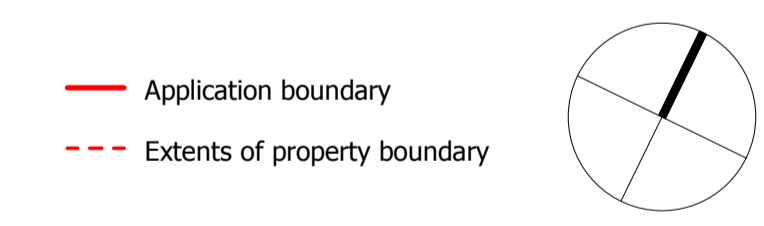


**05 Fifth Floor Plan**  
 1 : 100

FOR COMMENT

Project  
**11-12 Ingestre Road, Camden**  
 Assisted Living Development  
 Drawing Title  
**Proposed Plans**  
**Fifth Floor Plan**  
 Date 05/06/18 Scale As indicated @ A1 Drawn by DC Check by PN  
 Project No 27463 Drawing No A-P11-06 Revision

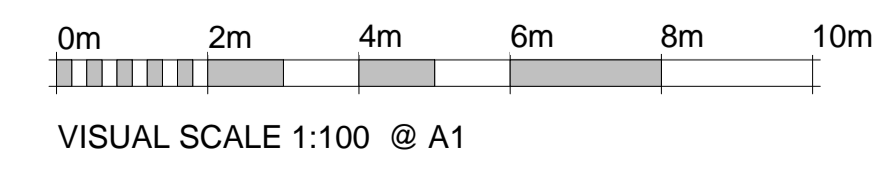

**BARTON DRAFT WILLMORE**  
 Planning • Master Planning & Urban Design • Architecture • Landscape Planning & Design • Environmental Planning • Graphics Communication • Public Engagement • Research  
 bartonwillmore.co.uk  
Offices at Bristol Cambridge Cardiff Edinburgh Glasgow London Manchester Newcastle Reading Solihull Southampton

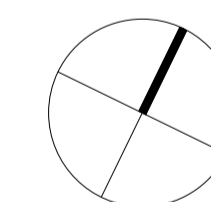

FOR COMMENT

Project  
 11-12 Ingestre Road, Camden  
 Assisted Living Development  
 Drawing Title  
 Roof Plan

Date	Scale	Drawn by	Check by
05/06/18	1 : 100 @ A1	DC	PN
Project No	Drawing No	Revision	
27463	A-P11-07	A	

**BARTON DRAFT WILLMORE**

Planning • Master Planning & Urban Design • Architecture • Landscape Planning & Design • Environmental Planning • Graphics Communication • Public Engagement • Research

bartonwillmore.co.uk

Offices at Bristol Cambridge Cardiff Edinburgh Glasgow London Manchester Newcastle Reading Solihull Southampton

**1** 06 Roof Plan  
 1 : 100




VISUAL SCALE 1:100 @ A1



Extents of red line to be agreed


Public Realm to be updated to BW Landscape details

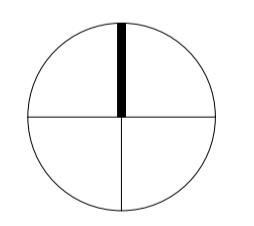

FOR COMMENT

Project  
11-12 Ingestre Road, Camden  
Assisted Living Development  
Drawing Title  
Site Plan - Ground Floor

Date	Scale	Drawn by	Check by
05/06/18	1 : 200 @ A1	DC	PN
Project No	Drawing No	Revision	
27463	A-P11-10		

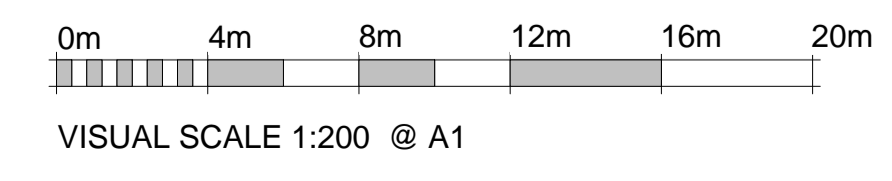

**BARTON WILLMORE**  
DRAFT  
Planning • Master Planning & Urban Design • Architecture • Landscape Planning & Design • Environmental Planning • Graphics Communication • Public Engagement • Research  
bartonwillmore.co.uk  
Offices at Bristol Cambridge Cardiff Edinburgh Edinburgh Leeds London Manchester Newcastle Reading Solihull Southampton