




GREAT RUSSELL STREET. - HORSE SHOE HOTEL -STAGE. AUDITORIUM. ENTRANCE. BAINBRIDGE.D DOMINION THEATRE. COURT ROAD . TOTTENHAM NEW OXFORD STREET SIXTEEN FEET TO AN INCH. WM. & T.R. MILBURN, F.F.R.I.B.A., ARCHITECTS & SURVEYORS, SUNDERLAND AND LONDON. JANUARY 1928. SITE PLAN - Company of the Comp

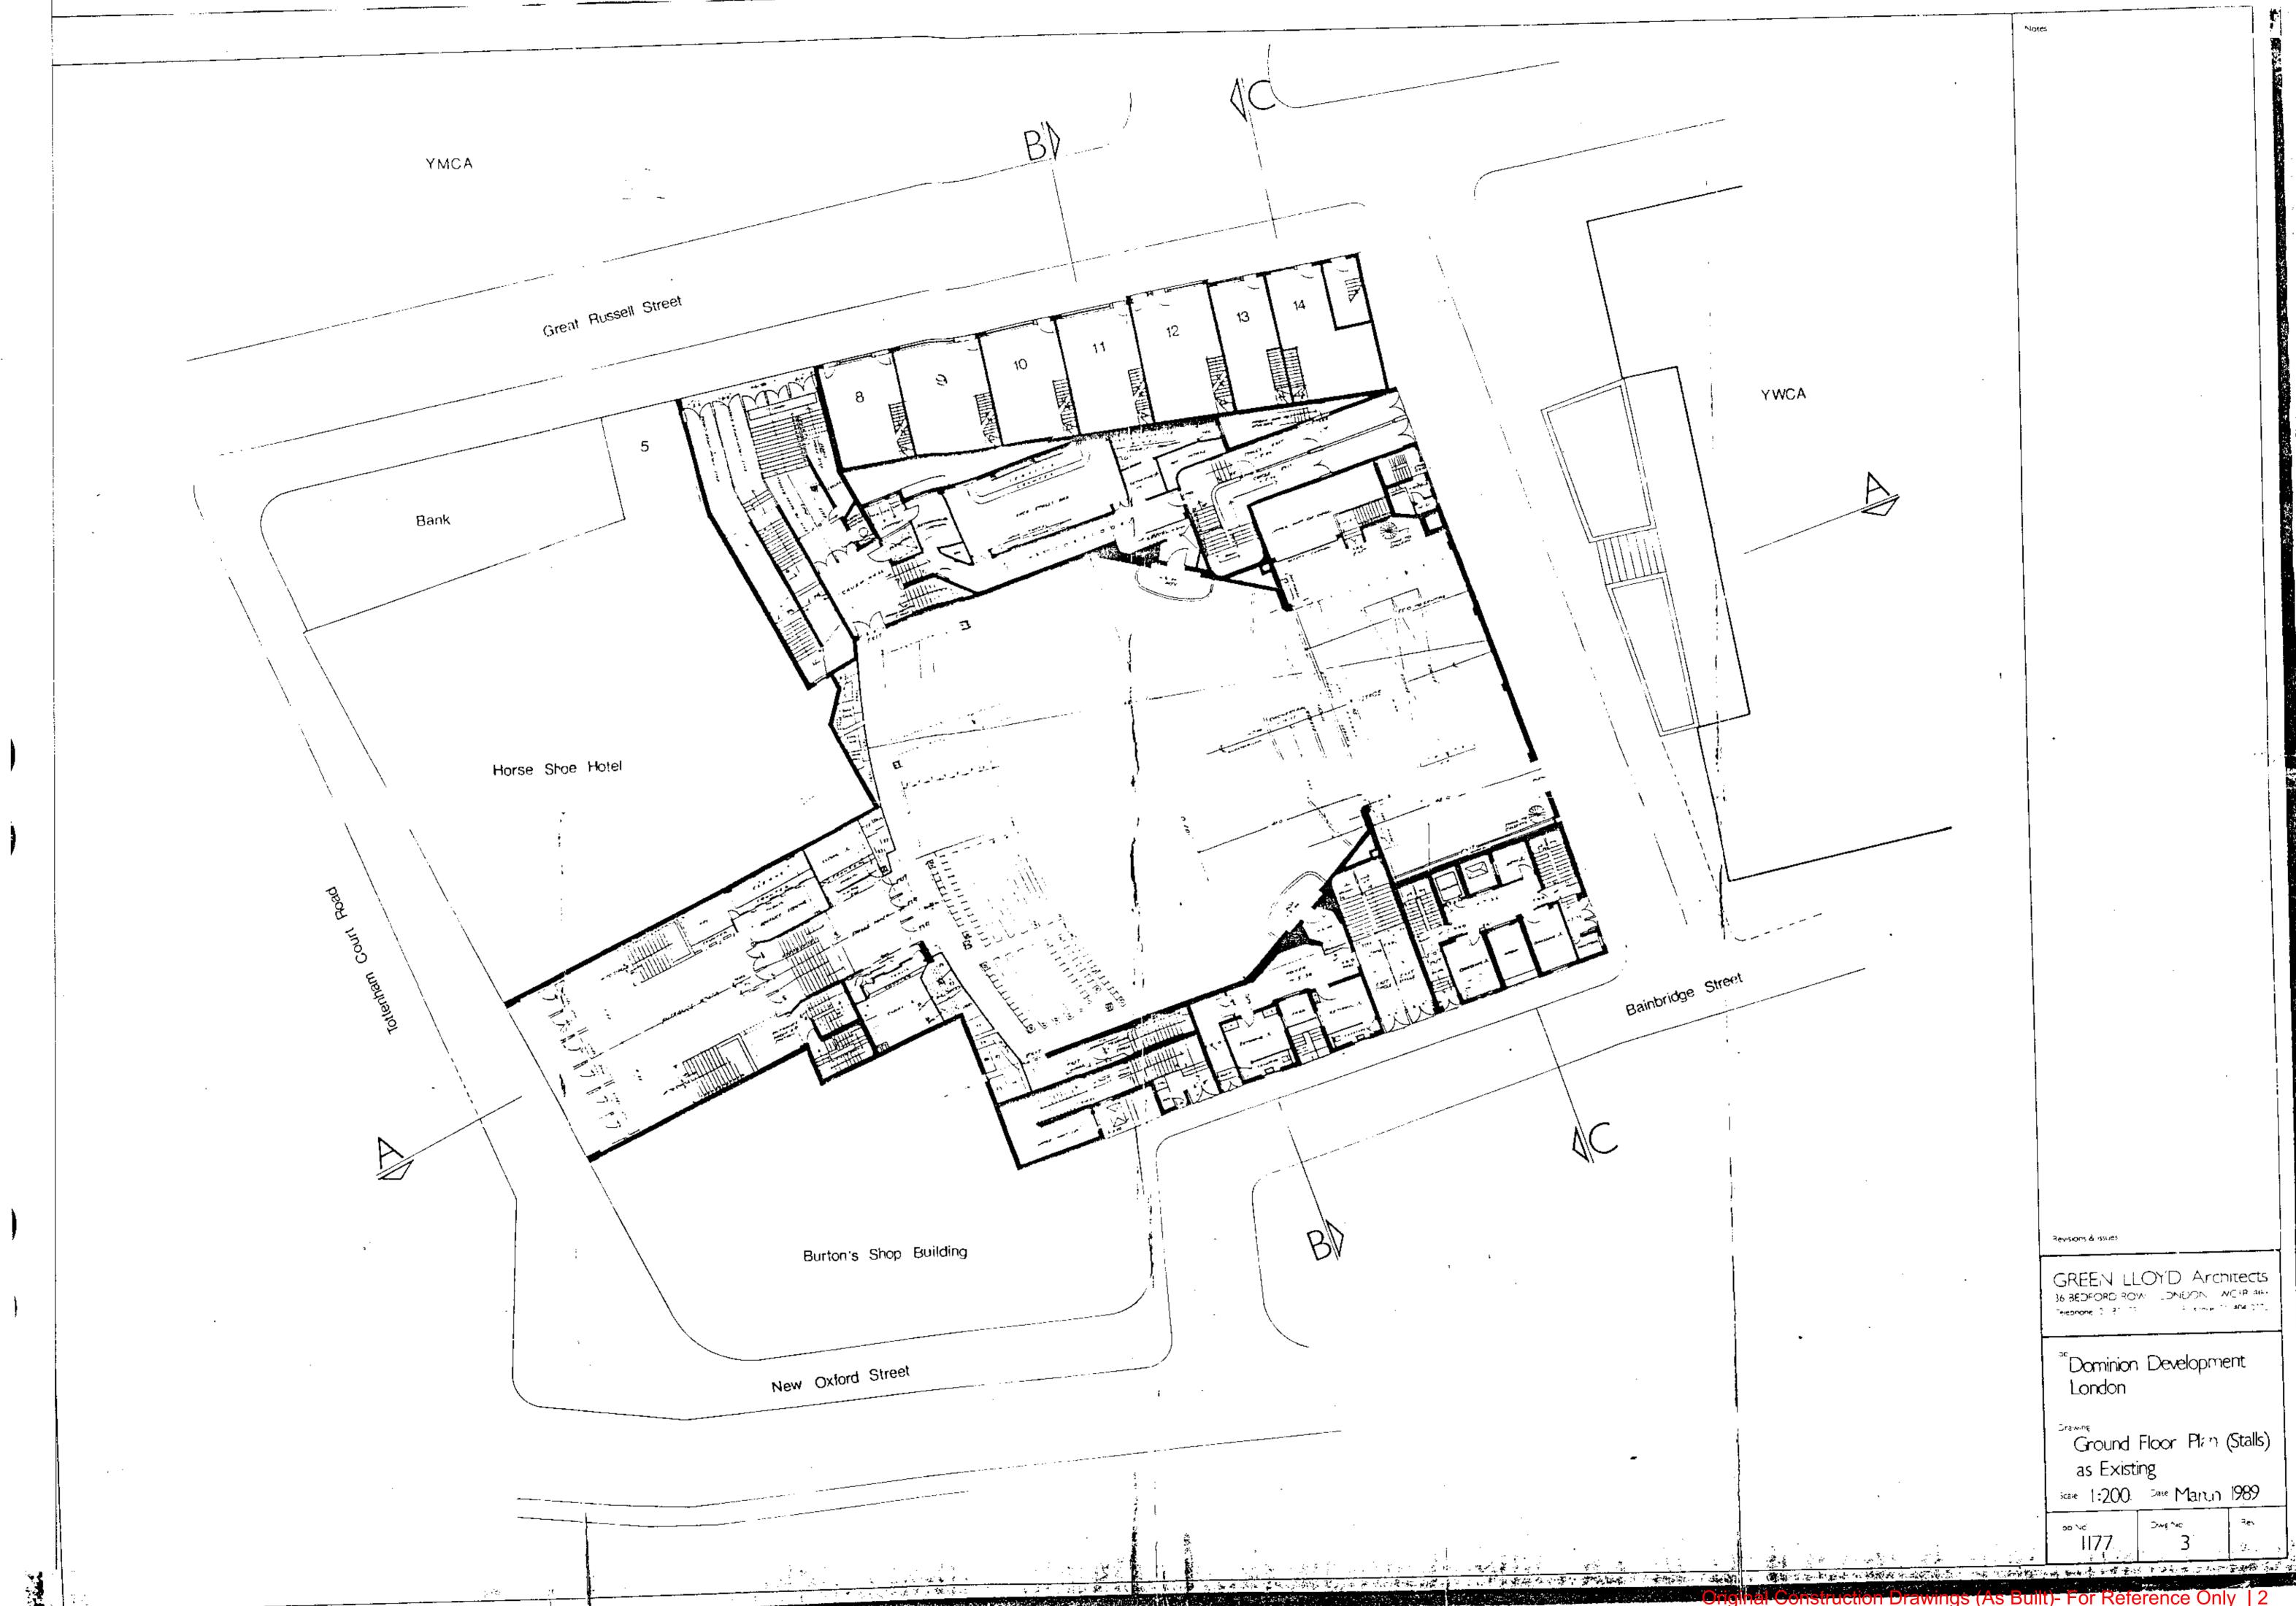


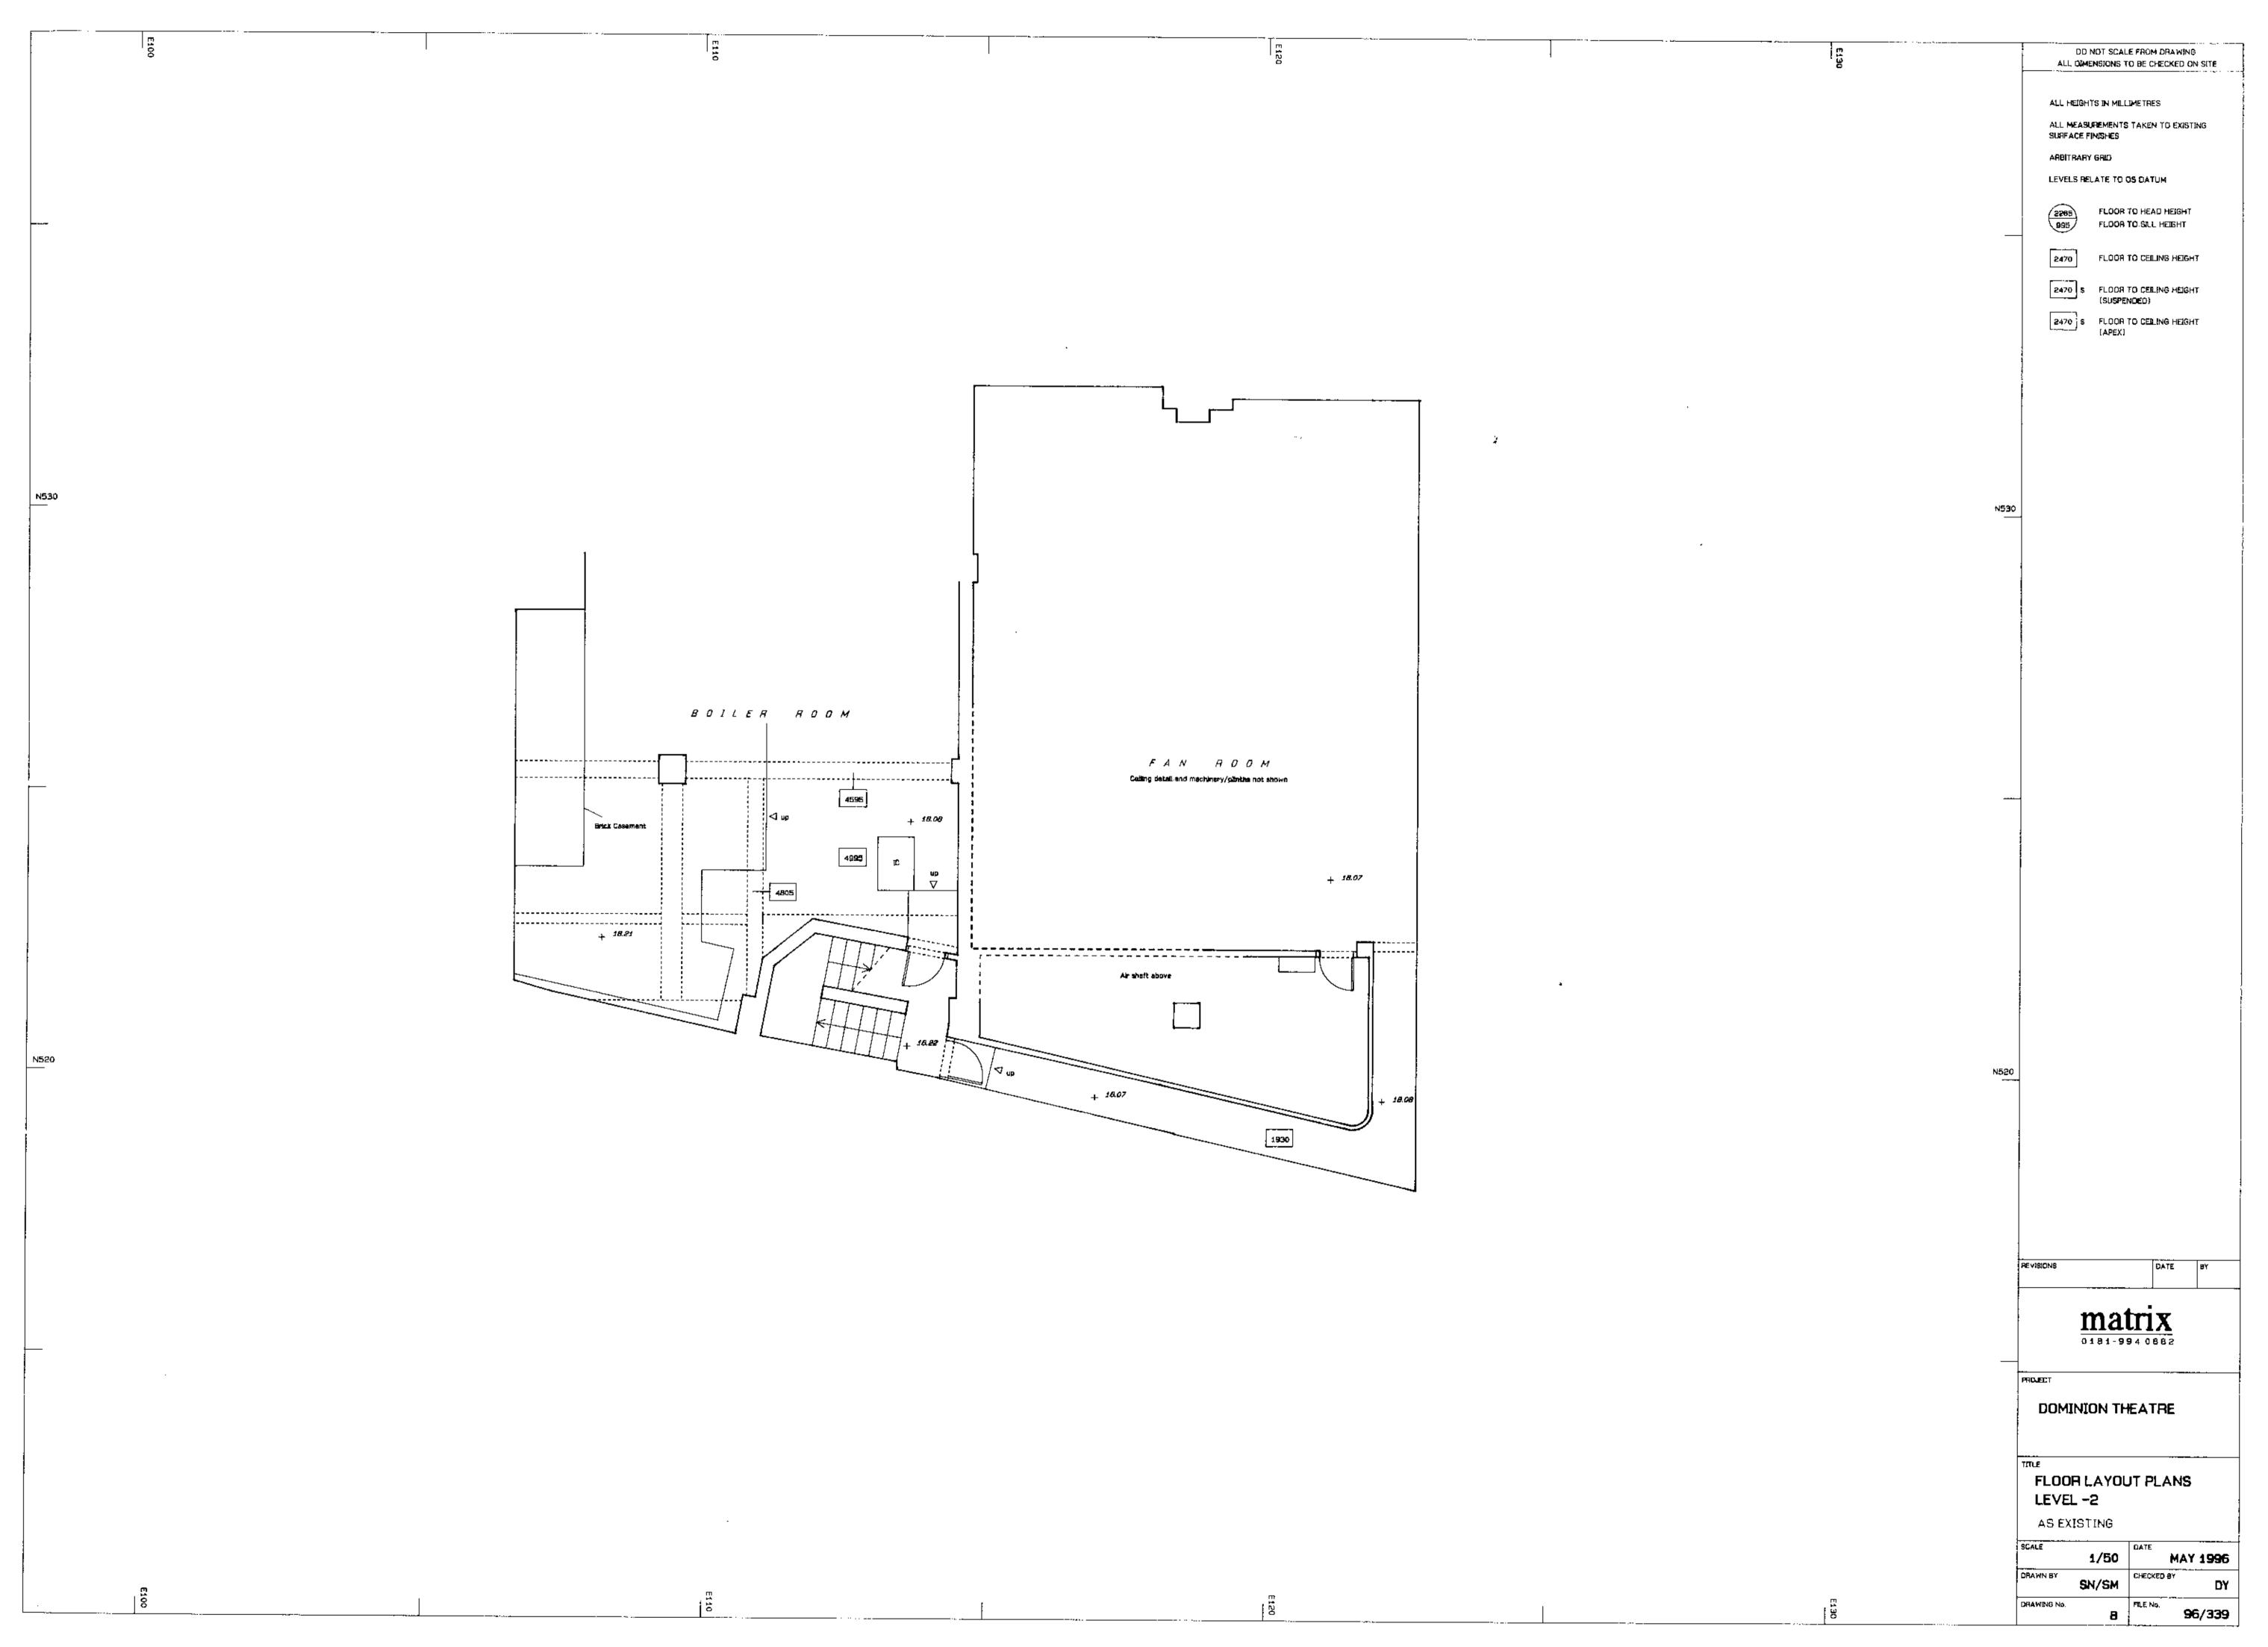


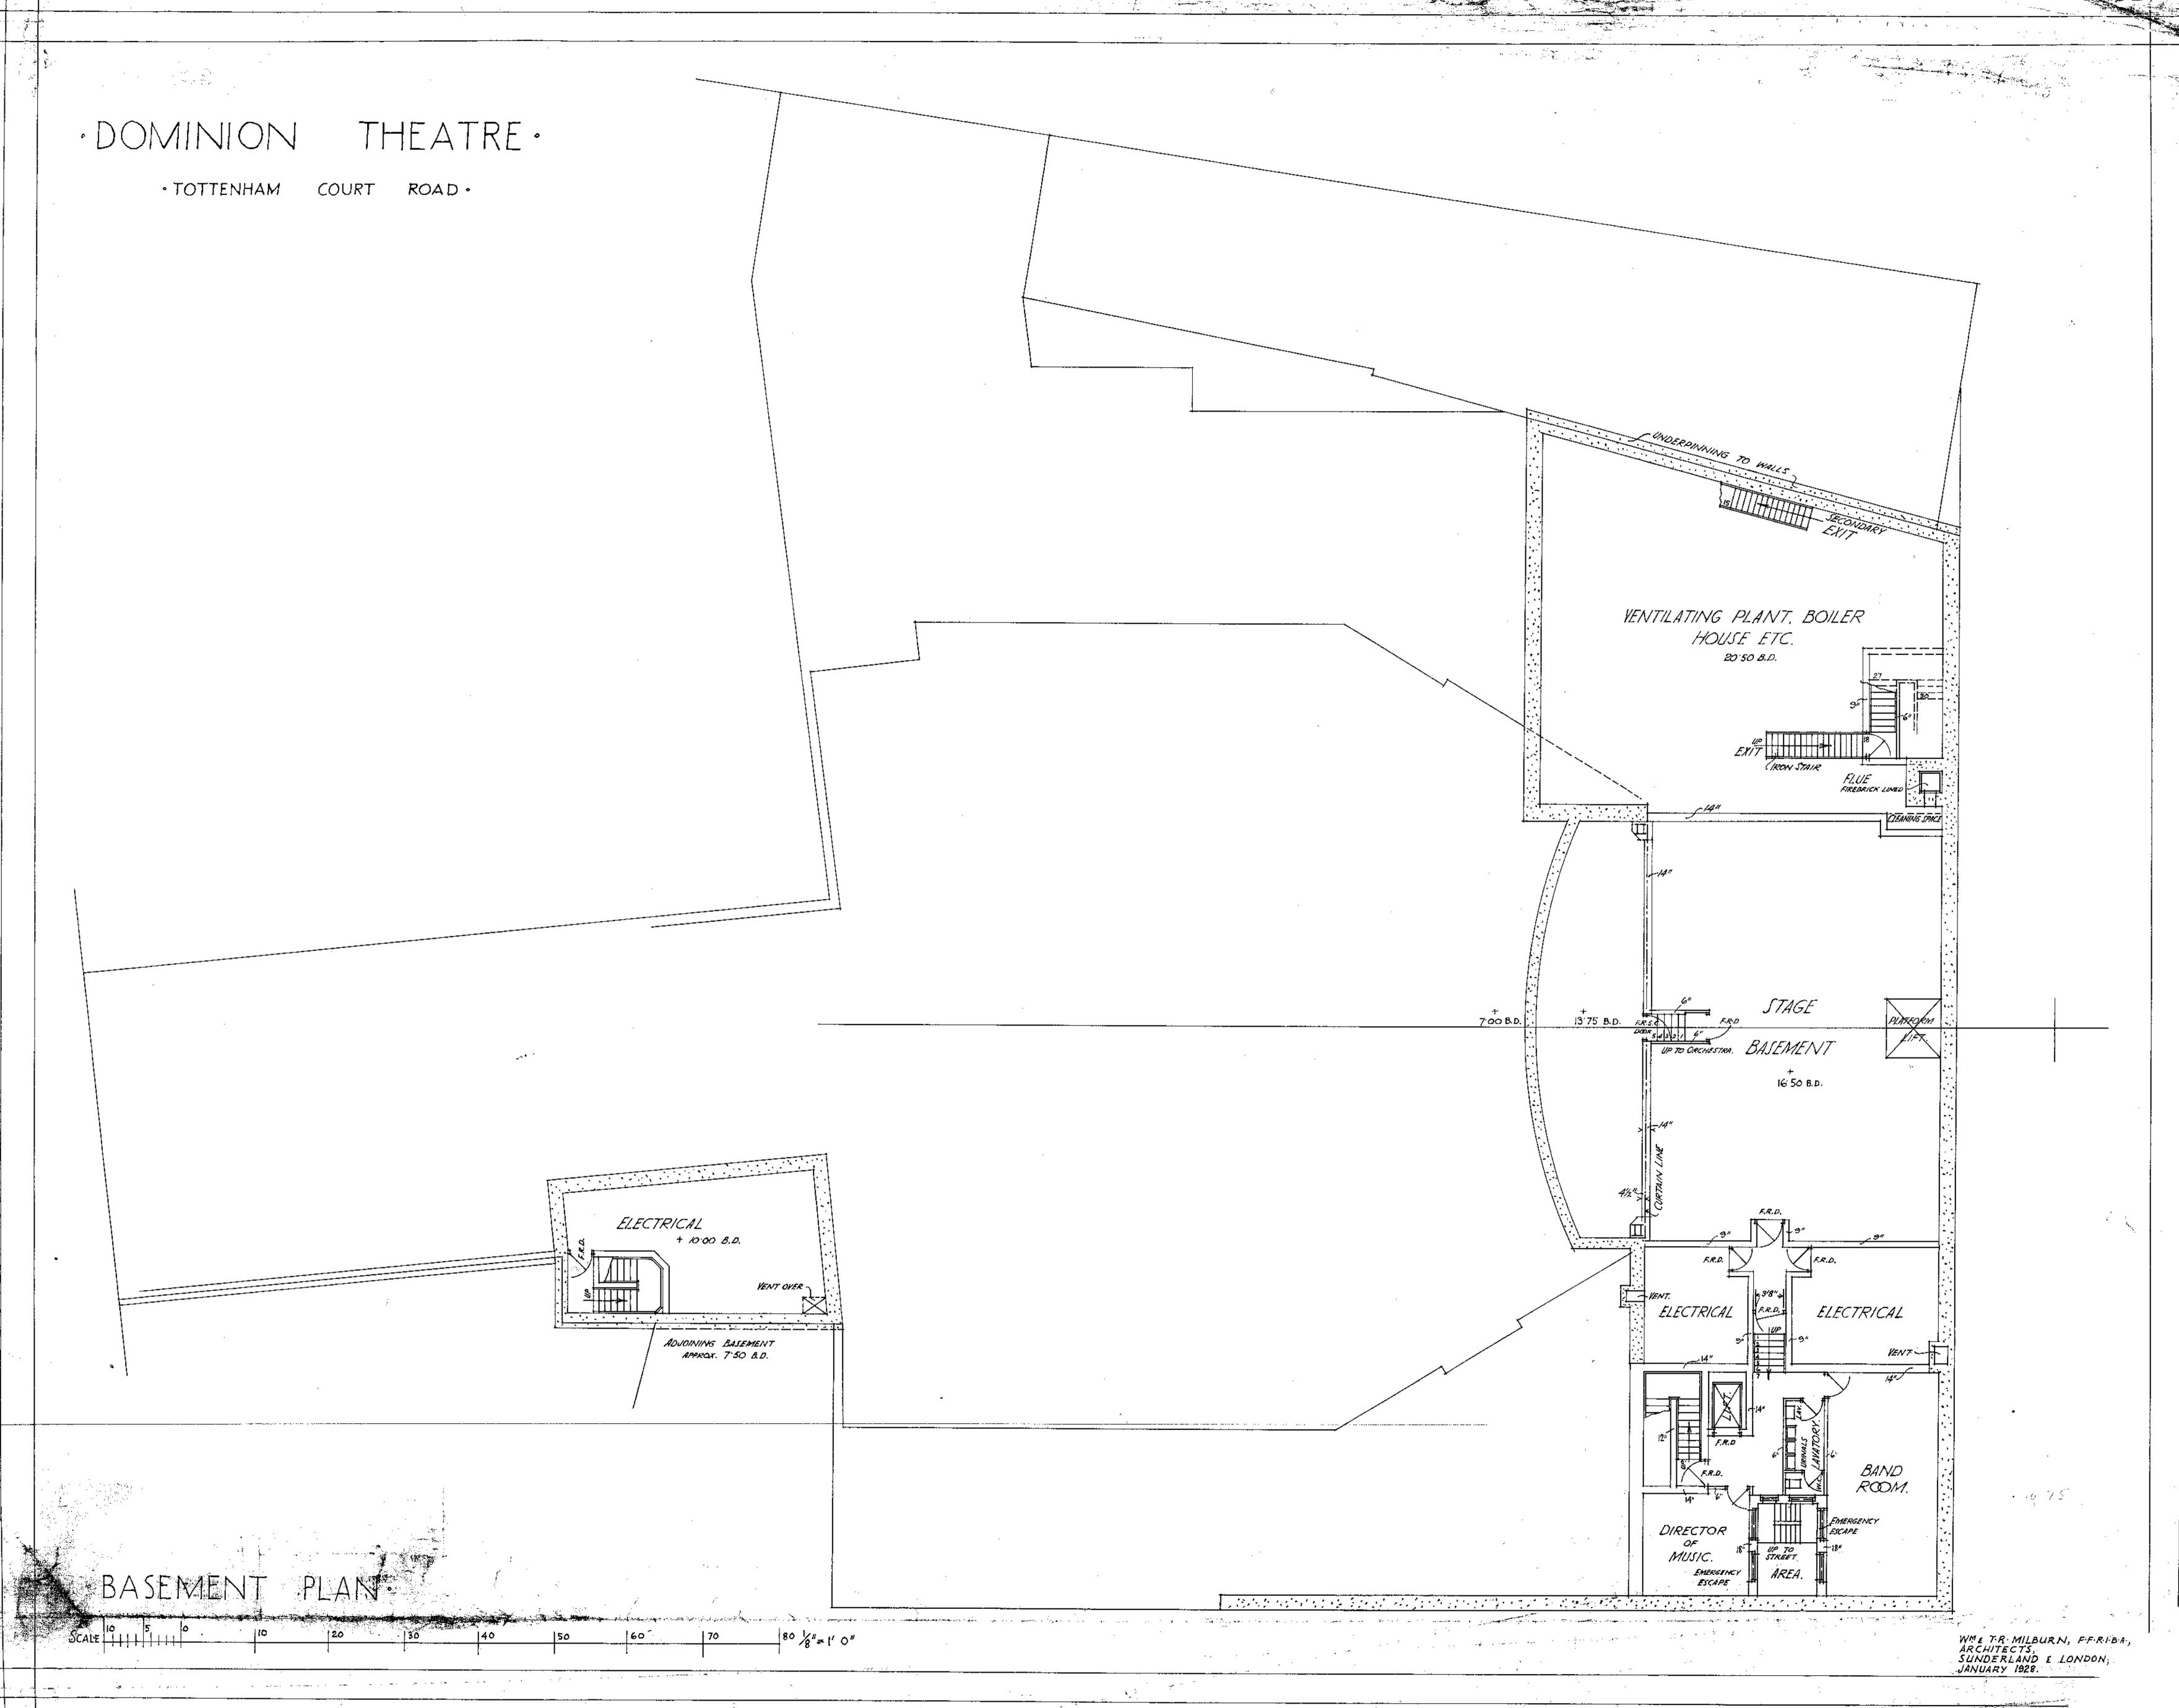


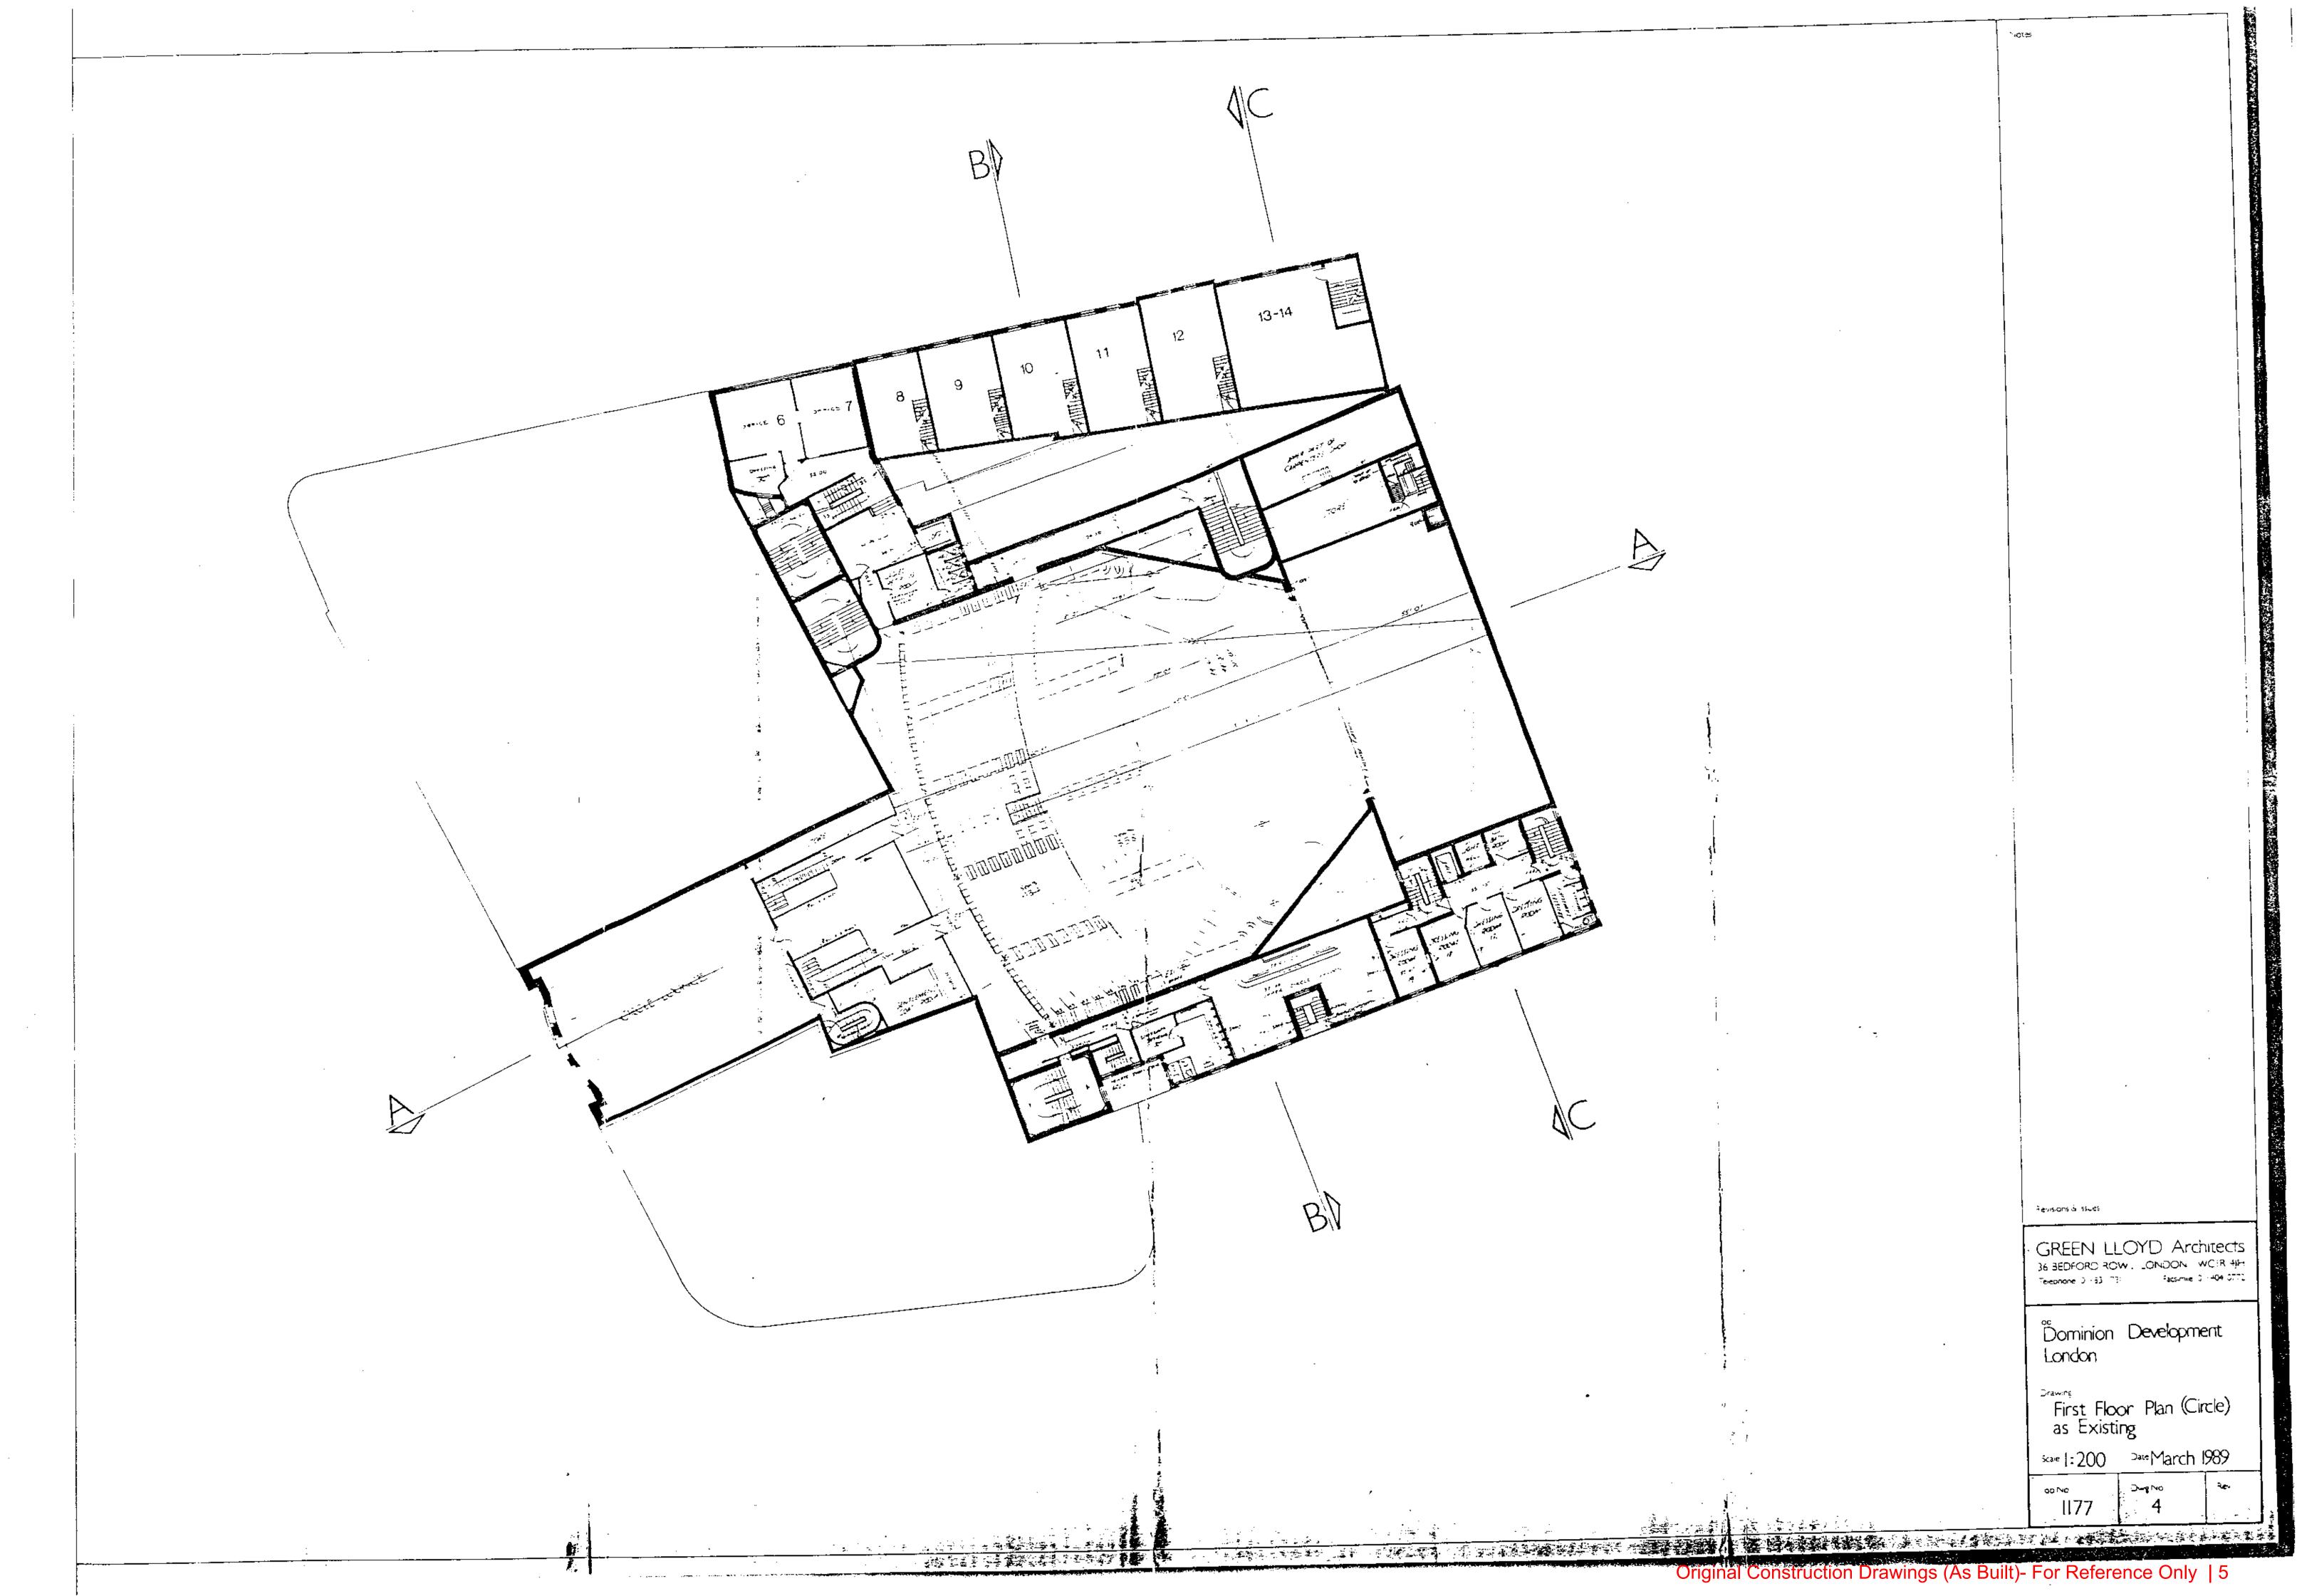

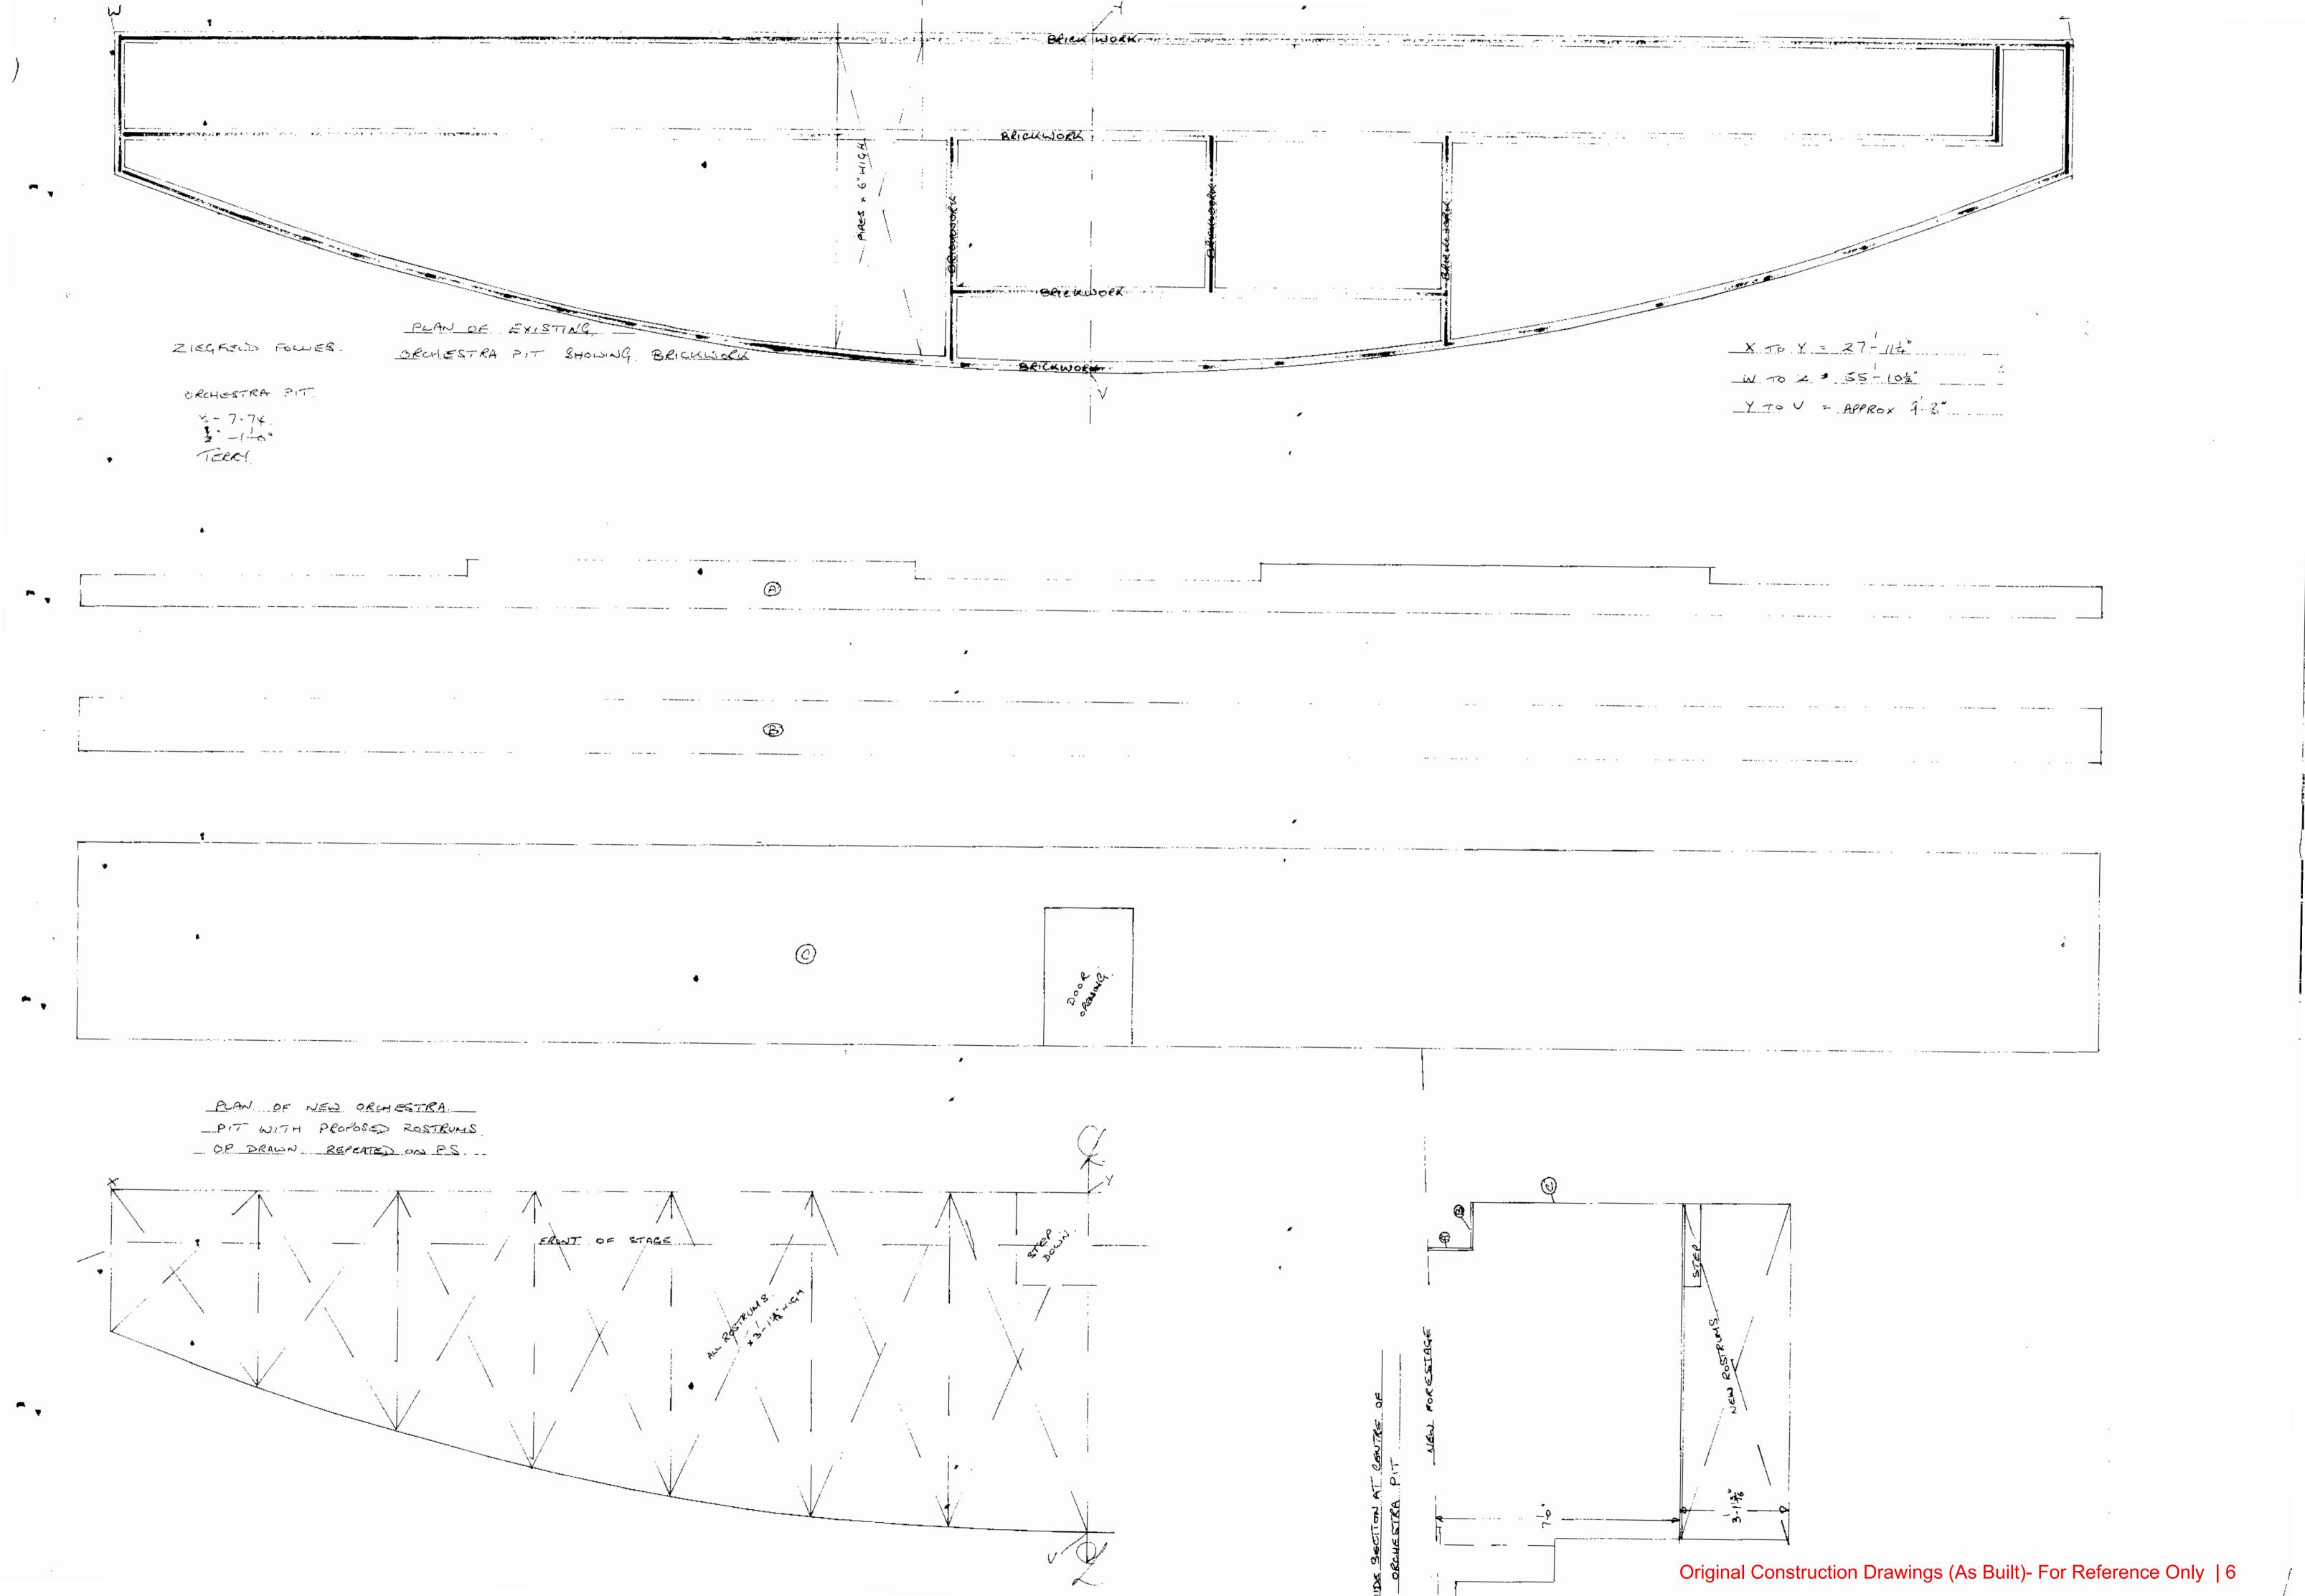

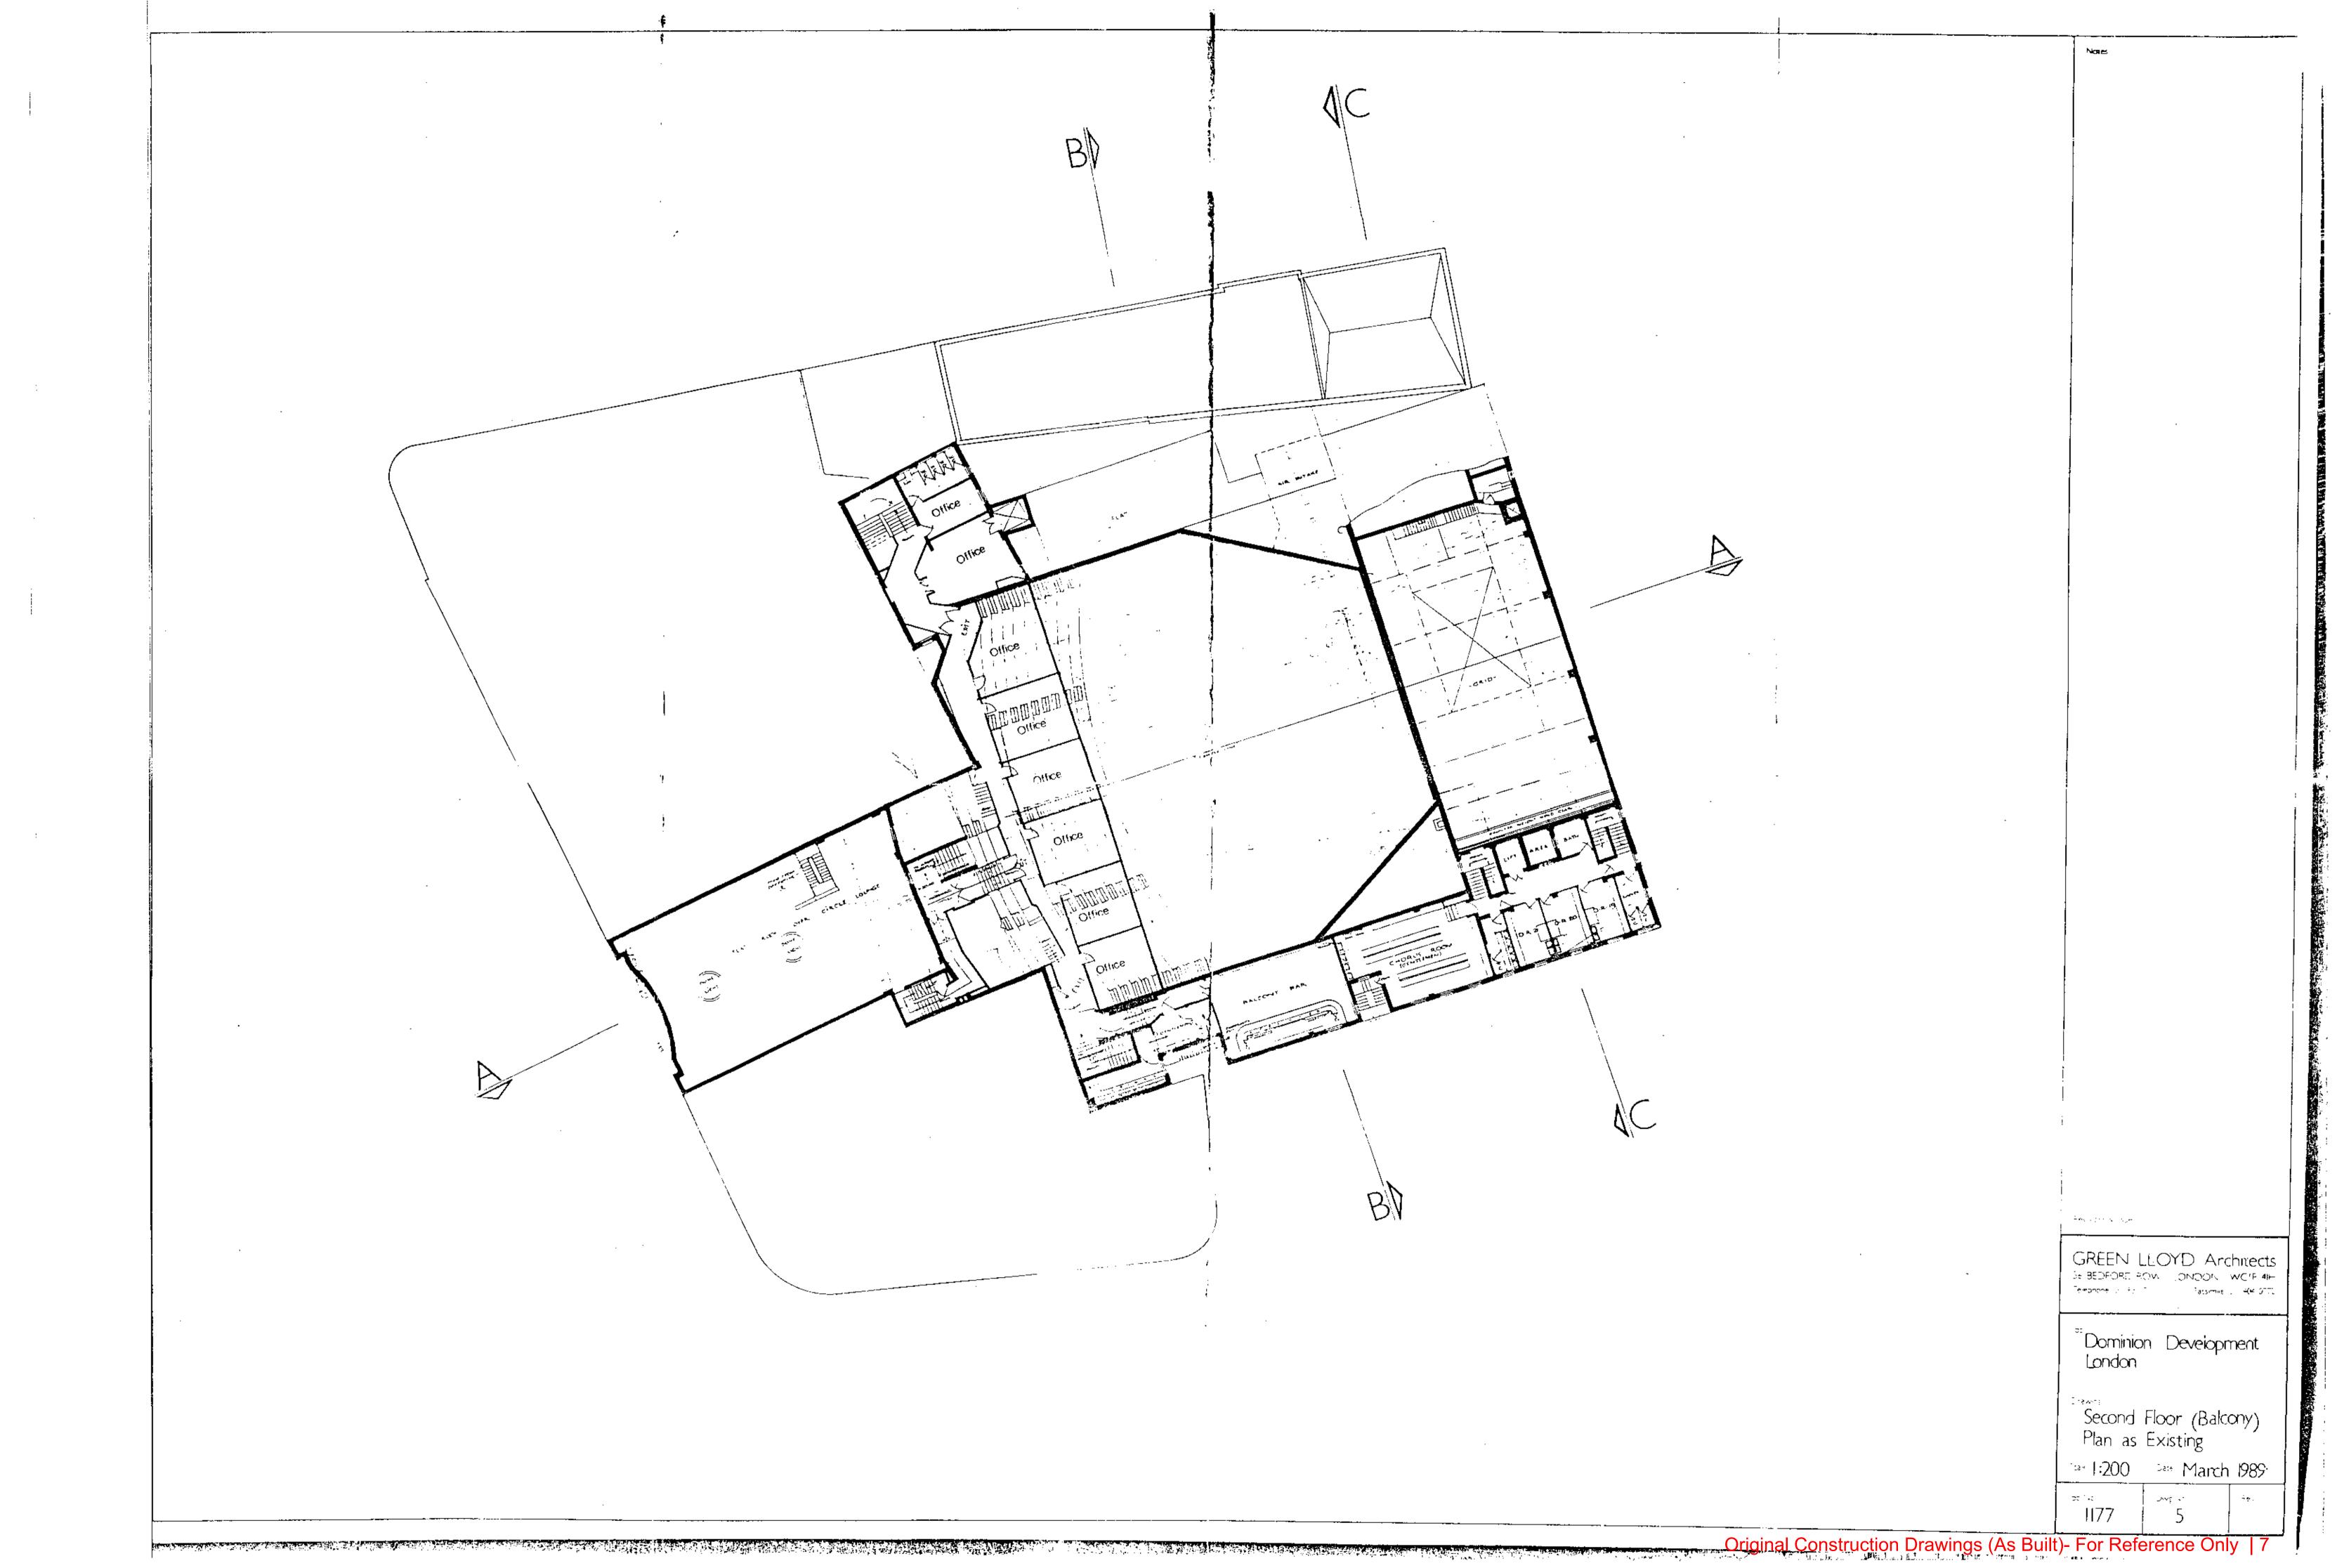

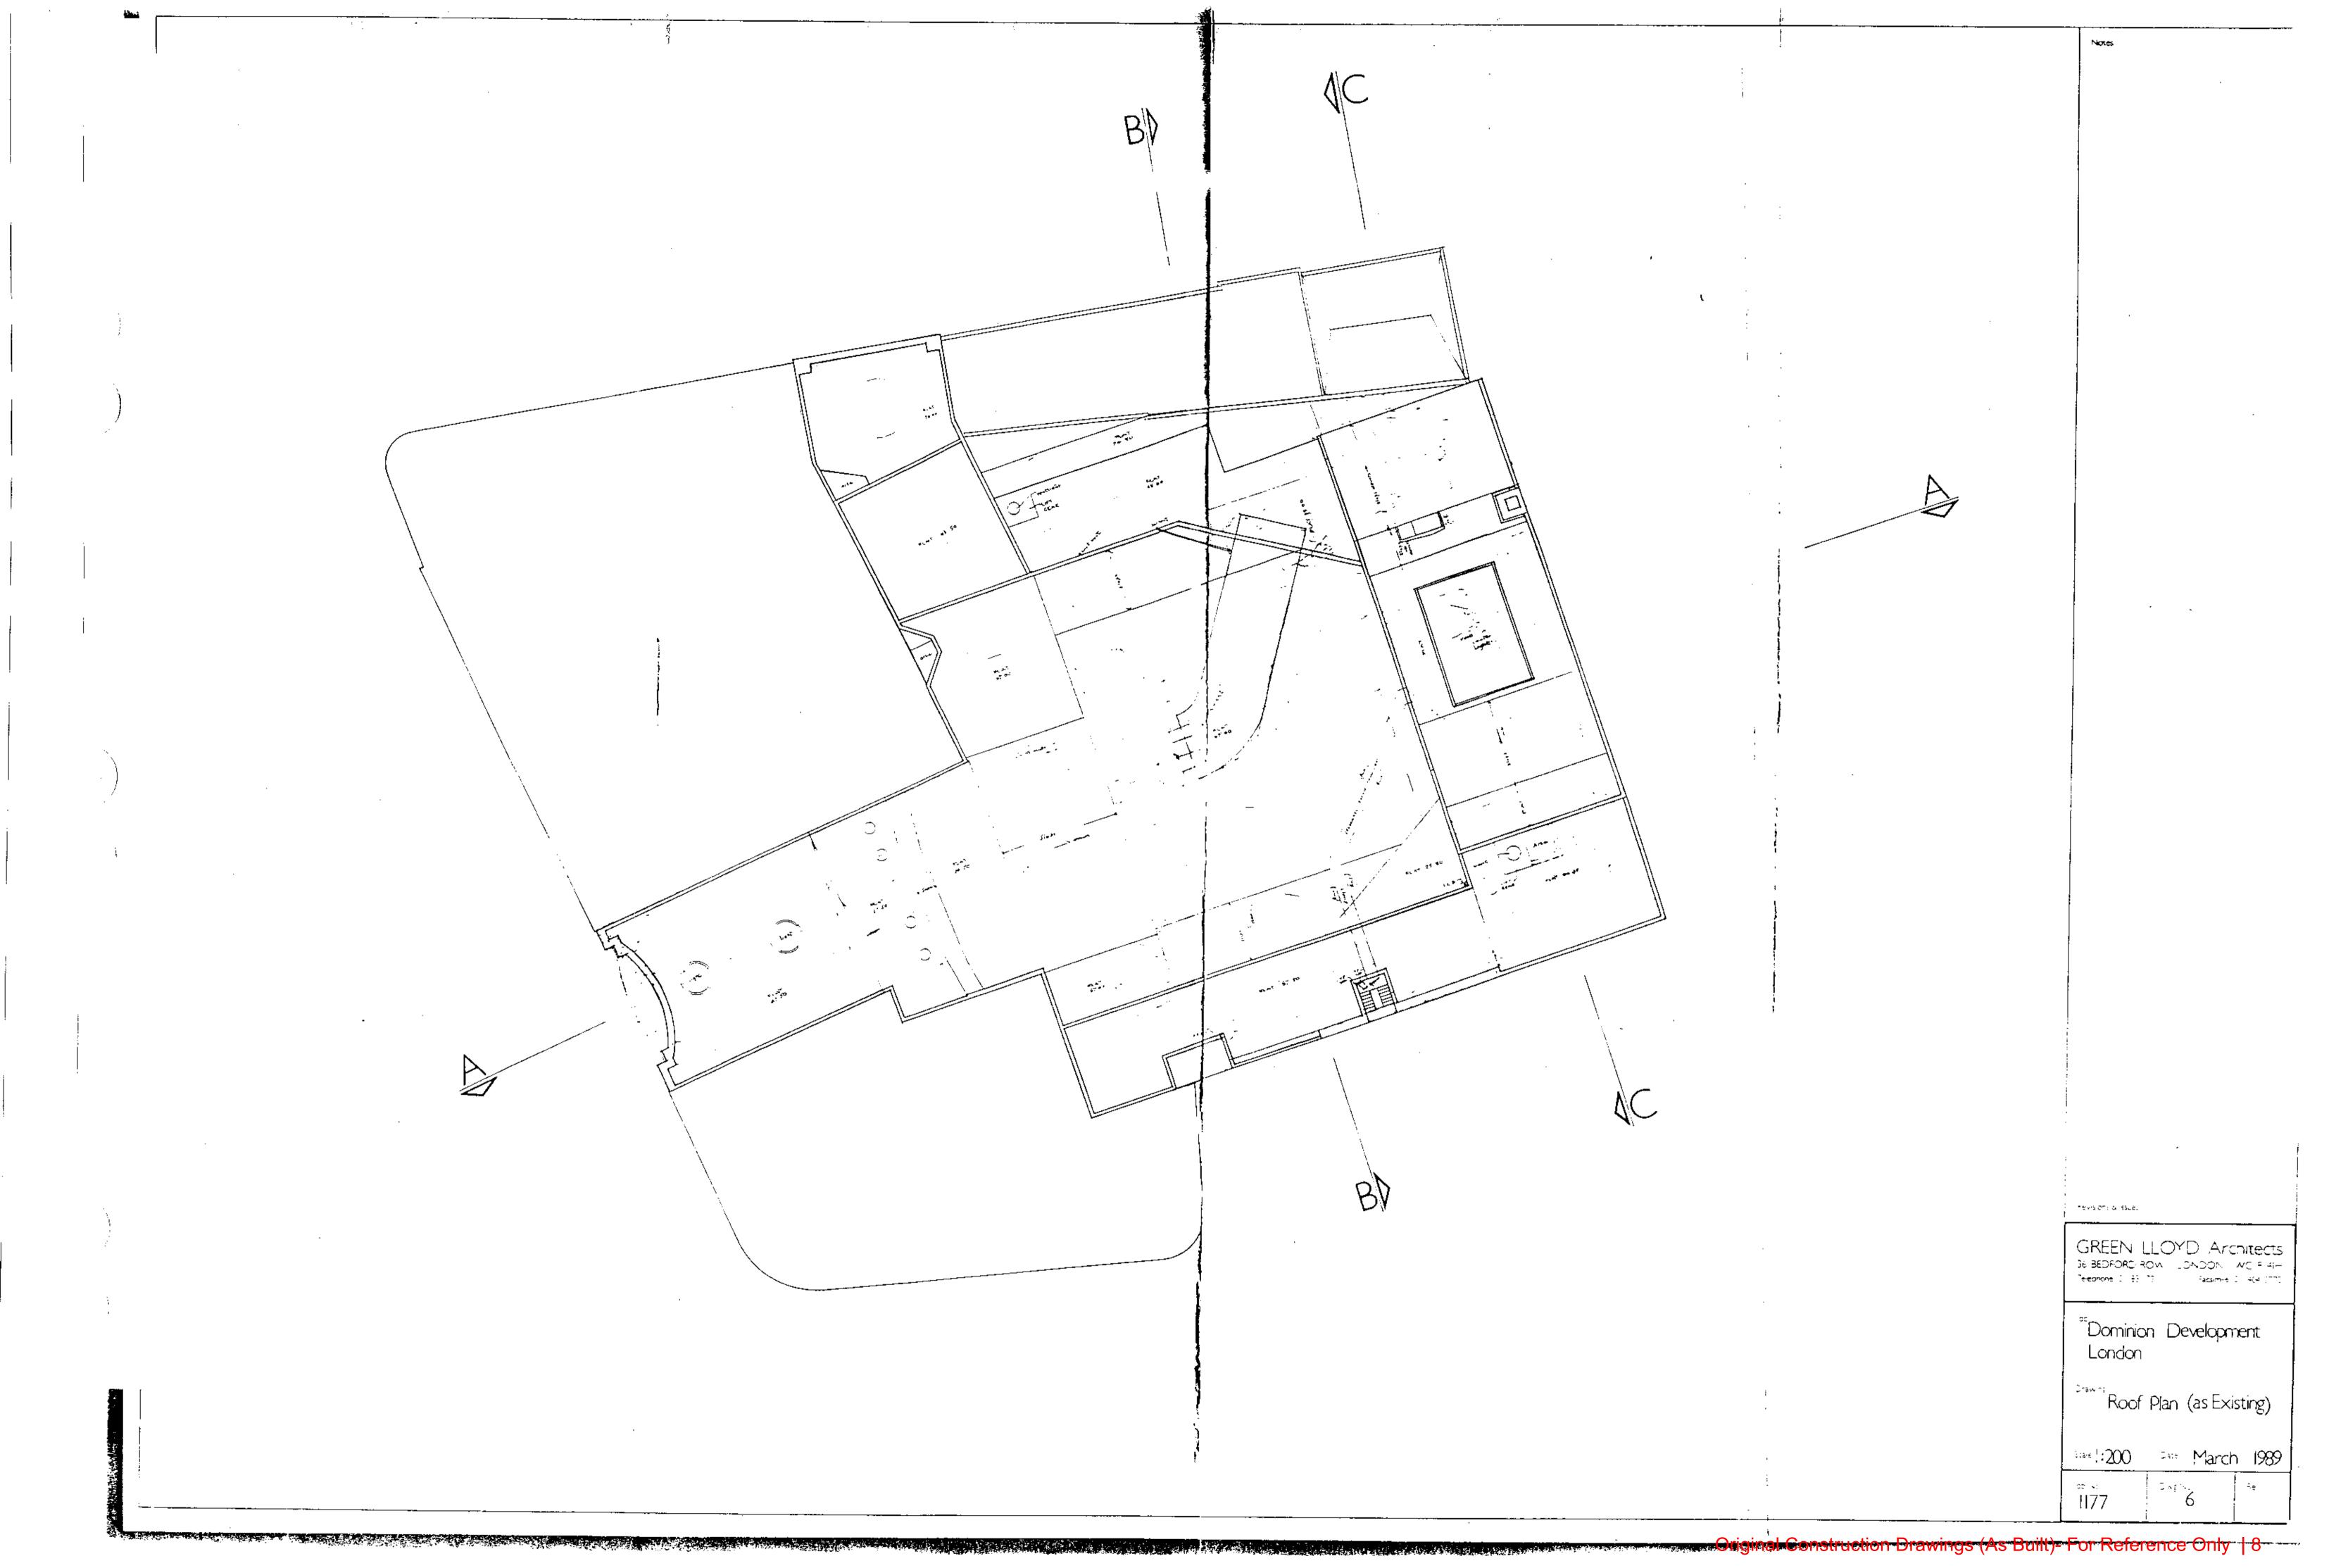

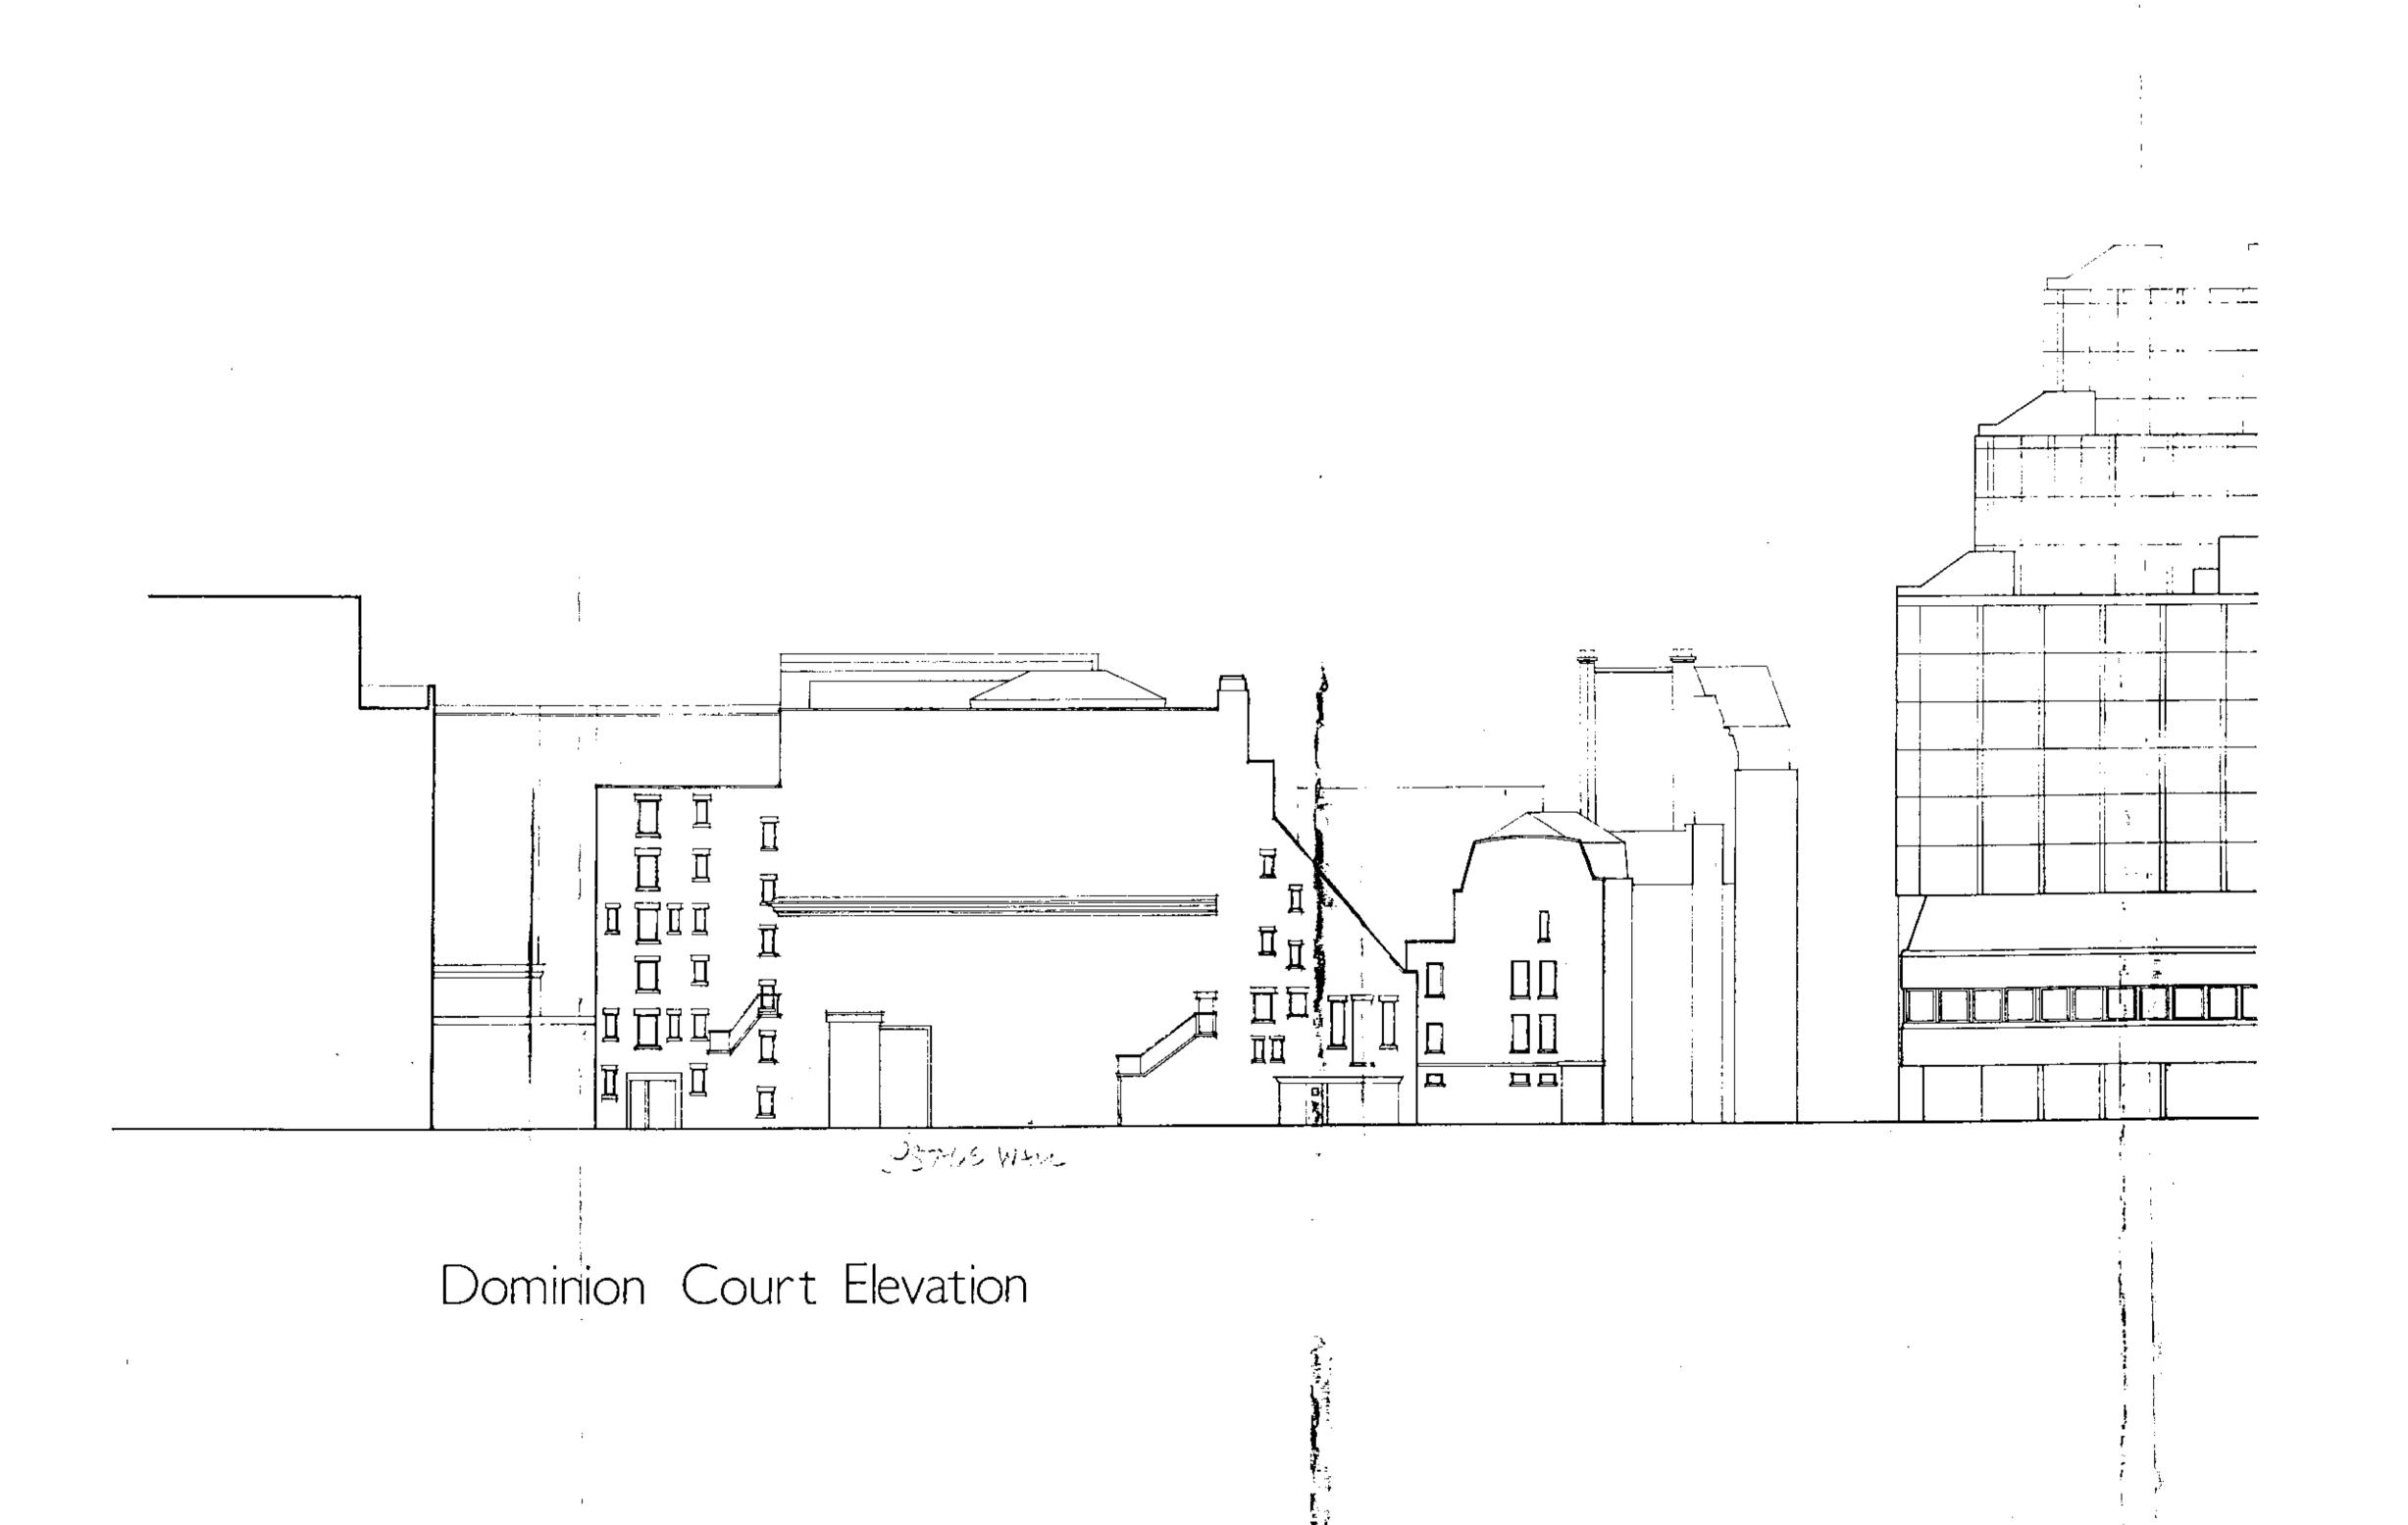

Baringer & broom

GREEN LLOYD Architects
36 BEDFORD ROW LONDON WCIR 4]H
Telephone: 01-831 7317 Facsimile: 01-404 0772

Dominion Development London

Dominion Court Elevation
(as Existing)

Scale 1:200 Date February 1989

W L

Construction Drawings (As Built)- For Reference Only | 9

