




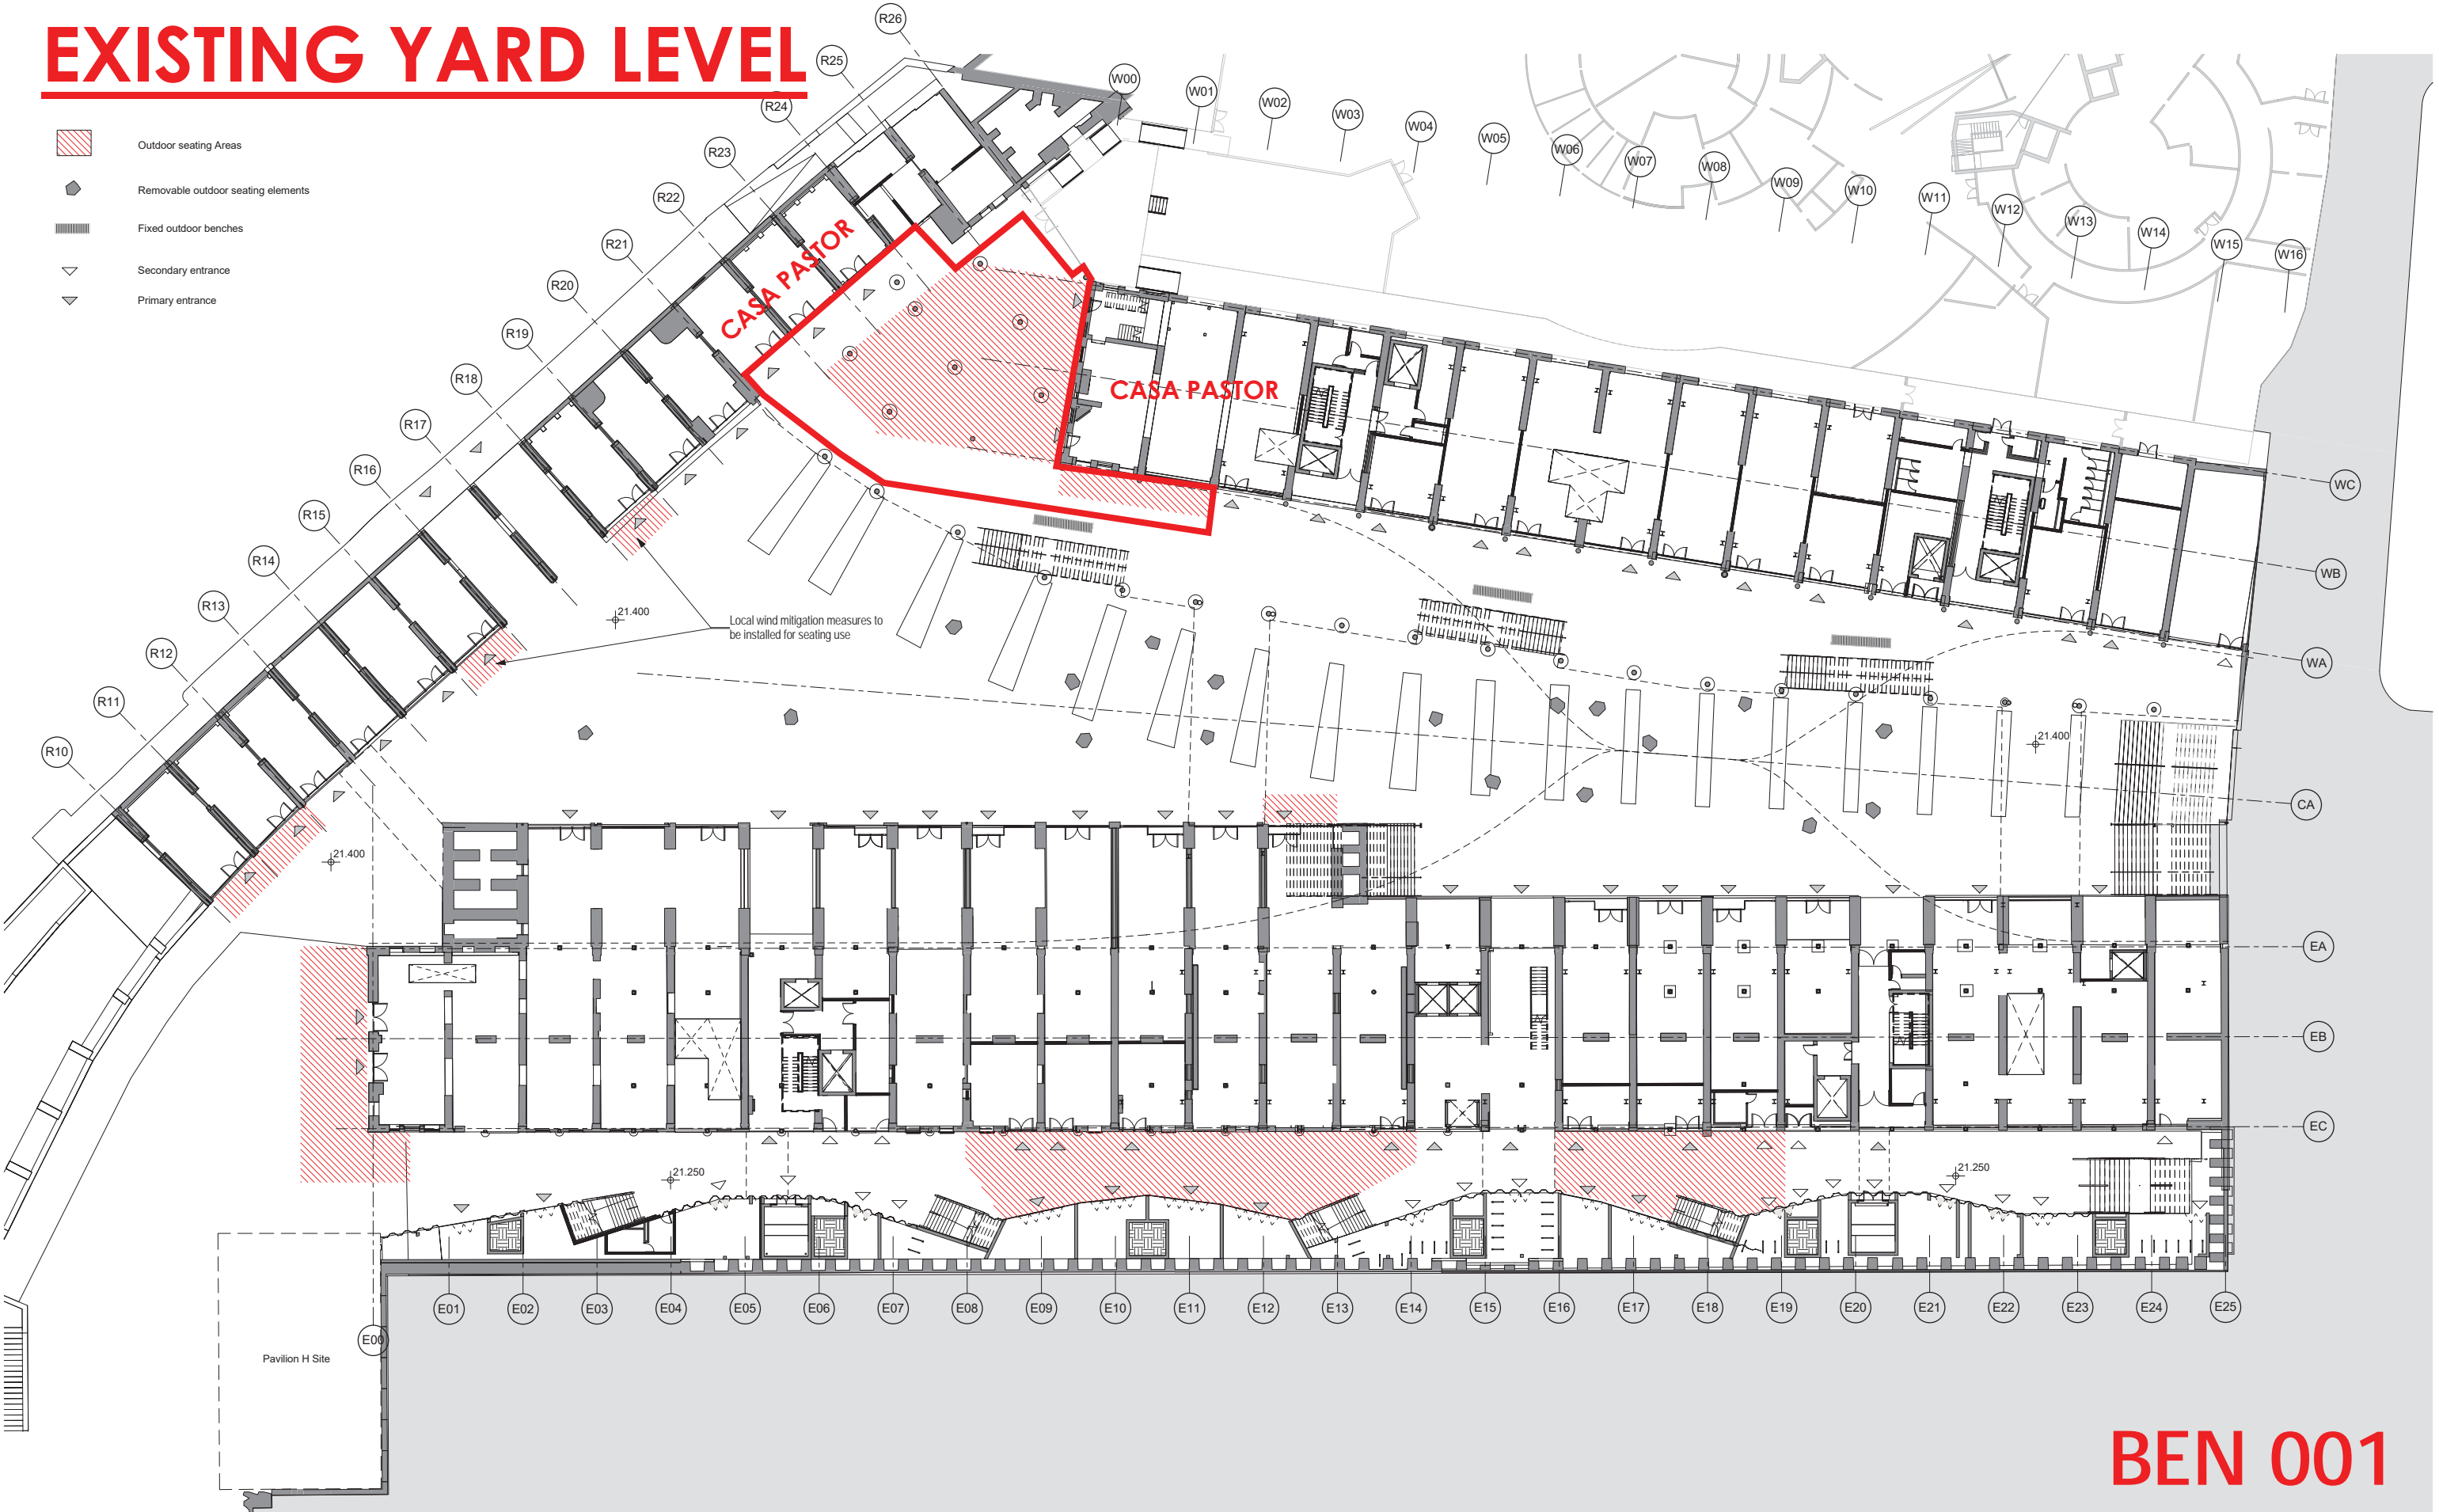



EXISTING YARD LEVEL

-  Outdoor seating Areas
-  Removable outdoor seating elements
-  Fixed outdoor benches
-  Secondary entrance
-  Primary entrance



NOTE BY BENCHMARK (MAY 2018)

THE RED LINE IDENTIFIES THE APPROVED YARD LEVEL OUTDOOR SEATING AREA UNDER PLANNING PERMISSION 2015/6015/P NOW PROPOSED TO BE USED AS AN OUTDOOR A3 RESTAURANT BY CASA PASTOR (UNIT 4 - YARD LEVEL WCDY) - SEE MAY 2018 PLANNING APPLICATION.

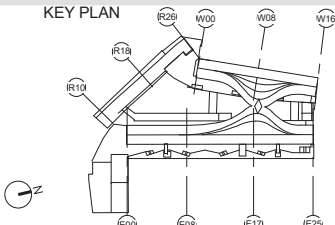

Heatherwick studio






Web: <http://www.heatherwick.com>
 Email: studio@heatherwick.com
 356 - 354 Gray's Inn Road London
 UK +44 (0)20 7833 8800
 fax: +44(0)20 7833 8400


project	COAL DROPS YARD
title	Outdoor Seating Plan - Yard Level
scale	1 : 250 @ A1 1 : 500 @ A3
date	18/09/15
drawn	HS
checked	PEZ
date	18/09/15
rev.	891
drawing no.	PL-1073
rev.	-

FOR APPROVAL

BEN 001


EXISTING VIADUCT LEVEL

-  Outdoor seating areas
-  Removable outdoor planters
-  Outdoor benches
-  Secondary entrance
-  Primary entrance

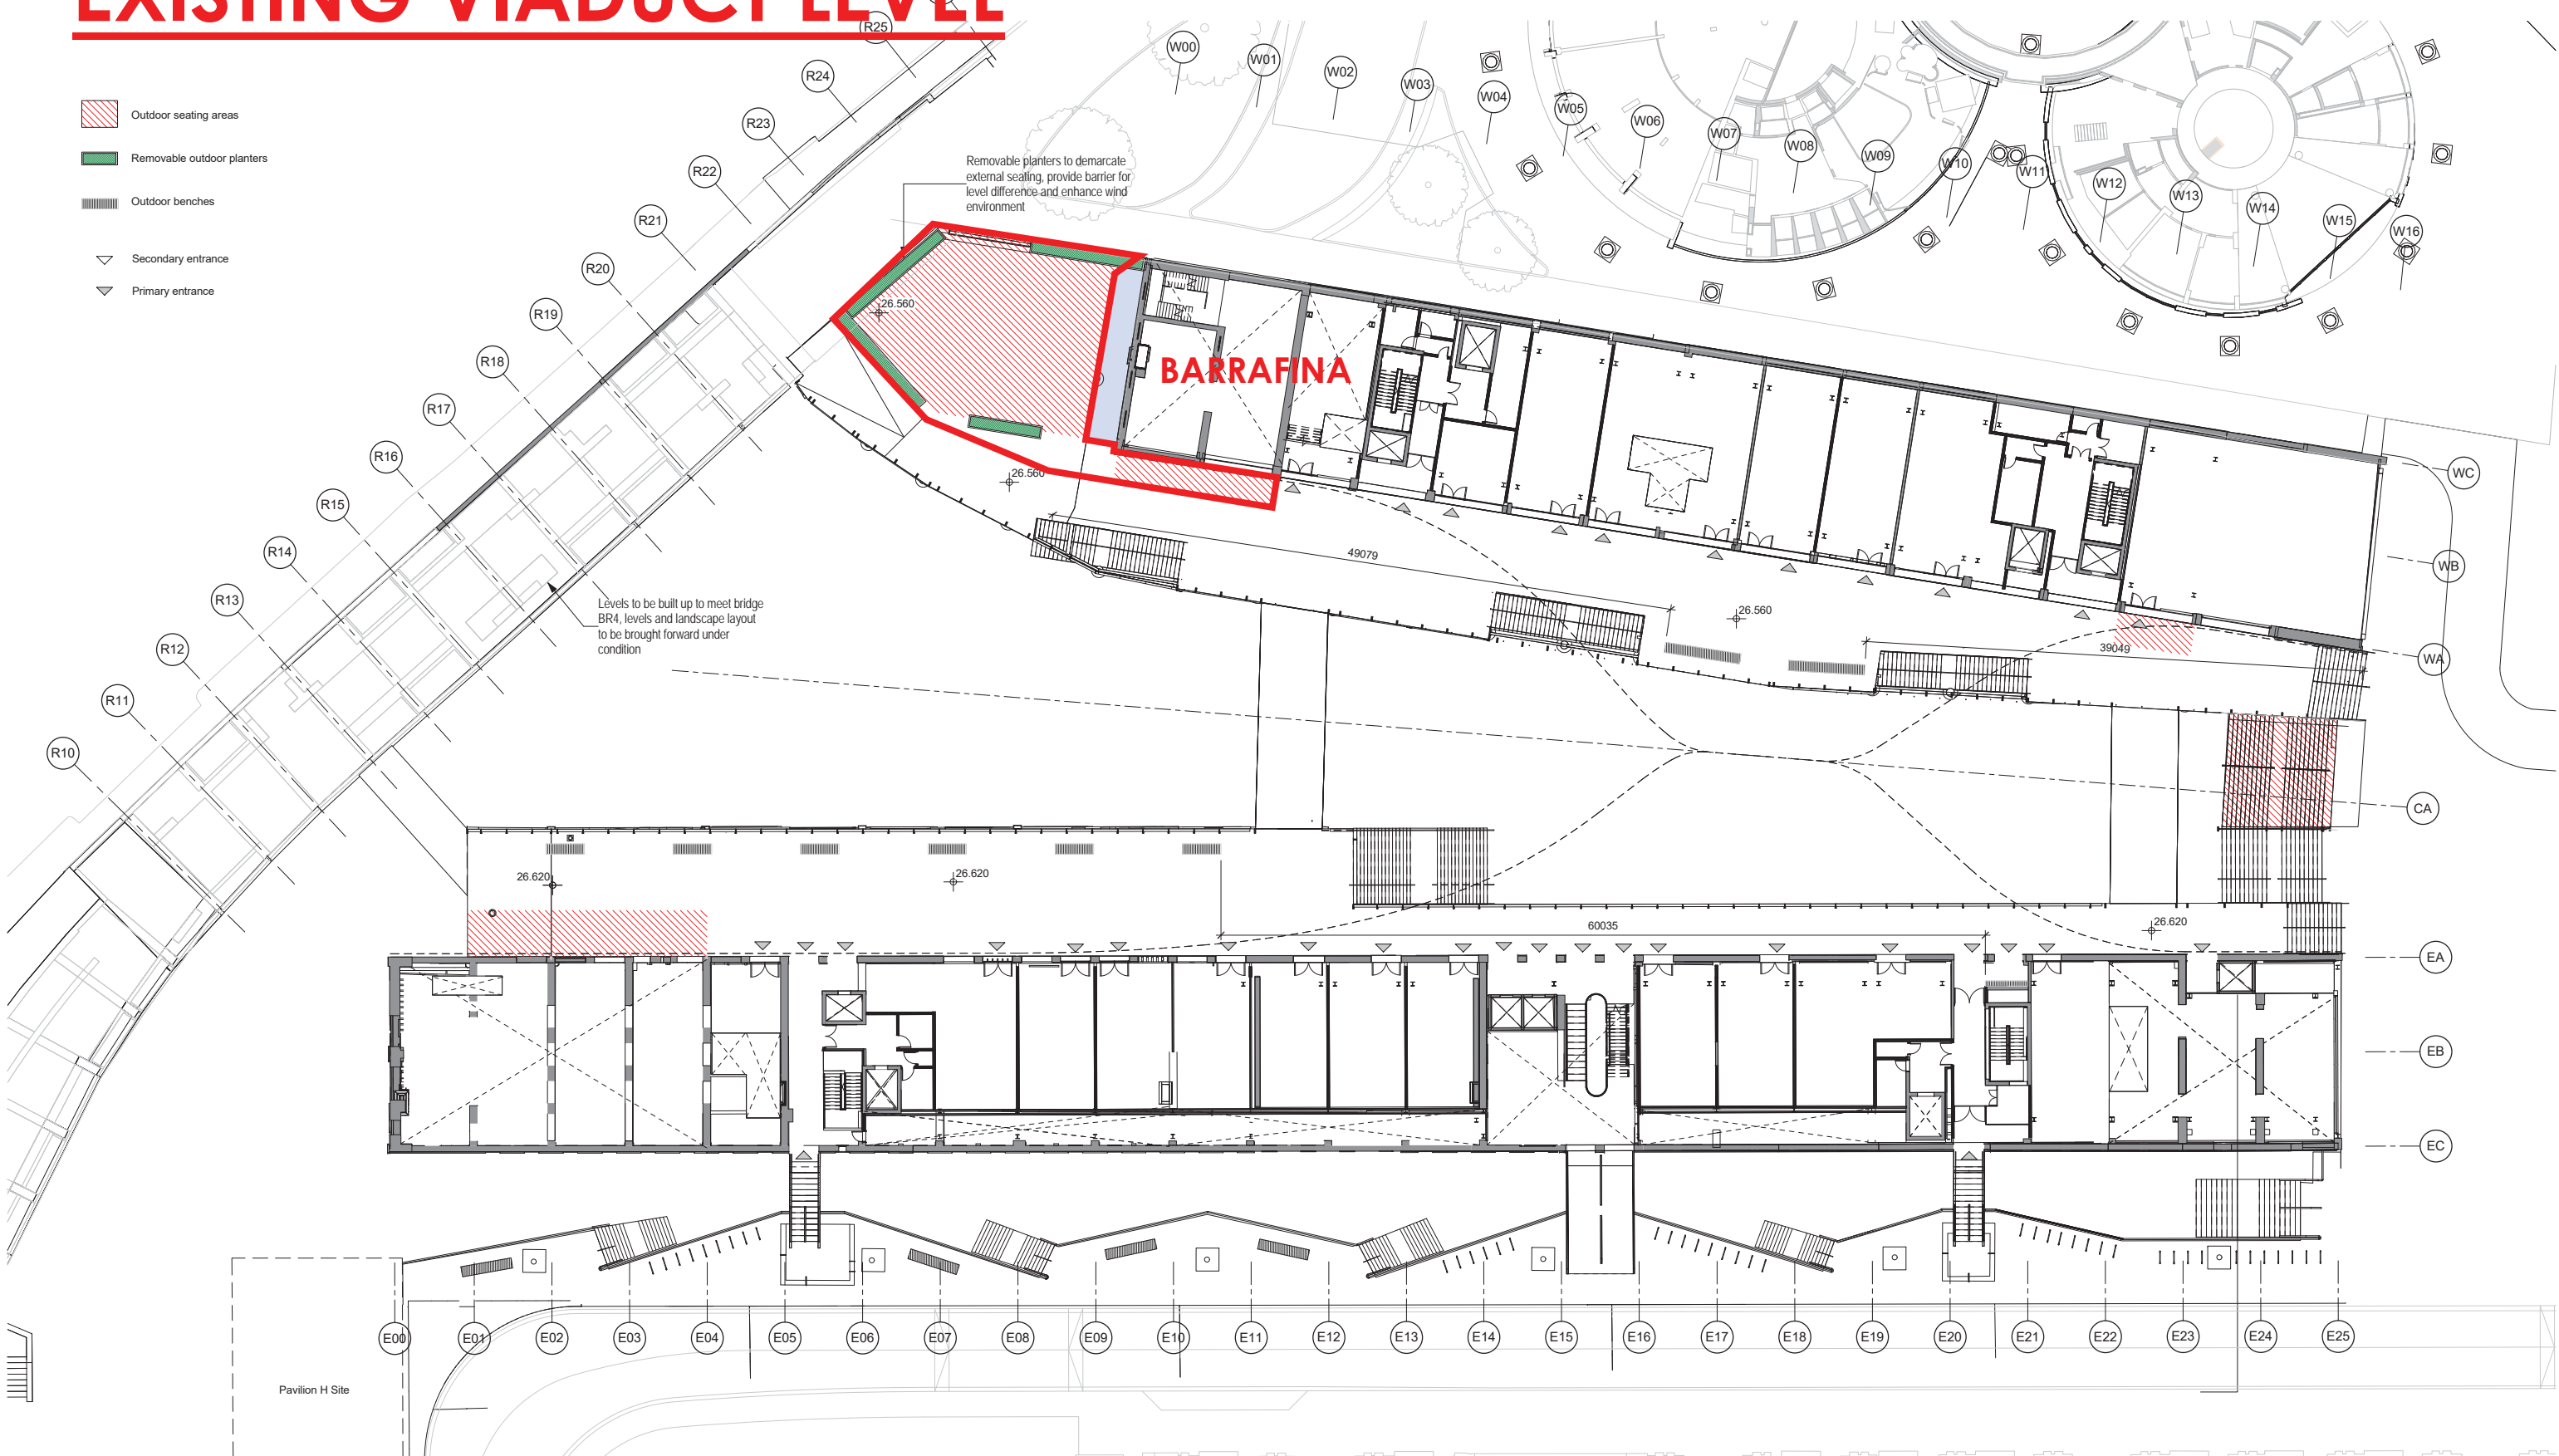

NOTE BY BENCHMARK ADDED 23/05/2018:
THE RED LINE IDENTIFIES THE APPROVED OUTDOOR SEATING AREA UNDER PLANNING PERMISSION 2015/6015/P NOW PROPOSED TO BE USED AS AN OUTDOOR A3 RESTAURANT DINING AREA BY BARRAFINA (UNIT 4 - VIADUCT LEVEL) WCDY - SEE MAY 2018 PLANNING APPLICATION.

BEN 002

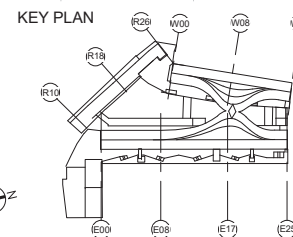

Heatherwick studio

Web: <http://www.Heatherwick.com>
 Email: studio@heatherwick.com
 356 - 364 Gray's Inn Road London
 WC1A 1JX UK
 Tel: +44 (0)20 7833 8800
 Fax: +44(0)20 7833 8400

project COAL DROPS YARD

title Outdoor Seating Plan - Viaduct Level

scale 1: 250 @ A1
 1: 500 @ A3
 date 18/09/15

drawn HS
 checked PEZ
 H5 job no. 891

FOR APPROVAL
 drawing no. PL-1074
 rev. -