
05

NOTES: This drawing is the exclusive Copyright of Ltb and may not be copied or handed to any Third parties without prior consent. All dimensions must be checked on site and not scaled from the drawing. All drawings and proposals are subject to approvals by statutory authorities.

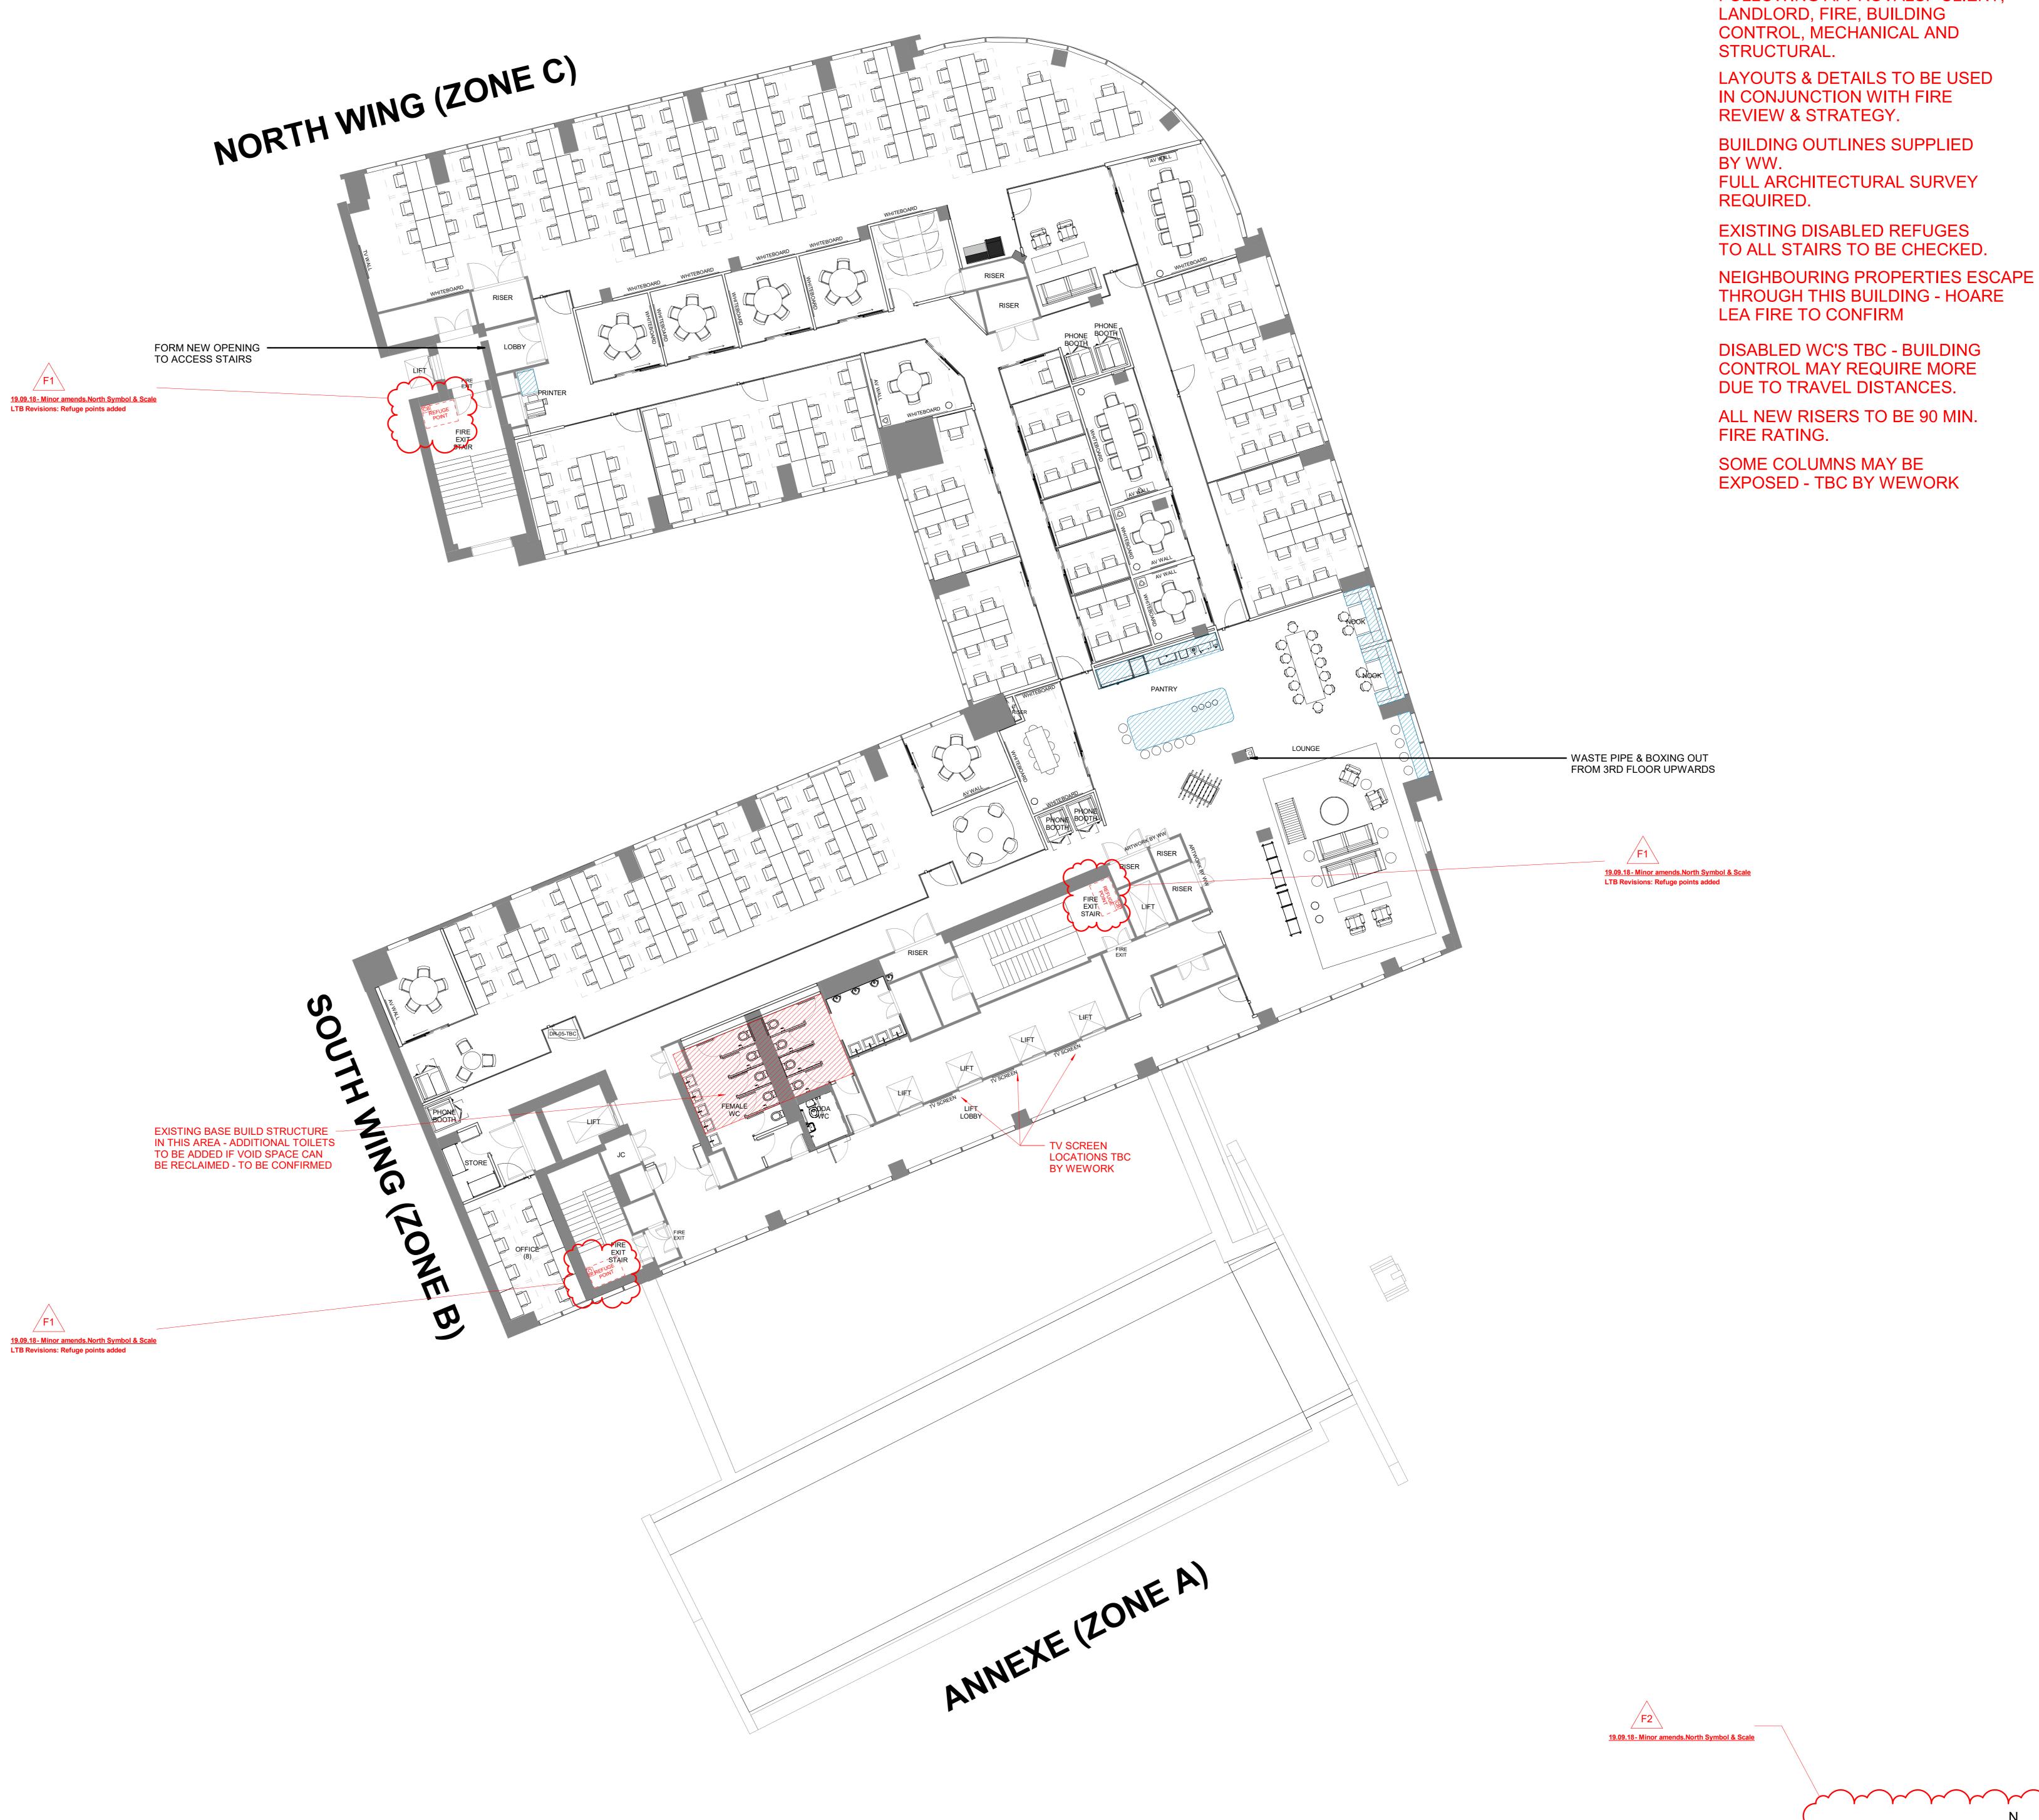

Floor Area m2 Floor Area ft2 ALL LAYOUTS SUBJECT TO THE 1358 m² 14,612 SF FOLLOWING APPROVALS:- CLIENT, Square foot shown is based on supplied building shell and includes all columns - suject to site survey GENERAL CEILING HEIGHT = TBC mm unless other noted - Refer to survey details FLOOR VOID = TBC mm unless other noted - Refer to survey details CEILING VOID = TBC mm unless other noted - Refer to survey details LAYOUTS & DETAILS TO BE USED ACCOMMODATION SCHEDULE BRAINSTORM ROOM CONFERENCE ROOM LOUNGE MALE WC NOOK PANTRY

FACILITY
Name Occupancy
OFFICE 8 1

PHONE BOOTH

PRIVATE OFFICE

TOTAL HEAD COUNT 215

NEW WORKSTATIONS
1220 x 610mm WITH 'T' BAR LEGS

JOINERY ITEM

Minimal Works or No Works
proposed to these areas.

Notes shown in red.

— FIRE CURTAIN LINE

REFUGE POSITION
900x1400mm

CB CALL BUTTON POSITION

NOTES:
SEE CONTRACTORS DRAWINGS FOR A/V,
SECURITY ETC.
FIRE BARRIERS ON P-SET & LLS DRAWINGS.

LTB TO SUPPLY AND FIT ALL WHITEBOARDS

F Minor amends.North Symbol & Scale TK 19.09.18
E Updated to WW comments 23.07.18 GM 01.08.18
D Amended to match updated EC. Updated Floor Grid & Grommet Locations
C General updates to detail design TK 16.07.18
B General updates to detail design CE 22.06.18
A Revisions following design meeting & TK 15.06.18 site visit
- Drawing First Issue CE 08.06.18
Rev Descriptive Amendments Drawn By Date

Pre-Design - Construction - As Built

Construction

Client

WeWork

Client Contact

Project Name

Drawing Title

Drawing Title

5th Floor - General Arrangement

Account Manager

1120 WeWork 71-91 A London,

WeWork Aldwych House 71-91 Aldwych, London, WC2B 4HN