


General Notes

This drawing must not be scaled. All dimensions to be checked.

This drawing is to be read in conjunction with all relevant structural engineer's drawing and details, the specification for the works, the relevant architects drawings and any other specialists drawings.

Note that 'As Installed Record Drawings' should be used for co-ordination of MEP Systems. This drawing is for Design intent only.

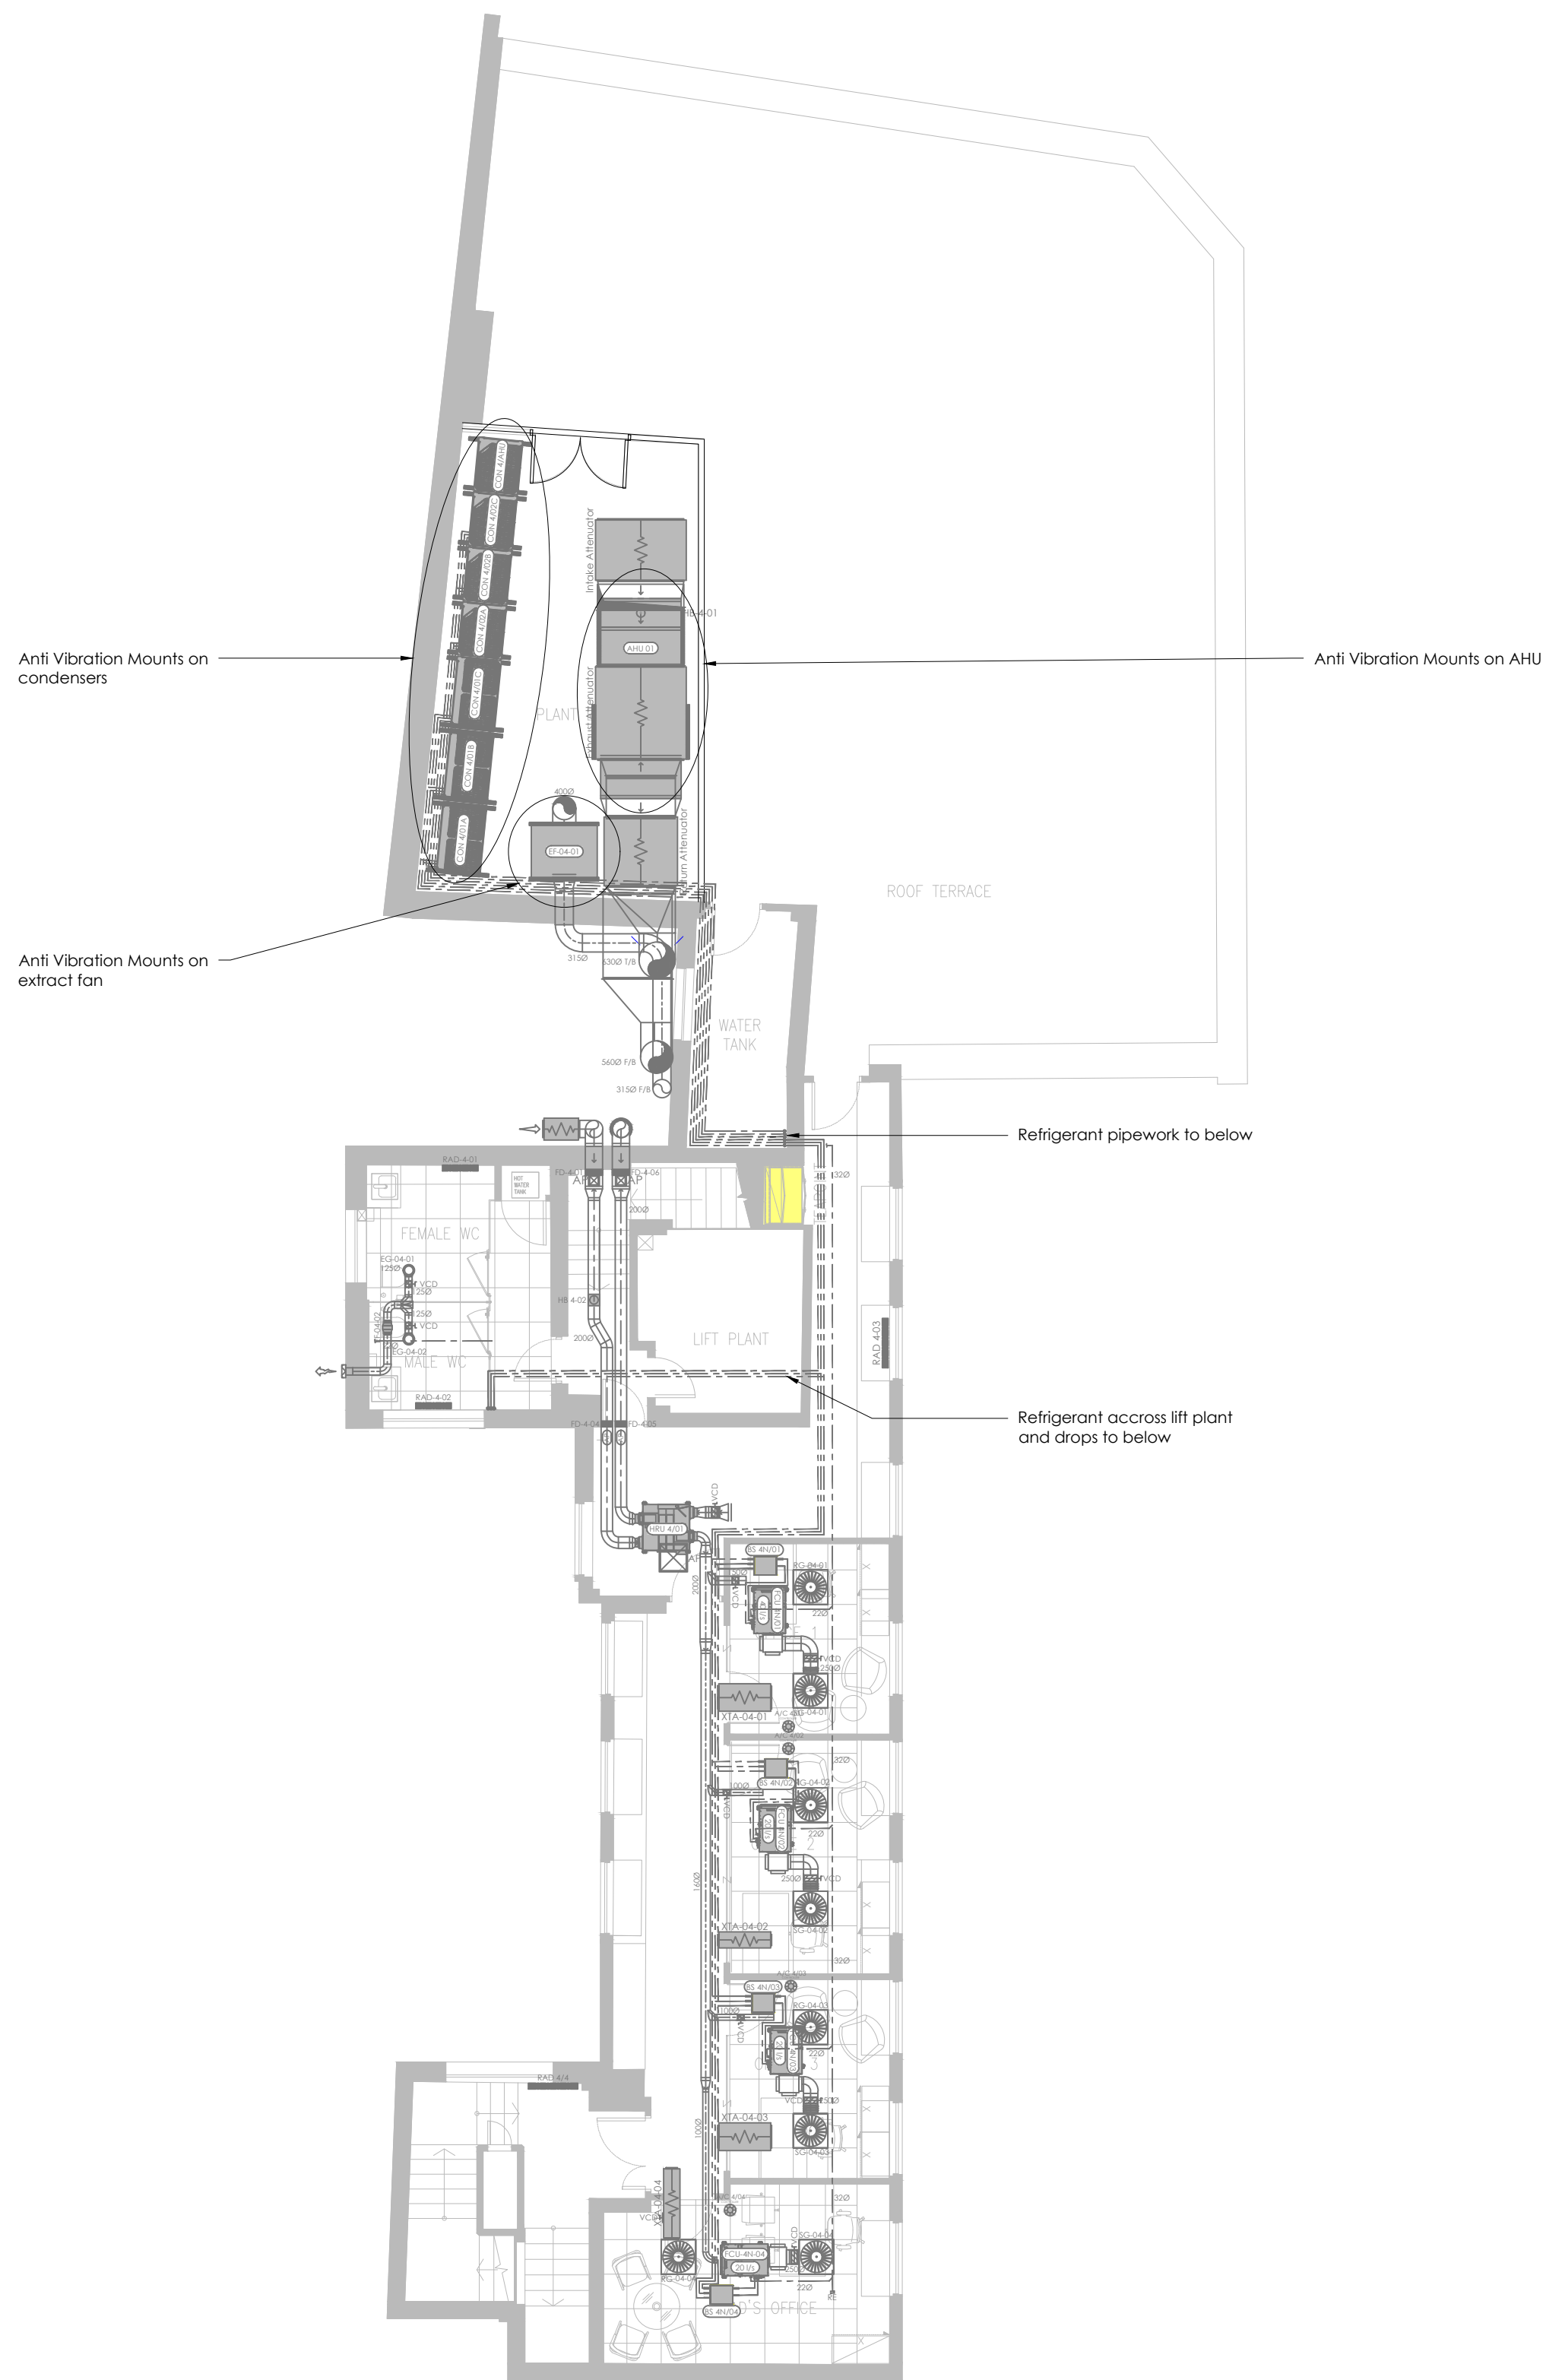

Rev	Description	By	Date
-----	-------------	----	------



Conditioned Environment
(Mechanical Services) Ltd
245 Acton Lane, Park Royal
London NW10 7NR
T 020 8453 1010
F 020 8965 8469
E enquiries@c-env.co.uk
www.c-env.co.uk



Client

Maris

Project

Fordham University
150-152 Clerkenwell Road
London - EC1R 5EQ

Drawing Title

4th Floor Mechanical
Services Layout

Drawing Status

RECORD DRAWING

Designed By	Drawn By	Checked By
-------------	----------	------------

J.G.	F.M.	K.S.
------	------	------

1st Issue Date	Scale @ A1
----------------	------------

10-10-18	1:100
----------	-------

Project	Serv.	Floor	Ref	Sheet	Rev
---------	-------	-------	-----	-------	-----

4424	M	04	MEC	01	RD
------	---	----	-----	----	----