


Rear Elevation

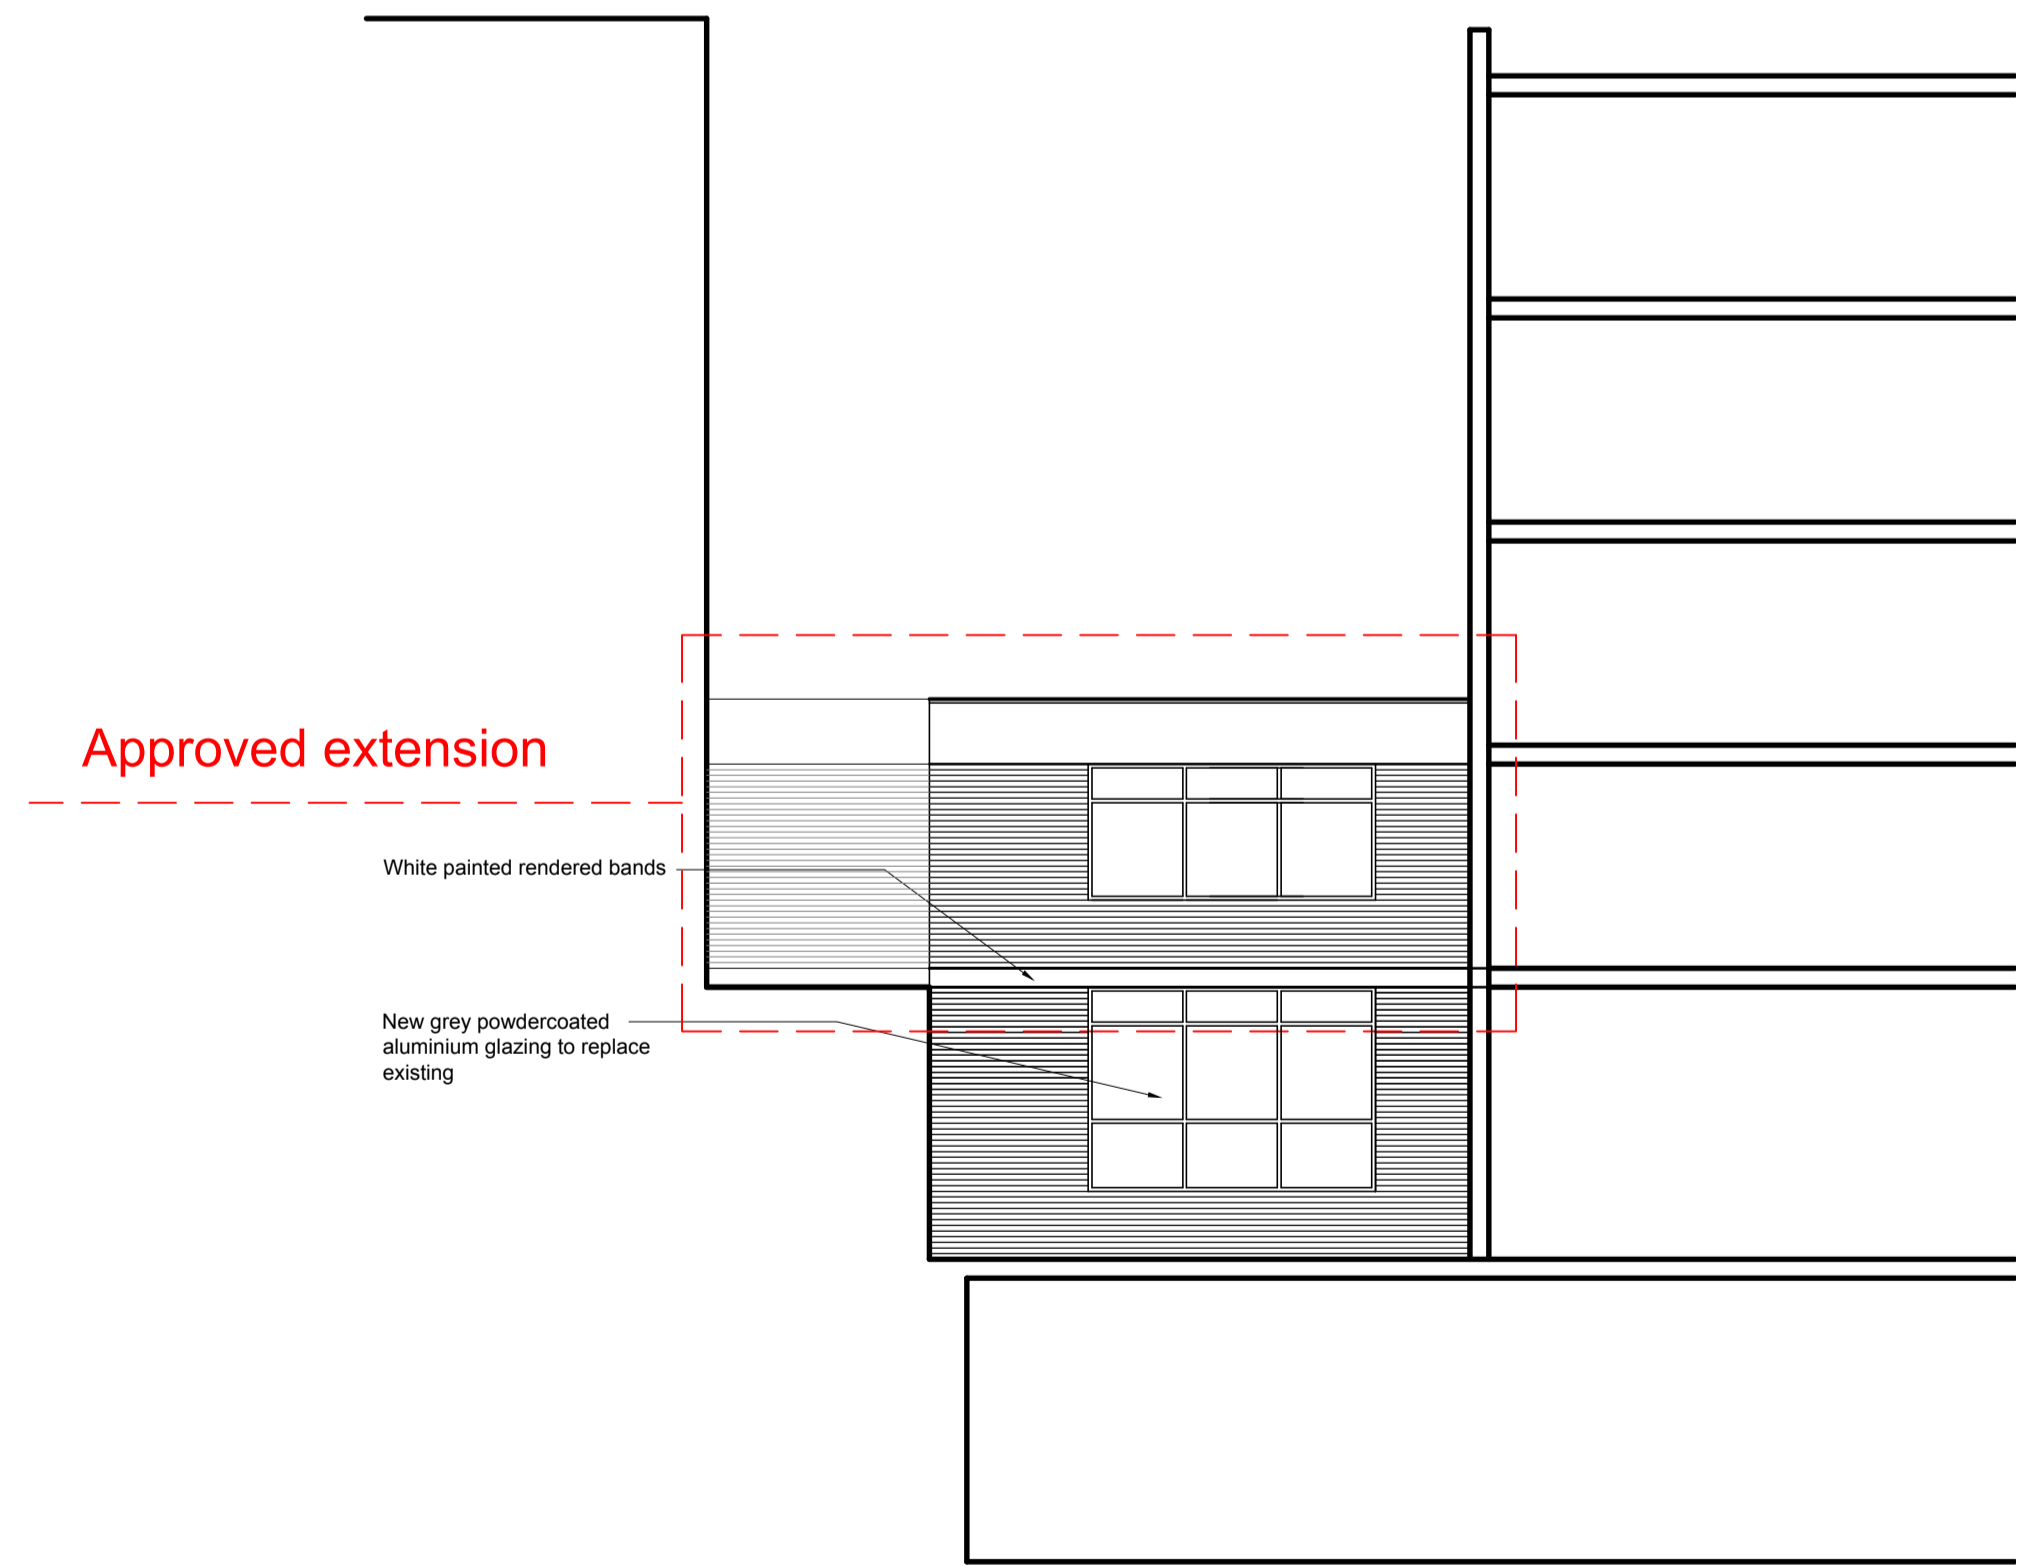

Courtyard Elevation

revisions

ALL FIGURED DIMENSIONS TO BE CHECKED ON SITE BY CONTRACTOR BEFORE COMMENCING WORK.
NO DIMENSIONS SCALED FROM THIS DRAWING

GB&P
Geoff Beardsley & Partners (UK) LLP
 CHARTERED ARCHITECTS AND CDM CO-ORDINATORS
 Elin House, 1A Elin Grove, Teddington, Middlesex TW11 8RD
 Tel: 020 86144374 Fax: 020 89778494
 www.gbpartners.co.uk

client

NYRAFF LTD.

job

67 - 74 SAFFRON HILL
 LONDON
 EC1N 8QX

title

REAR & COURTYARD
 ELEVATIONS
 AS BUILT

dwg no.

1500/AB3

scale 1:100 @ A1 date JAN 2017
 1:200 @ A3