




REAR ELEVATION  
SCALE 1:50

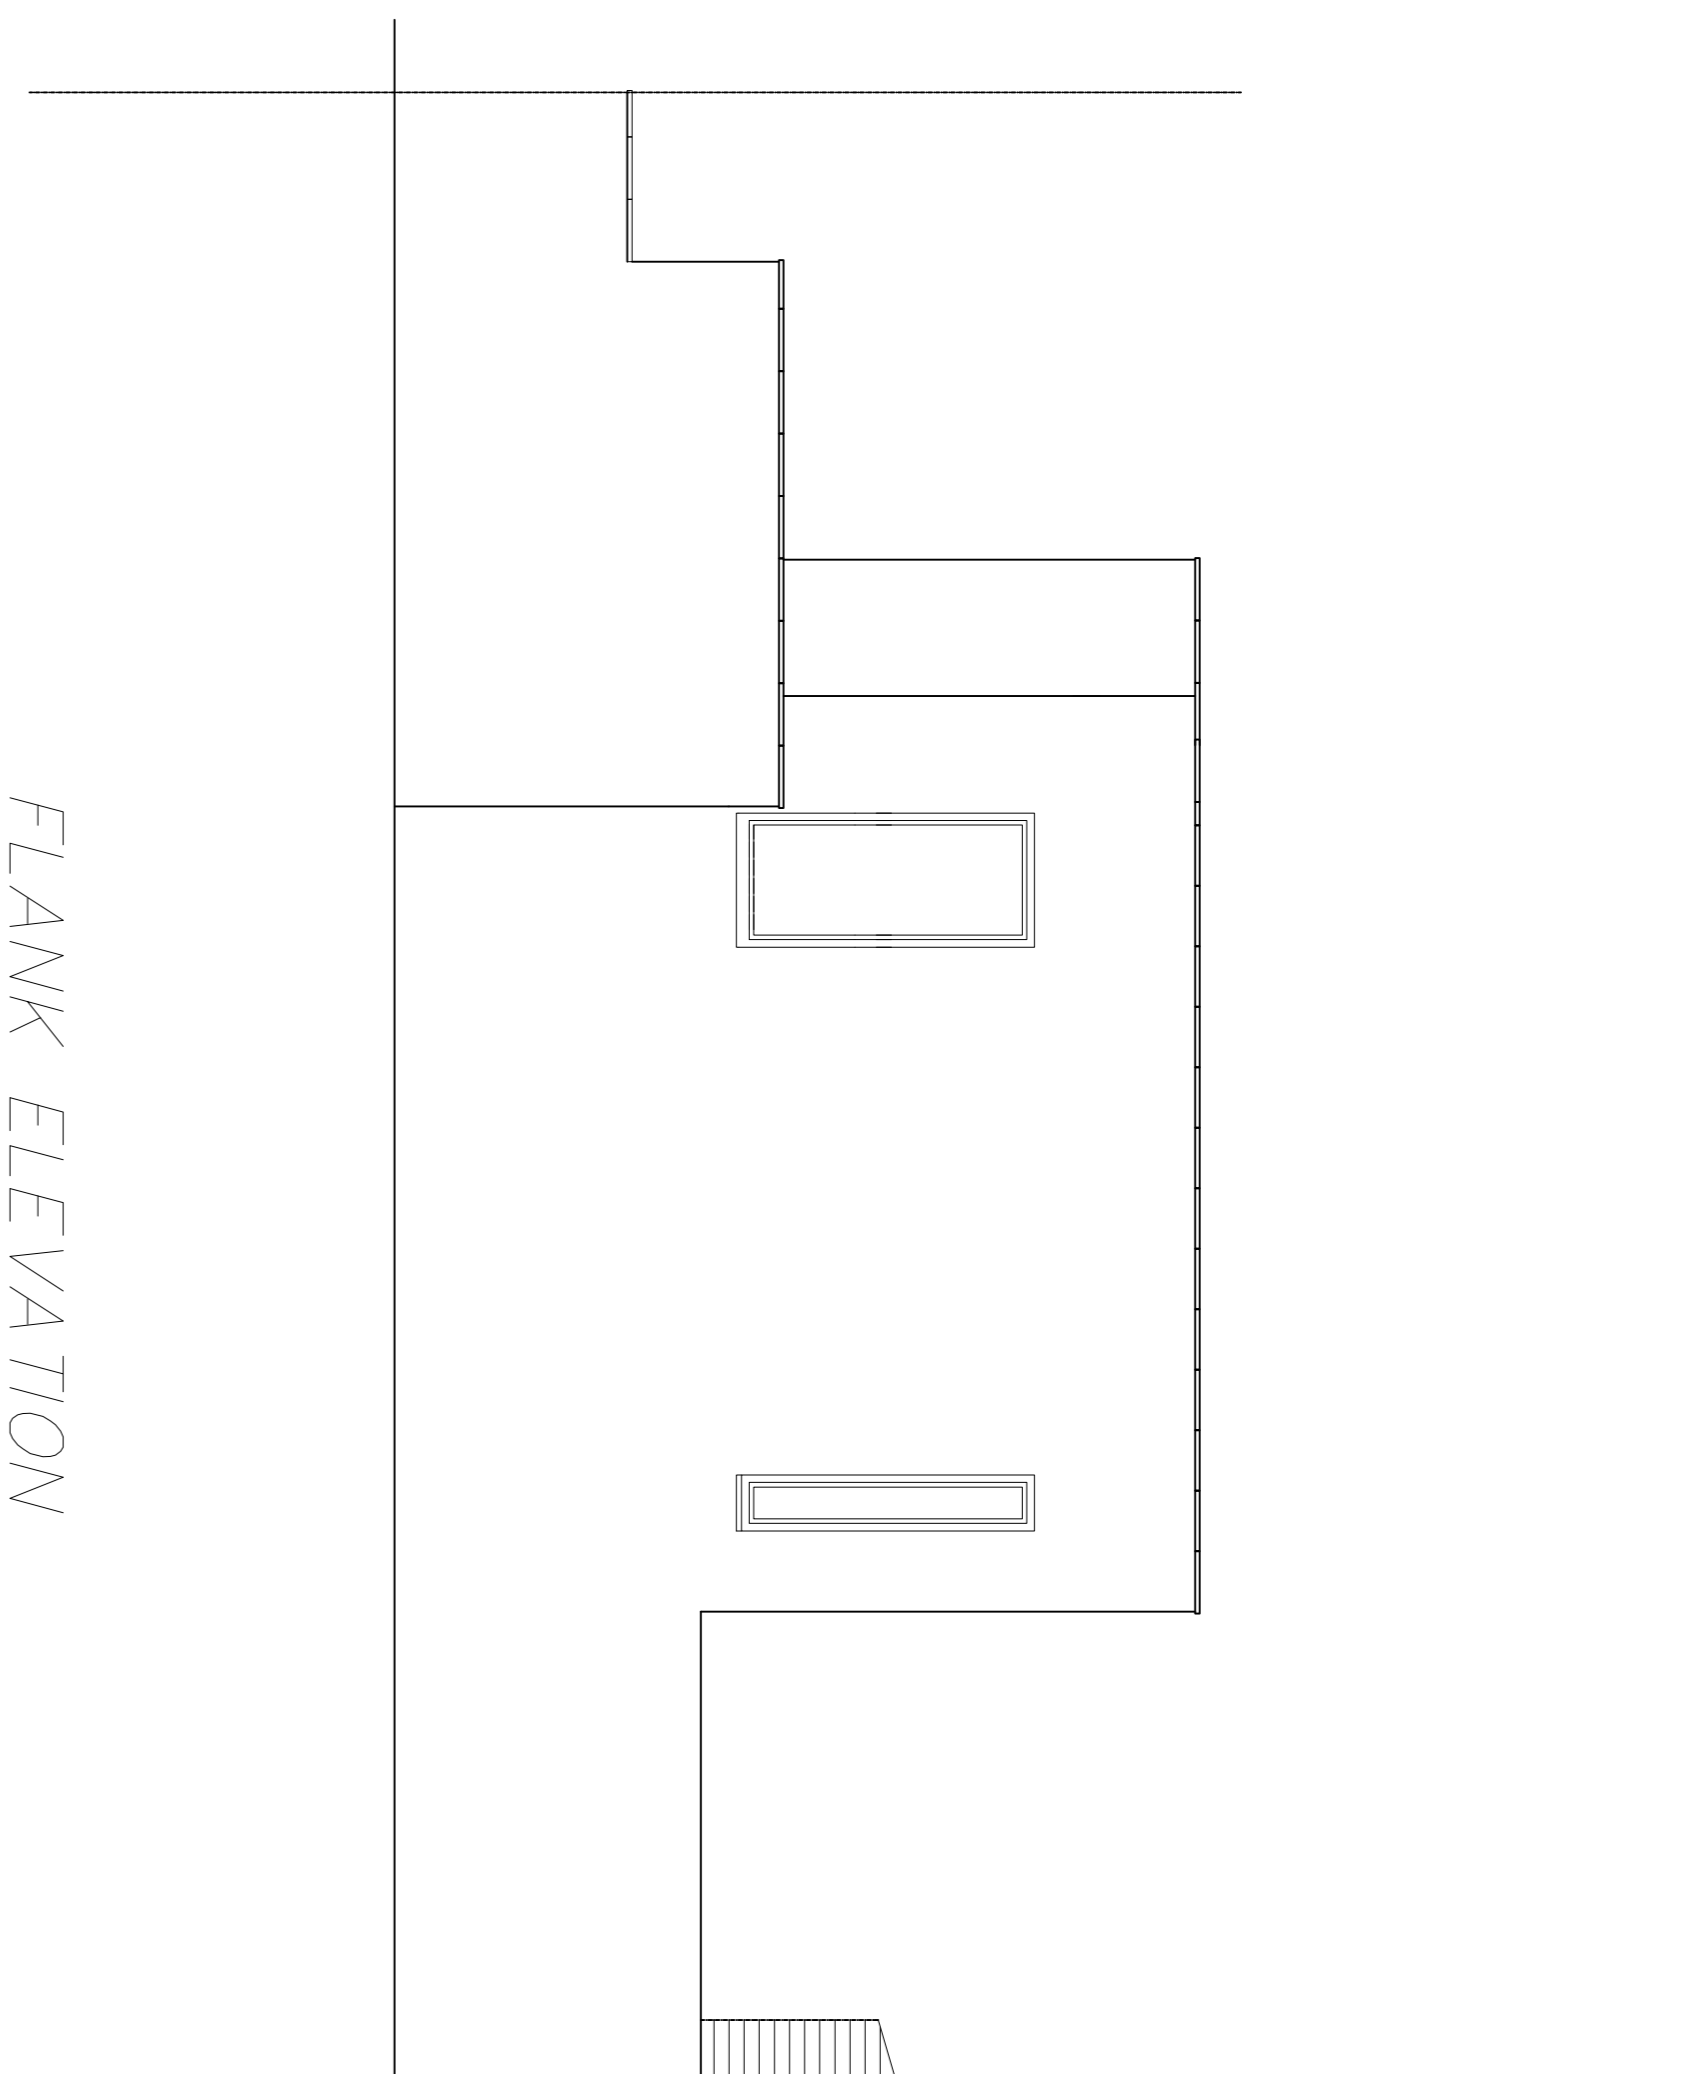

FLANK ELEVATION  
SCALE 1:50

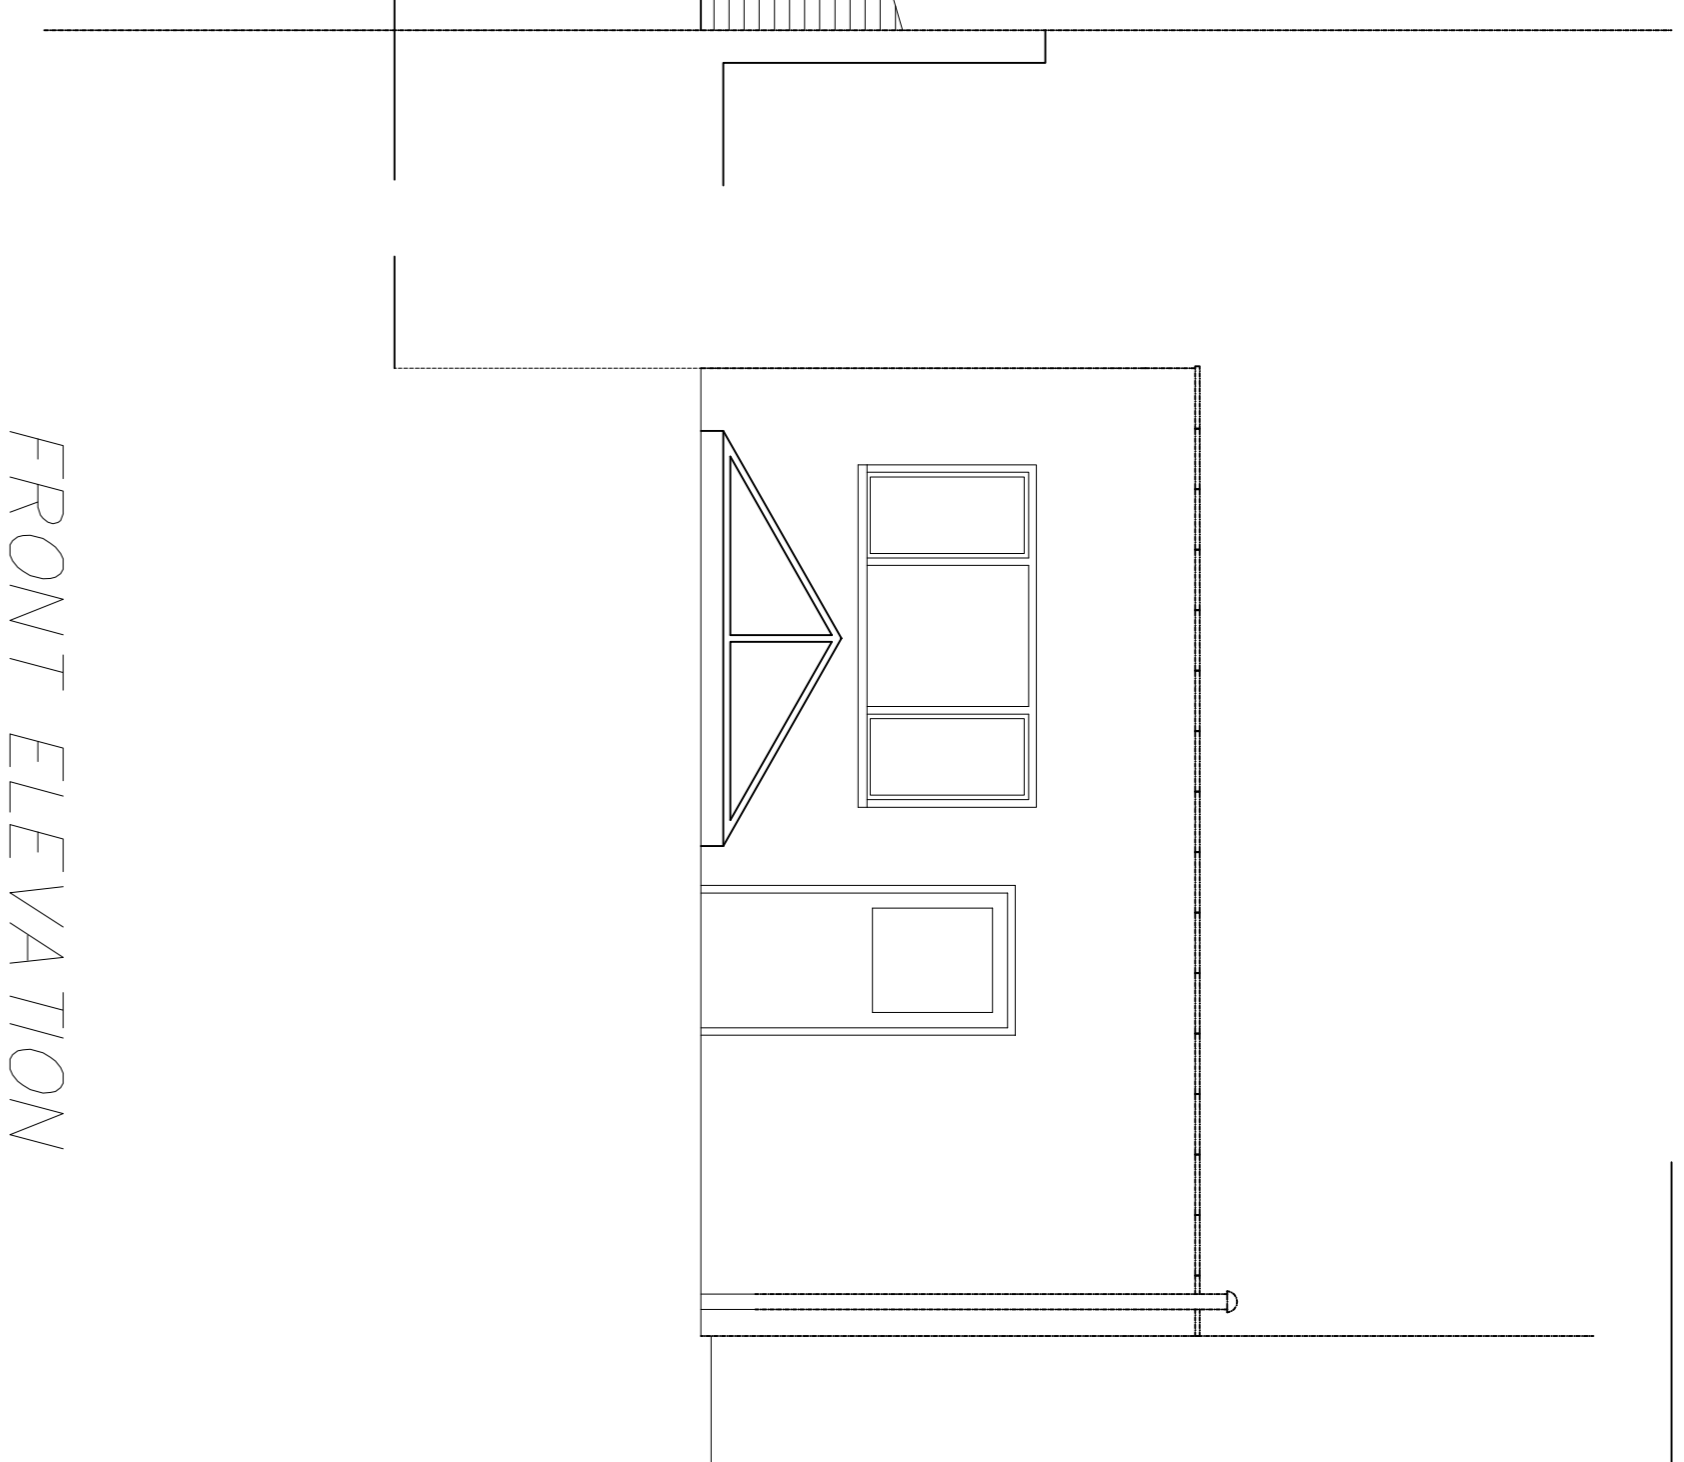

FRONT ELEVATION  
SCALE 1:50

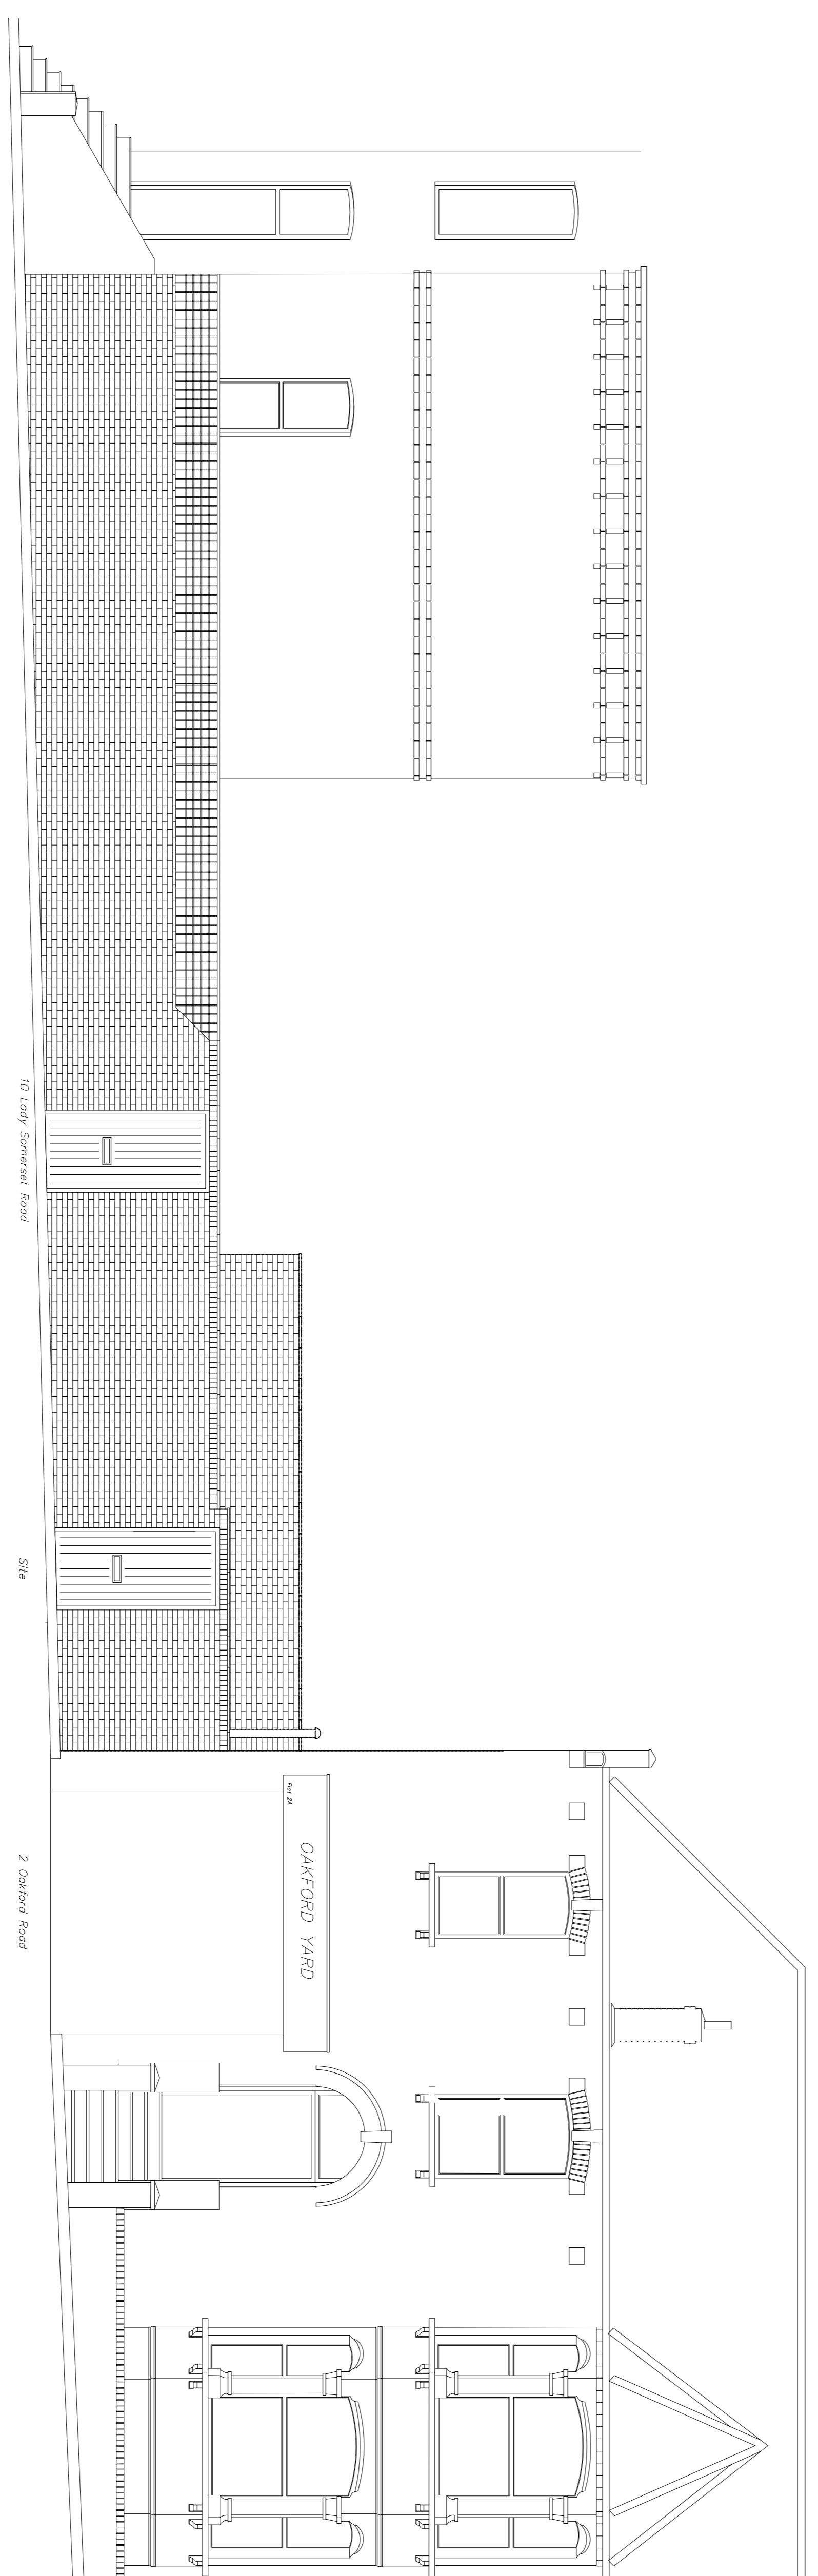

STREET SCENE  
SCALE 1:50

RevNo	Revision note	Date	Signature	Checked

**Property Design Solutions Ltd**  
 Planning and Building Control Drawings

New builds  
 Loft conversions  
 Extensions  
 Conversions  
 SAPs

CLIENT NAME <i>Property AV</i>	SHEET 5	SCALE @ A1 1:50
ADDRESS <i>Land Adjacent 10 Lady Somerset Road</i>	As Built elevations and street scene	
ISSUED 18.10.18	DRAWN LS1018/1	
REV 0	DATE 18.10.18	
© Copyright Property Design Solutions Ltd 2016 www.pdsoltd.co.uk		
07817 676211		