



LOWER GROUND FLOOR
SCALE 1:50

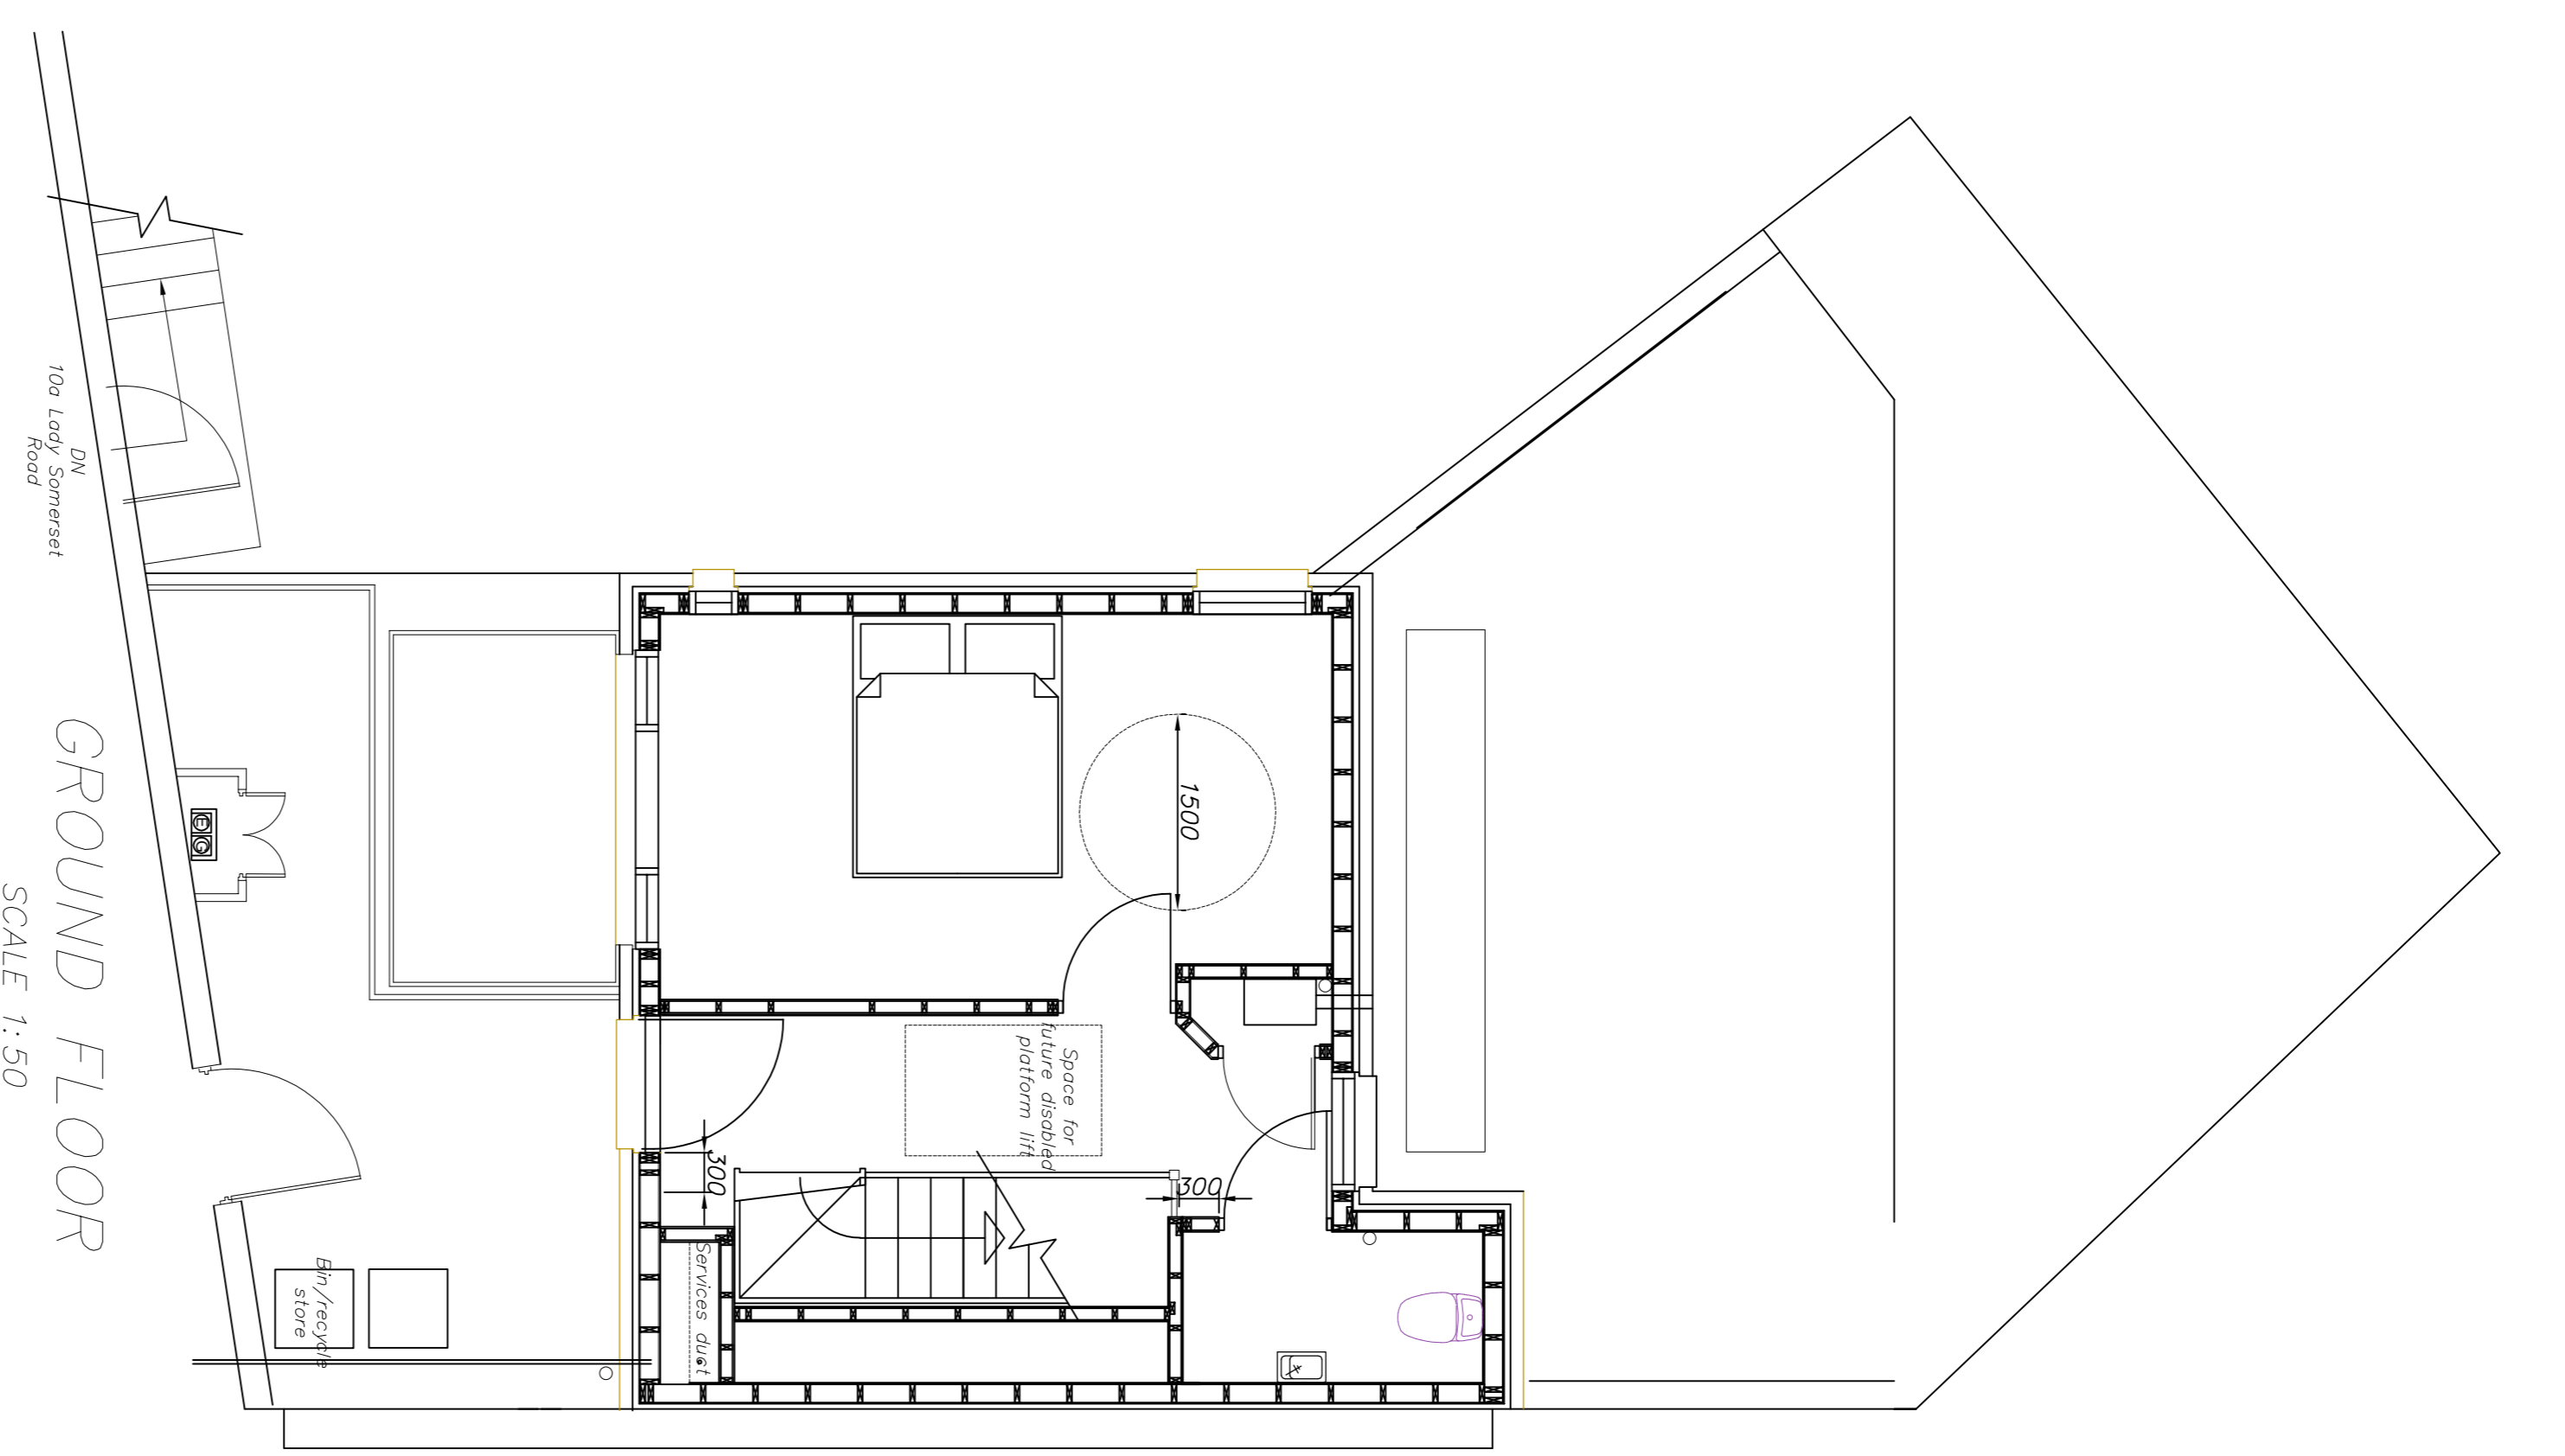

GROUND FLOOR
SCALE 1:50

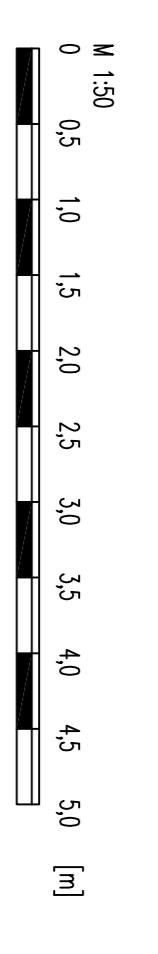

RevNo	Revision note	Date	Signature	Checked

Property Design Solutions Ltd
 Planning and Building Control Drawings

New builds
 Loft conversions
 Extensions
 Conversions
 SAPs

CLIENT NAME <i>Property AV</i>	SHEET 4	SCALE @ A1 1:50
ADDRESS <i>Land Adjacent 10 Lady Somerset Road MWS</i>	As Built Plans	
ISSUED 08.10.18	DRAWING LS0810	
REV	© Copyright Property Design Solutions Ltd 2016 www.pdsoltd.co.uk	
09/2016	07817 676211	